

H:\PROJECTS\ROCKWALL\2003120\PLAN-SHEETS\2003120-PHASE-2.DWG
08/04/04 CAG


PHASE 1-C



SIGN CW20-1D



SIGN G20-2a

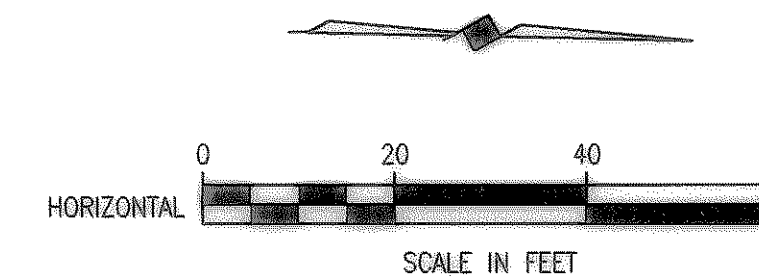


DRUMS W/ TYPE "C"
WARNING LIGHTS @ 10' C-C

DRUMS W/ TYPE "C"
WARNING LIGHTS @ 10' C-C



SIGN R11-2

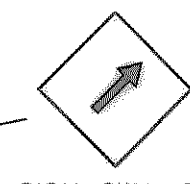

SIGN CW1-6AR

PROP. TEMP. 4"
DOUBLE YELLOW STRIPE

DRUMS W/ TYPE "C"
WARNING LIGHTS @ 20' C-C



SIGN G20-2a



SIGN CW20-1D


- LEGEND**
- CONST. SIGN
 - CHANNELIZING DEVICE
 - TYPE III BARRICADE W/TWO TYPE "A" FLASHING LIGHTS
 - TEMP. H.M.A.C. P.V.M.T.
 - PHASE 1-A P.V.M.T.
 - PHASE 1-B P.V.M.T.
 - PHASE 1-C P.V.M.T.

RE-BID
SUGGESTED
SEQUENCE OF WORK

These plans and related specifications were prepared for construction of this specific project only. Reuse of these documents is not permitted without written authorization of Birkhoff, Hendricks, & Conway, L.L.P.

REVISED TO CONFORM
TO CONSTRUCTION RECORDS
BY M.H. DATE 12/04/2006

THESE DOCUMENTS ARE FOR
BIDDING, CONSTRUCTION,
AND PERMIT PURPOSES.
DATE: 12/04/06

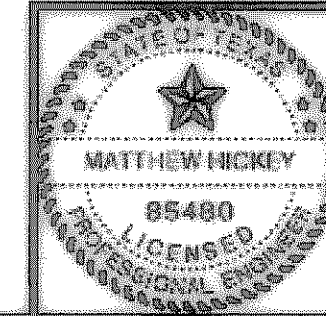

CITY OF ROCKWALL, TEXAS

**CLARK STREET
PHASE 1-C
BOYDSTUN & CLARK INTERSECTION**

BIRKHOFF, HENDRICKS & CONWAY, L.L.P.
CONSULTING ENGINEERS
Dallas, Texas

DESIGNED BY: <u>M.H.</u>	PROJECT: <u>2003-120</u>	SHEET NO. <u>105</u>
DRAWN BY: <u>B.H.C.</u>	DATE: <u>OCTOBER, 2004</u>	OF <u>105</u> SHEETS