


- LEGEND**
- PHASE 1A
 - PHASE 1B
 - PHASE 1C
 - PHASE 1D
 - PHASE 2

These plans and related specifications were prepared for construction of this specific project only. Reuse of these documents is not permitted without written authorization of Birkhoff, Hendricks, & Conway, L.L.P.

CITY OF ROCKWALL, TEXAS
CLARK STREET
SUGGESTED CONSTRUCTION PHASING

BIRKHOFF, HENDRICKS & CONWAY, L.L.P.
 CONSULTING ENGINEERS
 Dallas, Texas

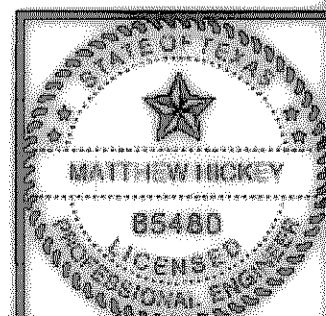

THESE DOCUMENTS ARE FOR BIDDING, CONSTRUCTION, AND PERMIT PURPOSES.
Matthew Hickey
 DATE: 10/13/07

REVISED TO CONFORM TO CONSTRUCTION RECORDS
 BY M.H. DATE 12/04/2006

DESIGNED BY: <u>M.H.</u>	PROJECT: <u>2003-120</u>	SHEET NO. <u>106</u>
DRAWN BY: <u>B.H.C.</u>	DATE: <u>OCTOBER, 2004</u>	OF <u>106</u> SHEETS

REV 08/06/04 CAC H:\PROJECTS\ROCKWALL\2003120\PLAN-SHEETS\2003120-PHASING-1.DWG