


LEGEND

- PHASE 2
- PHASE 2B

These plans and related specifications were prepared for construction of this specific project only. Reuse of these documents is not permitted without written authorization of Birkhoff, Hendricks, & Conway, L.L.P.

CITY OF ROCKWALL, TEXAS  
 CLARK STREET  
 SUGGESTED CONSTRUCTION PHASING

BIRKHOFF, HENDRICKS & CONWAY, L.L.P.  
 CONSULTING ENGINEERS  
 Dallas, Texas

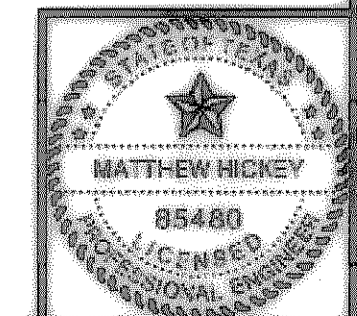

DESIGNED BY: M.H.	PROJECT: 2003-120	SHEET NO. 107
DRAWN BY: B.H.C.	DATE: OCTOBER, 2004	OF SHEETS

REVISED TO CONFORM TO CONSTRUCTION RECORDS  
 BY M.H. DATE 12/04/2006

THESE DOCUMENTS ARE FOR BIDDING, CONSTRUCTION, AND PERMIT PURPOSES.  
 DATE: 12/12/04