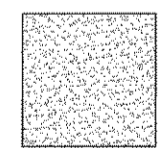
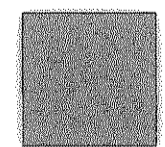
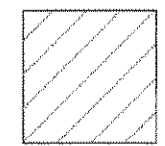
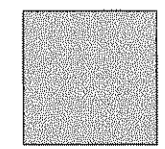


LEGEND

-  PHASE 2B
-  PHASE 3
-  PHASE 4
-  PHASE 5A

These plans and related specifications were prepared for construction of this specific project only. Reuse of these documents is not permitted without written authorization of Birkhoff, Hendricks, & Conway, L.L.P.

CITY OF ROCKWALL, TEXAS


**CLARK STREET
SUGGESTED CONSTRUCTION PHASING**

BIRKHOFF, HENDRICKS & CONWAY, L.L.P.
CONSULTING ENGINEERS
Dallas, Texas

| | | |
|-------------------|---------------------|---------------|
| DESIGNED BY: M.H. | PROJECT: 2003-120 | SHEET NO. 108 |
| DRAWN BY: B.H.C. | DATE: OCTOBER, 2004 | OF SHEETS |

REVISED TO CONFORM TO CONSTRUCTION RECORDS
BY M.H. DATE 12/04/2006

THESE DOCUMENTS ARE FOR BIDDING, CONSTRUCTION, AND PERMIT PURPOSES.
DATE: 11/18/04

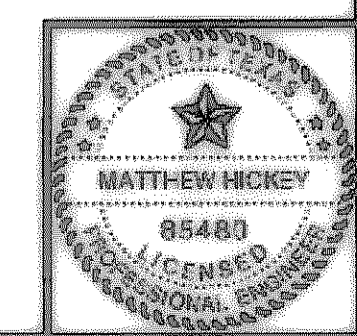

REV 08/06/04 CAG H:\PROJECTS\ROCKWALL\2003120\PLAN-SHEETS\2003120-PHASING-3.DWG