

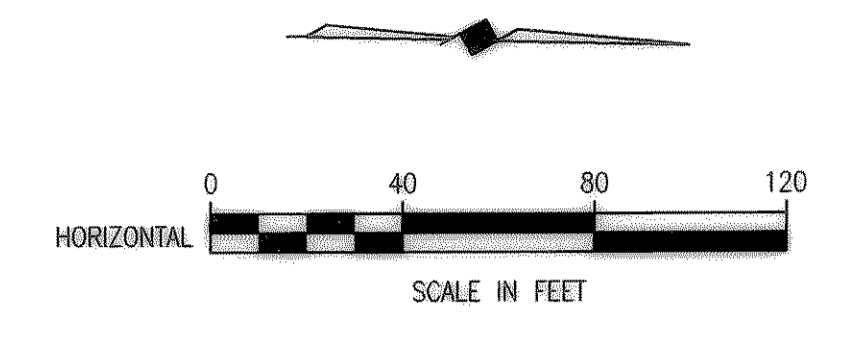


H:\PROJECTS\ROCKWALL\2003120\PLAN-SHEETS\2003120-PHASING-5.DWG
REV 08/06/04 CAG

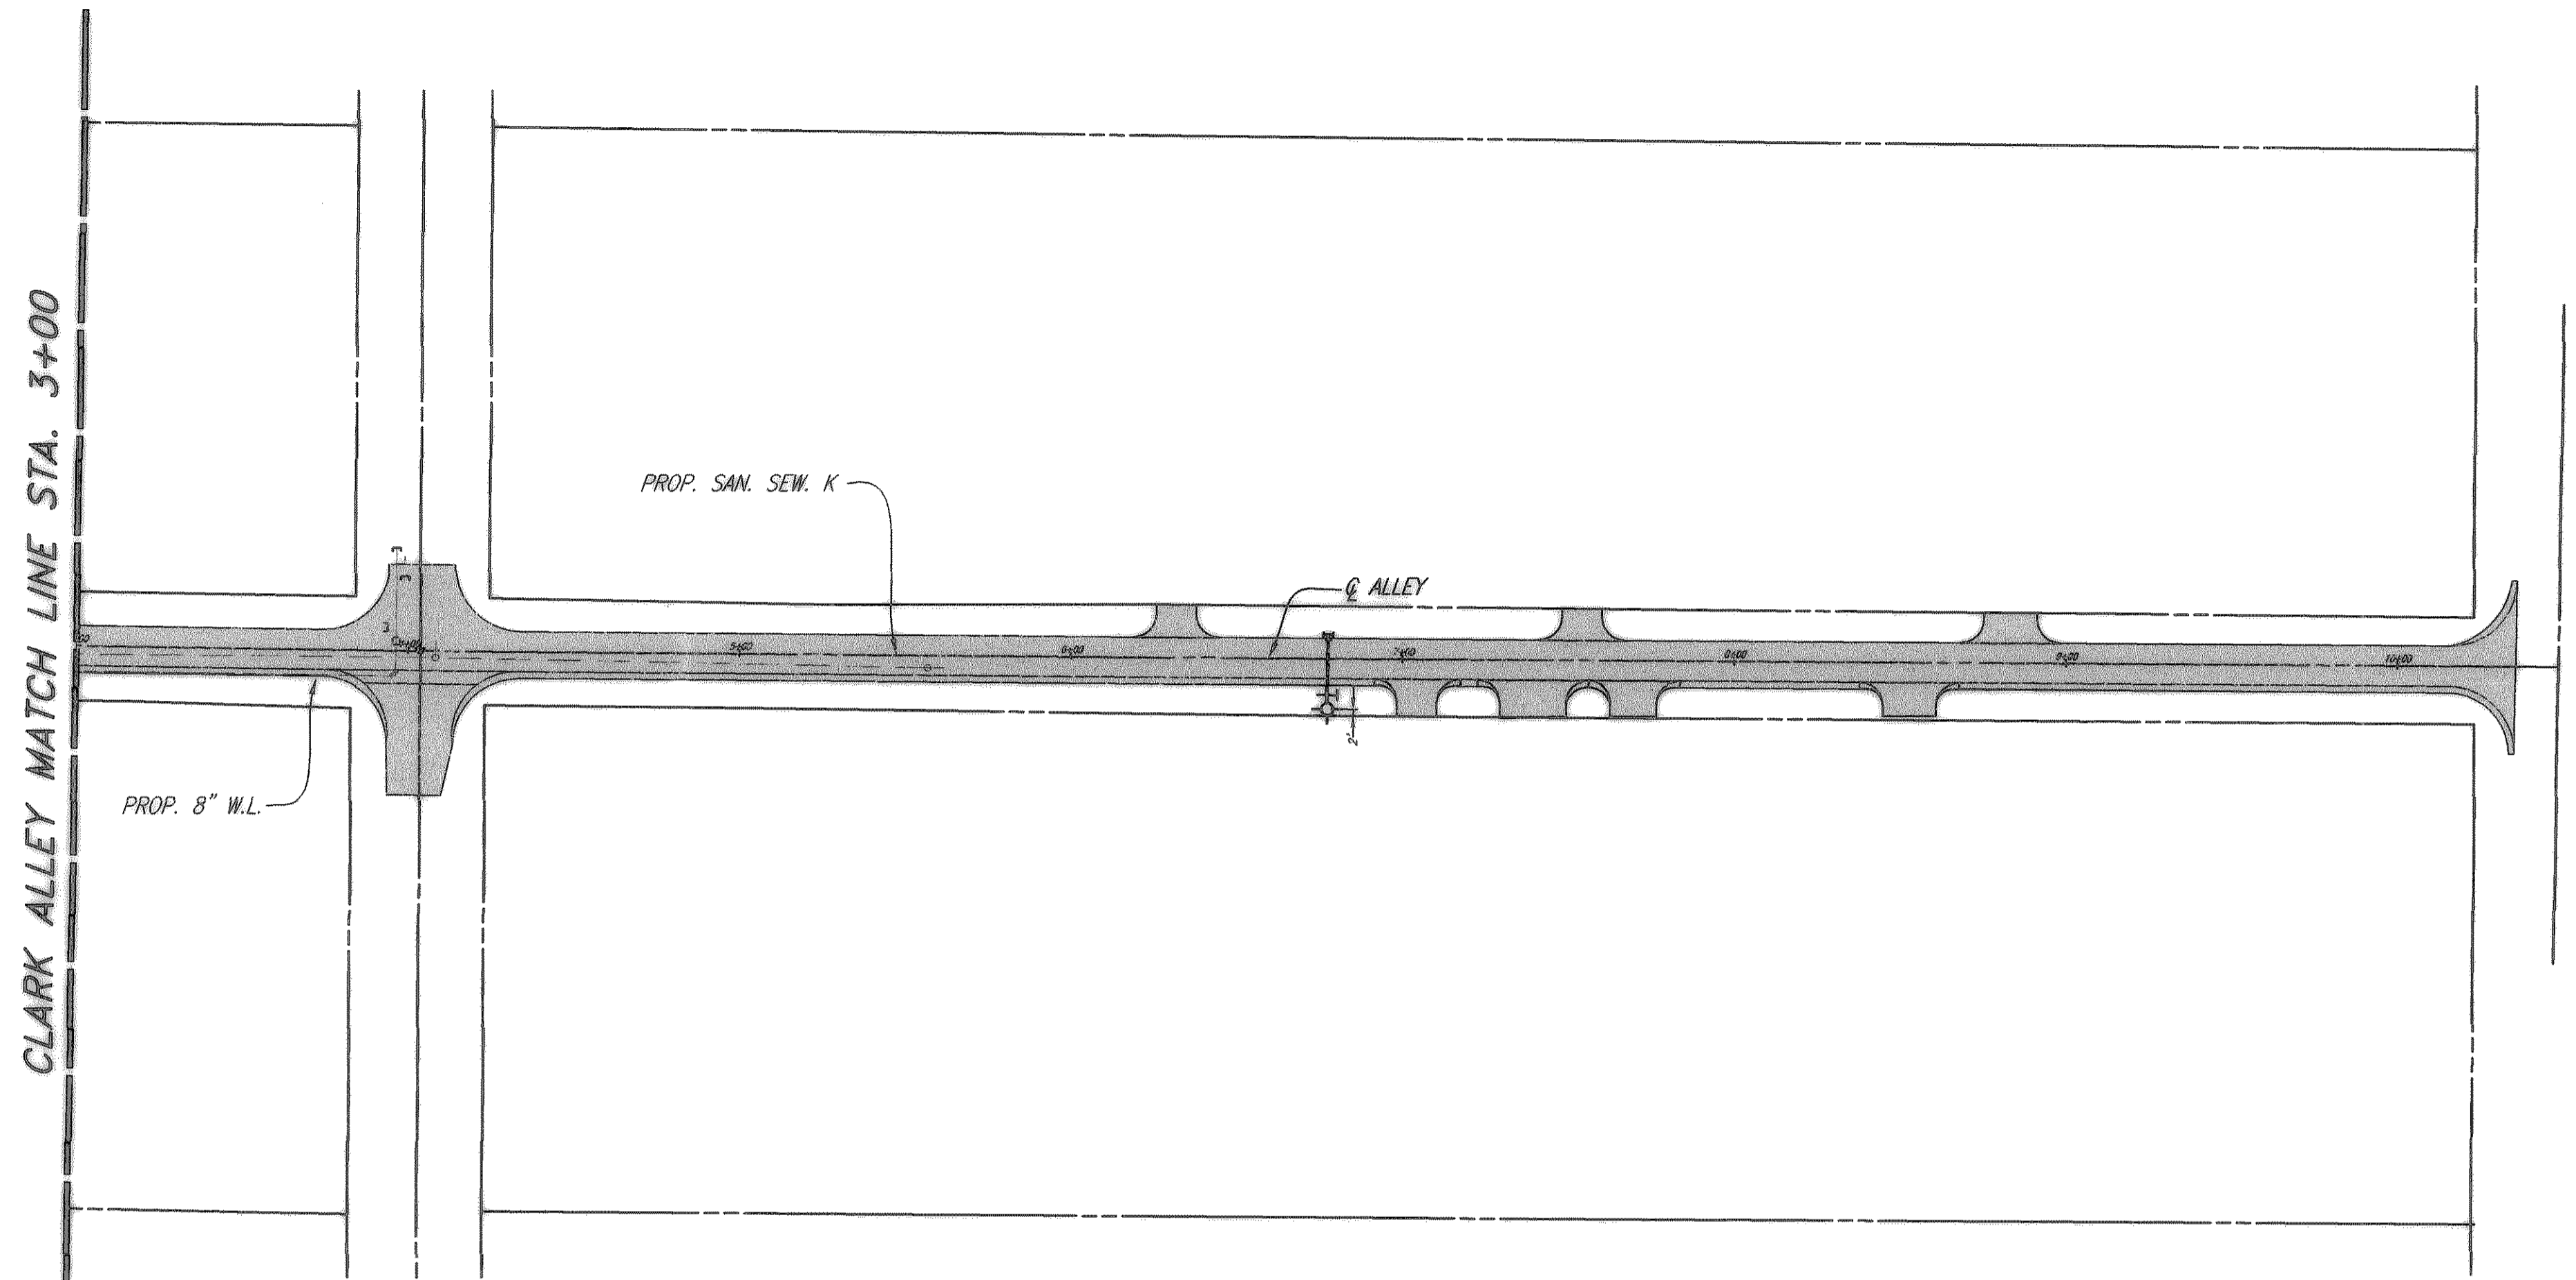

LEGEND

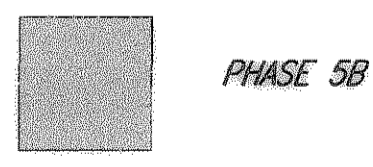


These plans and related specifications were prepared for construction of this specific project only. Reuse of these documents is not permitted without written authorization of Birkhoff, Hendricks, & Conway, L.L.P.

CITY OF ROCKWALL, TEXAS

**CLARK STREET
SUGGESTED CONSTRUCTION PHASING**

BIRKHOFF, HENDRICKS & CONWAY, L.L.P.
CONSULTING ENGINEERS
Dallas, Texas

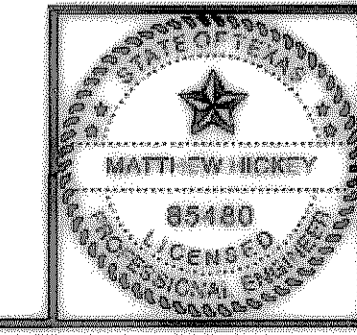

REVISED TO CONFORM
TO CONSTRUCTION RECORDS
BY M.H. DATE 12/04/2006

THESE DOCUMENTS ARE FOR
BIDDING, CONSTRUCTION,
AND PERMIT PURPOSES.
DATE: 12/12/04

DESIGNED BY: <u>M.H.</u>	PROJECT: <u>2003-120</u>	SHEET NO. <u>110</u>
DRAWN BY: <u>B.H.C.</u>	DATE: <u>OCTOBER, 2004</u>	OF <u> </u> SHEETS