


**NOTES**  
 1. CONTRACTOR SHALL SUPPLEMENT DETOUR WARNING SIGNS WITH ALL APPLICABLE CONSTRUCTION WARNING SIGNS IN ACCORDANCE WITH TxDOT'S MANUAL ON UNIFORM TRAFFIC CONTROL DEVICES FOR STREETS & HIGHWAYS.

- LEGEND**
- TYPE III BARRICADE W/ TWO TYPE "D" WARNING LIGHTS
  - CONSTRUCTION SIGN
  - PHASE 4

These plans and related specifications were prepared for construction of this specific project only. Reuse of these documents is not permitted without written authorization of Birkhoff, Hendricks & Conway, L.L.P.

**CITY OF ROCKWALL, TEXAS**  
**CLARK STREET-STORM SEWER SUGGESTED DETOUR PLAN PHASE 4**

**BIRKHOFF, HENDRICKS & CONWAY, L.L.P.**  
 CONSULTING ENGINEERS  
 Dallas, Texas

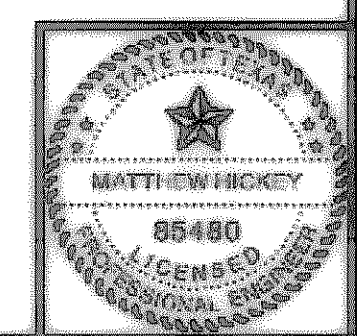

THESE DOCUMENTS ARE FOR BIDDING, CONSTRUCTION, AND PERMIT PURPOSES.  
*Matthew Hickey*  
 DATE: 10/20/04

REVISED TO CONFORM TO CONSTRUCTION RECORDS  
 BY M.H. DATE 12/04/2006

DESIGNED BY: M.H.	PROJECT: 2003-120	SHEET NO. 114
DRAWN BY: B.H.C.	DATE: OCTOBER, 2004	OF SHEETS