




08/05/04 LBS H:\ROCKWALL\2003\120\ROADS\GROSS-SEC\CHANNEL-A-XSECT.DWG SCALE: 1=20 XREF: ROCKWALL\2003\120\BASE\PROP-BASE

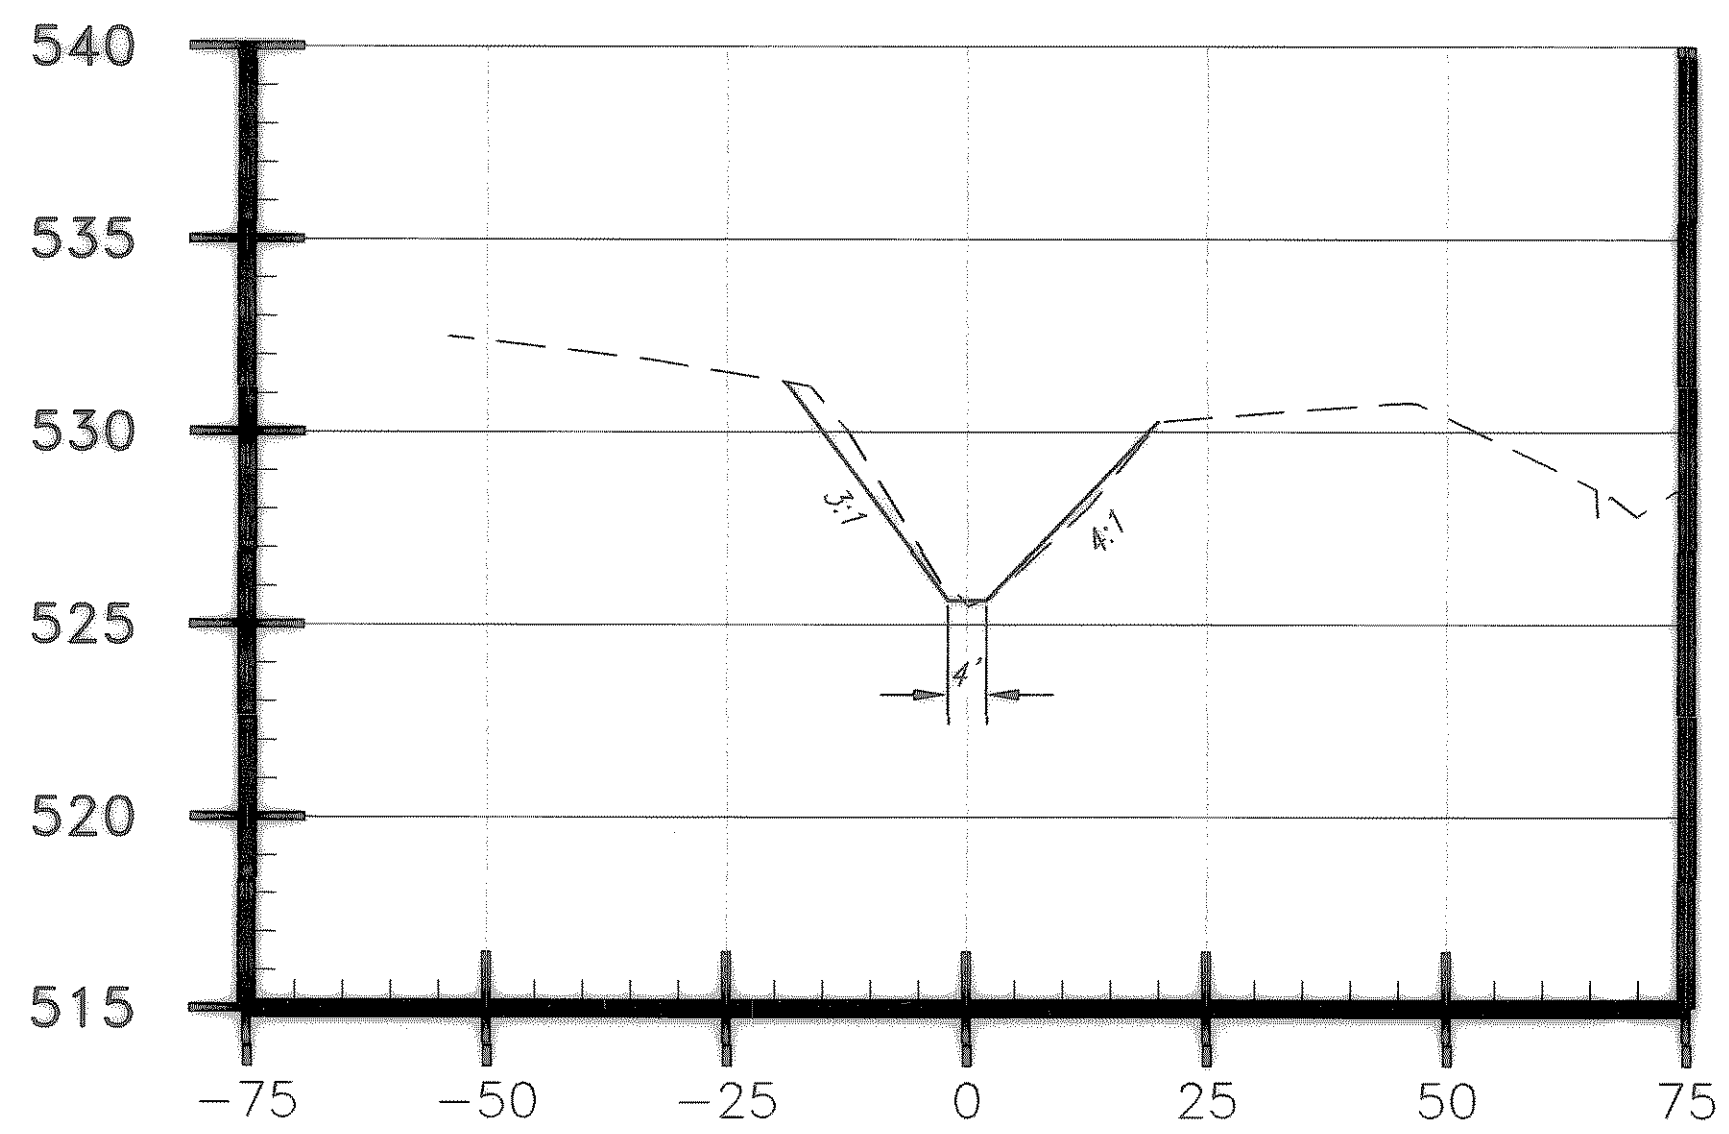


0+50.00

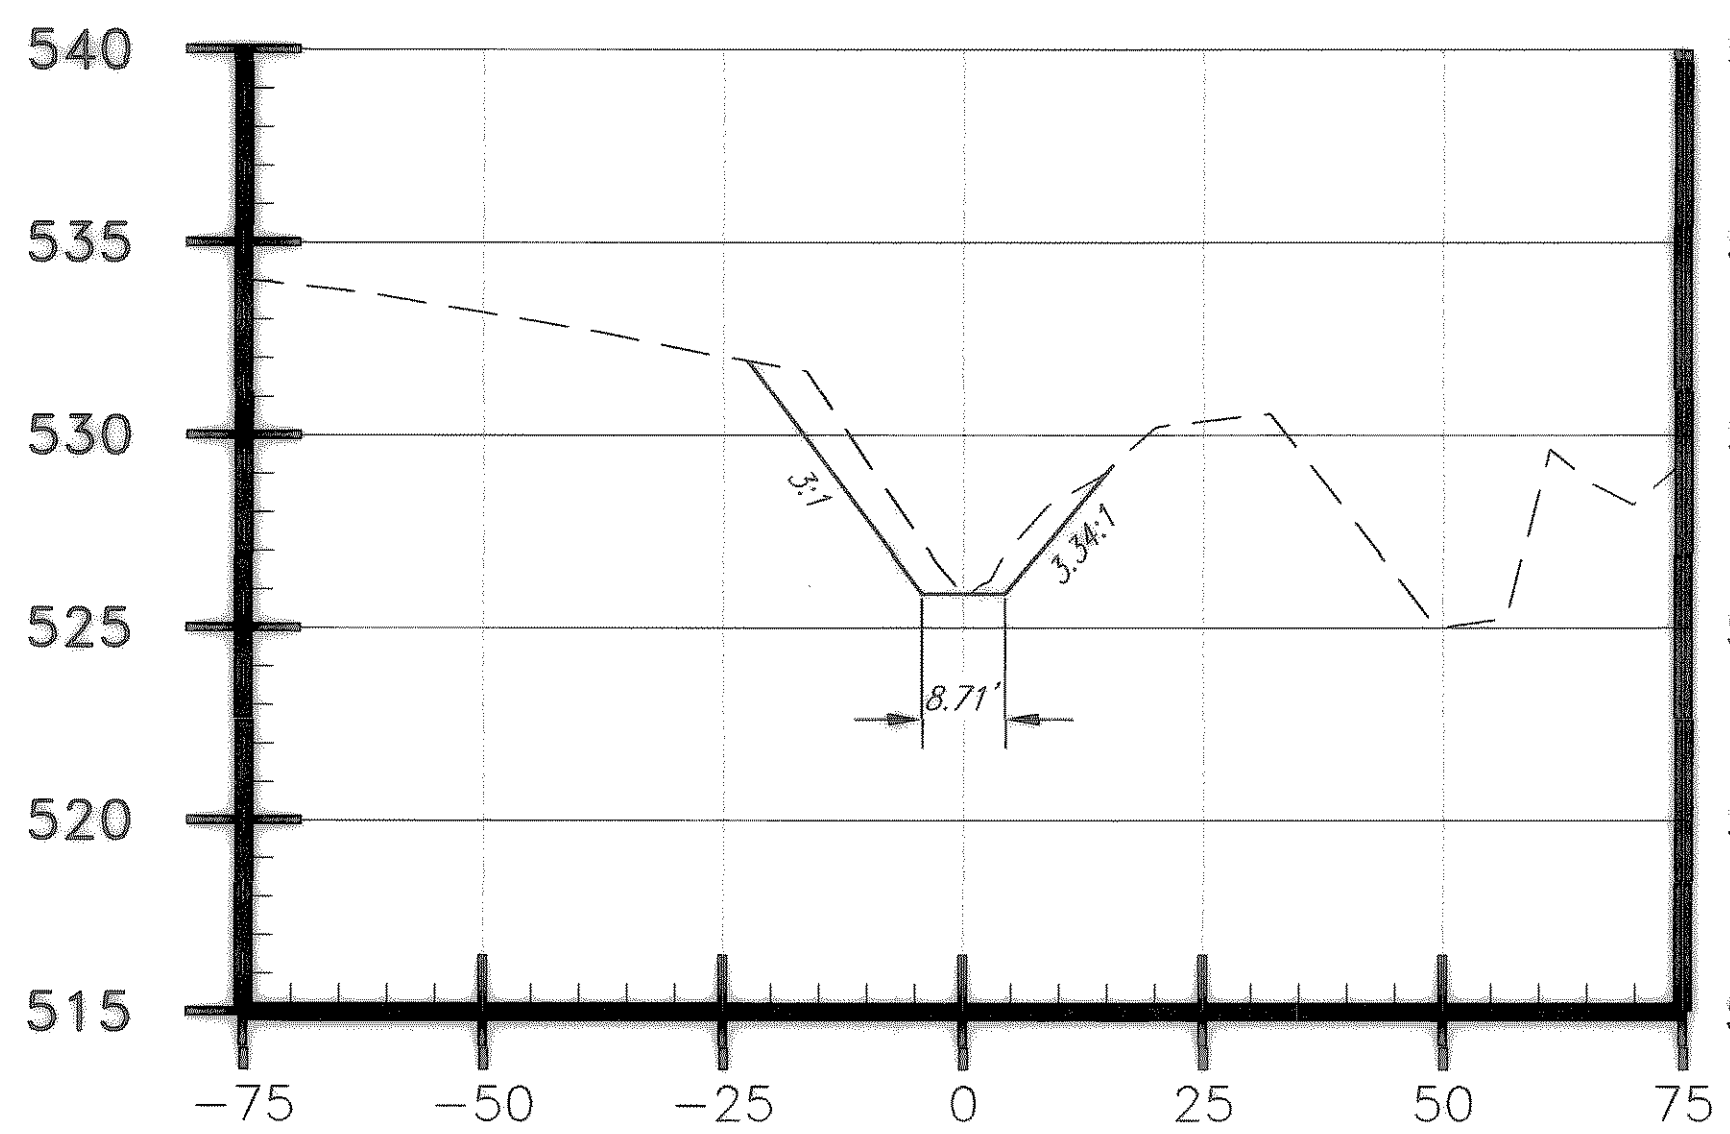


1+00.00

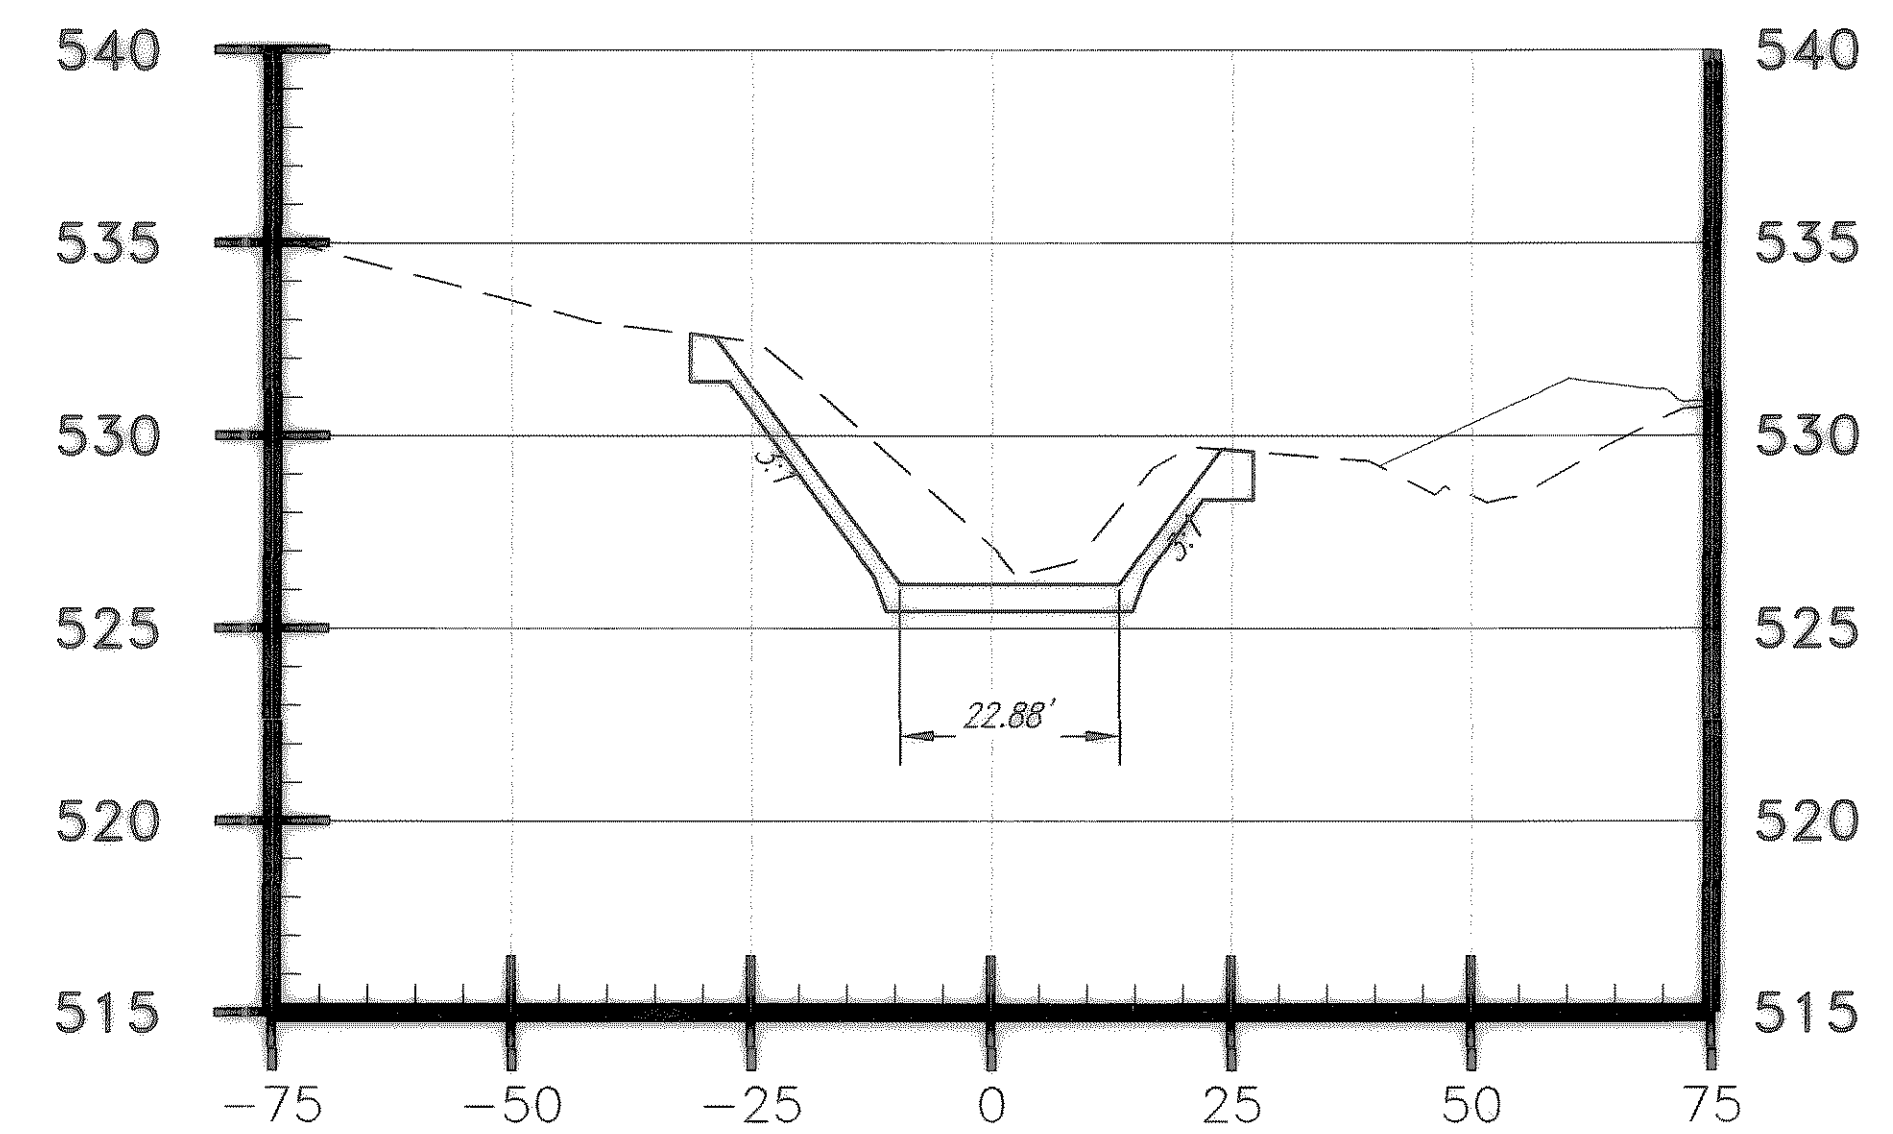


1+50.00

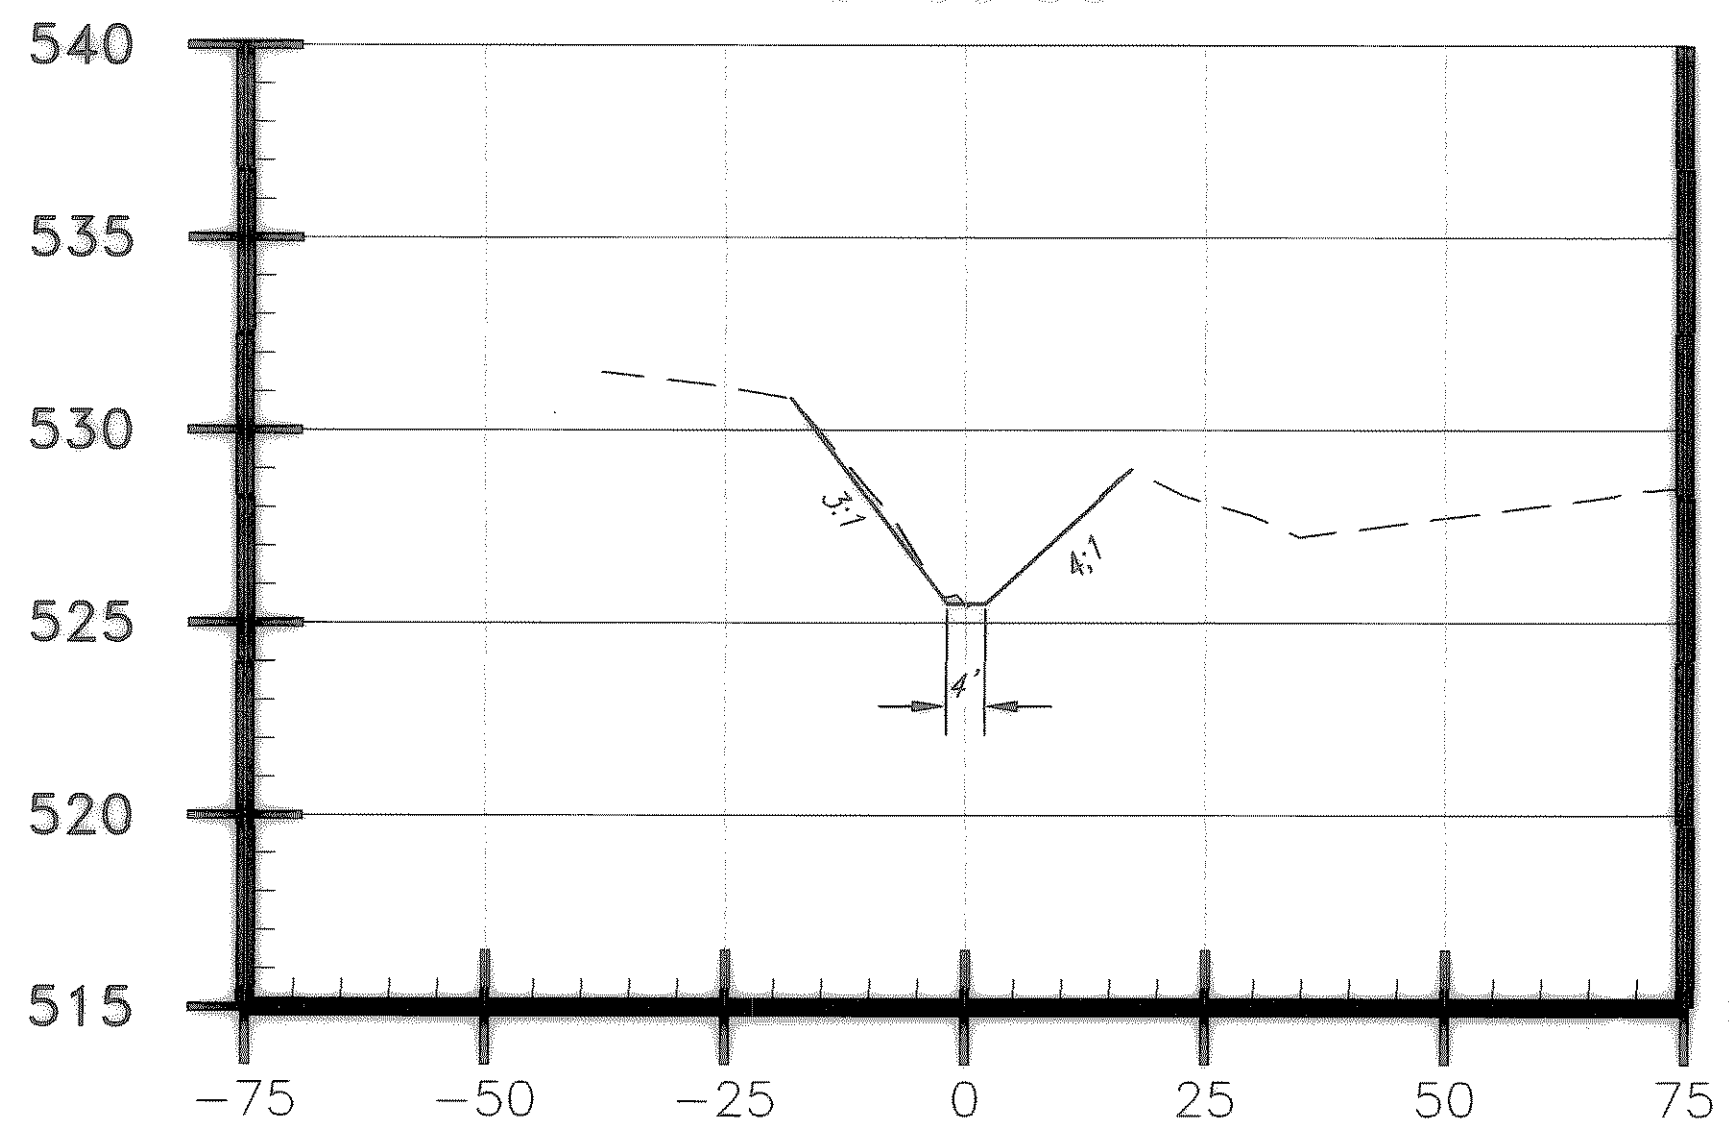


0+25.00

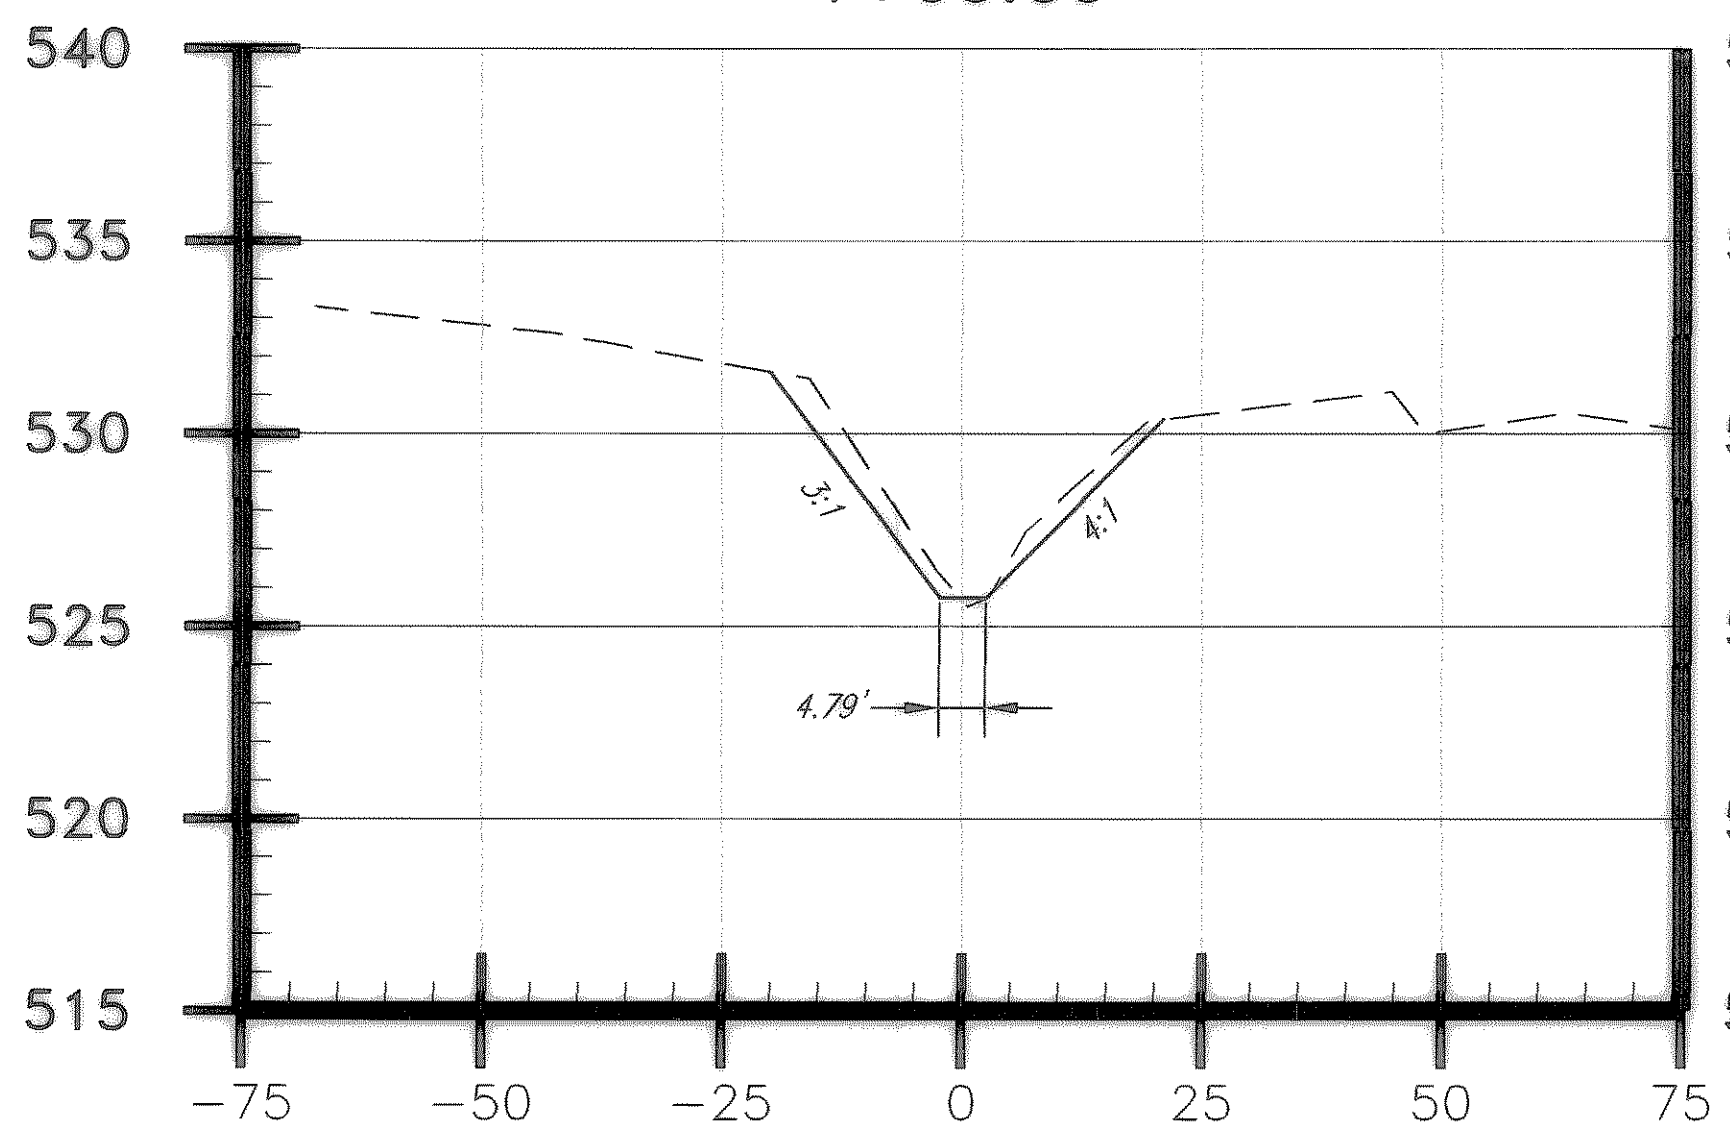


0+75.00

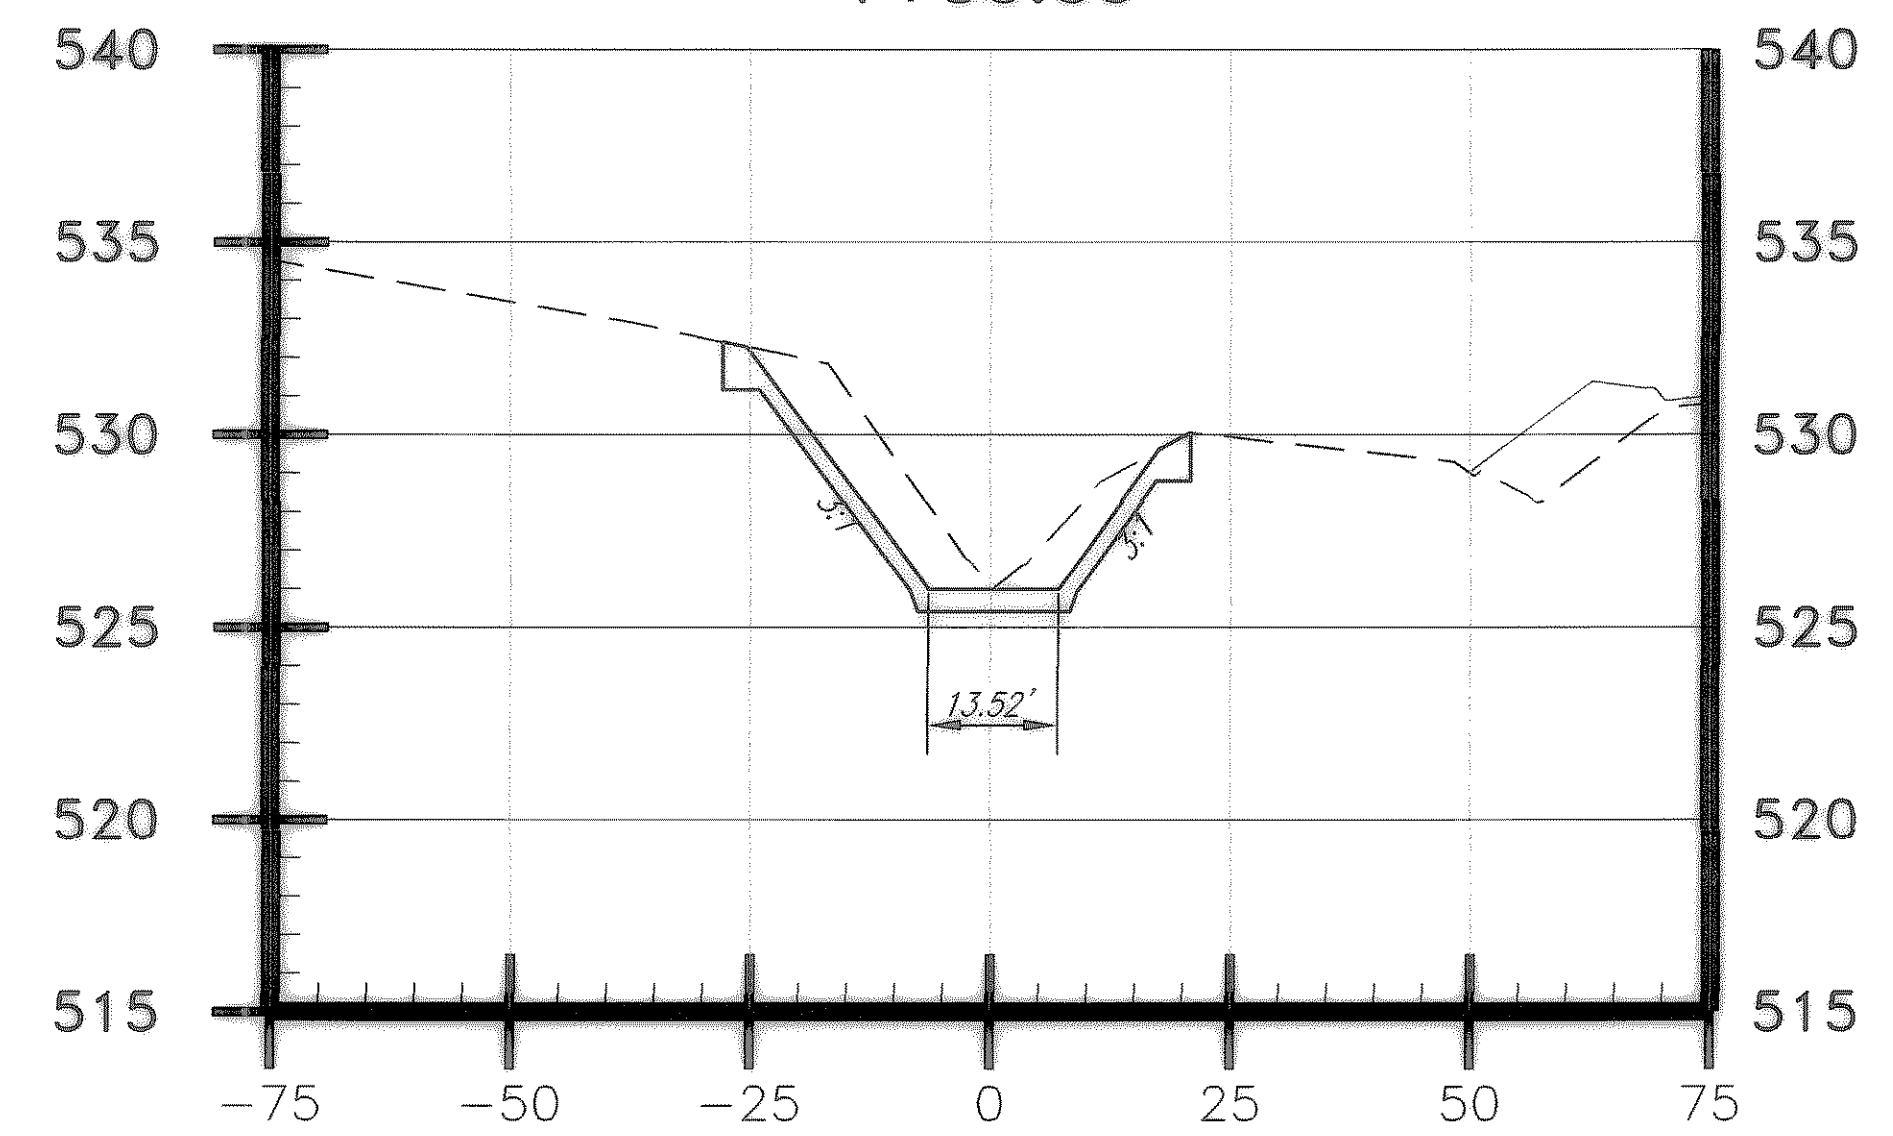

1+25.00

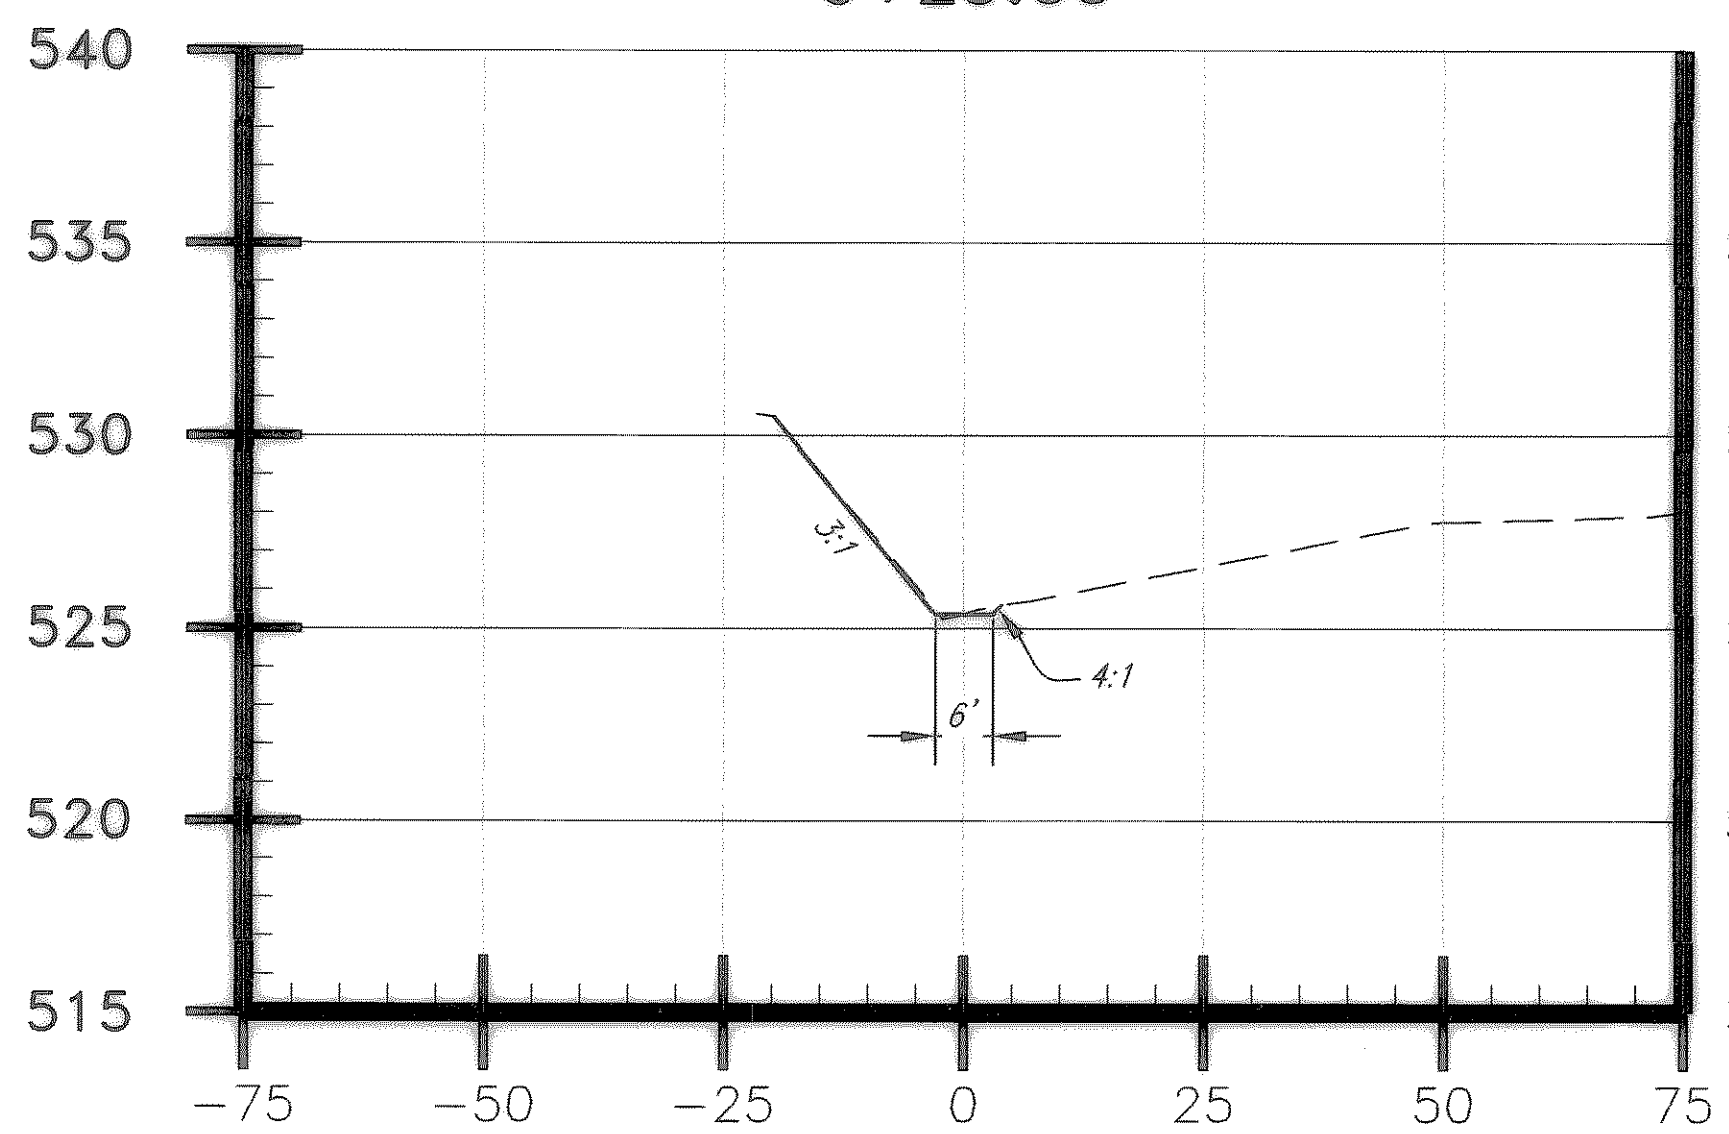

0+00.00

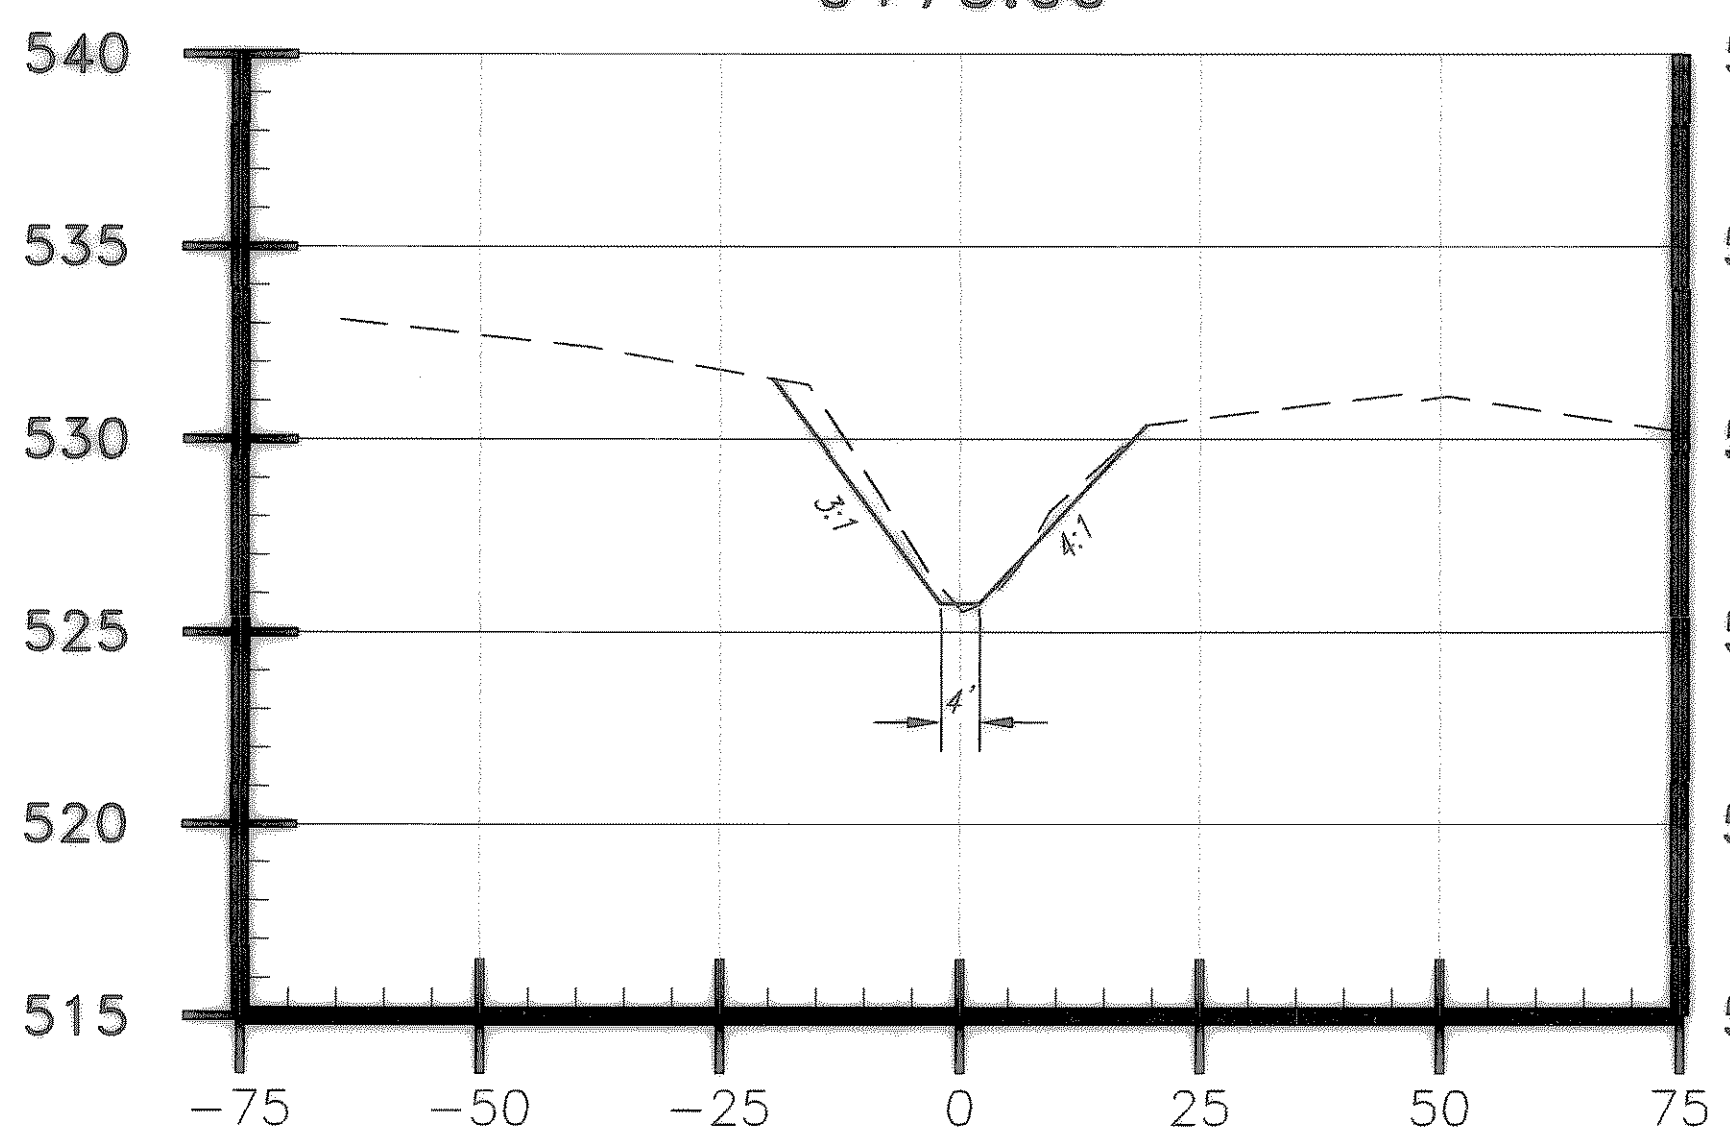


0+70.00

REVISED TO CONFORM
TO CONSTRUCTION RECORDS
BY M.H. DATE 12/04/2006

These plans and related specifications were prepared for construction of this specific project only. Reuse of these documents is not permitted without written authorization of Birkhoff, Hendricks & Conway, L.L.P.

THESE DOCUMENTS ARE FOR BIDDING, CONSTRUCTION, AND PERMIT PURPOSES.
Matthew Hickey
DATE: 6/6/07

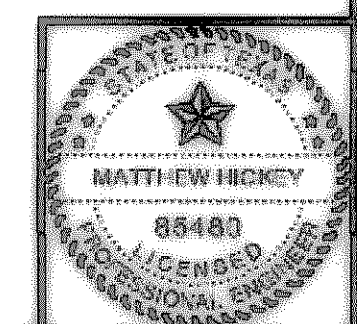

CITY OF ROCKWALL, TEXAS		
CLARK STREET- CHANNEL 'A' CROSS SECTIONS		
BIRKHOFF, HENDRICKS & CONWAY, L.L.P. CONSULTING ENGINEERS Dallas, Texas		
DESIGNED BY: <u>M.H.</u>	PROJECT: <u>2003-120</u>	SHEET NO. <u>79</u>
DRAWN BY: <u>R.J.L.</u>	DATE: <u>AUGUST, 2004</u>	OF <u>X</u> SHEETS