




08/06/04 LBS H:\ROCKWALL\2003\120\ROADS\CROSS-SEC\CHANNEL-E-XSECT.DWG SCALE: 1=20 XREF: ROCKWALL\2003\120\BASE\PROP-BASE

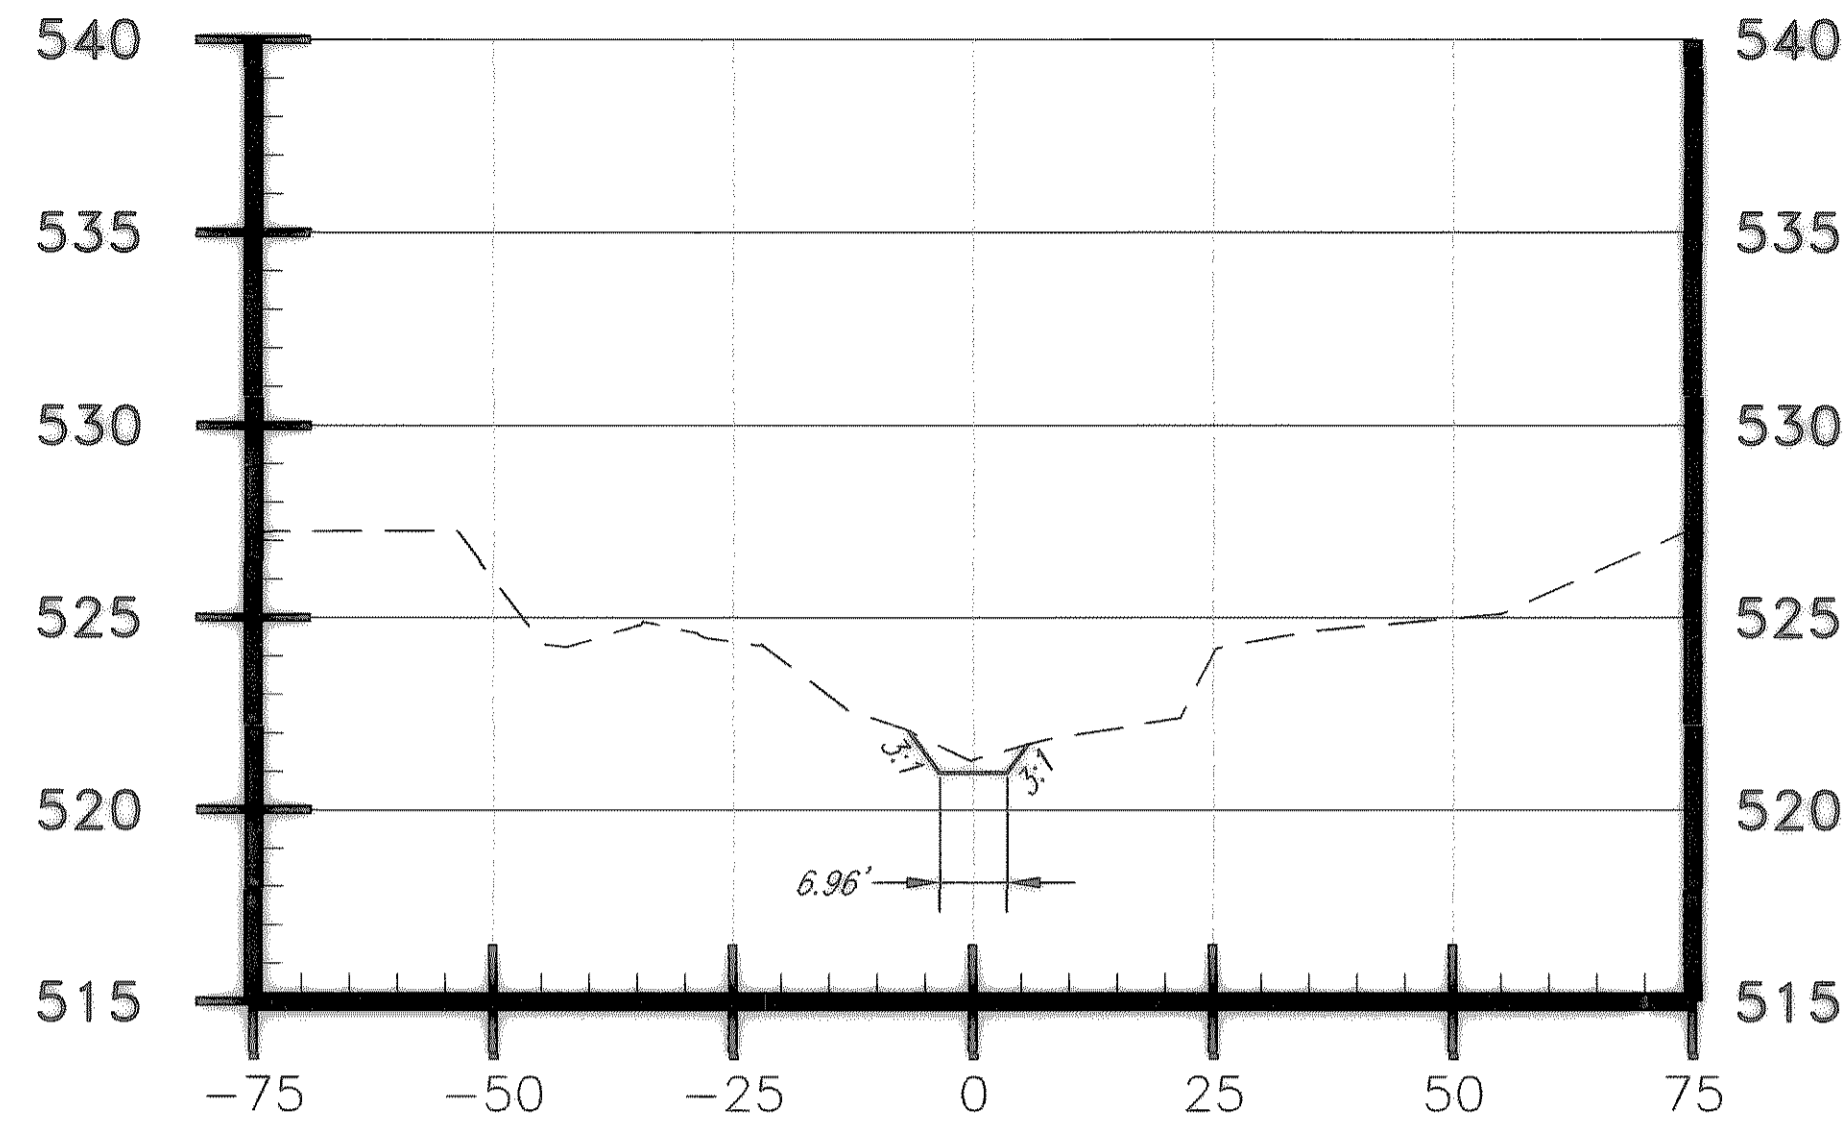


-2+22.54

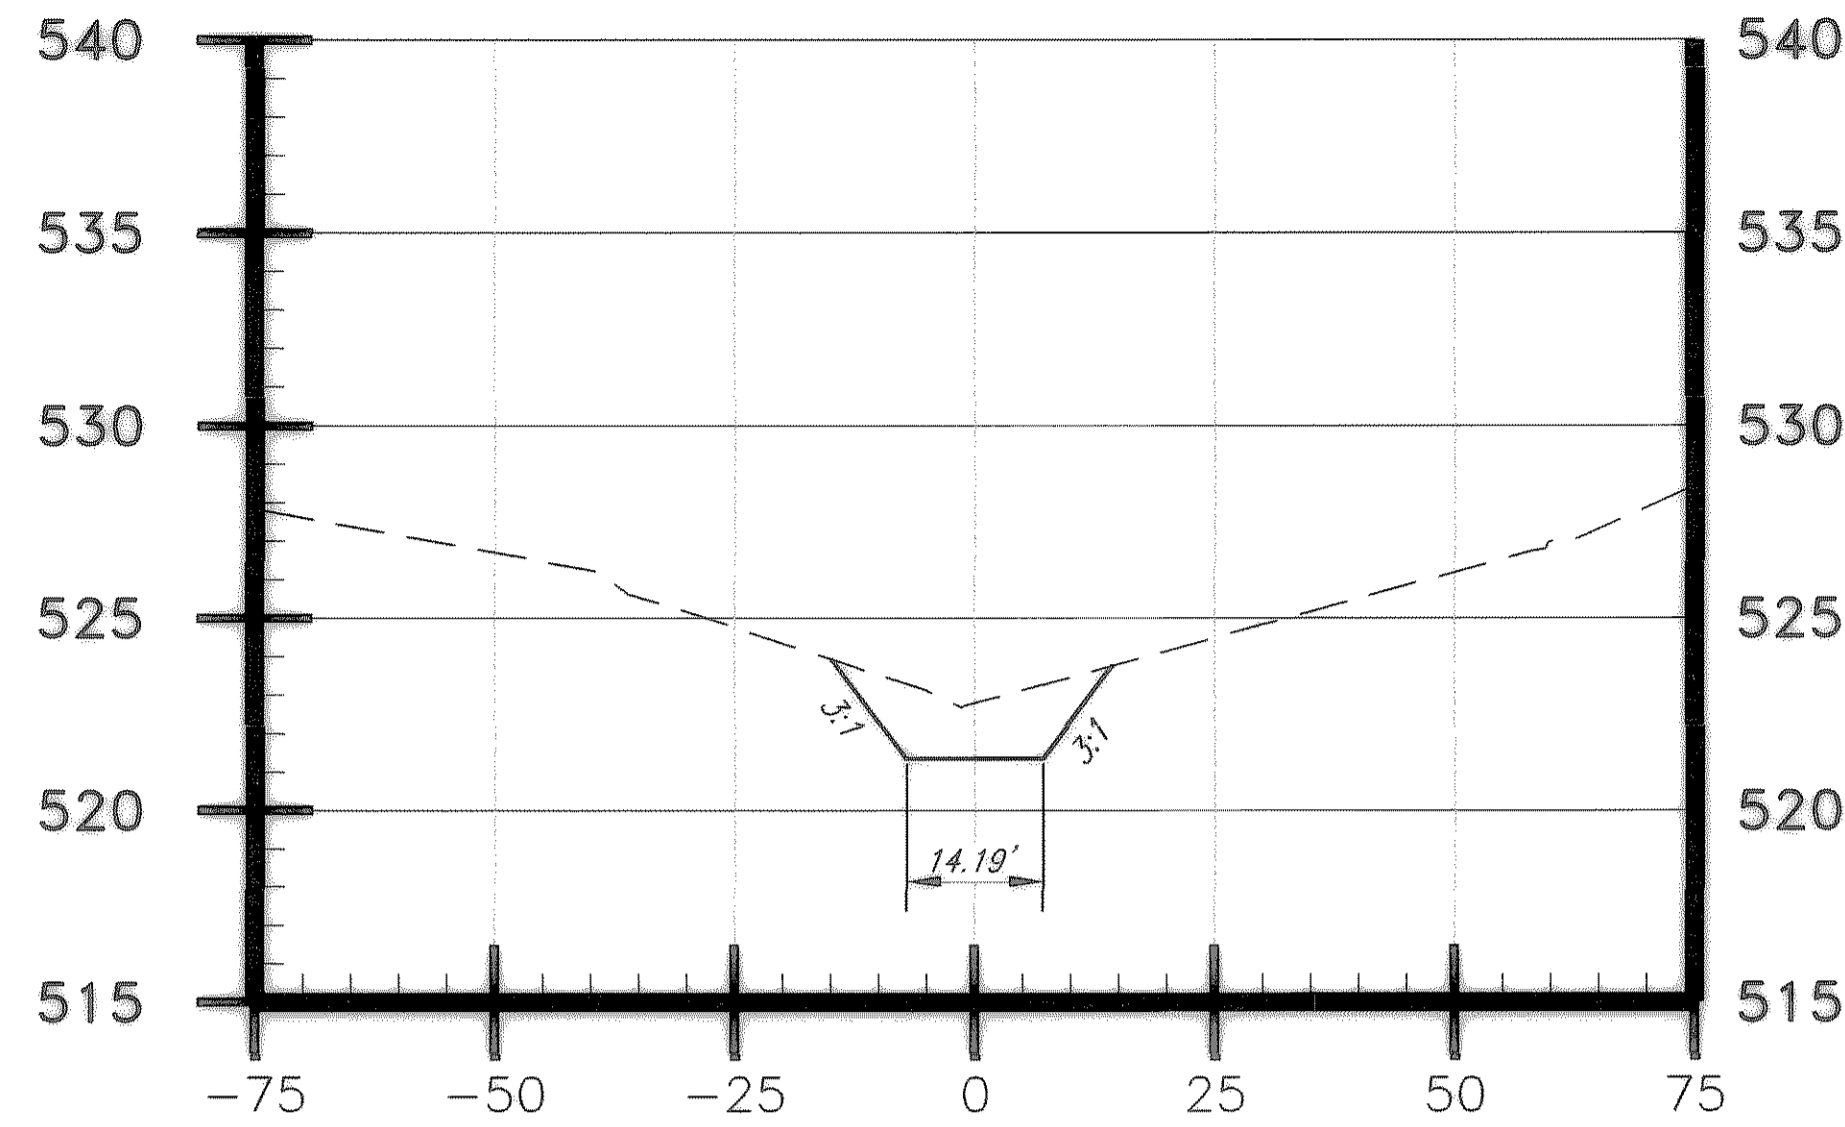


-1+47.54

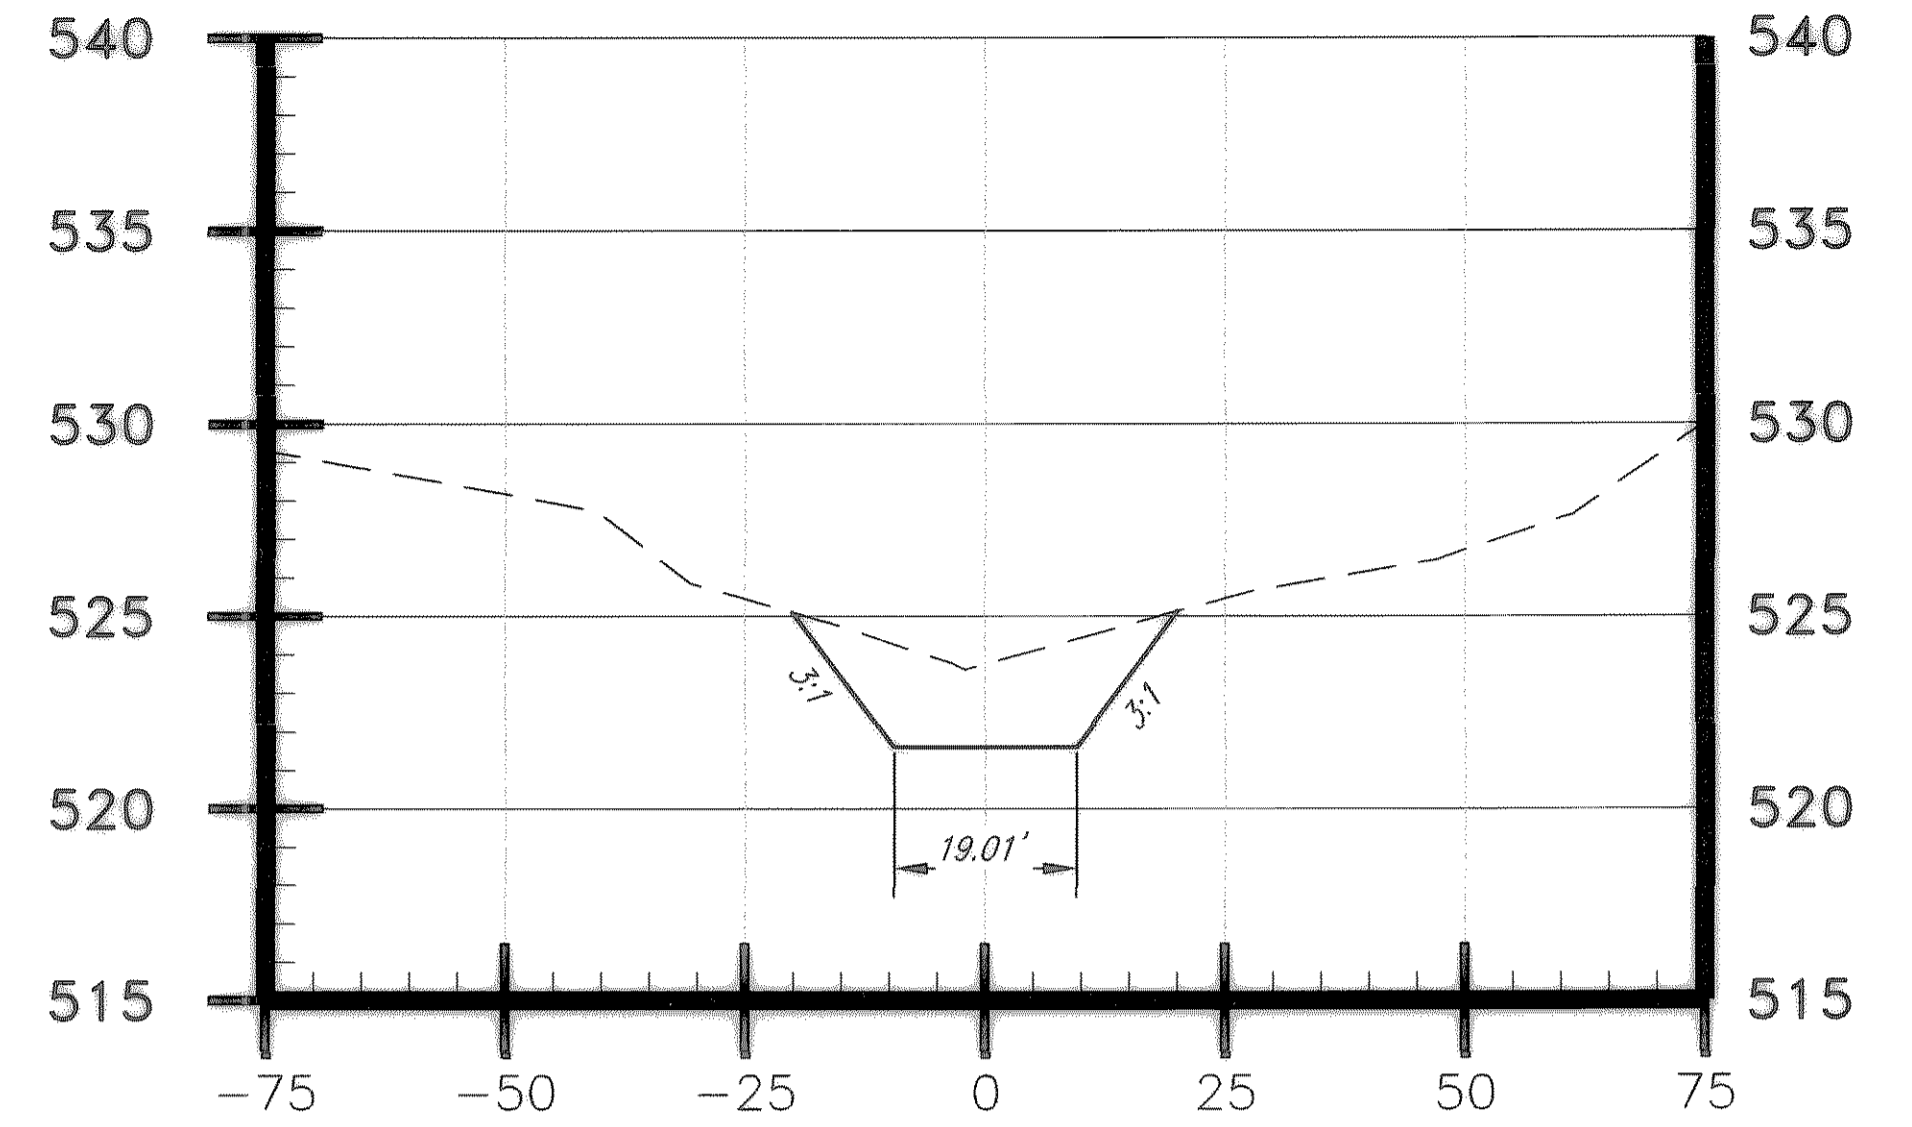


-0+97.54

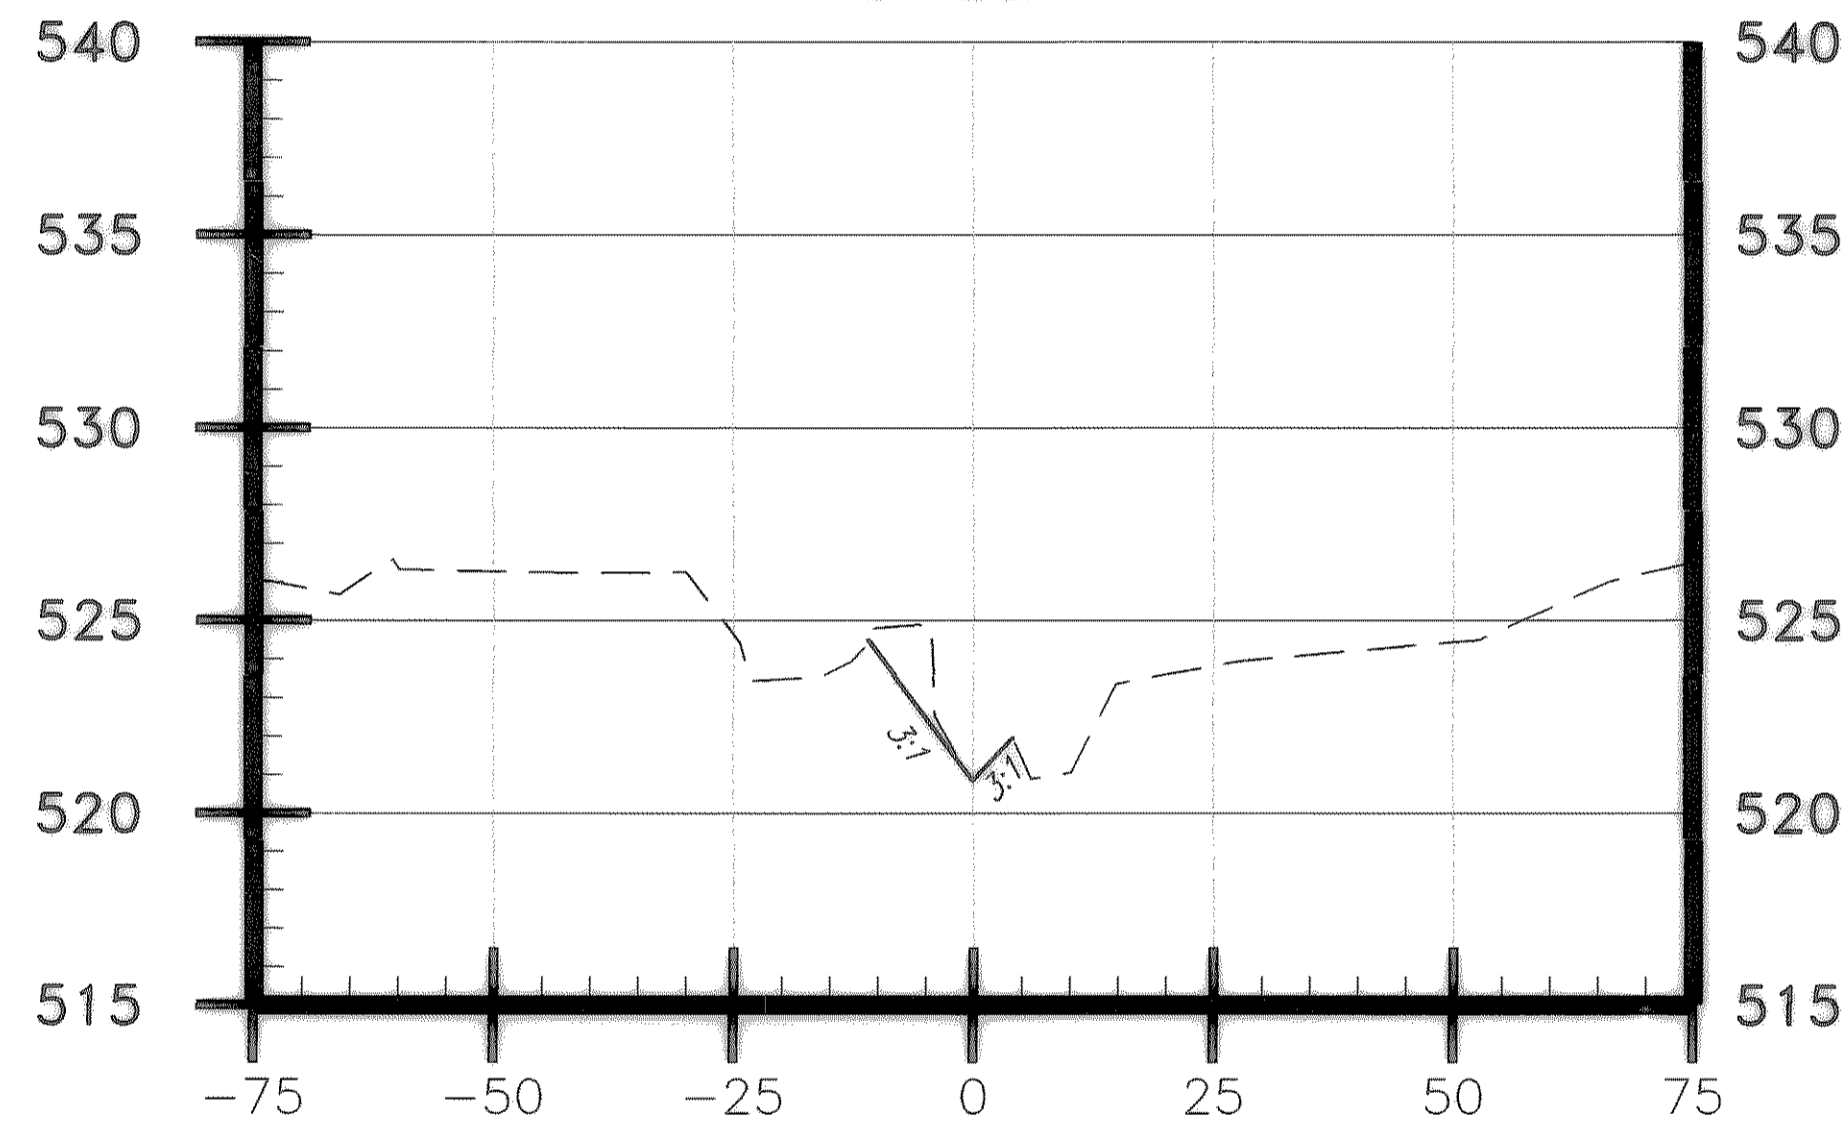


-2+45.04

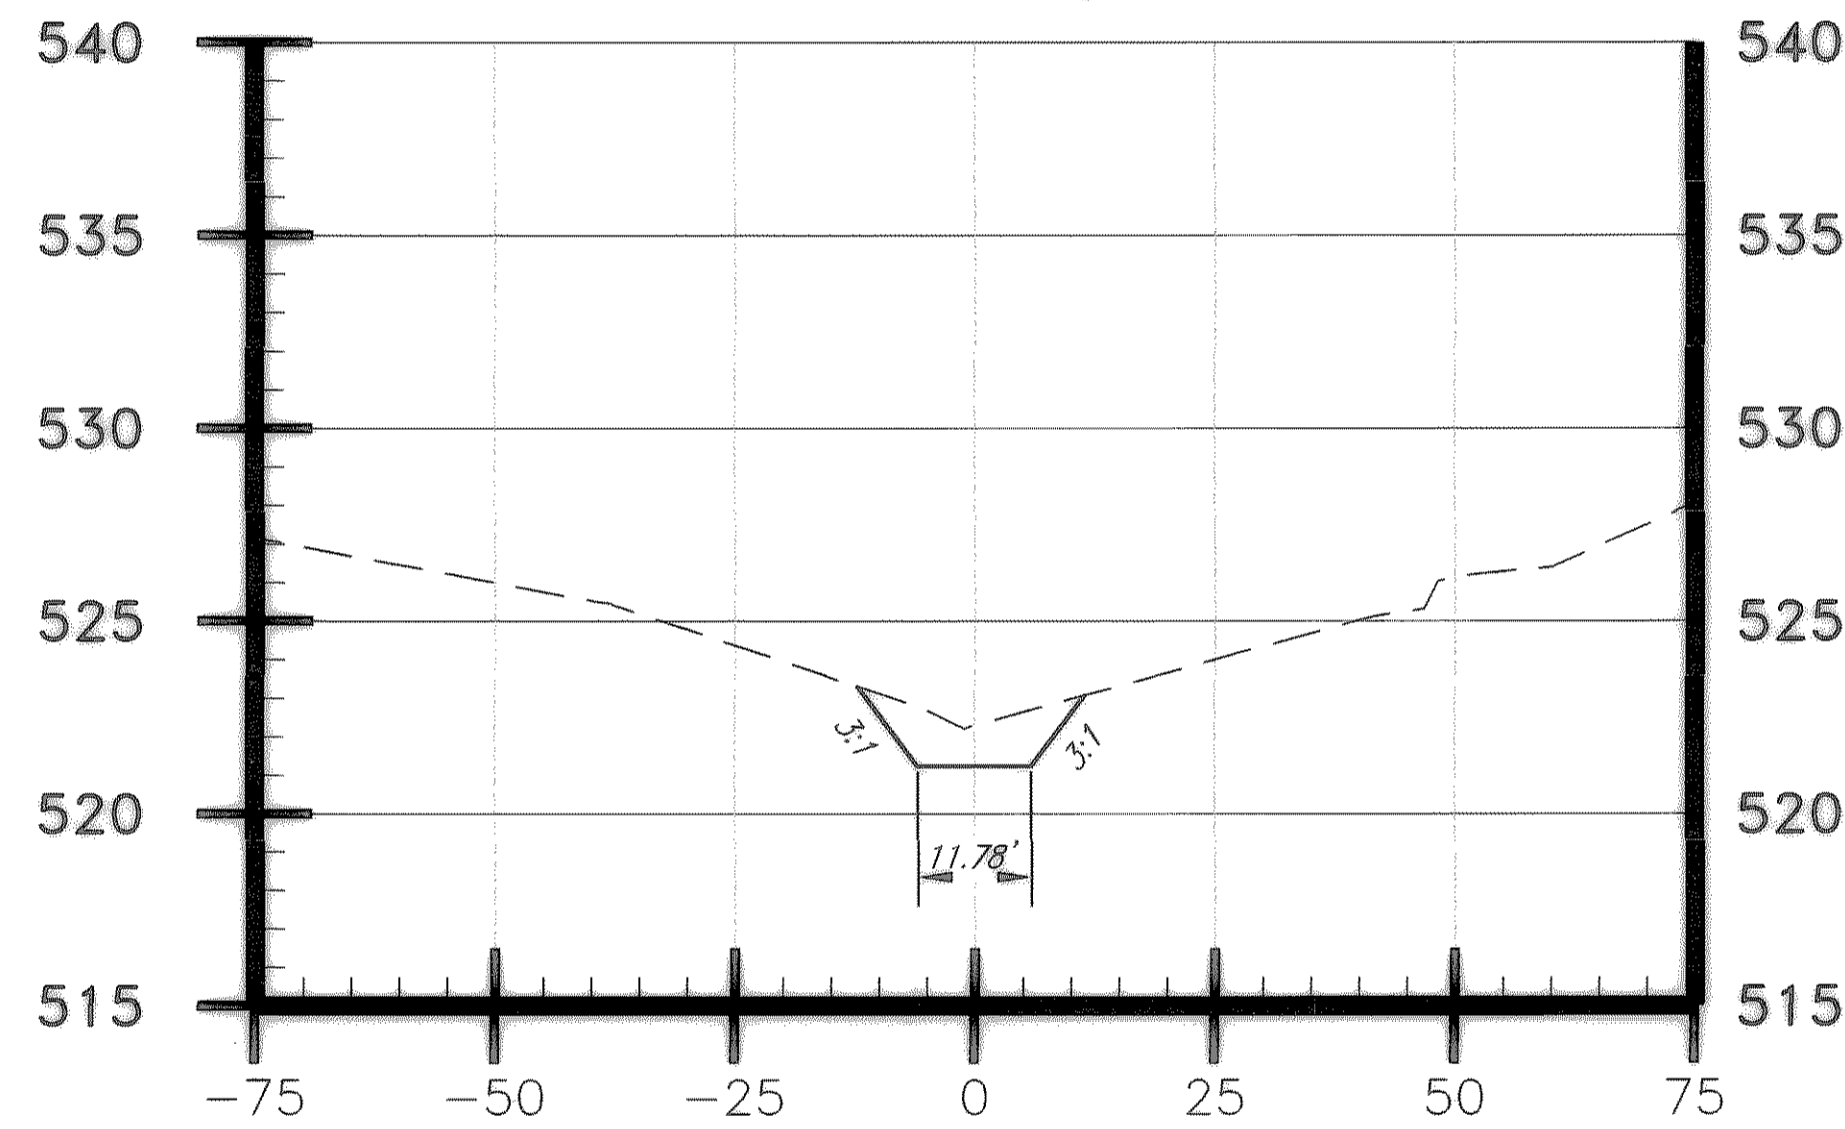


-1+72.50

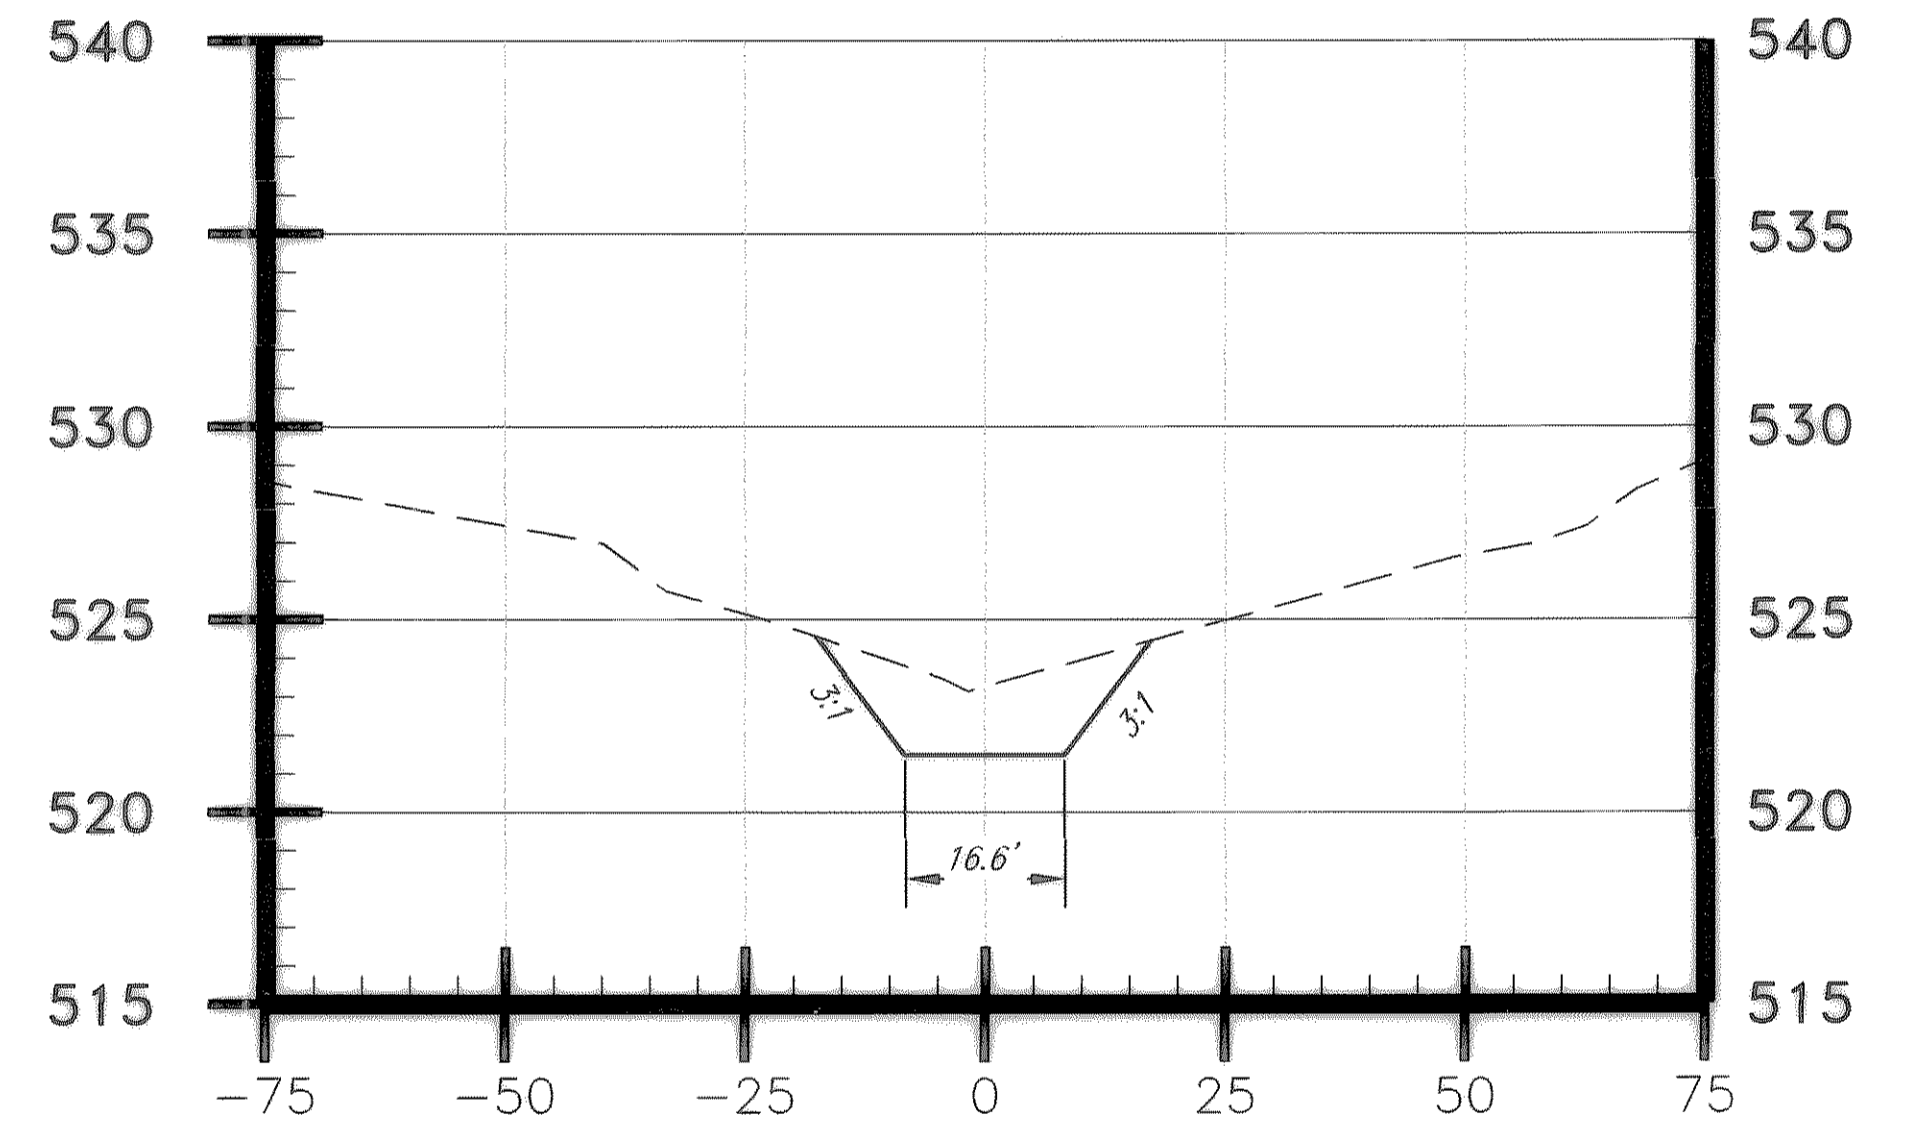

-1+22.54

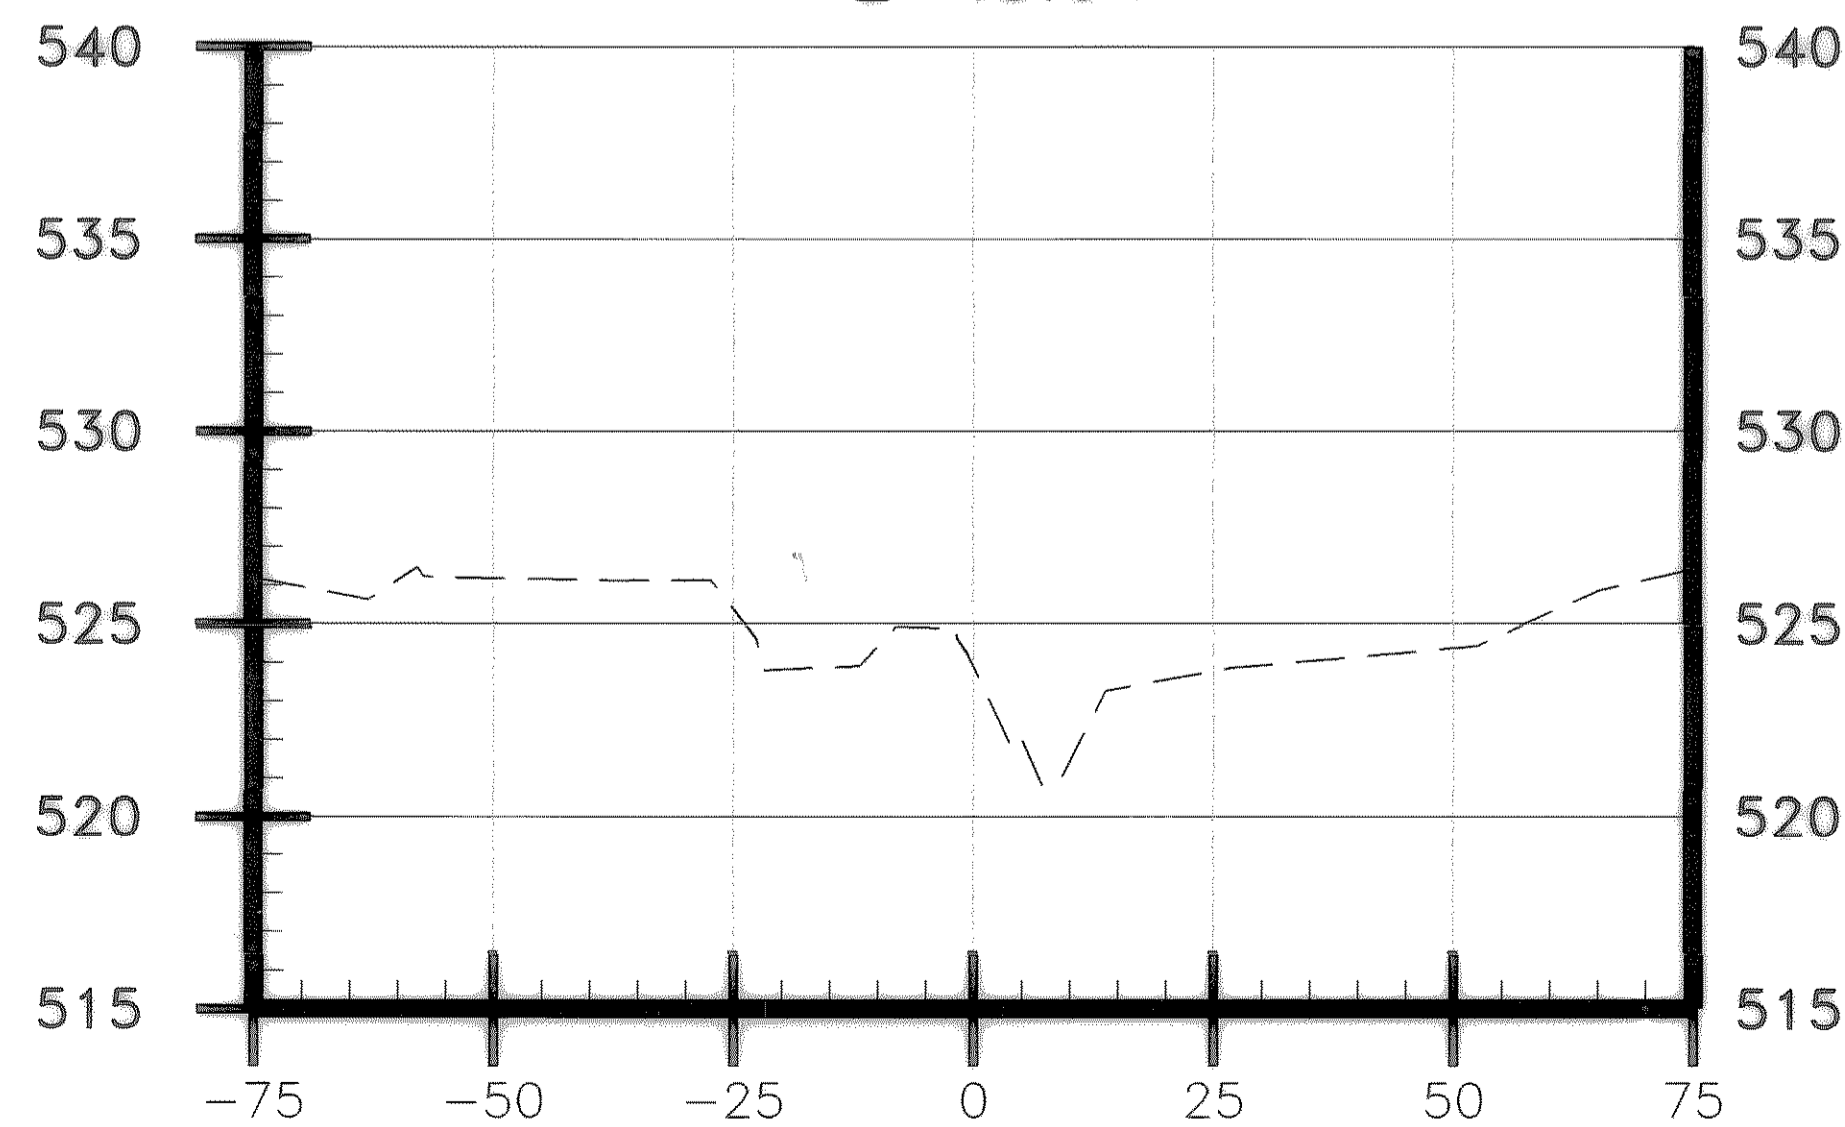

-2+47.54

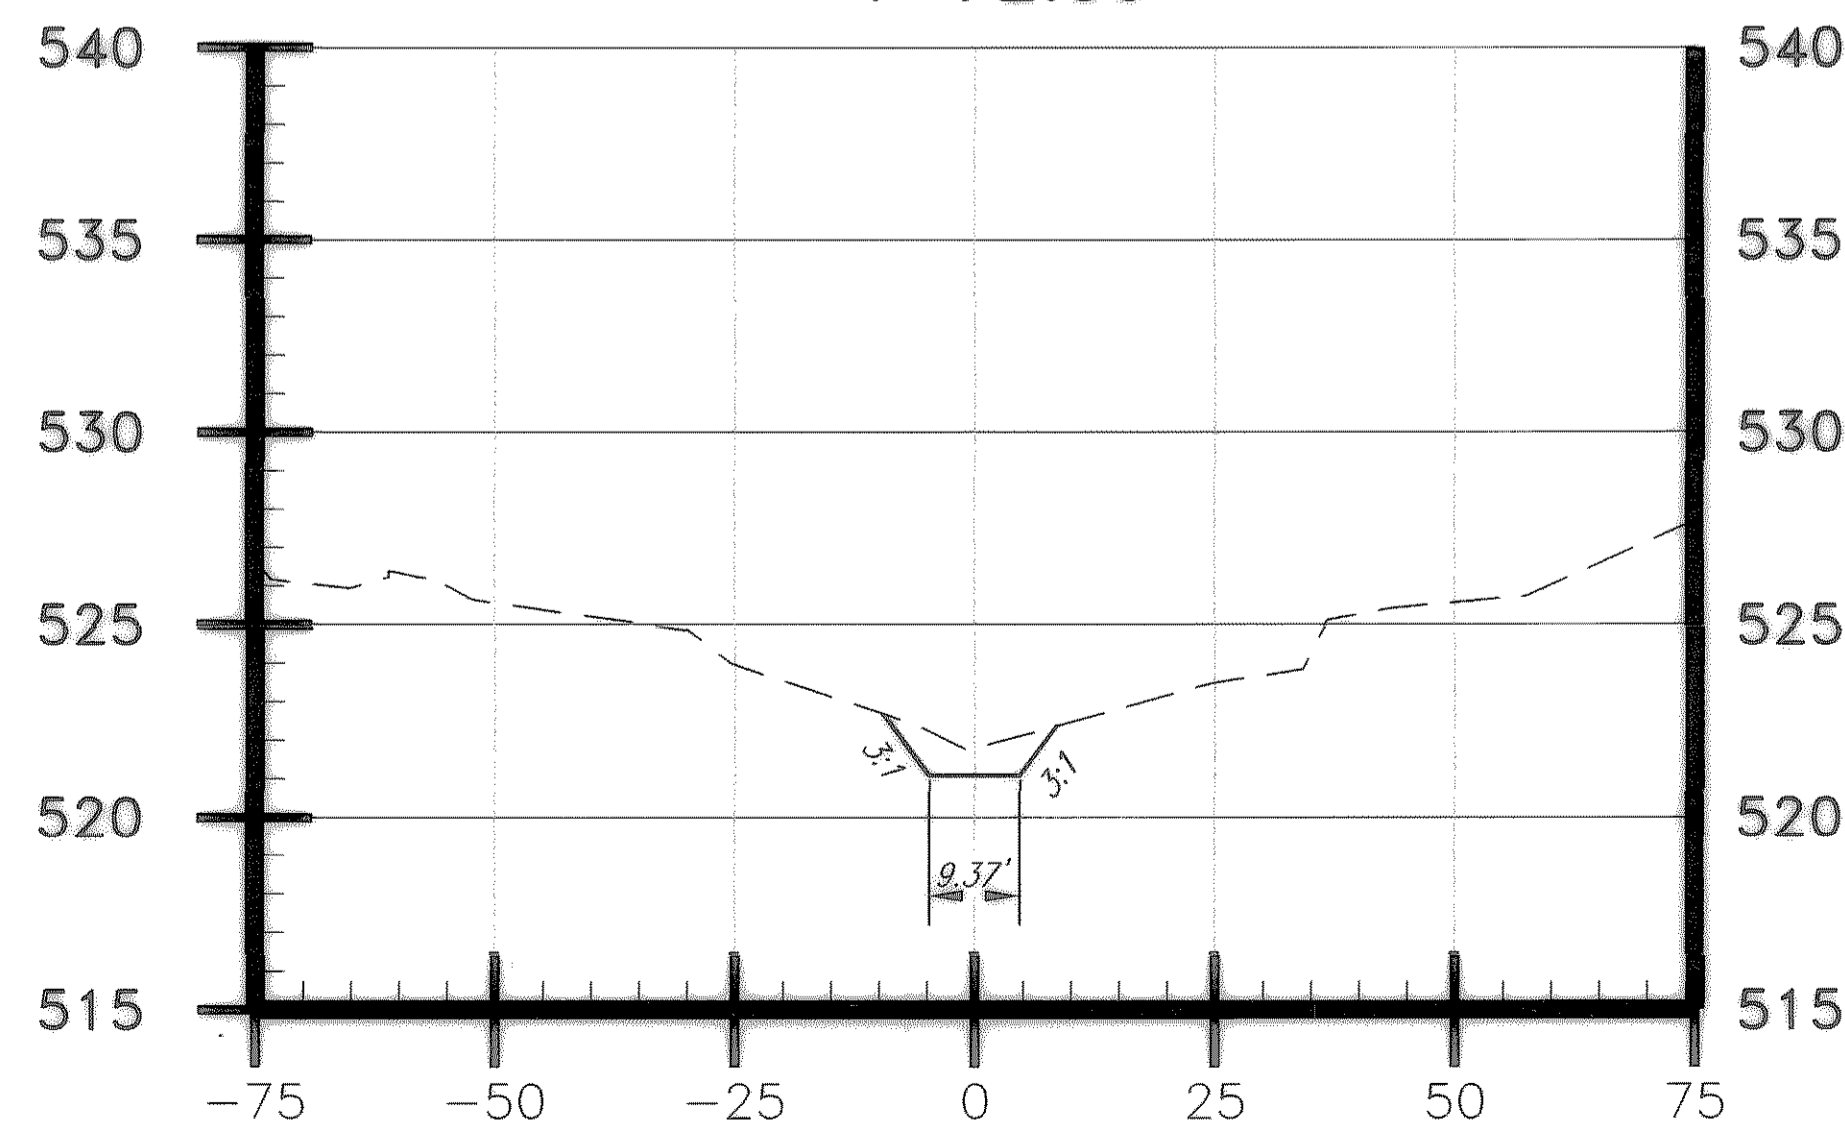


-1+97.54

REVISED TO CONFORM TO CONSTRUCTION RECORDS BY M.H. DATE 12/04/2006

These plans and related specifications were prepared for construction of this specific project only. Reuse of these documents is not permitted without written authorization of Birkhoff, Hendricks & Conway, L.L.P.

THESE DOCUMENTS ARE FOR BIDDING, CONSTRUCTION, AND PERMIT PURPOSES. DATE: 8/6/04

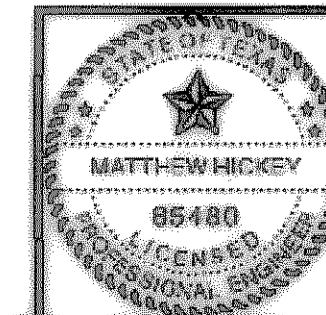

CITY OF ROCKWALL, TEXAS
CLARK STREET- CHANNEL 'E'
CROSS SECTIONS
BIRKHOFF, HENDRICKS & CONWAY, L.L.P.
CONSULTING ENGINEERS
Dallas, Texas
DESIGNED BY: M.H. PROJECT: 2003-120 SHEET NO. 81
DRAWN BY: R.J.L. DATE: AUGUST, 2004 OF X SHEETS