
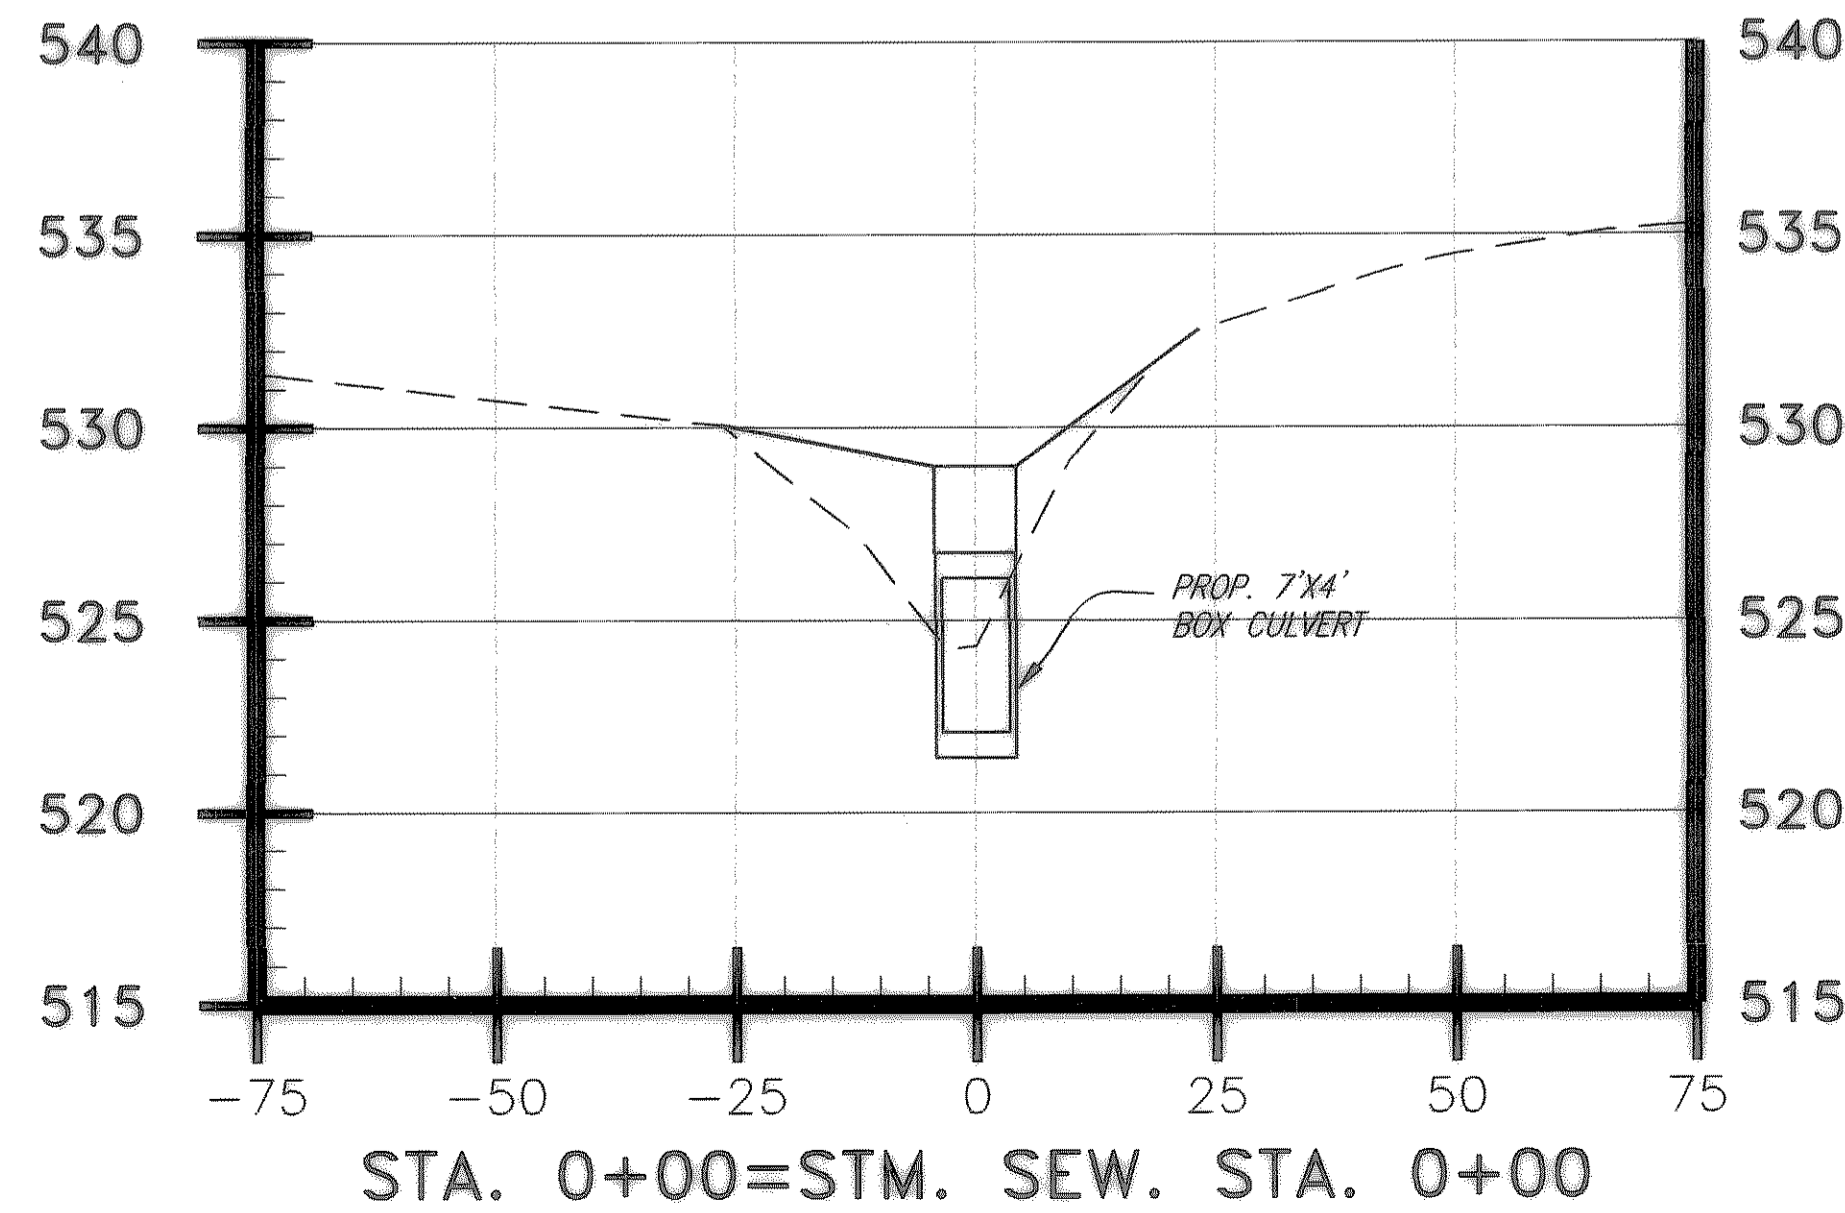
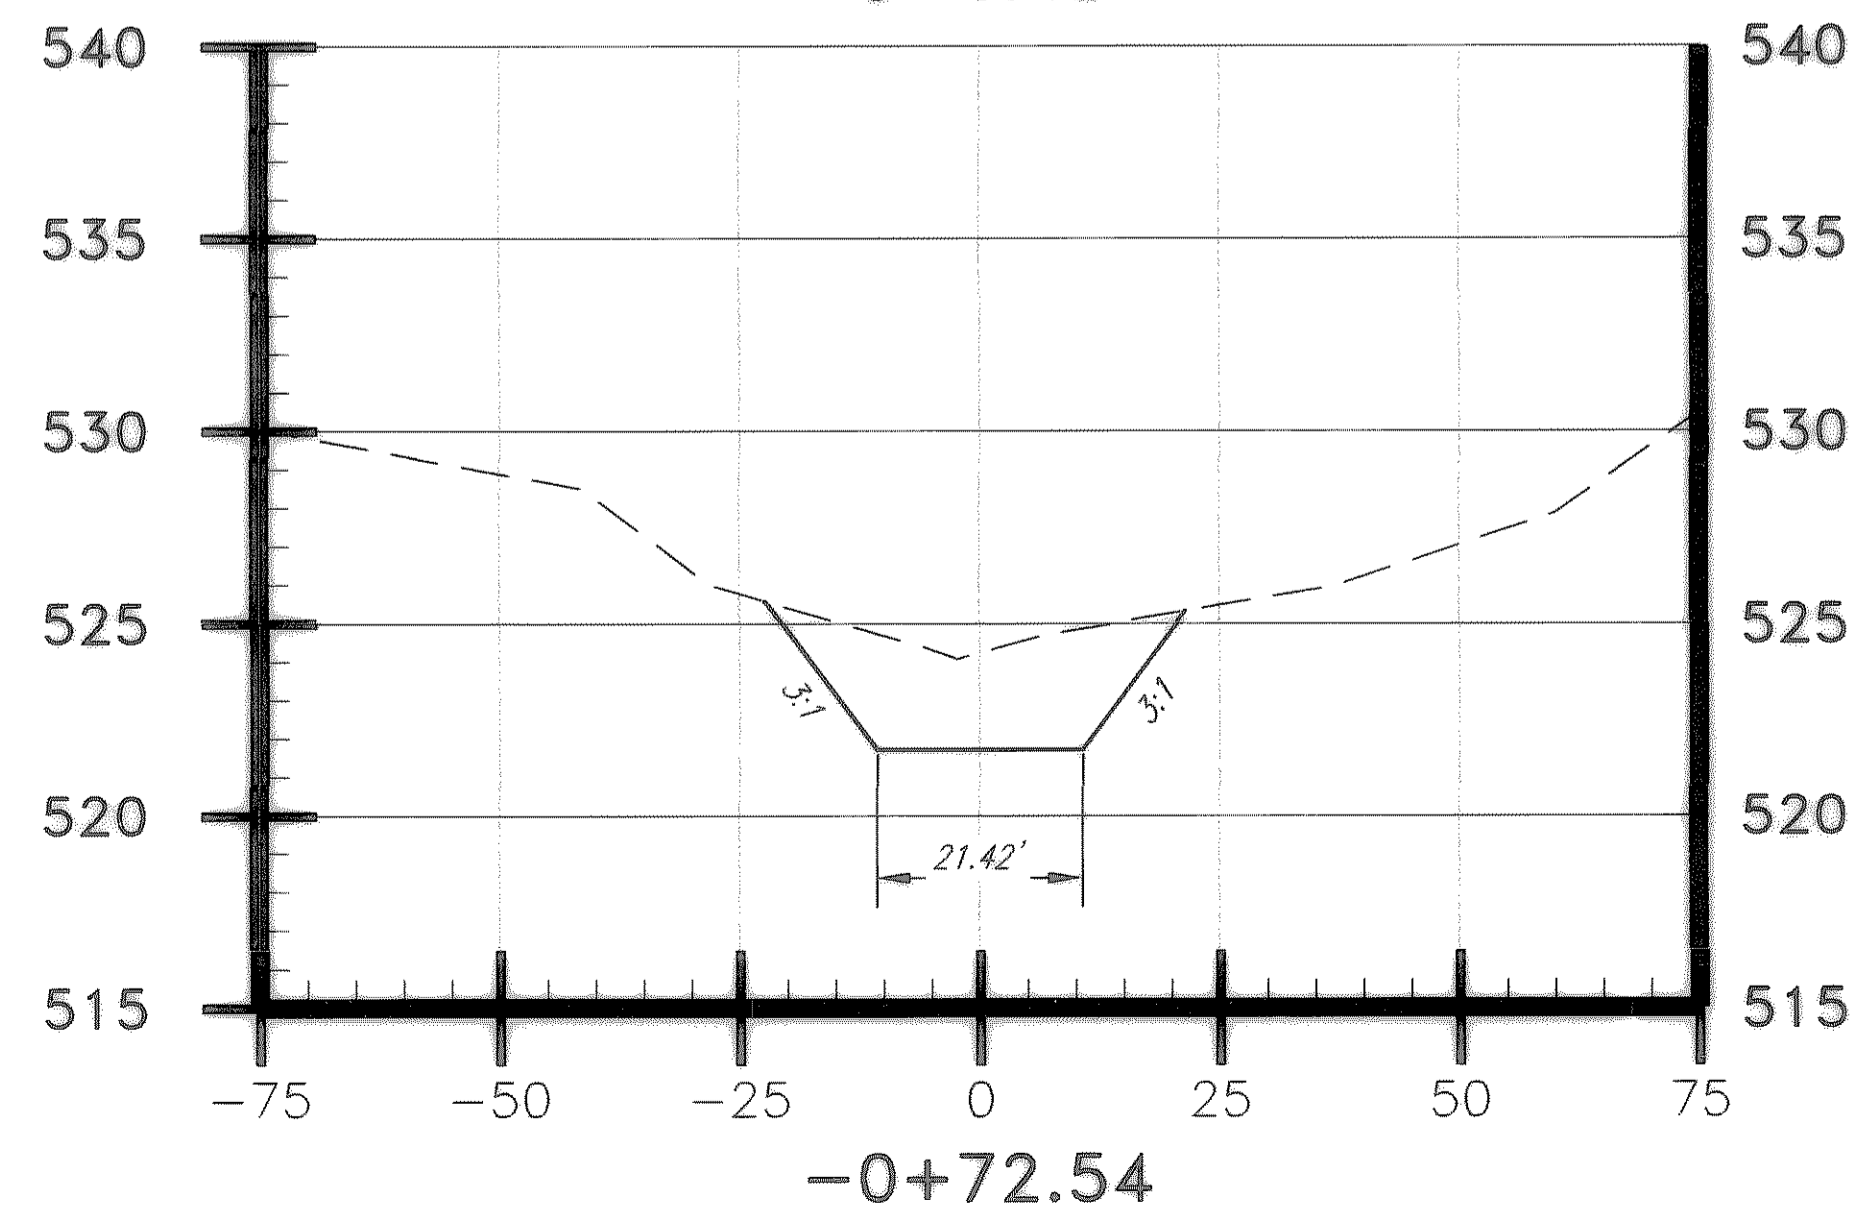
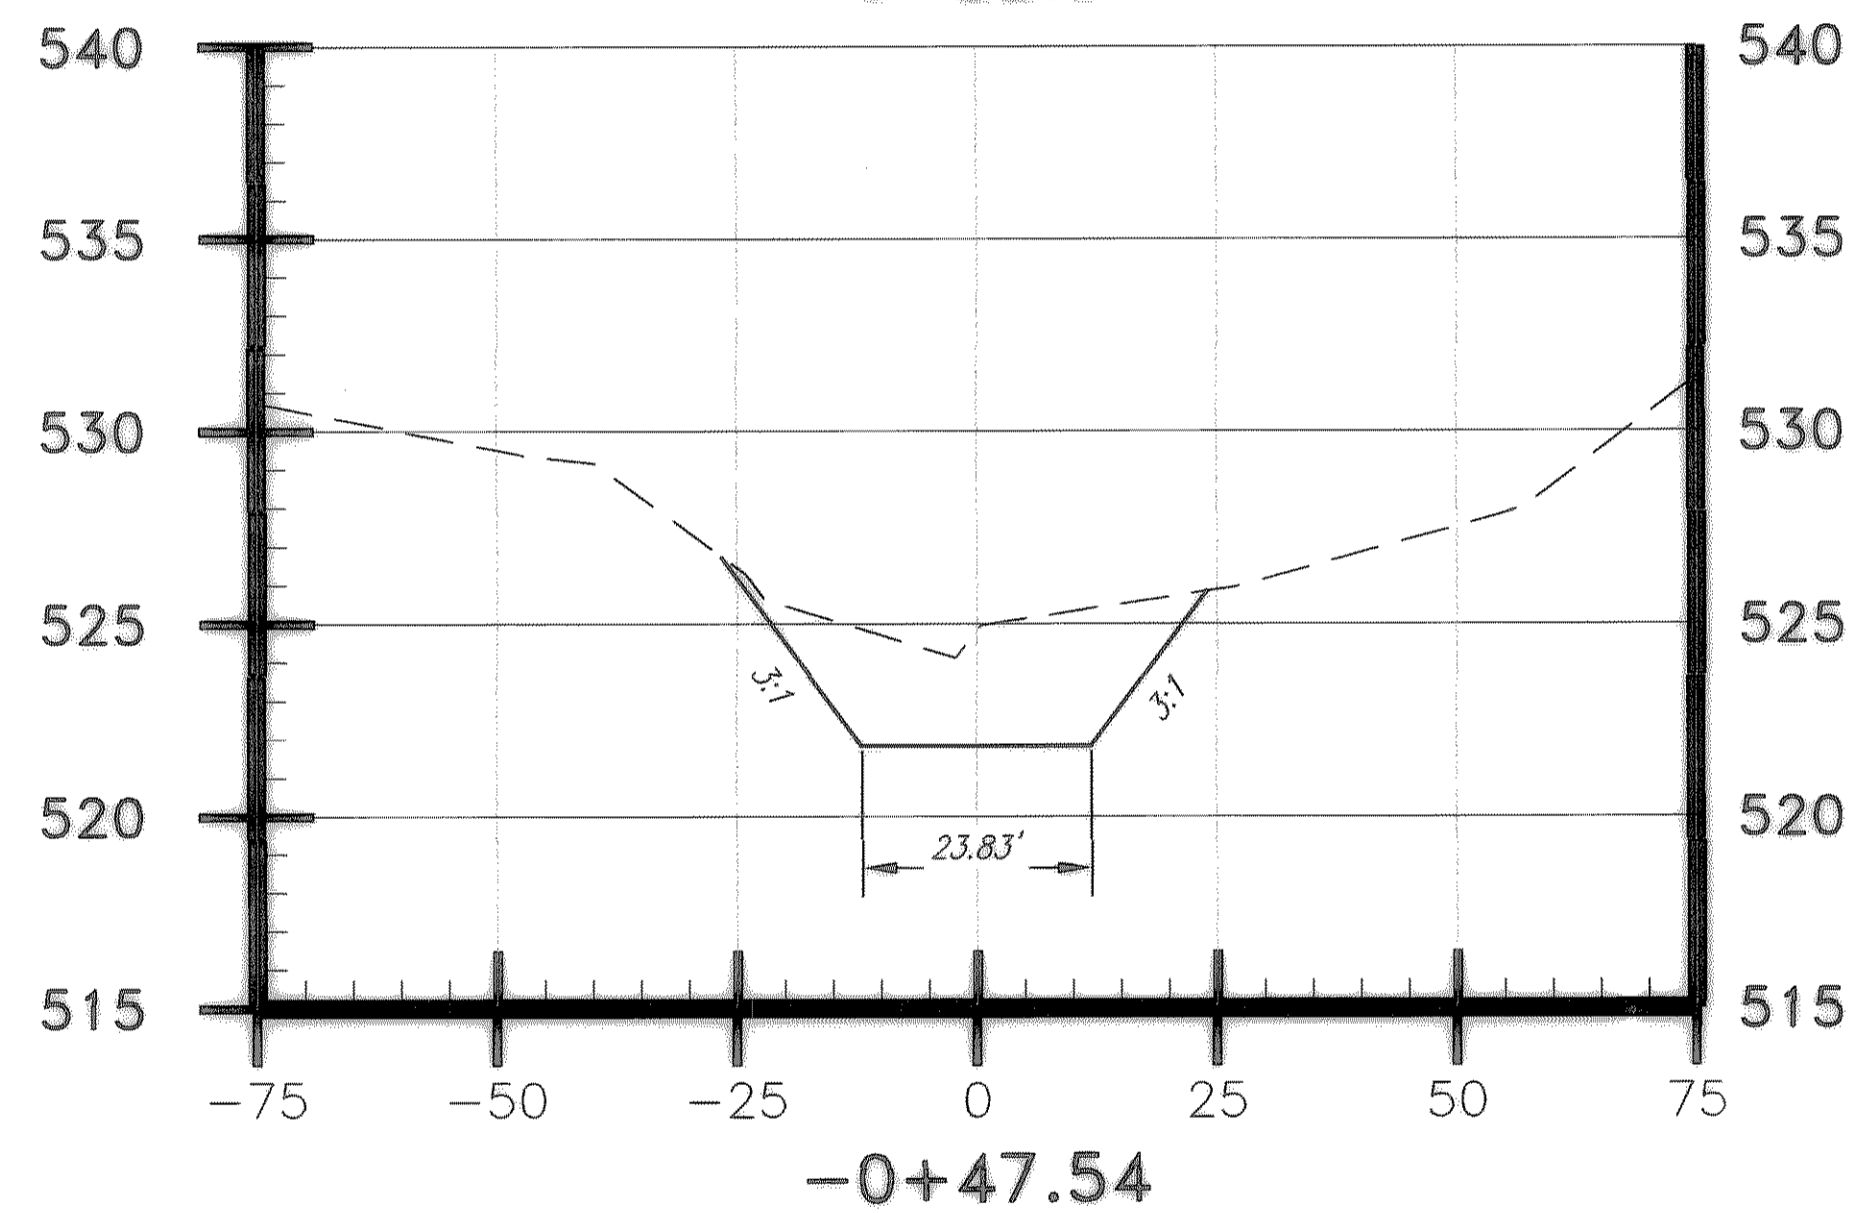



08/06/04 LBS H:\ROCKWALL\2003120\ROADS\CROSS-SEC\CHANNEL-E-XSECT.DWG SCALE: 1=20 XREF: ROCKWALL\2003120\BASE\PROP-BASE

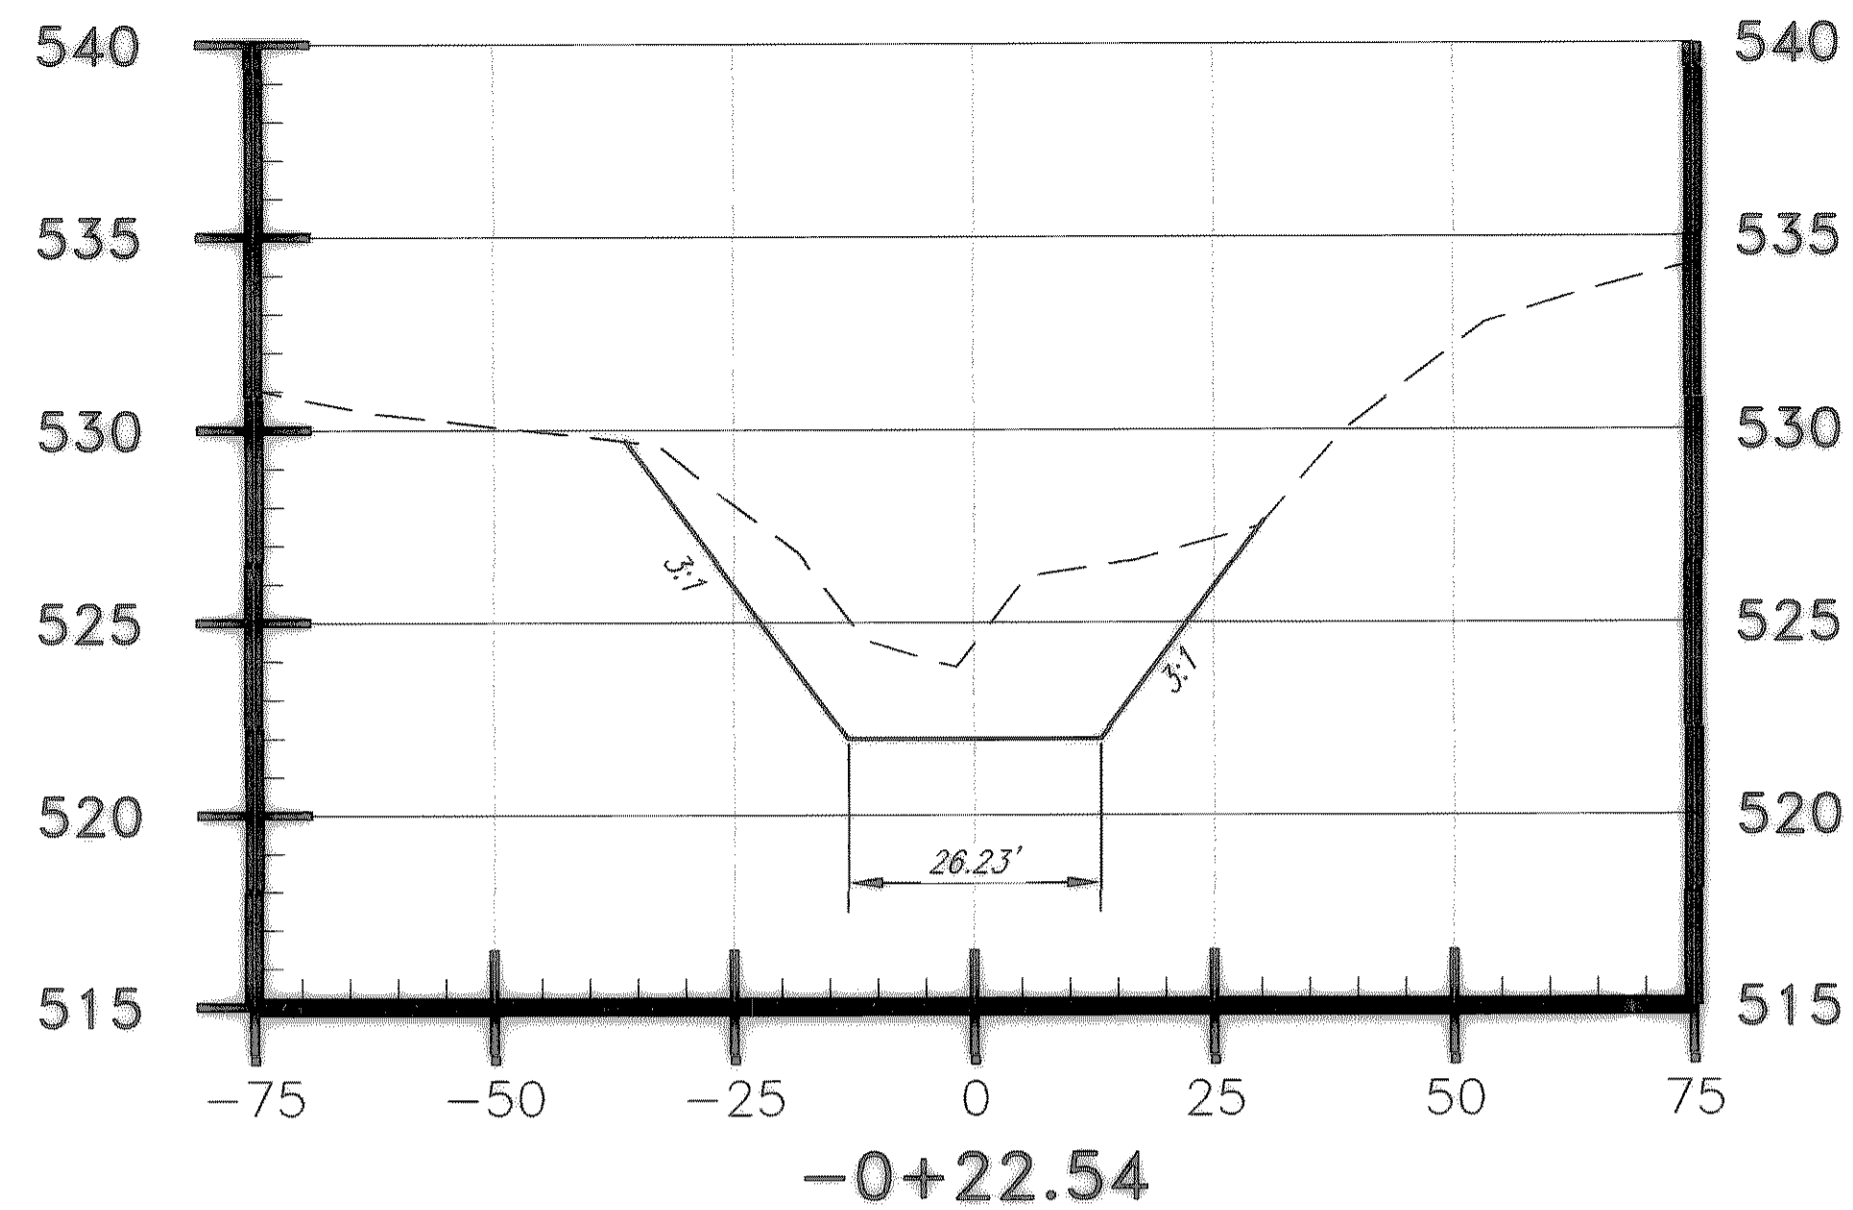

REVISED TO CONFORM
 TO CONSTRUCTION RECORDS
 BY M.H. DATE 12/04/2006

These plans and related specifications
 were prepared for construction of this
 specific project only. Reuse of these
 documents is not permitted without
 written authorization of Birkhoff,
 Hendricks & Conway, L.L.P.

THESE DOCUMENTS ARE FOR
 BIDDING, CONSTRUCTION,
 AND PERMIT PURPOSES.
Matthew Hickey
 DATE: 8/6/07

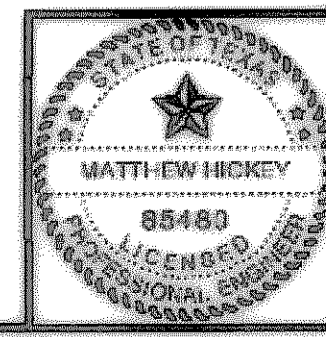

CITY OF ROCKWALL, TEXAS			
CLARK STREET- CHANNEL 'E'			
CROSS SECTIONS			
BIRKHOFF, HENDRICKS & CONWAY, L.L.P.			
<small>CONSULTING ENGINEERS Dallas, Texas</small>			
DESIGNED BY:	M.H.	PROJECT:	2003-120
DRAWN BY:	R.J.L.	DATE:	AUGUST, 2004
		SHEET NO.	82
		OF	X SHEETS