




H:\ROCKWALL\2003\20\INROADS\GROSS-SEC\CLARK-X\SECT.DWG SCALE: 1=20 XREF: ROCKWALL\2003\120\BASE\PROP-BASE 06/22/04 CAG

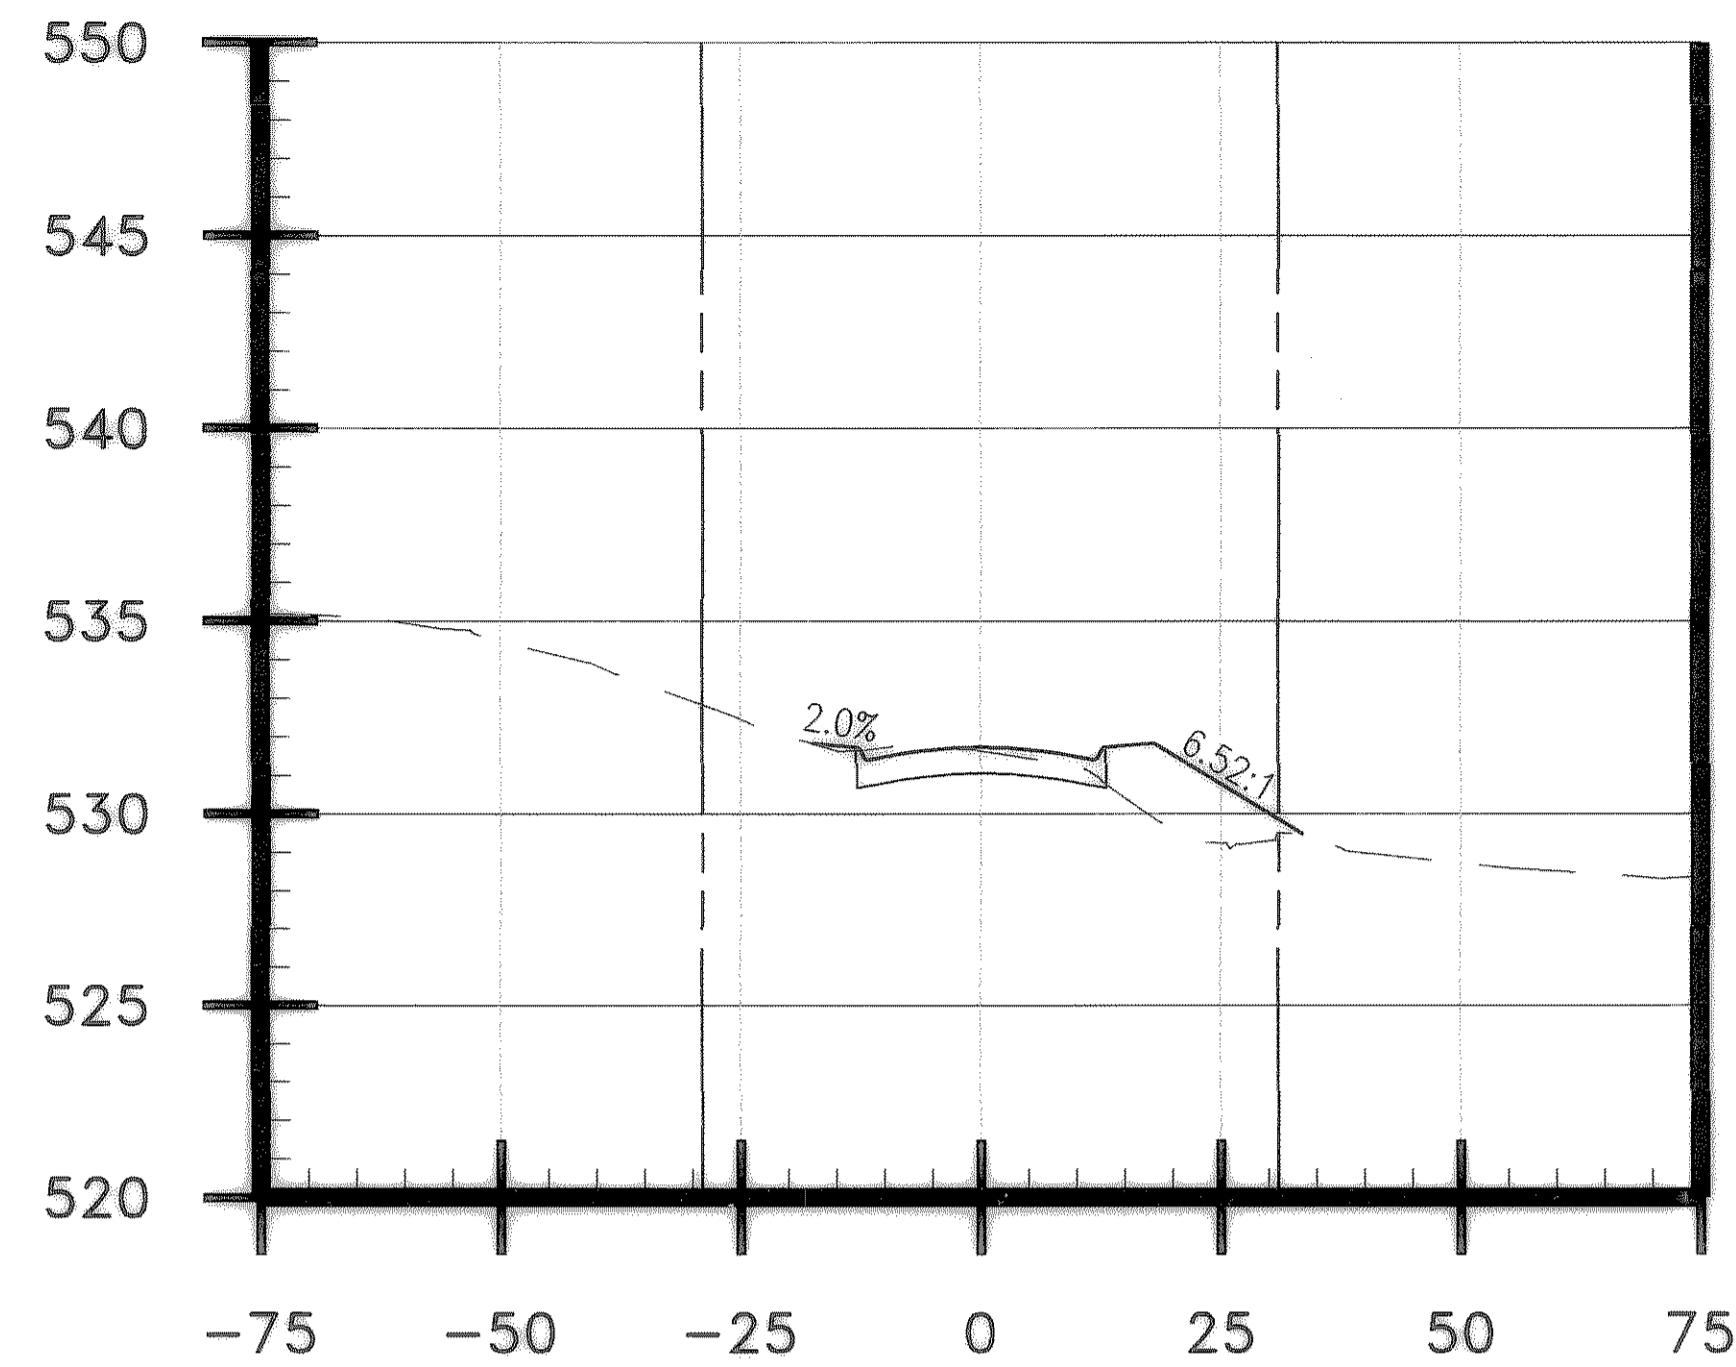


3+25

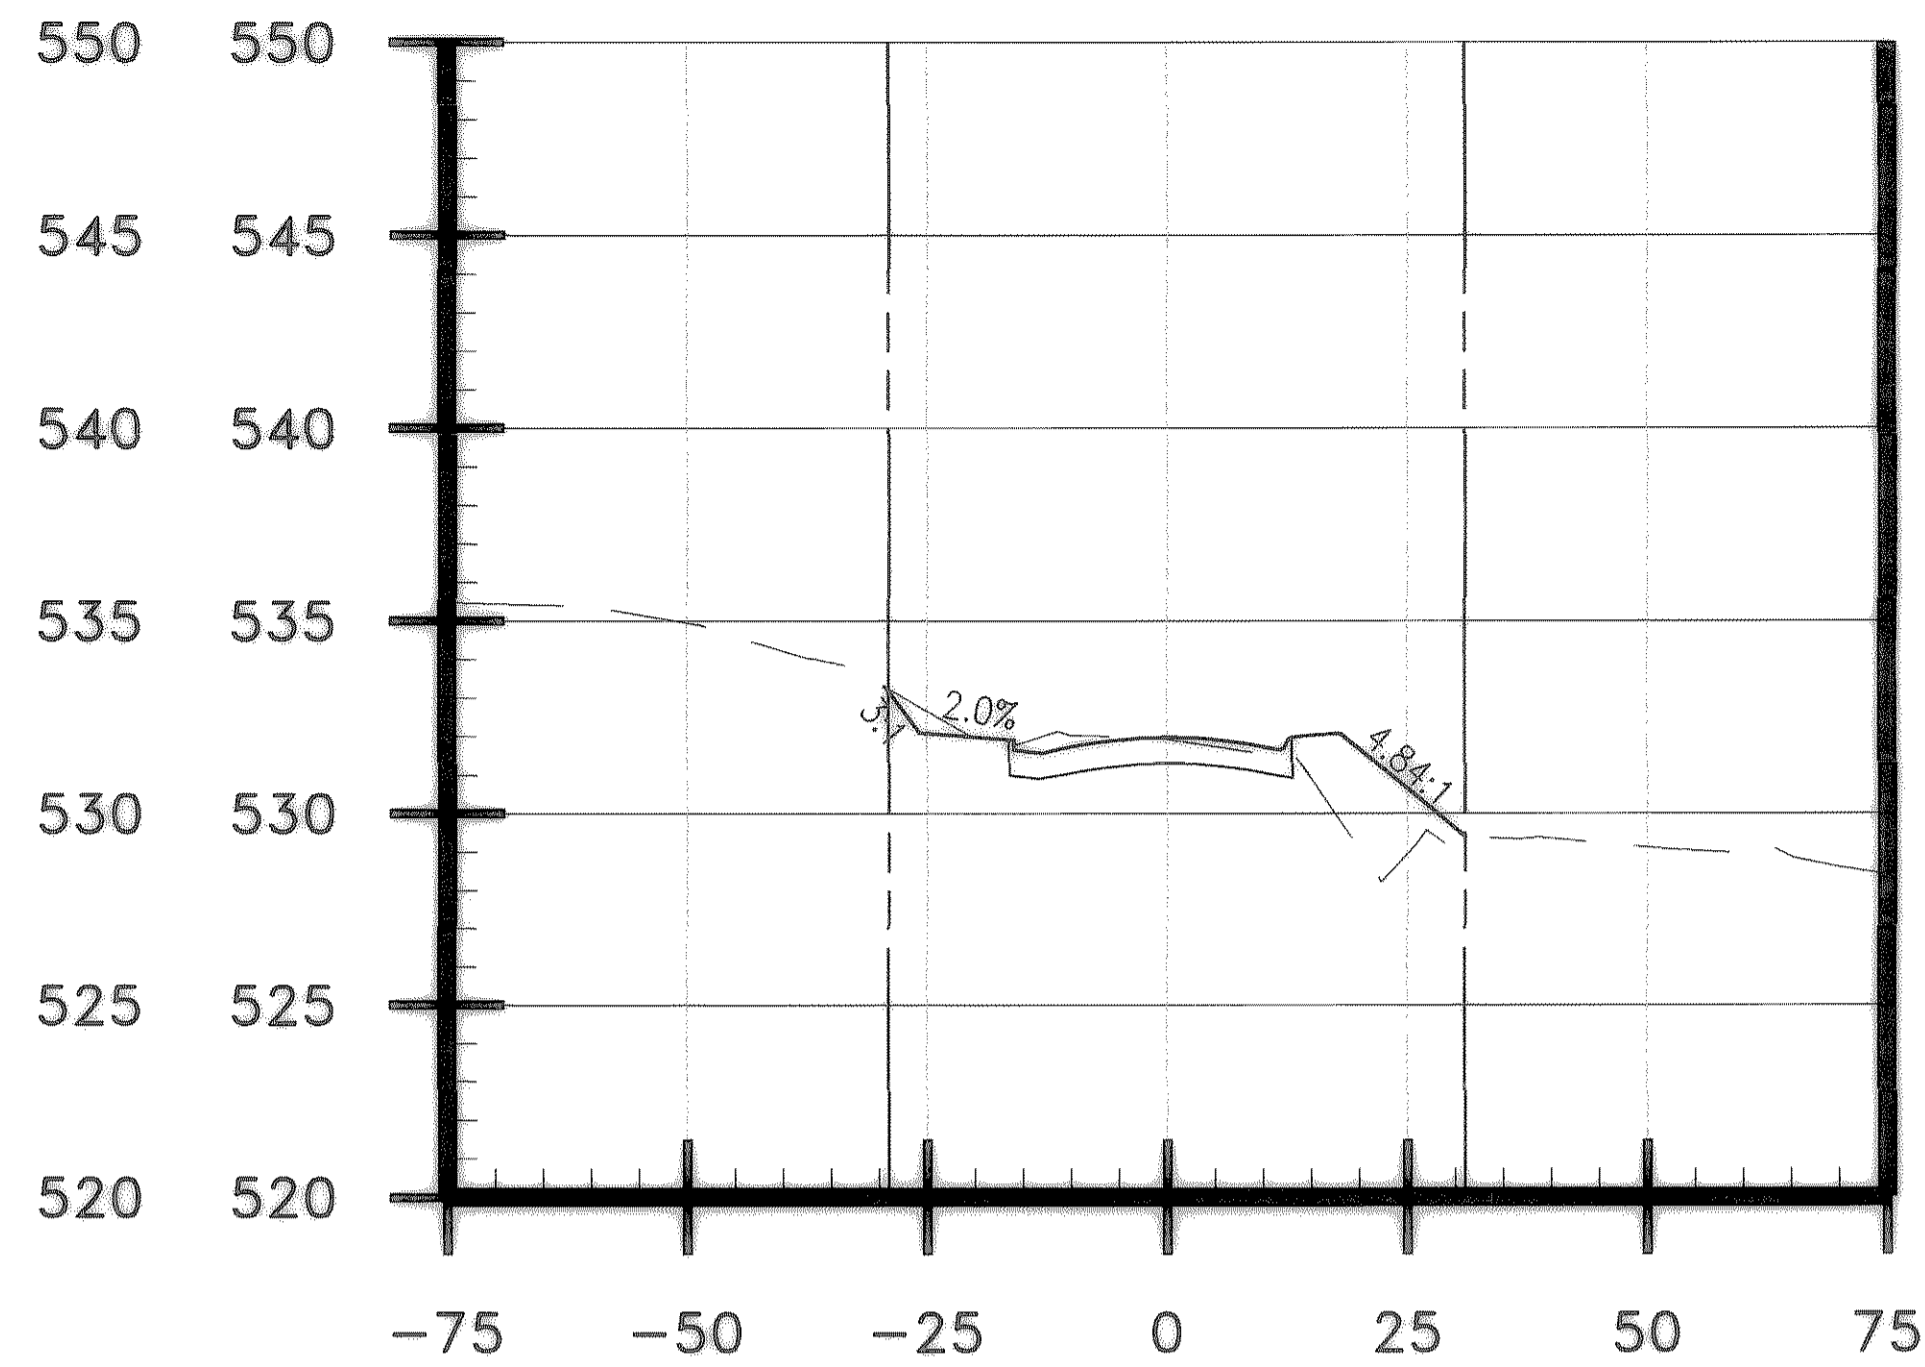


3+75

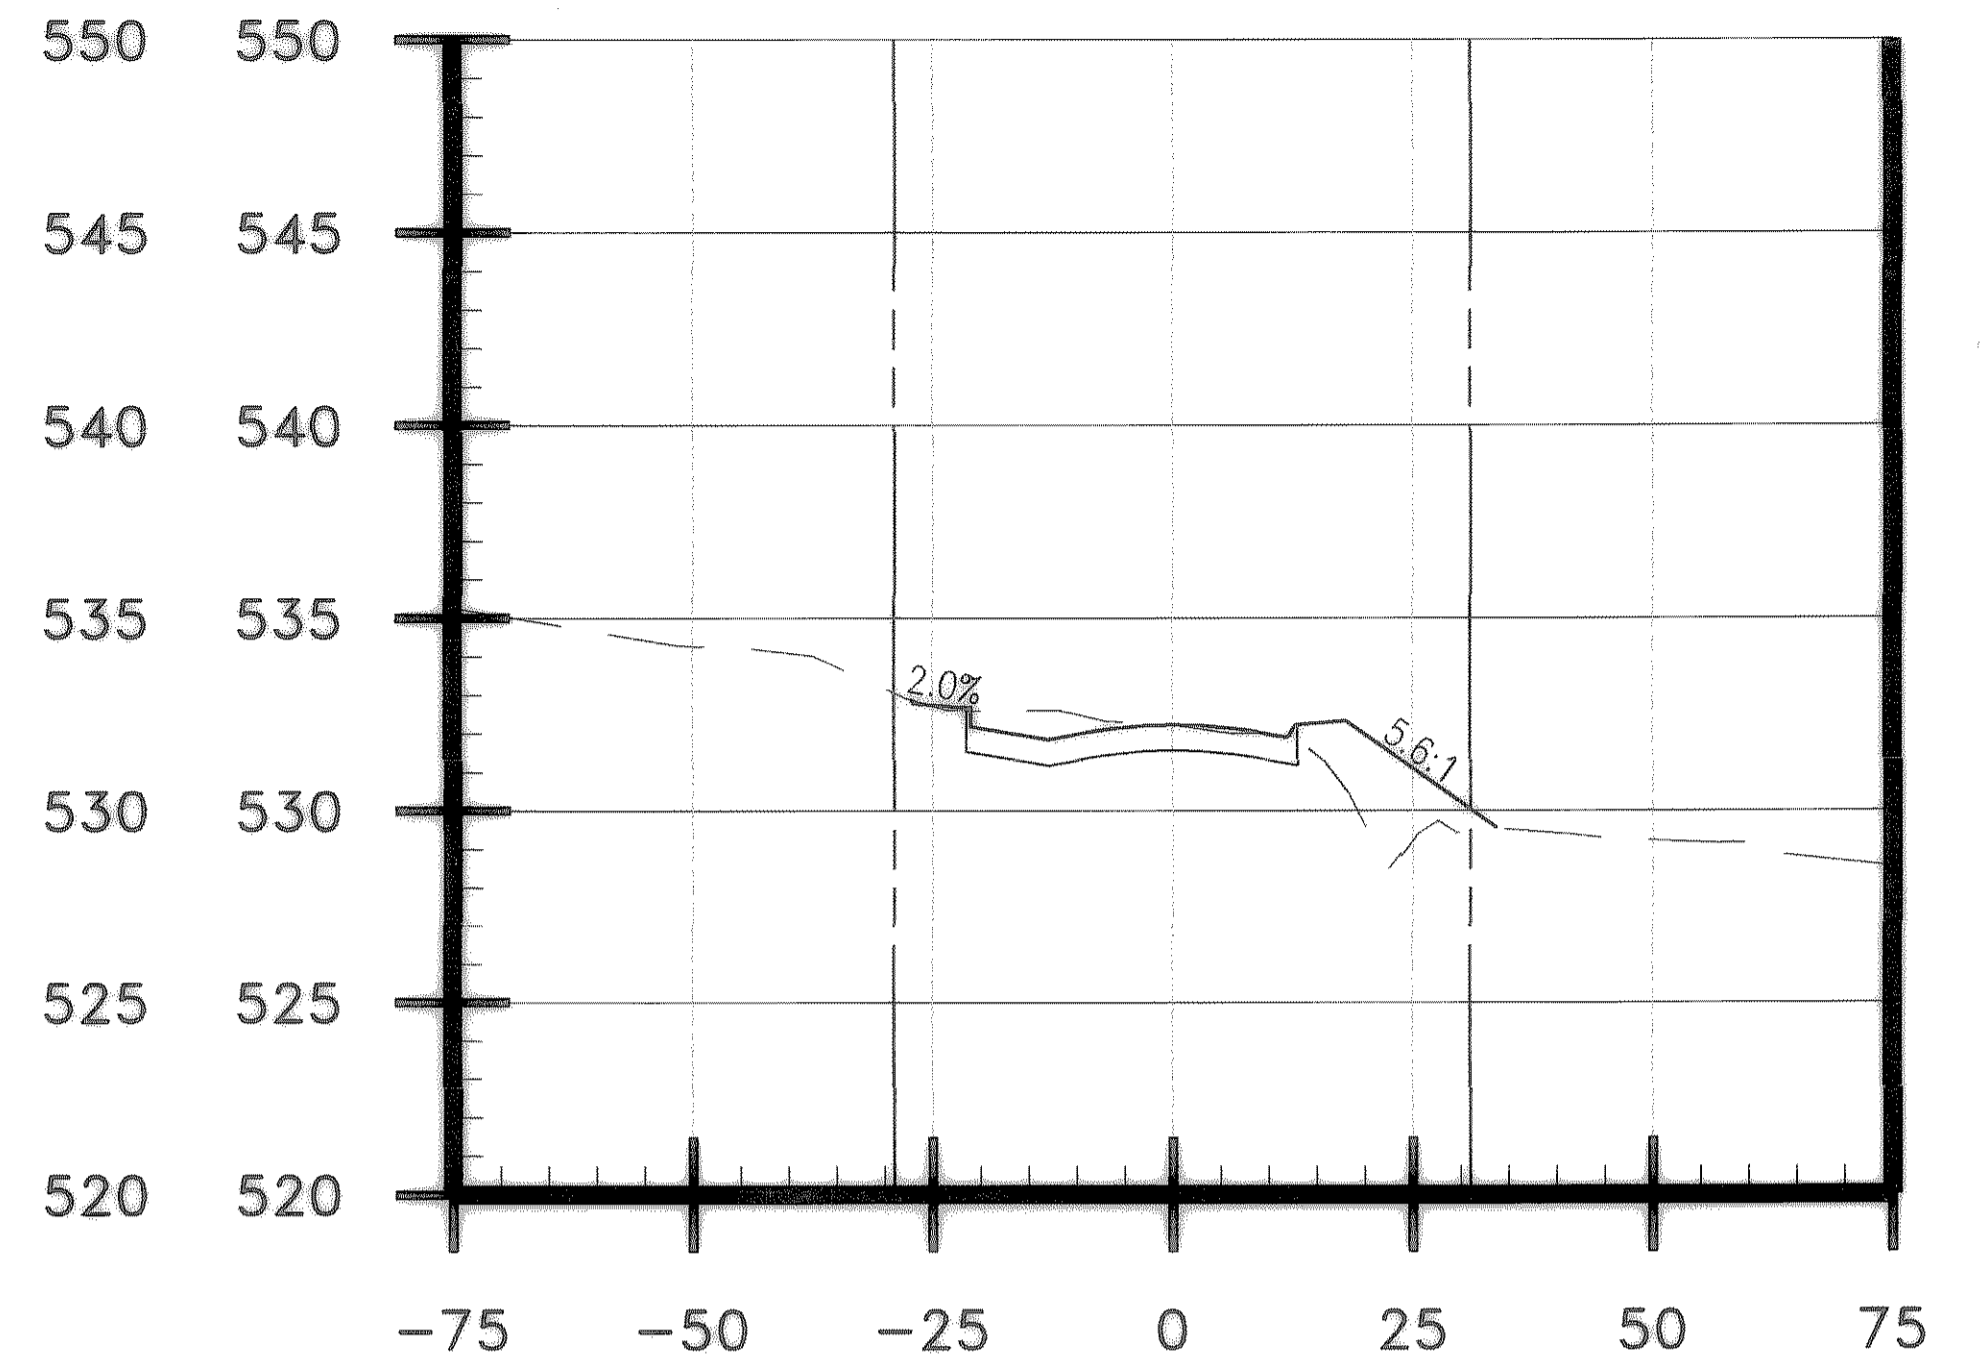


4+25

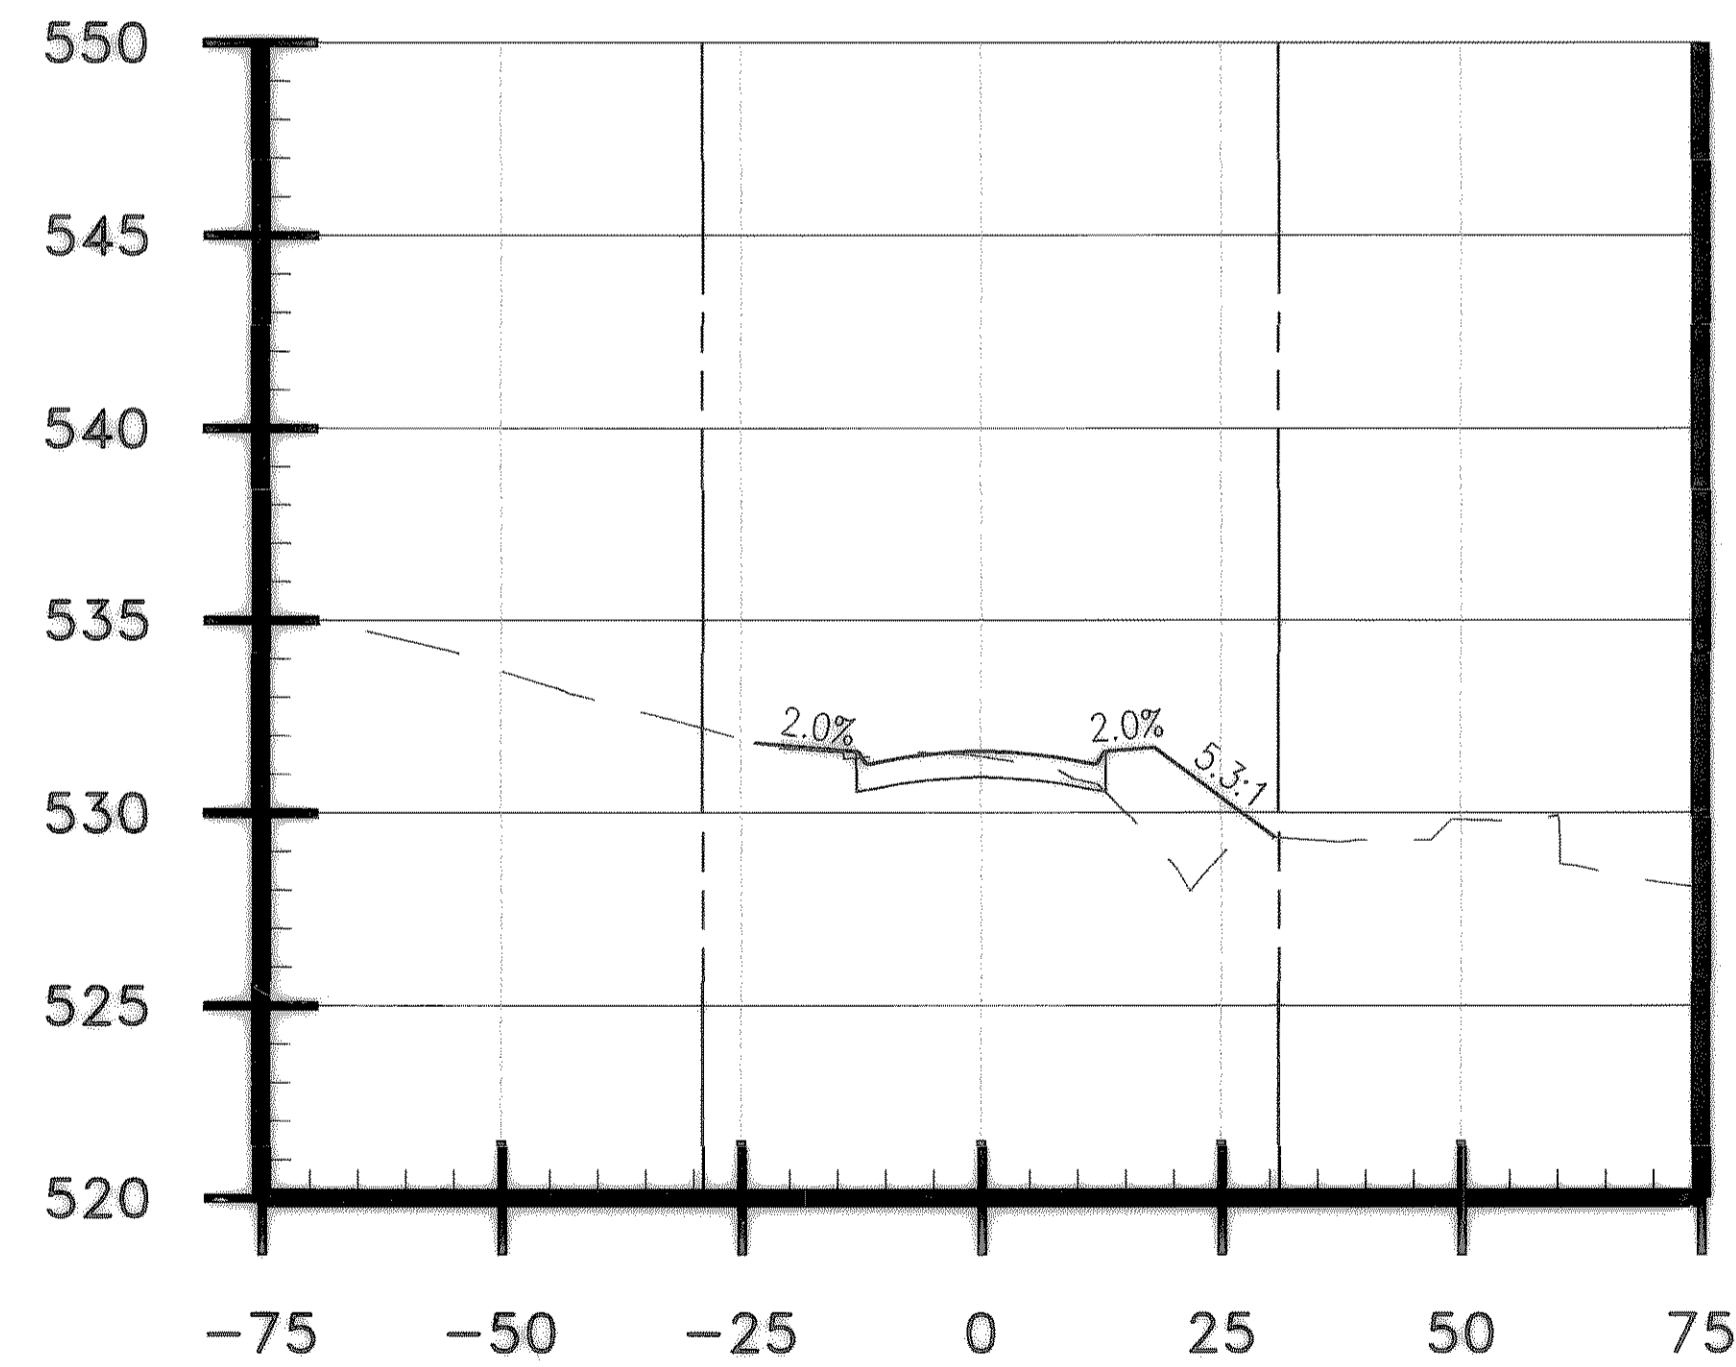

3+00

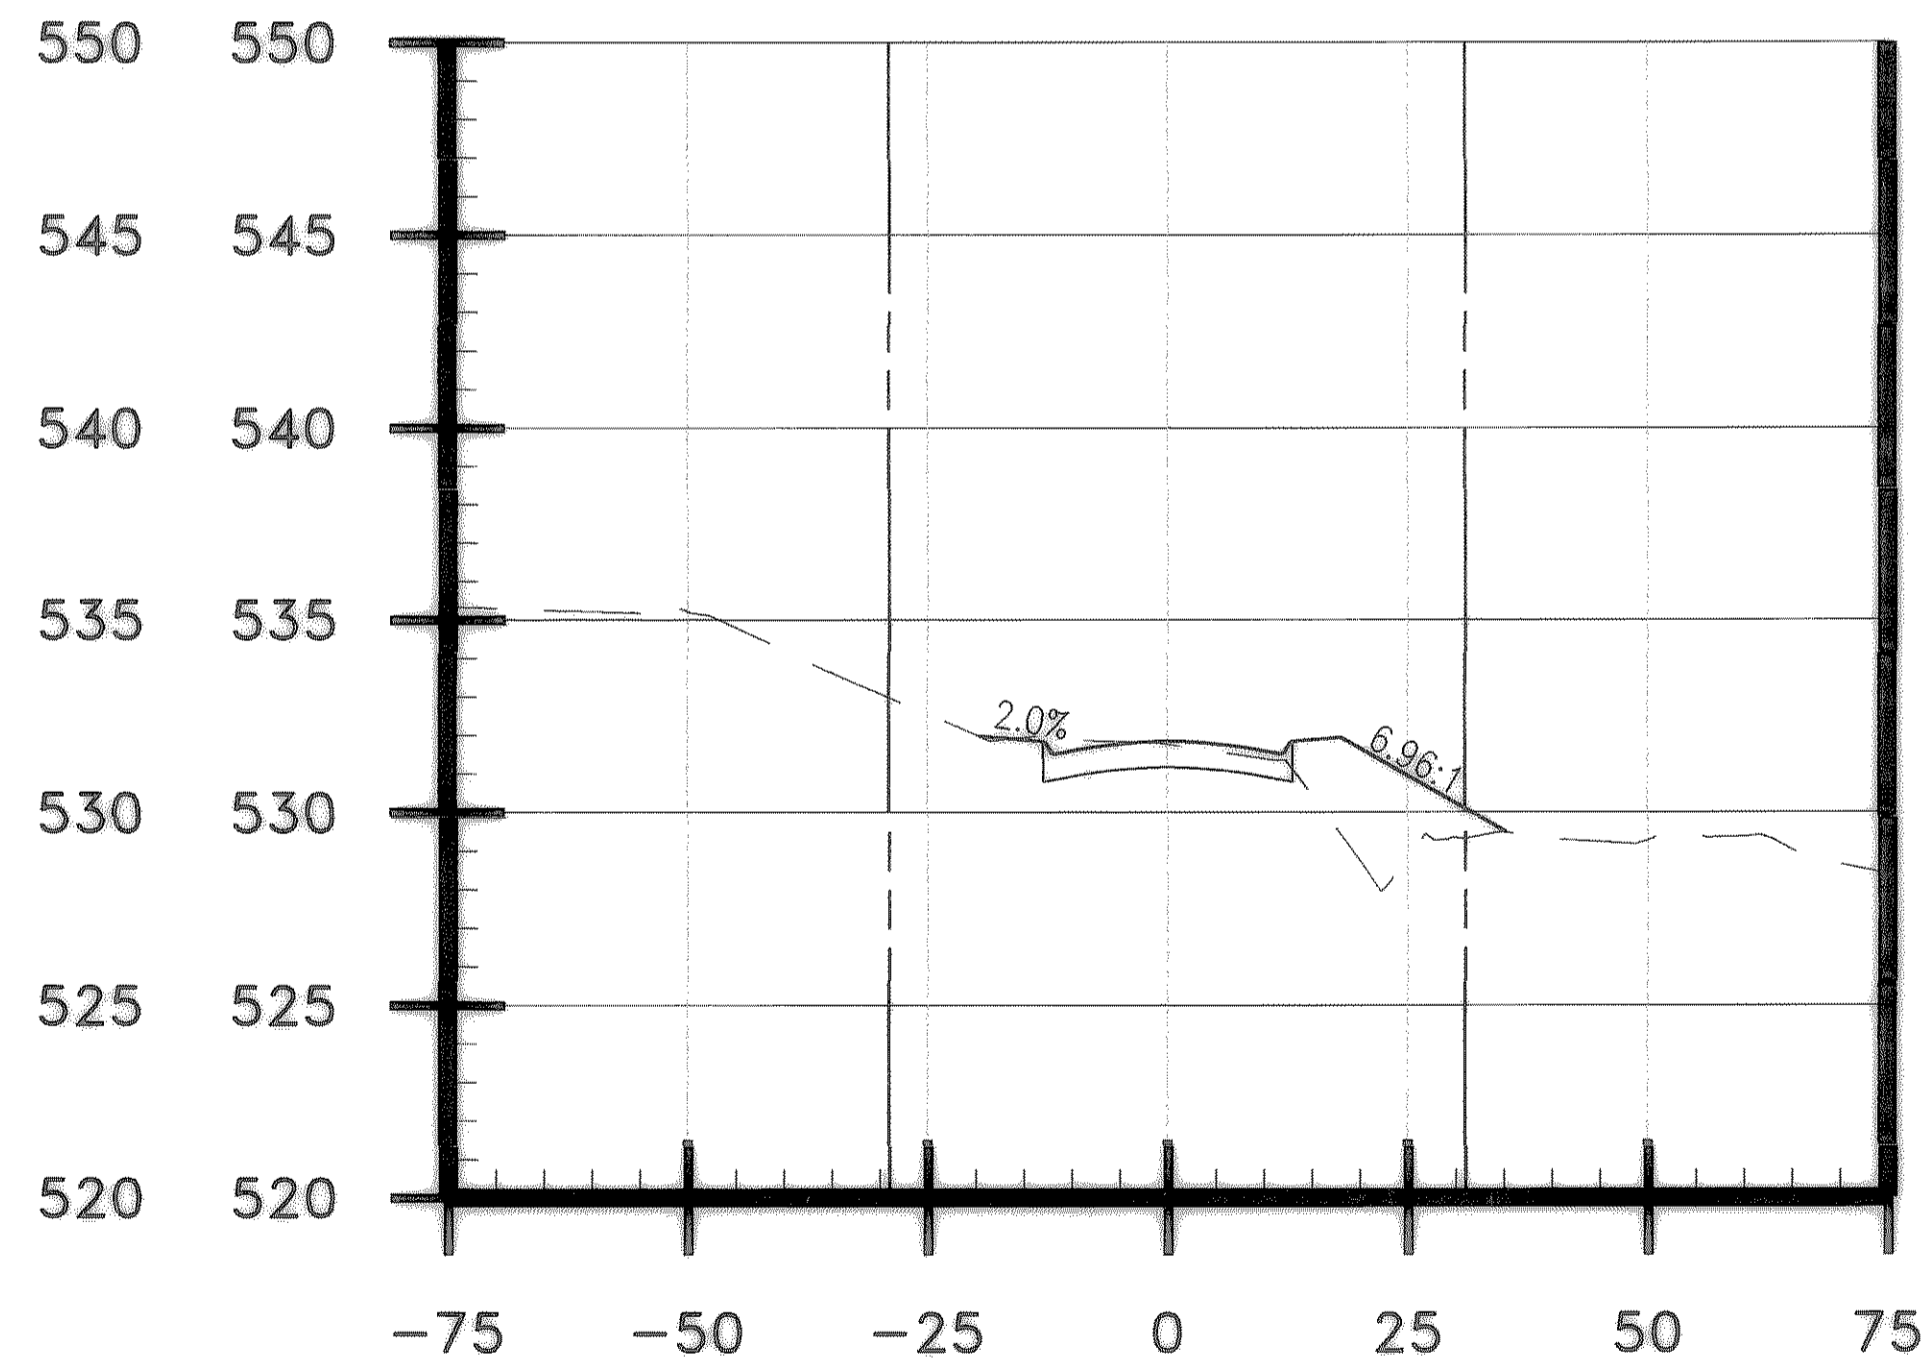

3+50

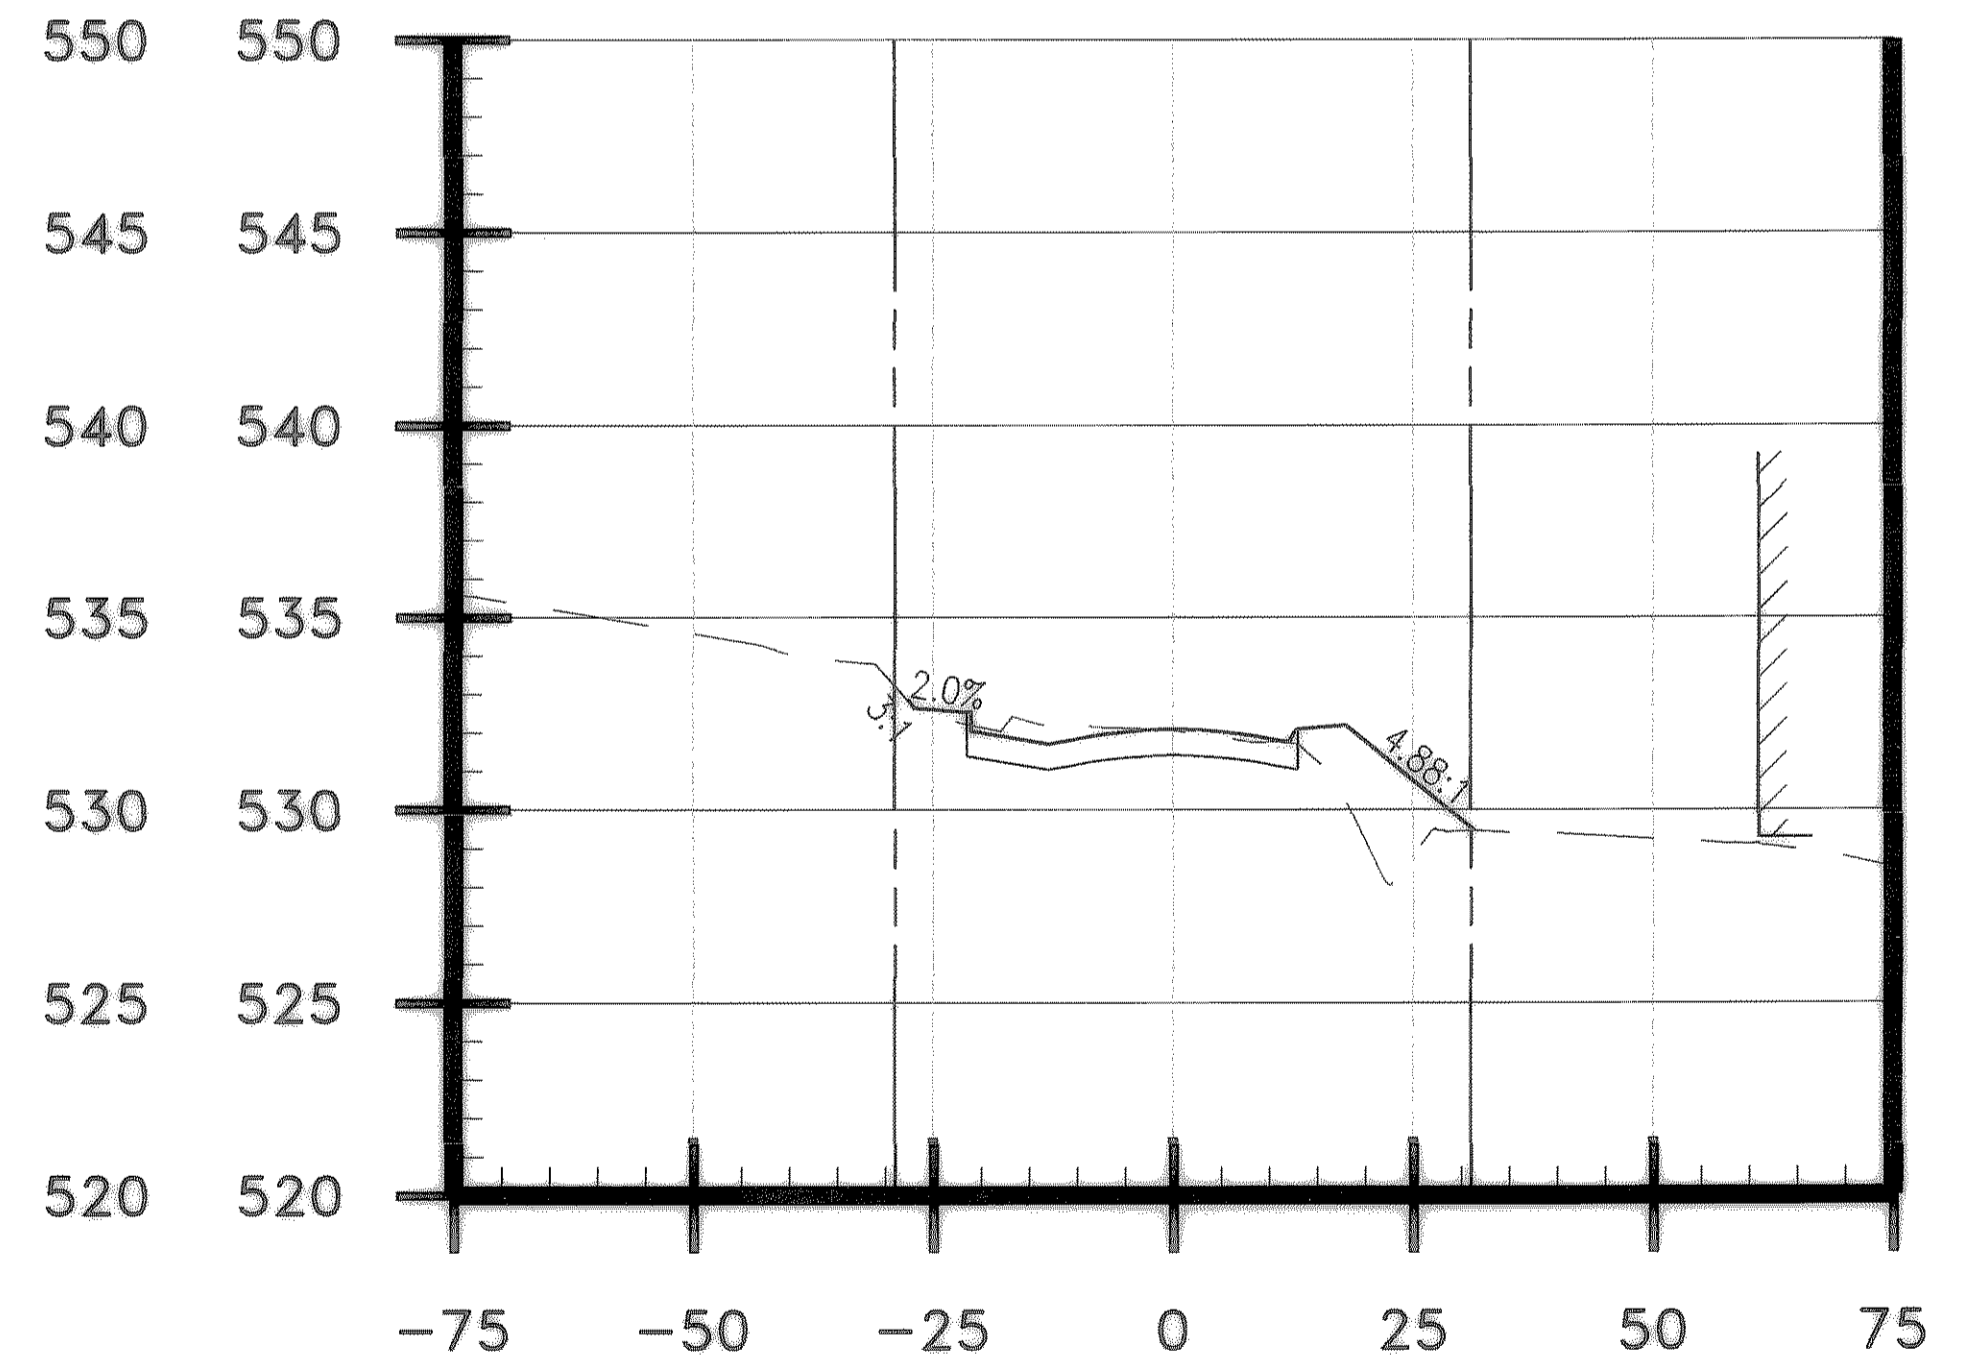

4+00

These plans and related specifications were prepared for construction of this specific project only. Reuse of these documents is not permitted without written authorization of Birkhoff, Hendricks & Conway, L.L.P.


CITY OF ROCKWALL, TEXAS

CLARK STREET CROSS SECTIONS

BIRKHOFF, HENDRICKS & CONWAY, L.L.P.
CONSULTING ENGINEERS
Dallas, Texas

REVISED TO CONFORM TO CONSTRUCTION RECORDS
BY M.H. DATE 12/04/2006

THESE DOCUMENTS ARE FOR BIDDING, CONSTRUCTION, AND PERMIT PURPOSES.
Matthew Hickey
DATE: 8/16/04

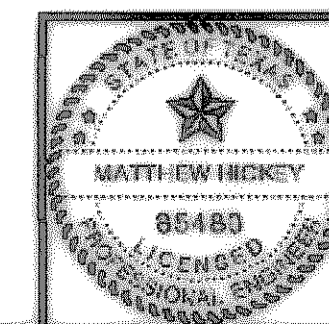

DESIGNED BY: M.H. PROJECT: 2003-120
DRAWN BY: B.H.C. DATE: AUGUST, 2004
SHEET NO. 118 OF 118 SHEETS