




H:\ROCKWALL\2003120\WROADS\CROSS-SEC\CLARK-XSECT.DWG SCALE: 1=20 XREF: ROCKWALL\2003120\BASE\PROP-BASE 06/22/04 CAG

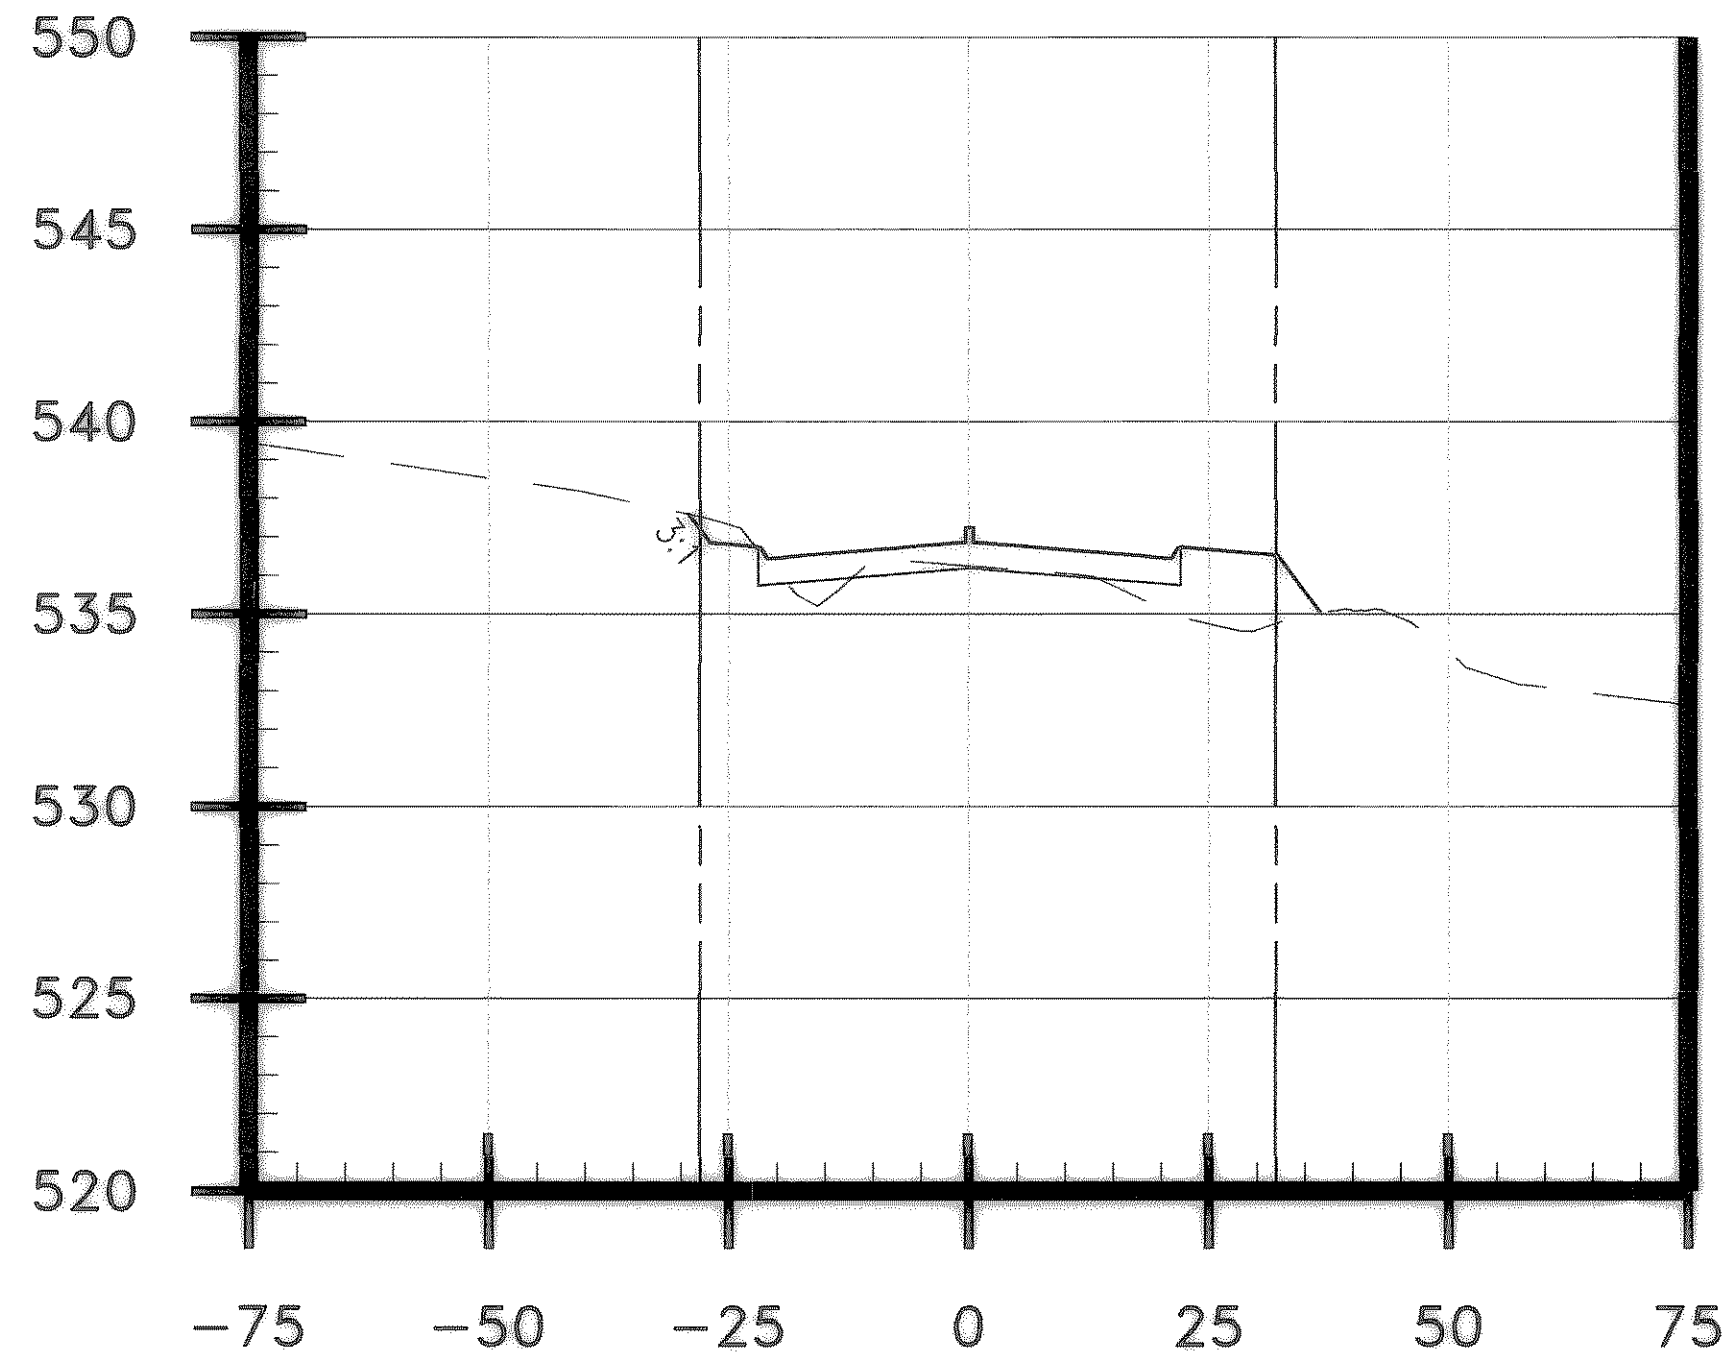


7+75

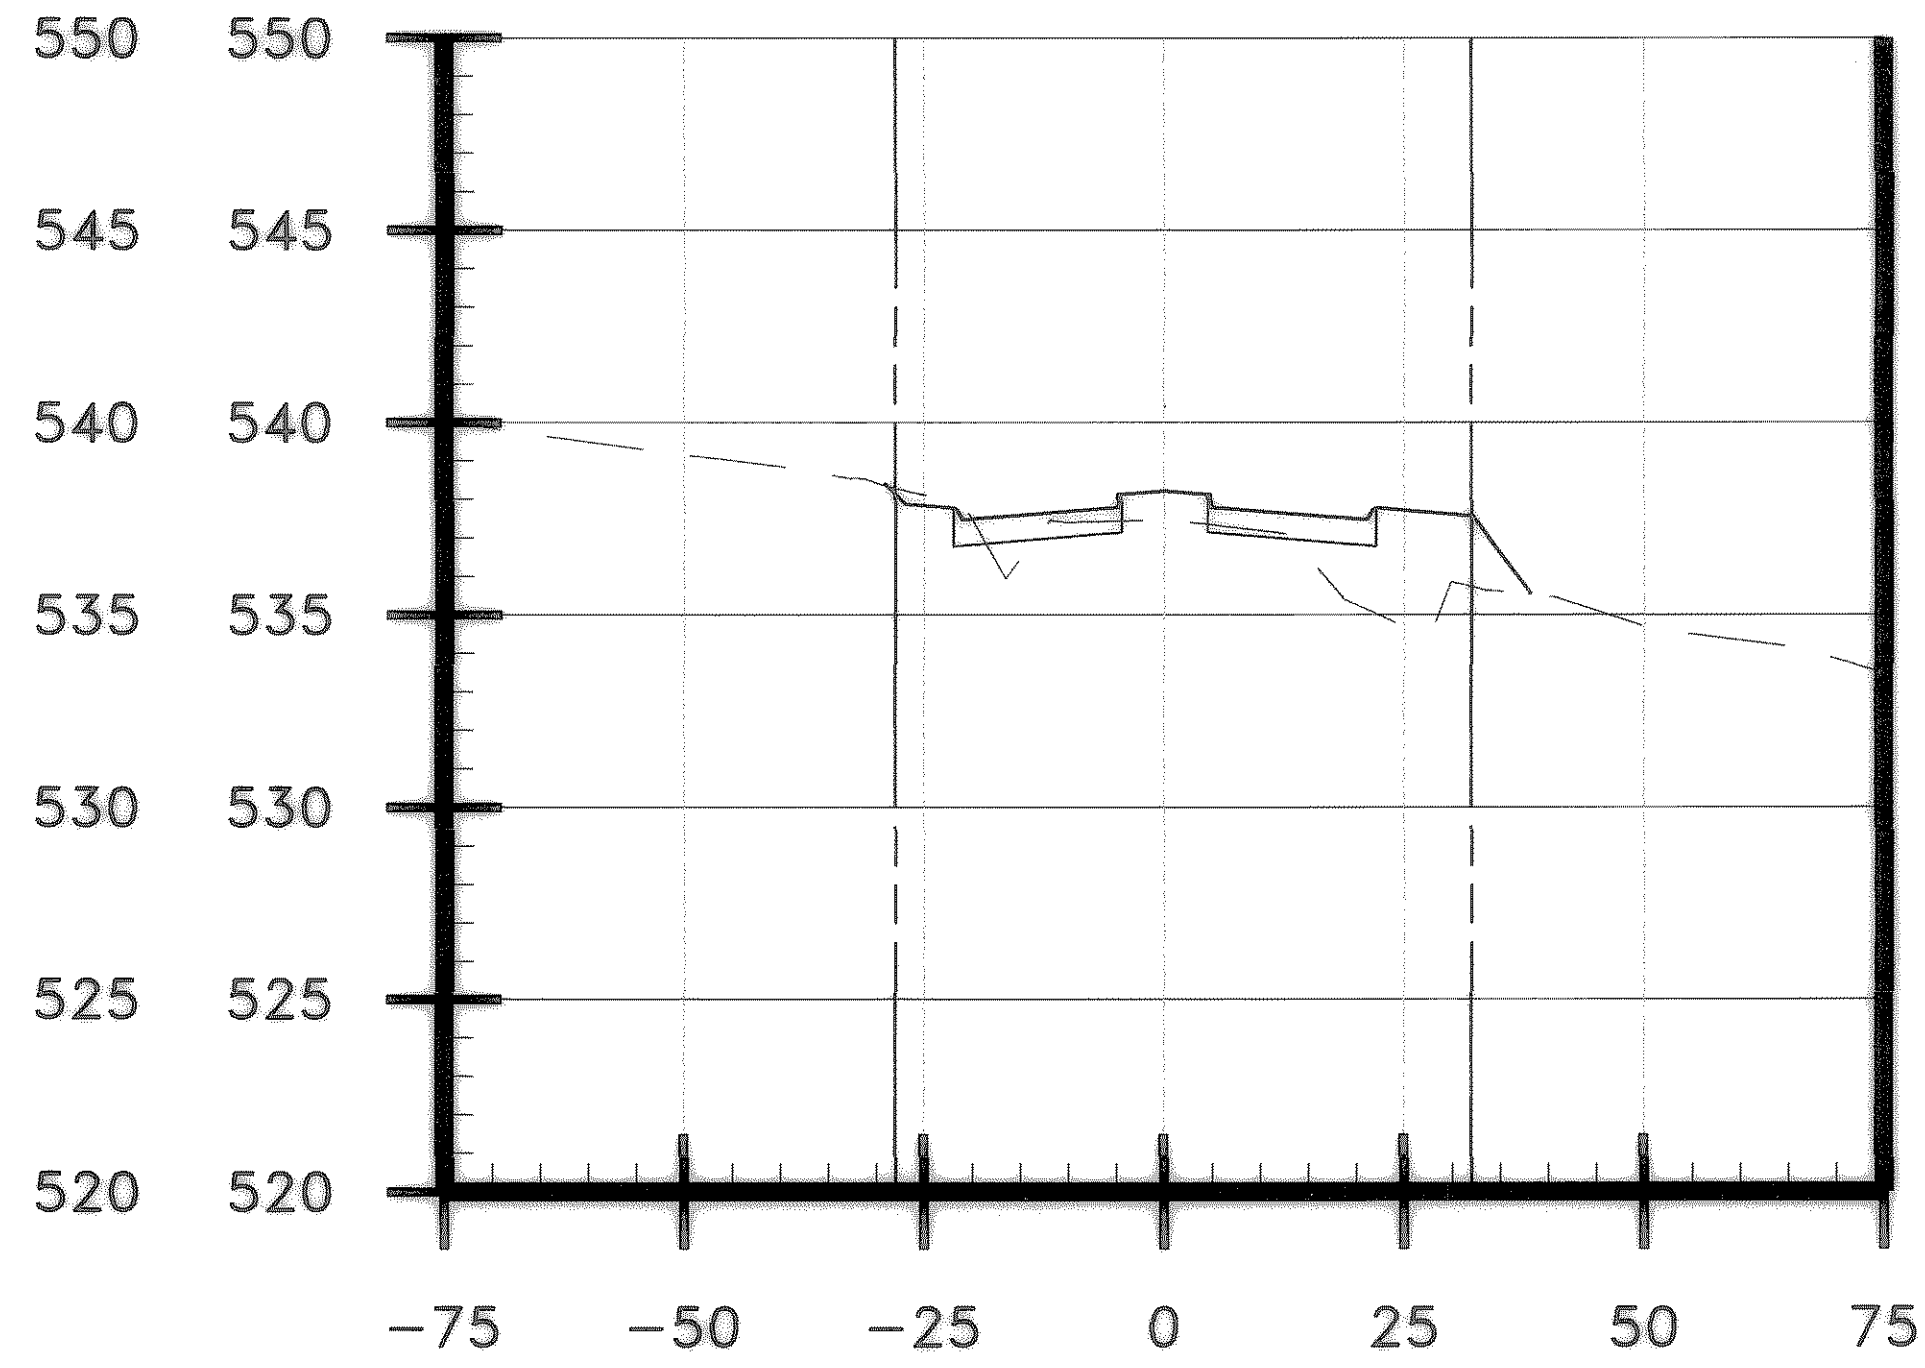


8+25

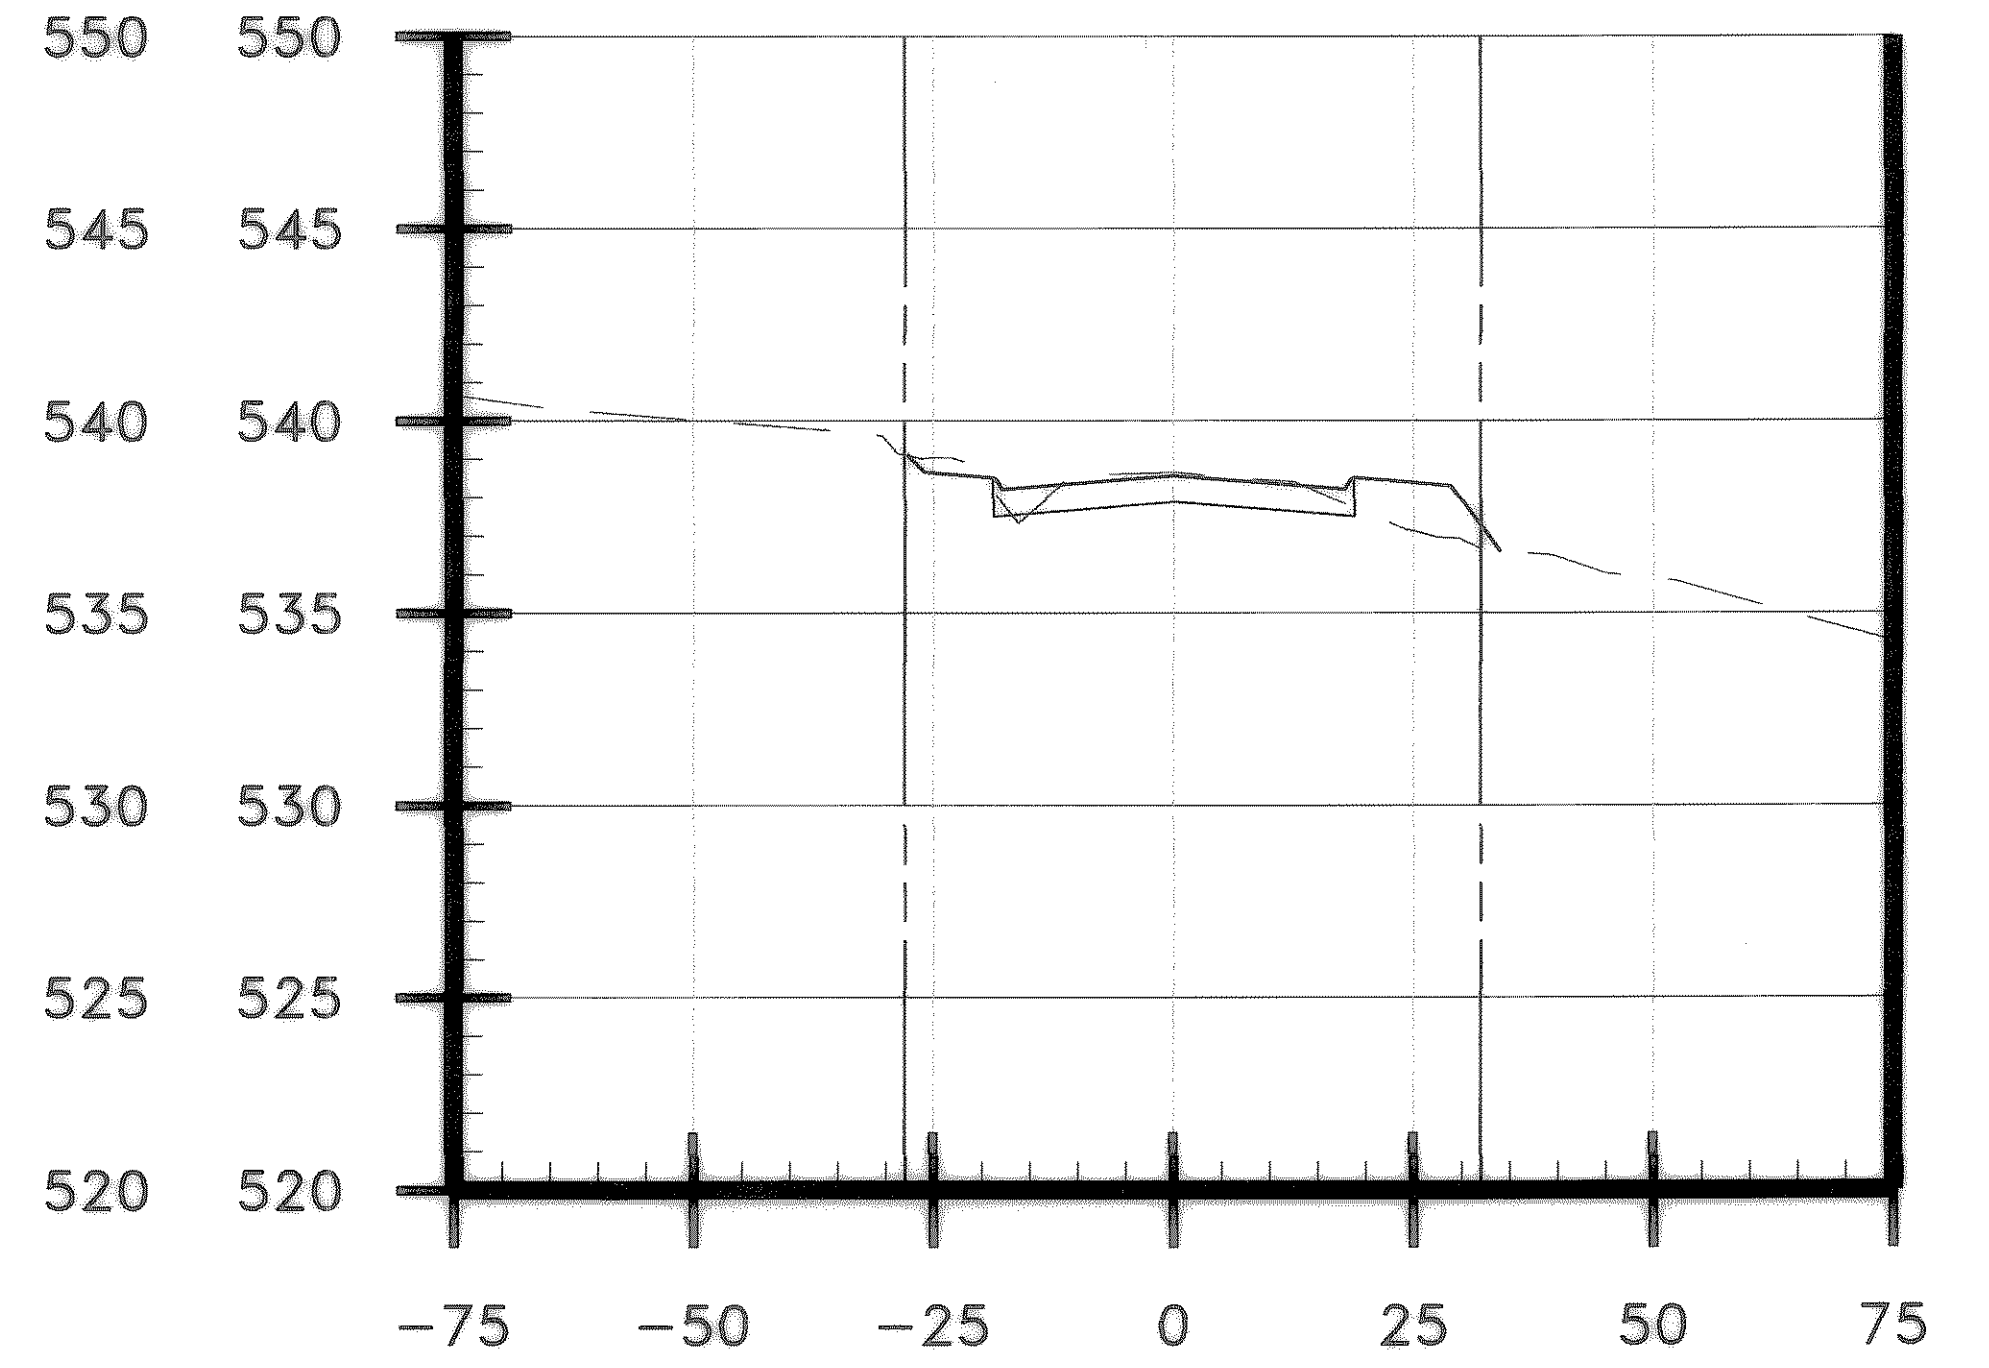


8+75

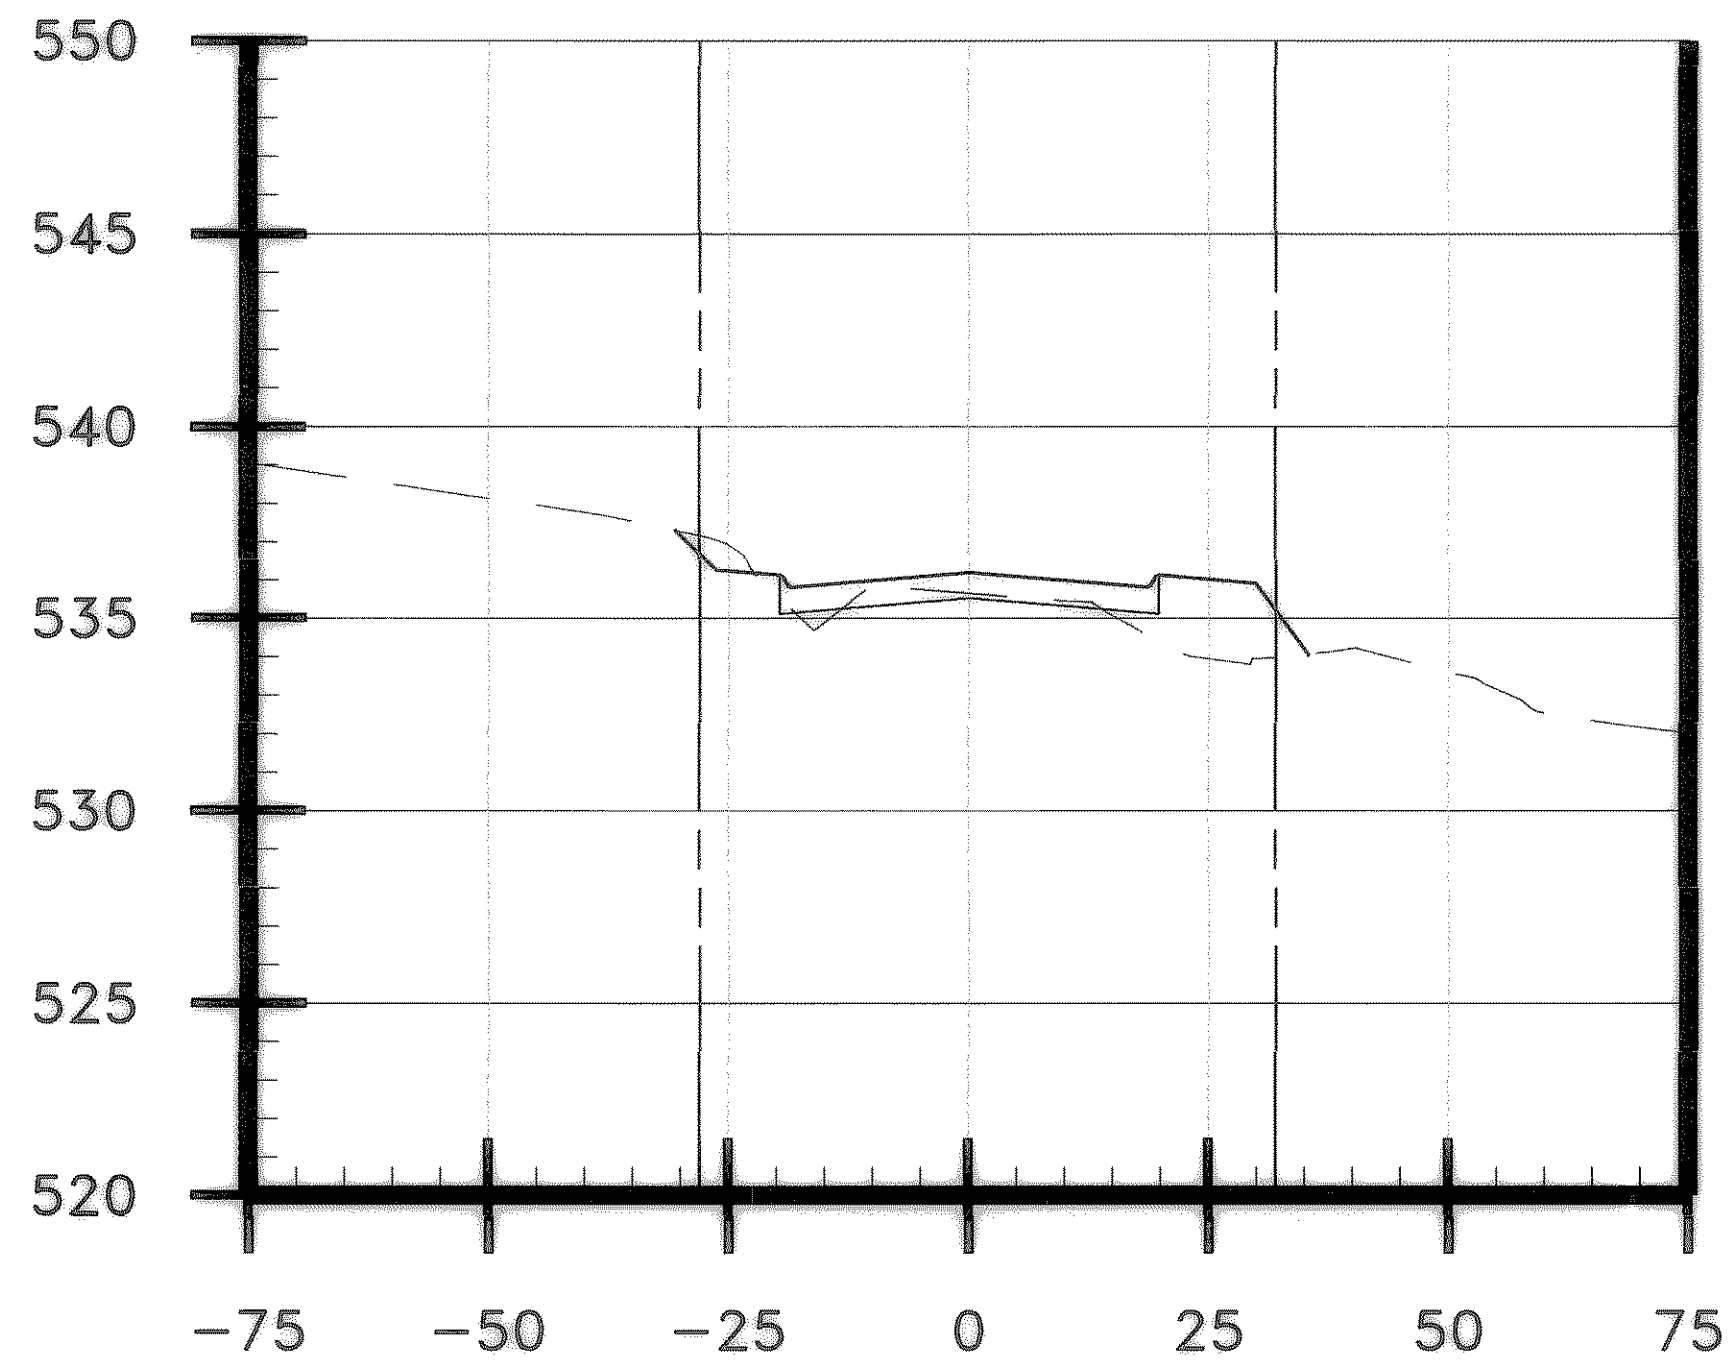

7+50

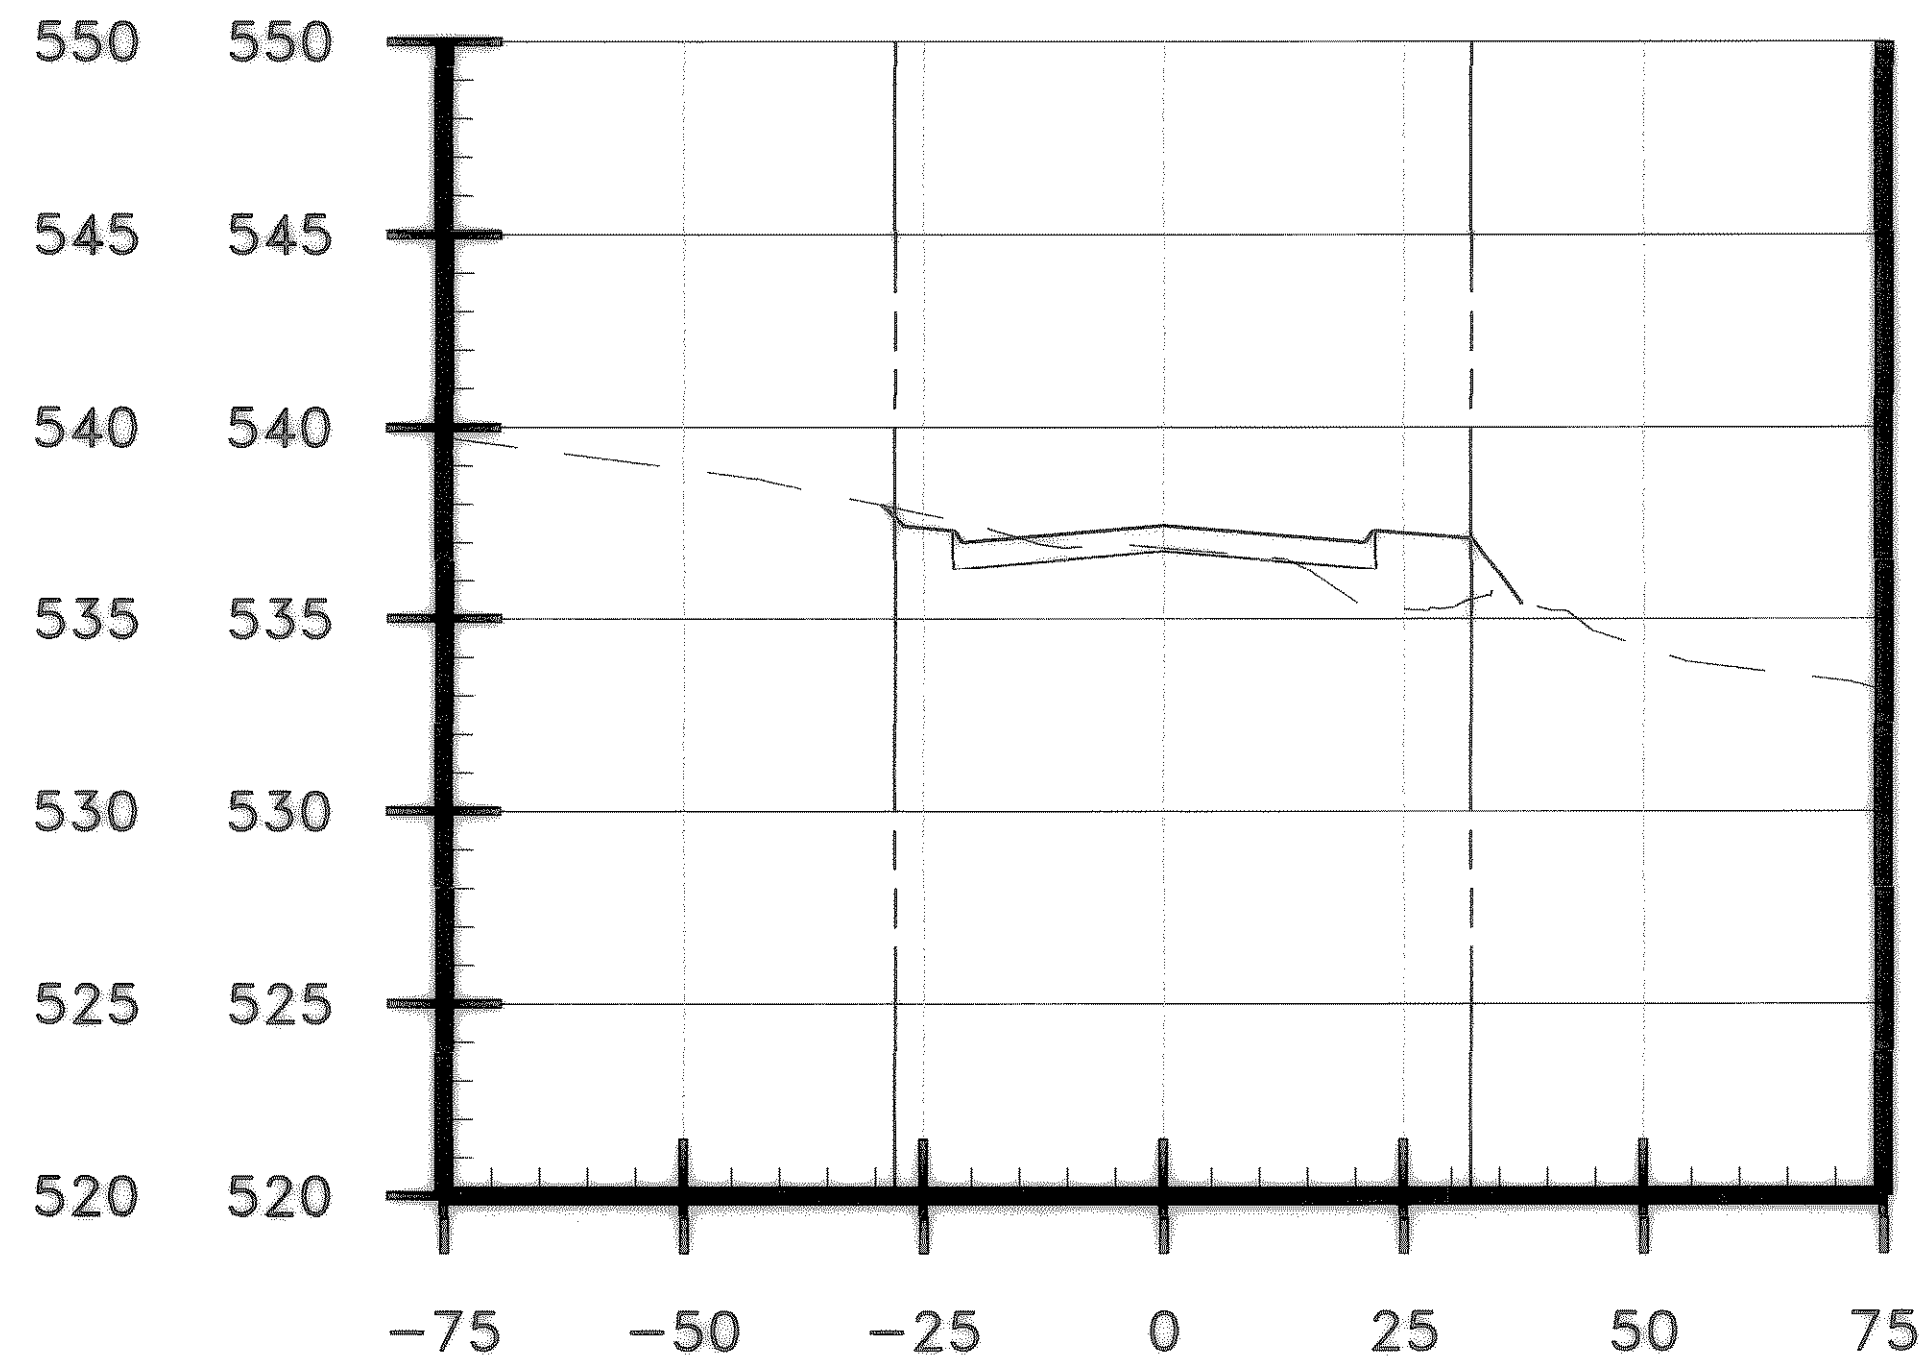

8+00

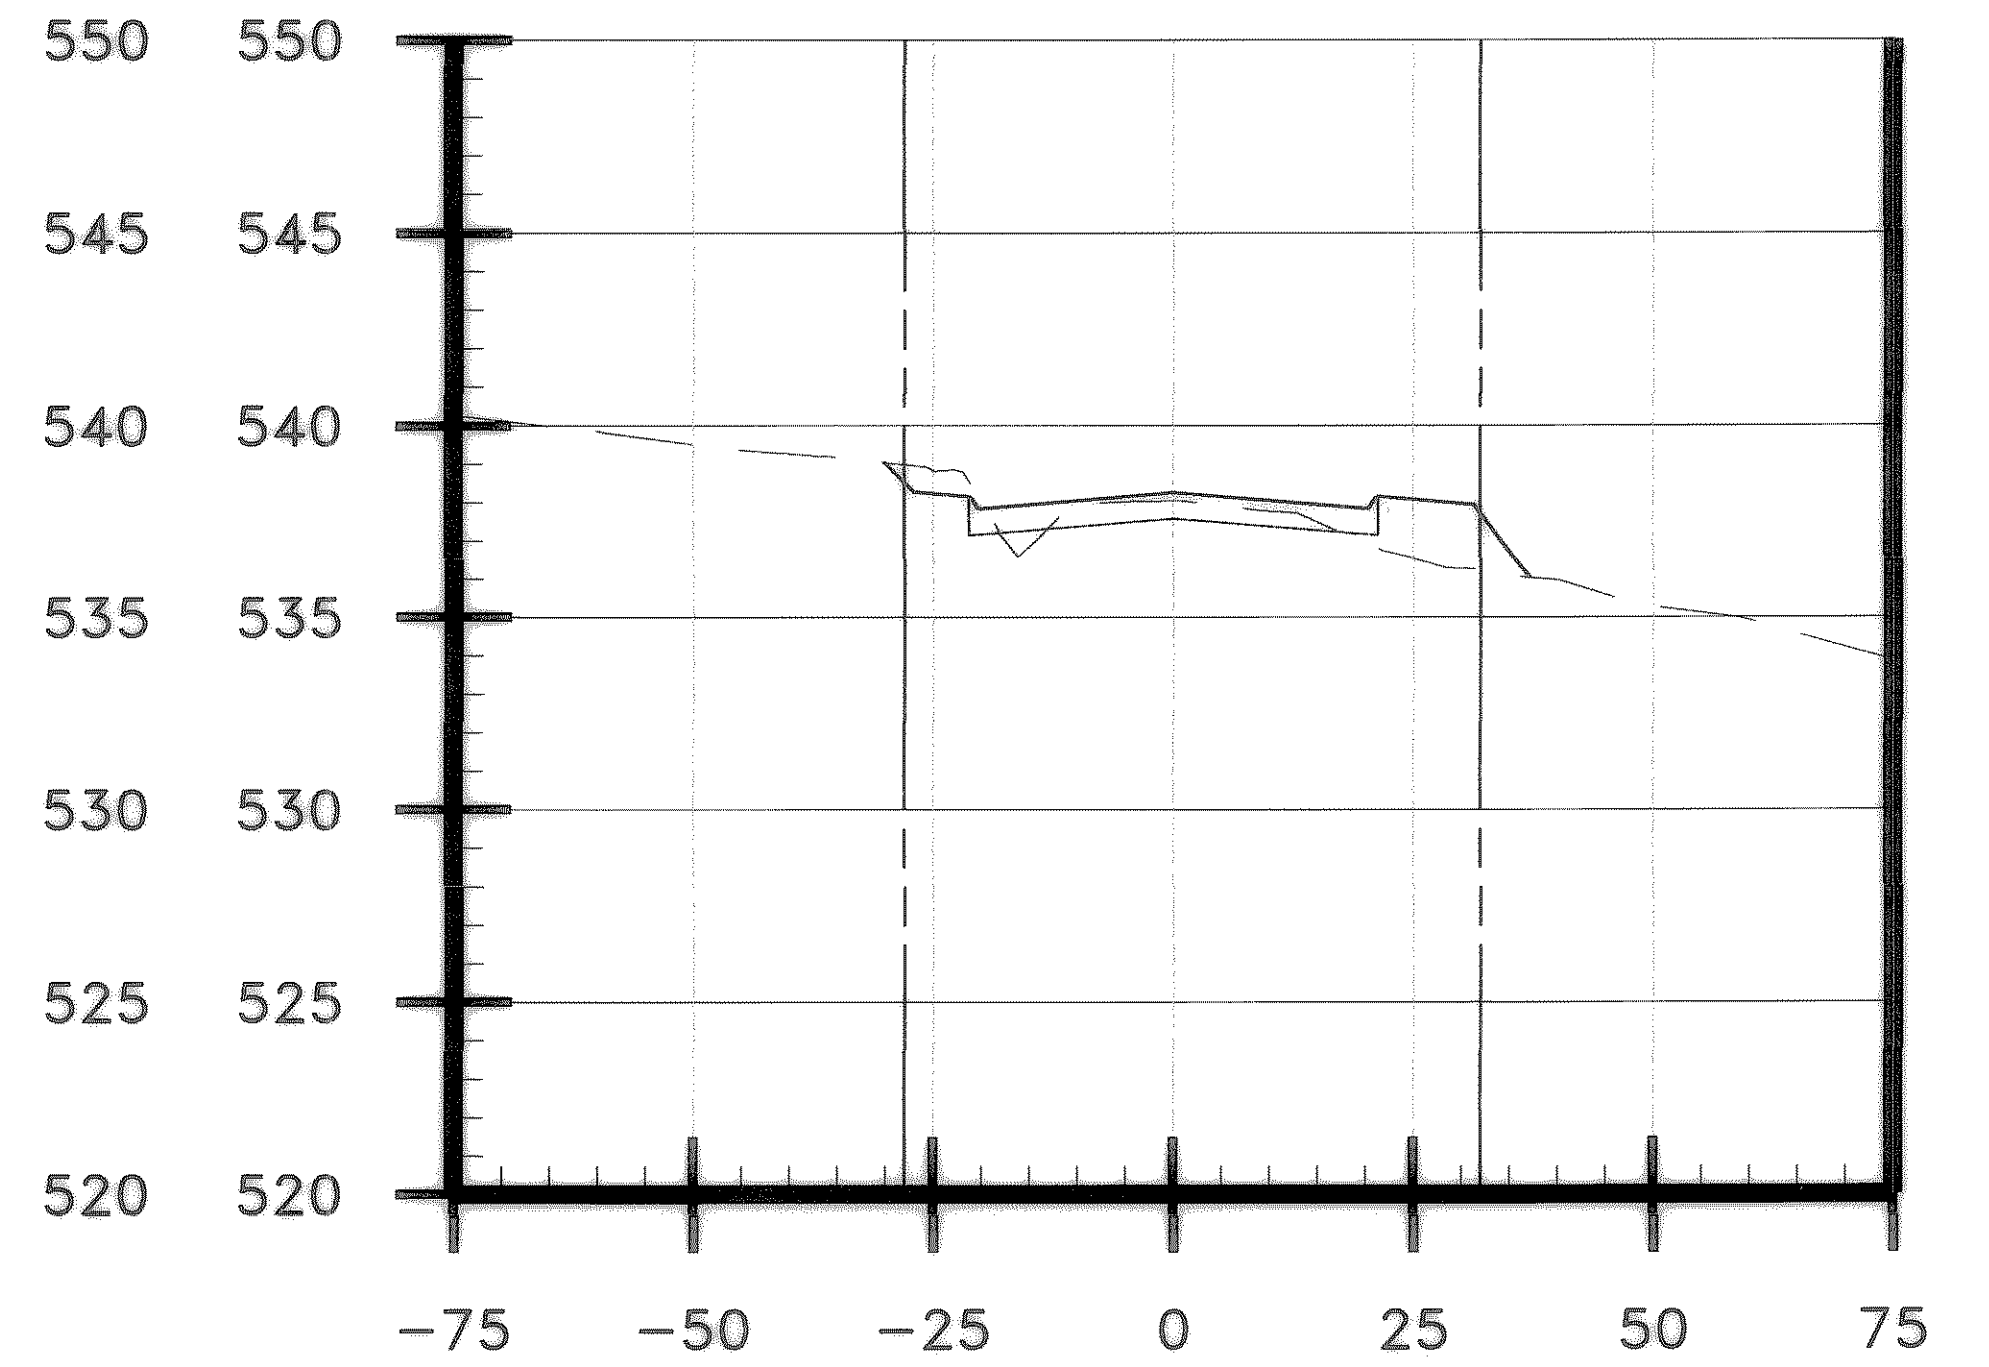

8+50

These plans and related specifications were prepared for construction of this specific project only. Reuse of these documents is not permitted without written authorization of Birkhoff, Hendricks & Conway, L.L.P.

CITY OF ROCKWALL, TEXAS


CLARK STREET  
CROSS SECTIONS

BIRKHOFF, HENDRICKS & CONWAY, L.L.P.  
CONSULTING ENGINEERS  
Dallas, Texas

REVISED TO CONFORM  
TO CONSTRUCTION RECORDS  
BY M.H. DATE 12/04/2006

THESE DOCUMENTS ARE FOR  
BIDDING, CONSTRUCTION,  
AND PERMIT PURPOSES.

DATE: 8/6/04

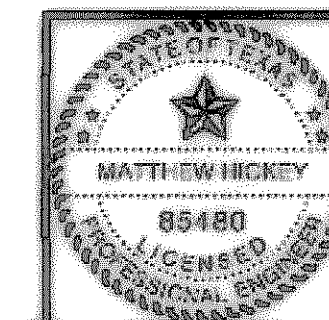

DESIGNED BY: M.H. PROJECT: 2003-120 SHEET NO. 121  
DRAWN BY: B.H.C. DATE: AUGUST, 2004 OF 121 SHEETS