




H:\ROCKWALL\2003\20\INROADS\CROSS-SEC\CLARK-X\SECTION\DWG SCALE: 1=20 XREF: ROCKWALL\2003\20\BASE\PROP-BASE 06/22/04 CAG

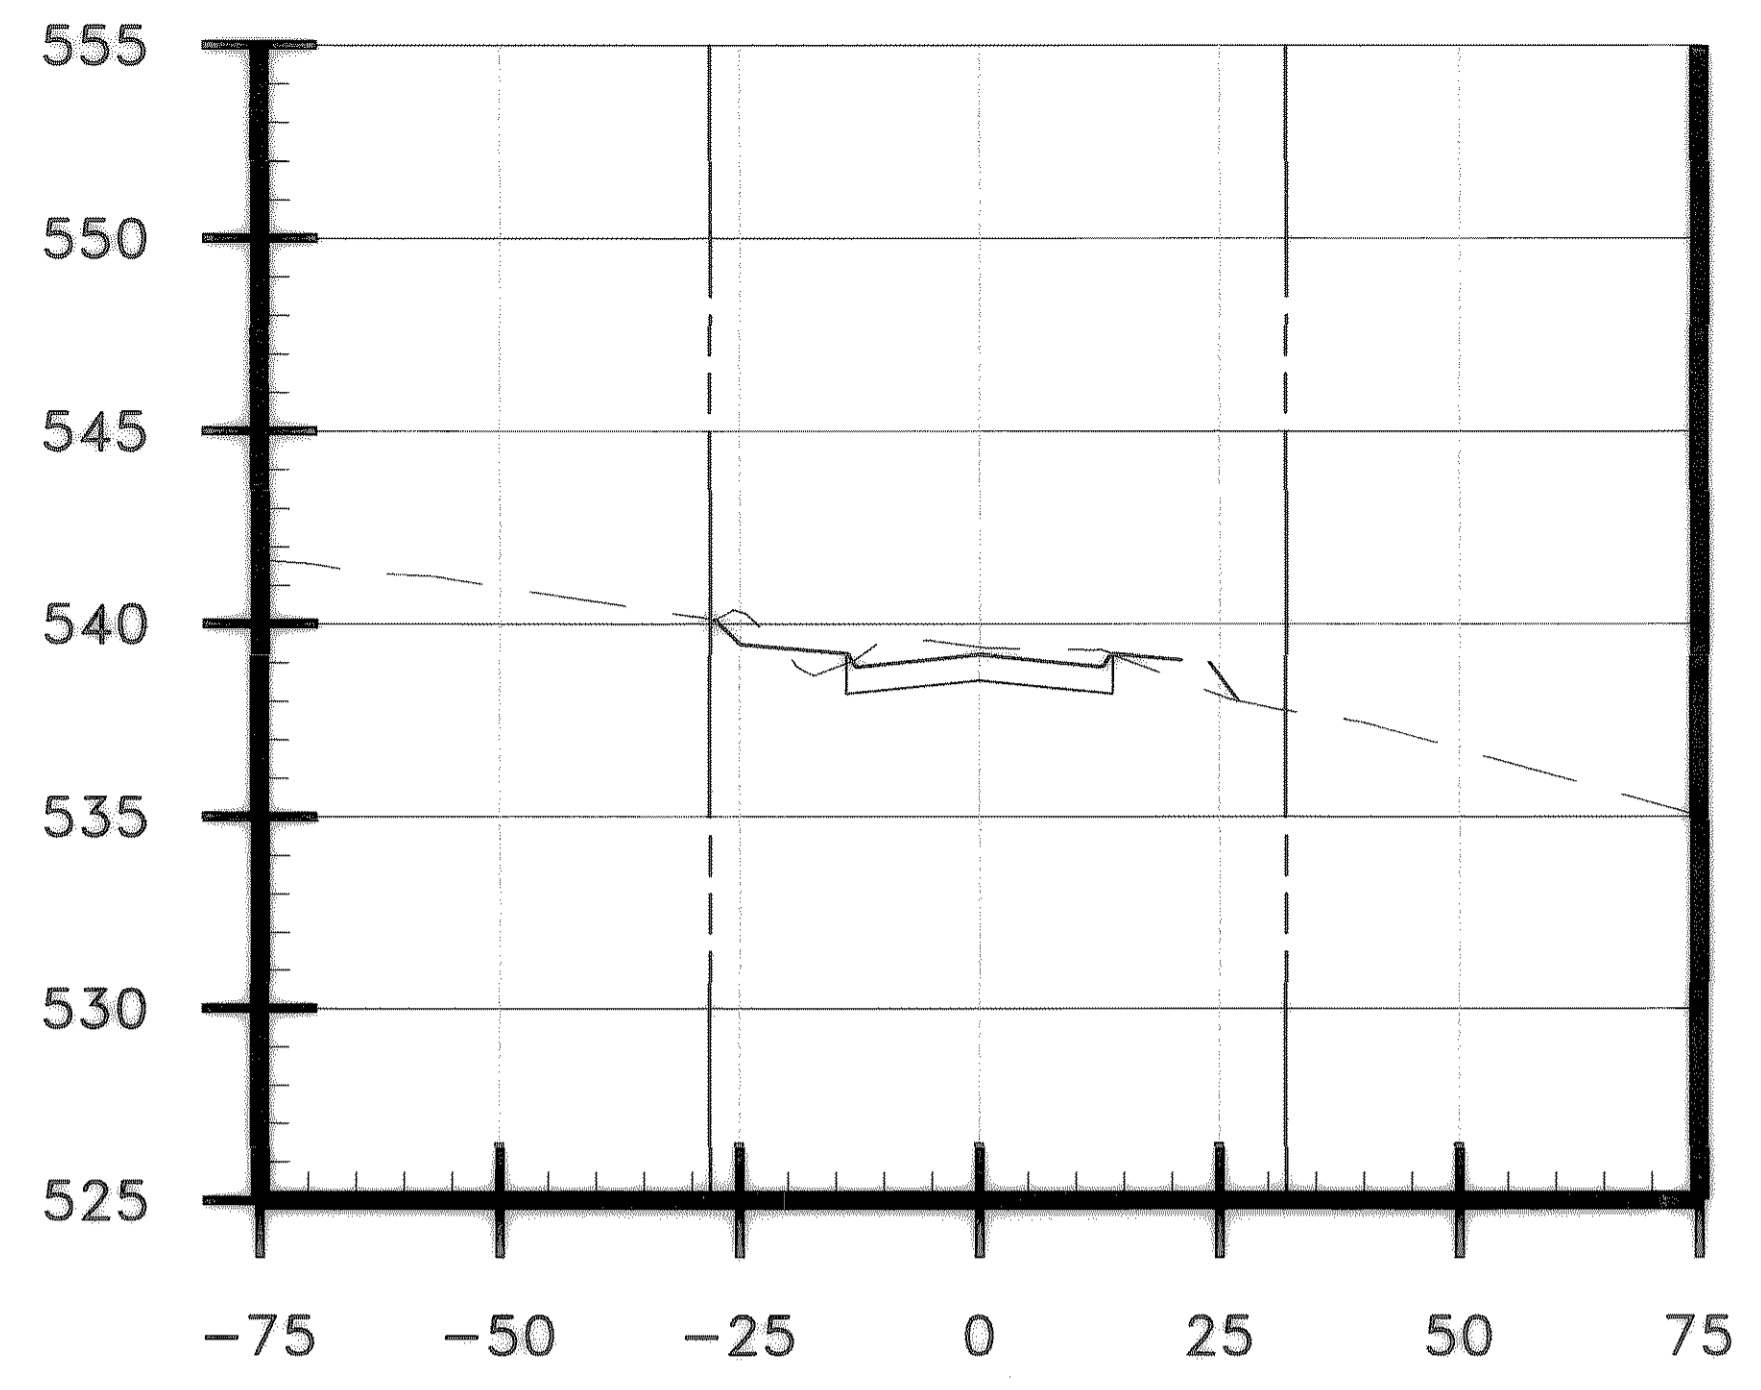


9+25

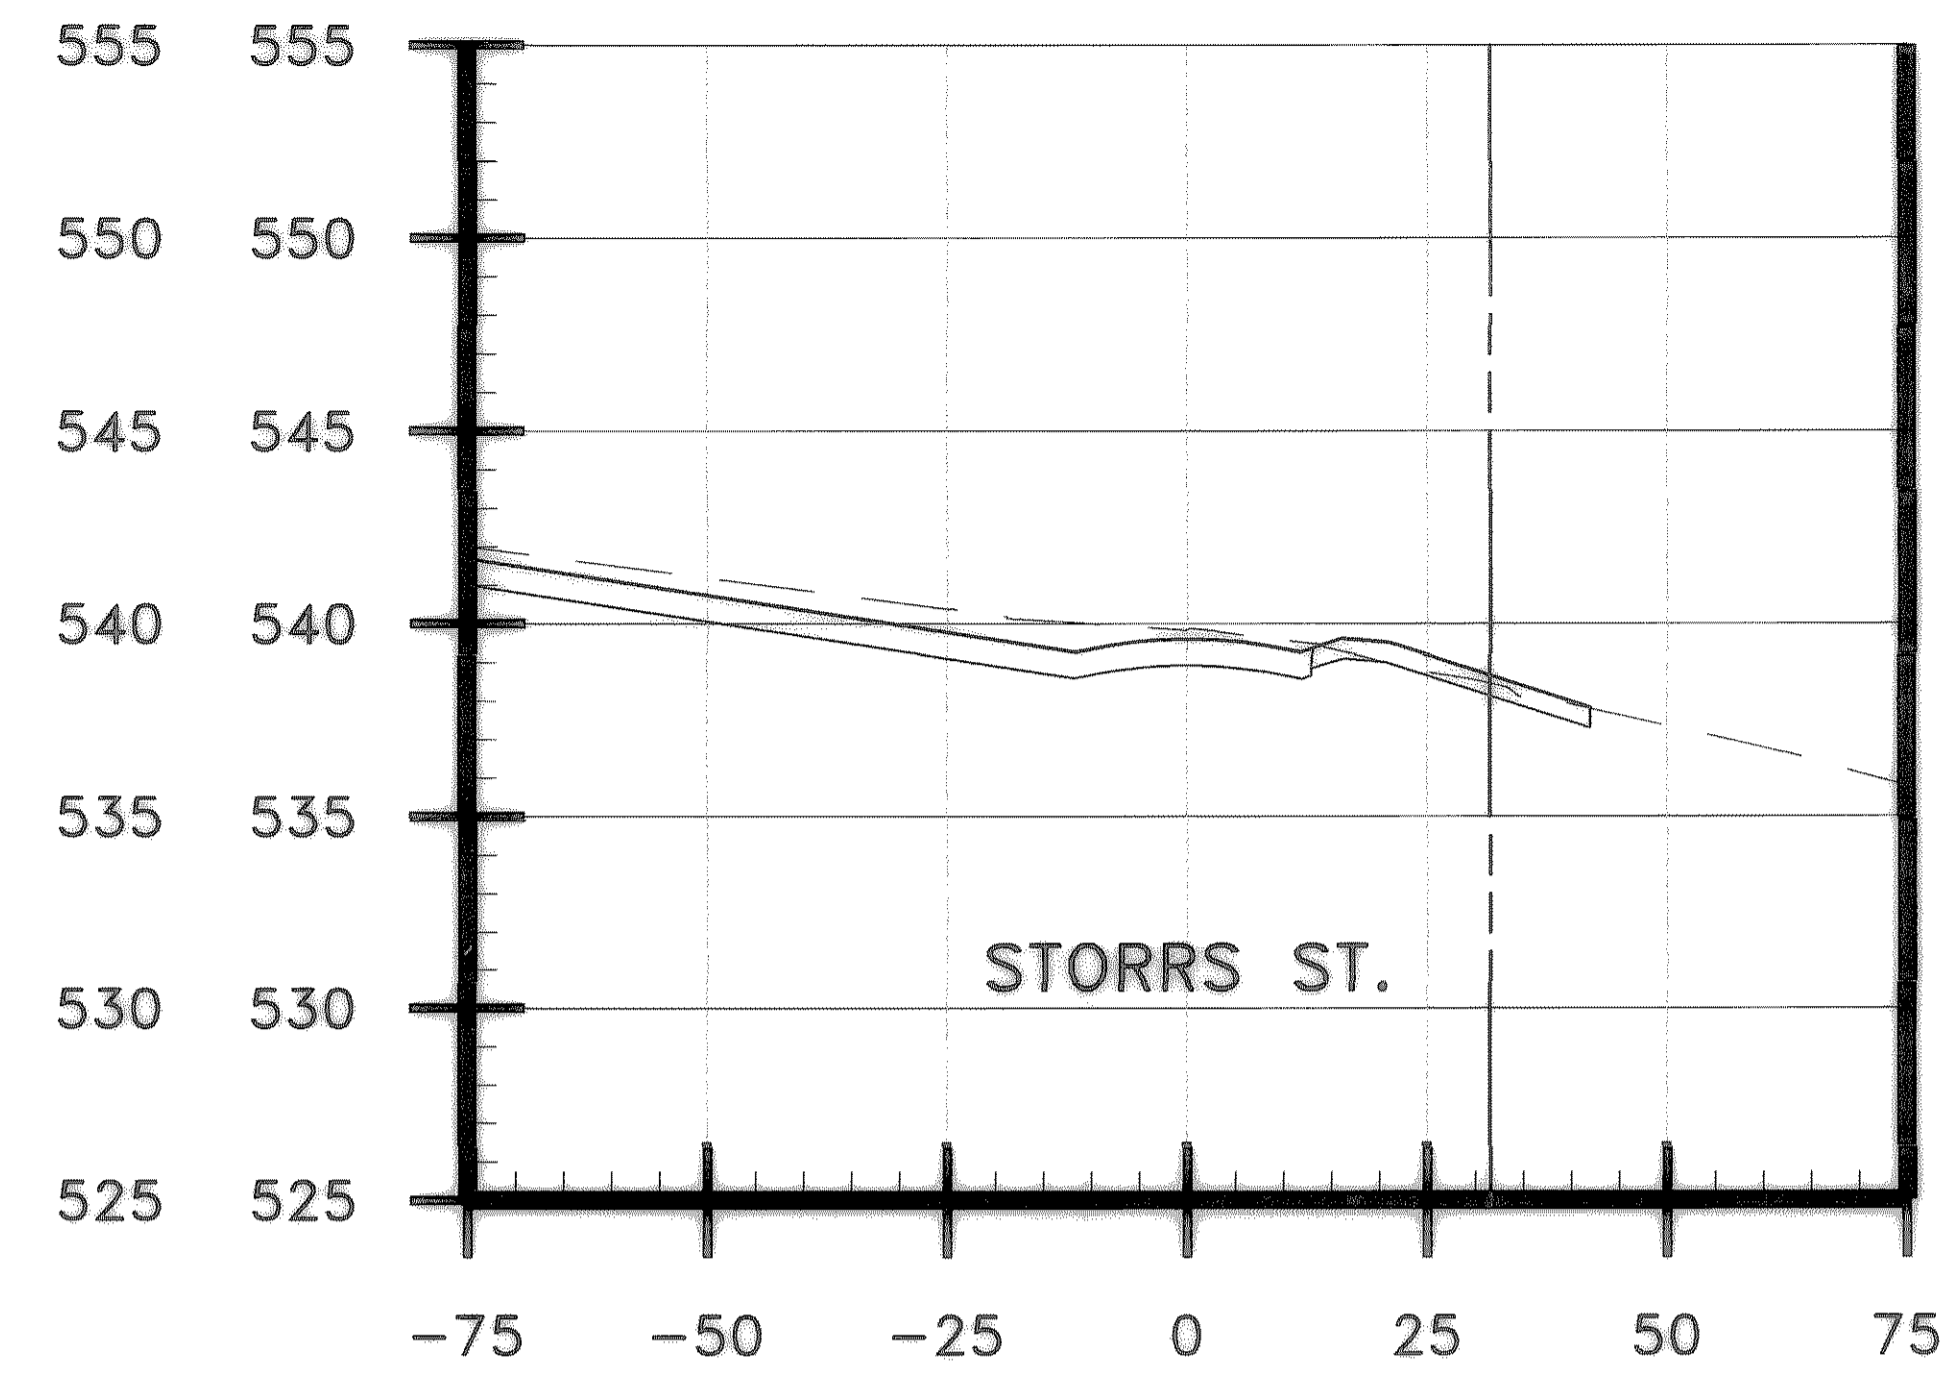


9+75

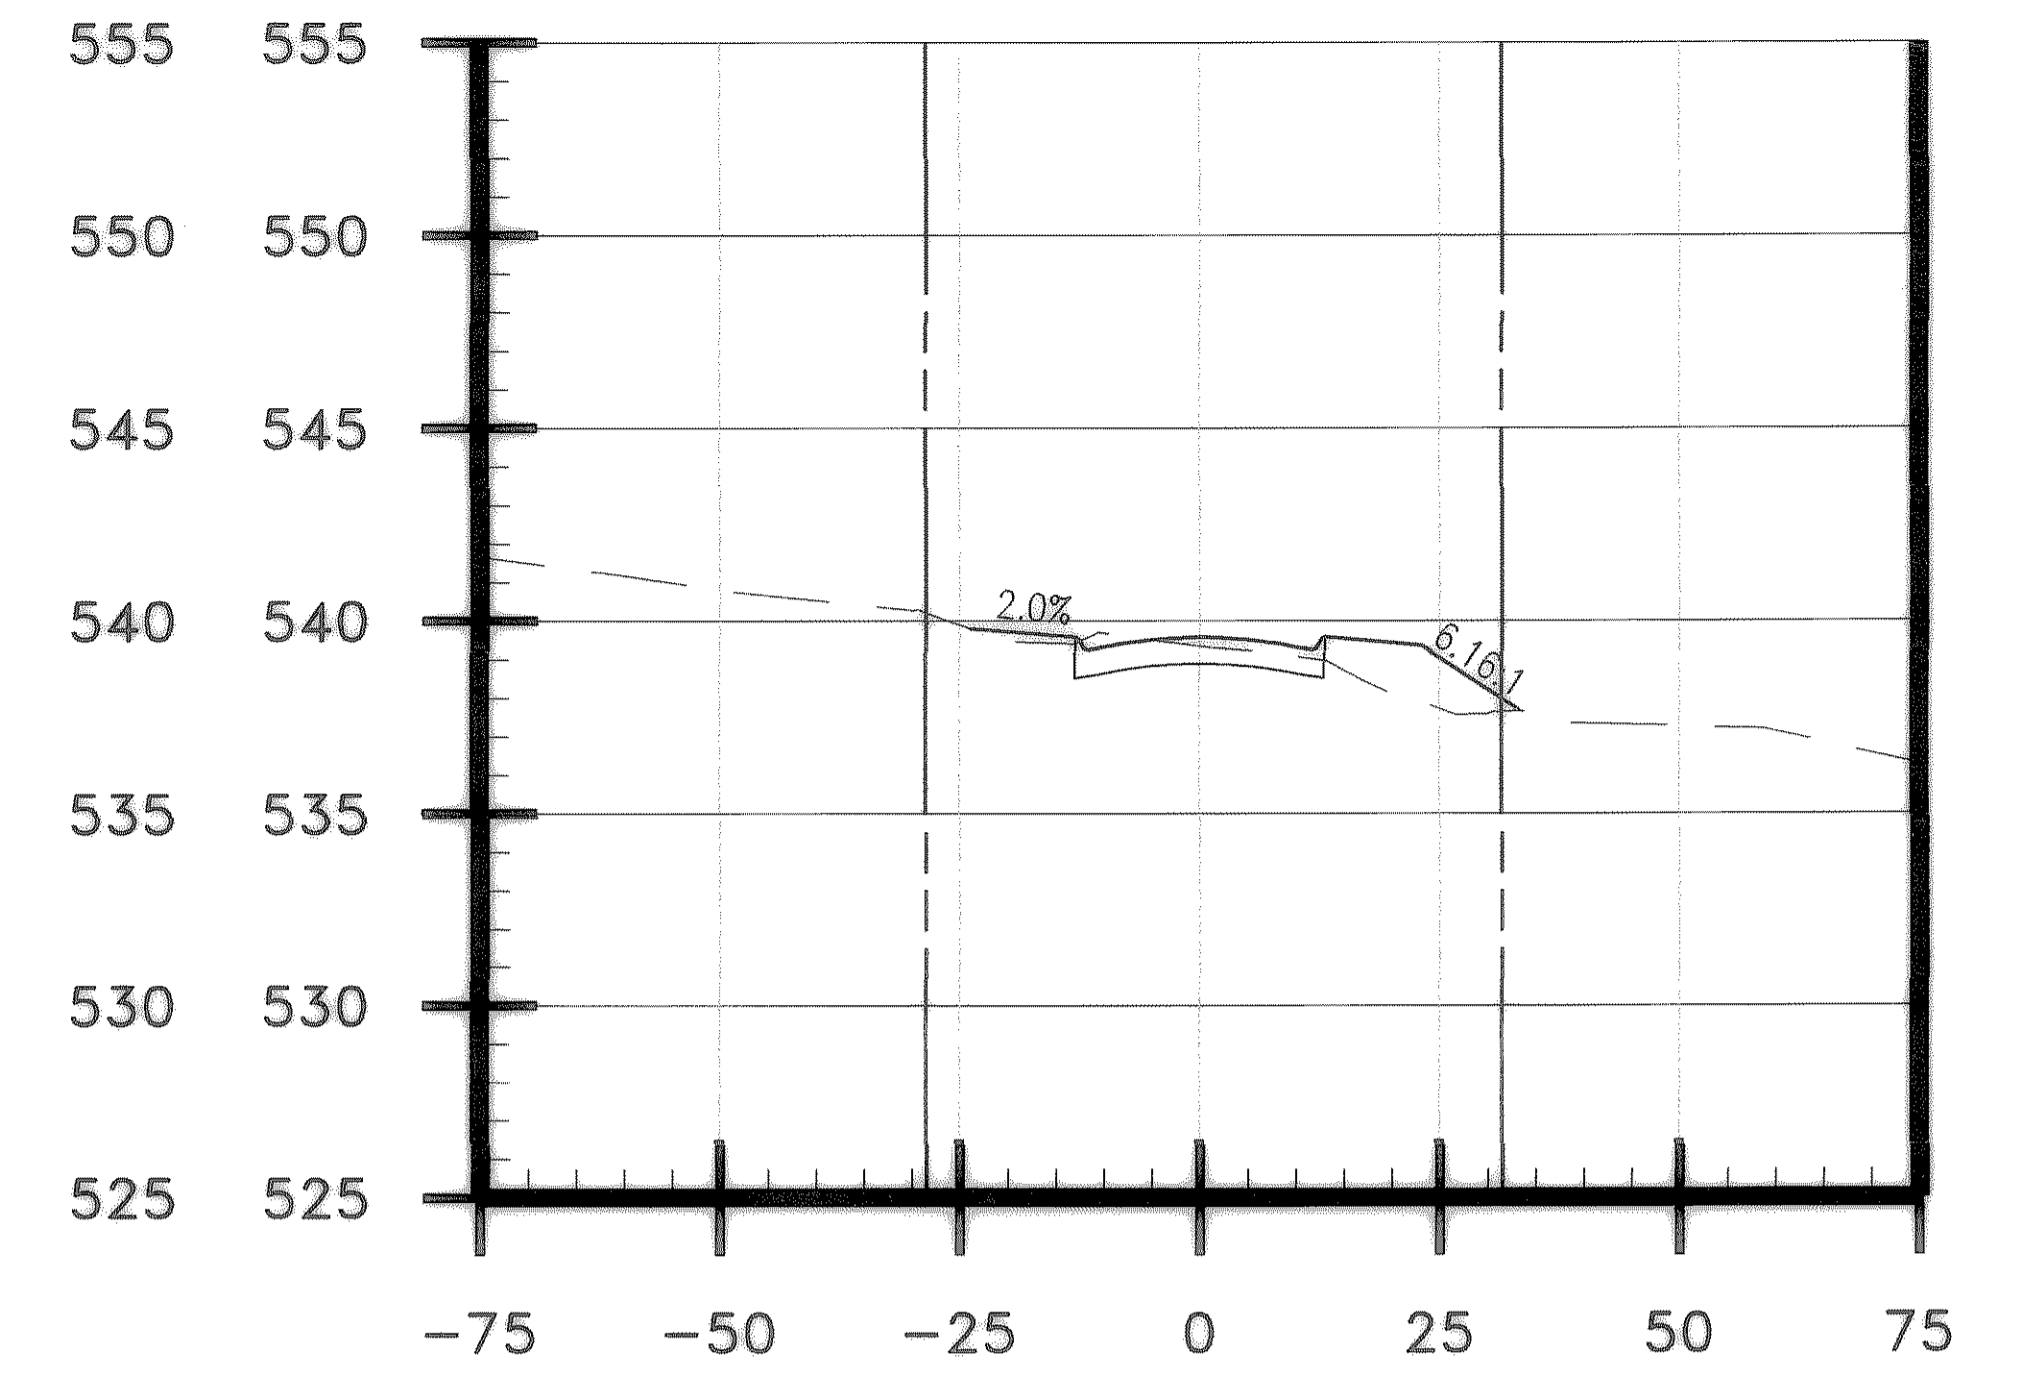


10+25

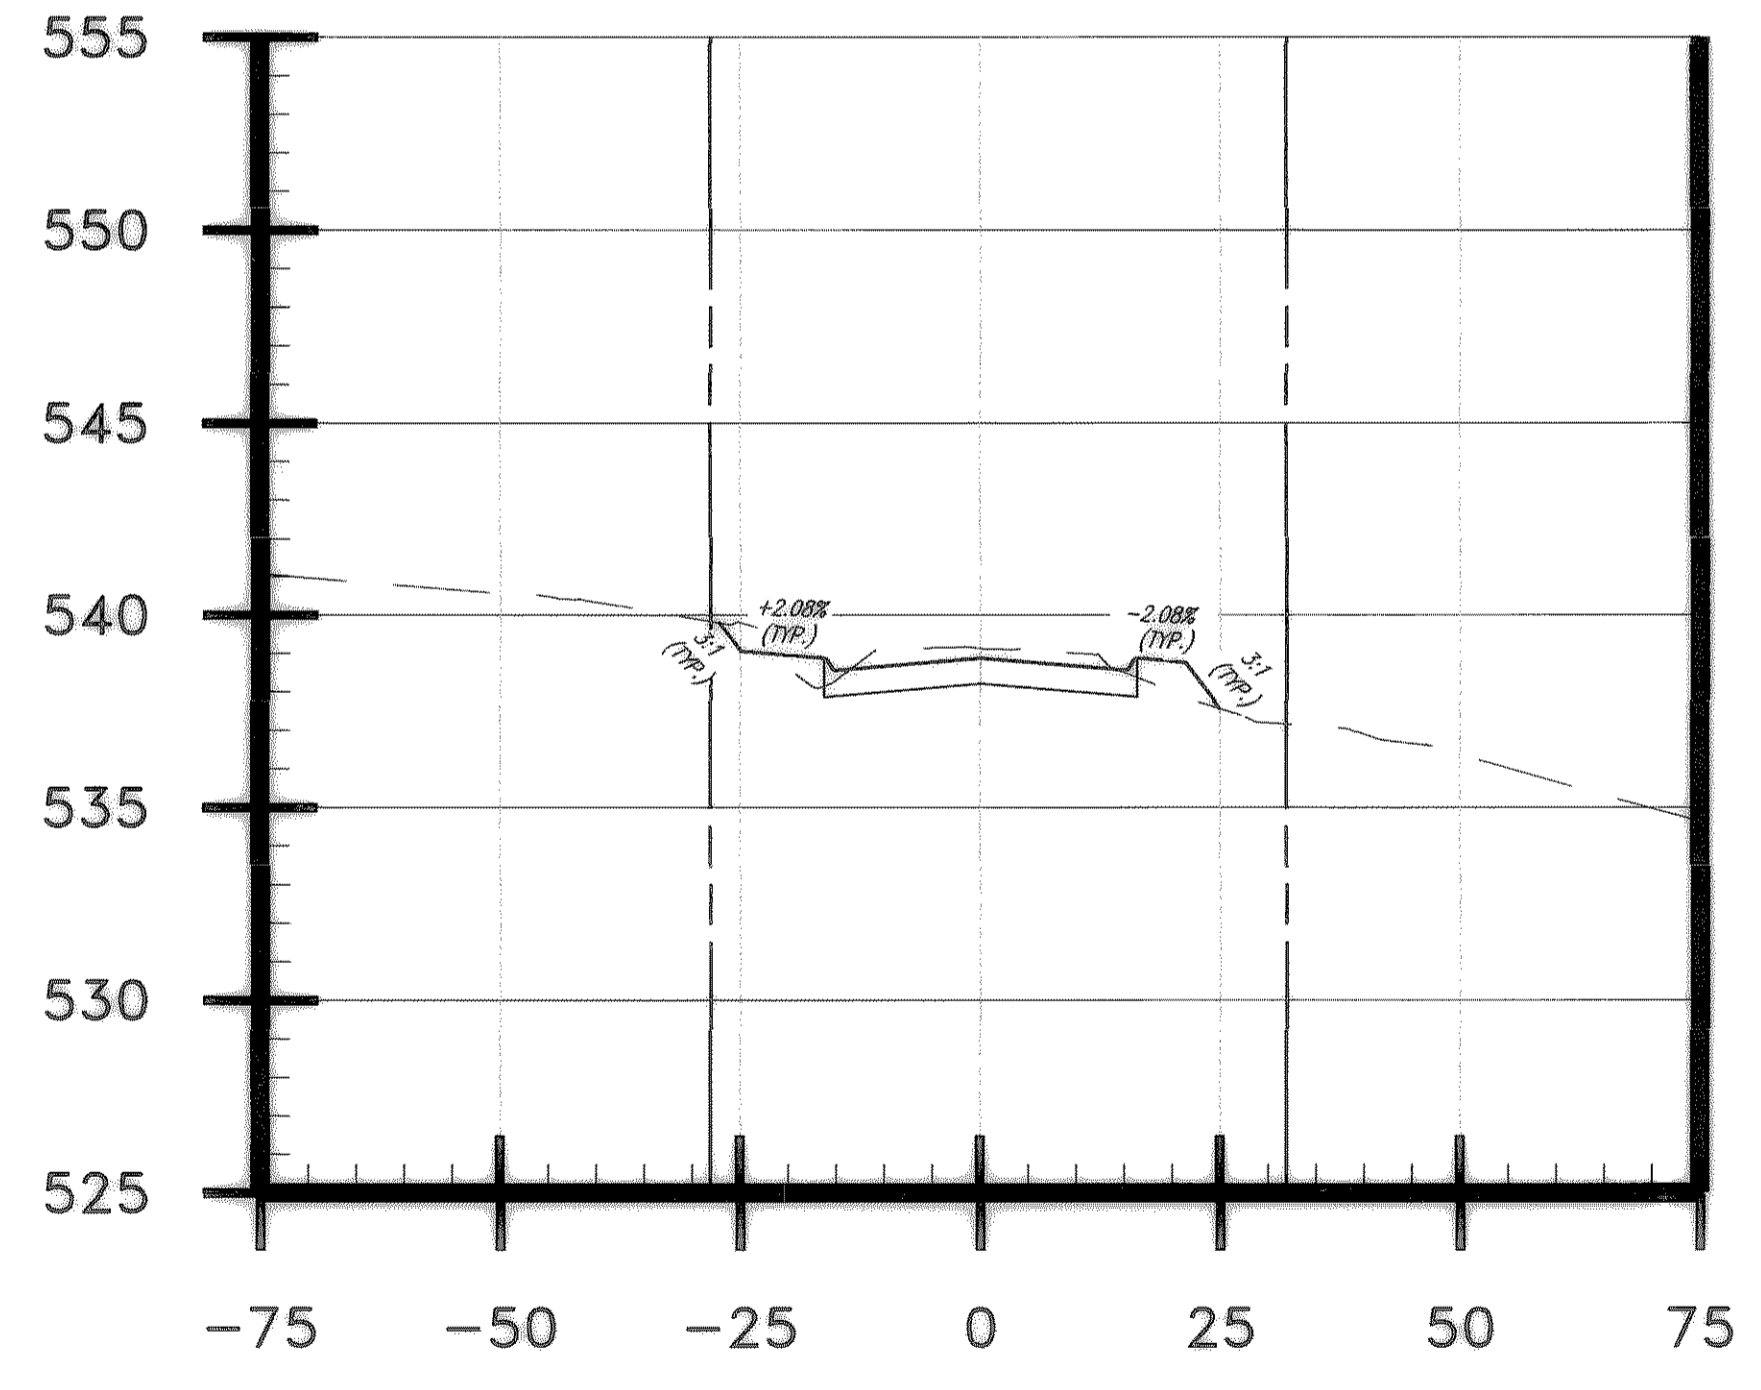

9+00

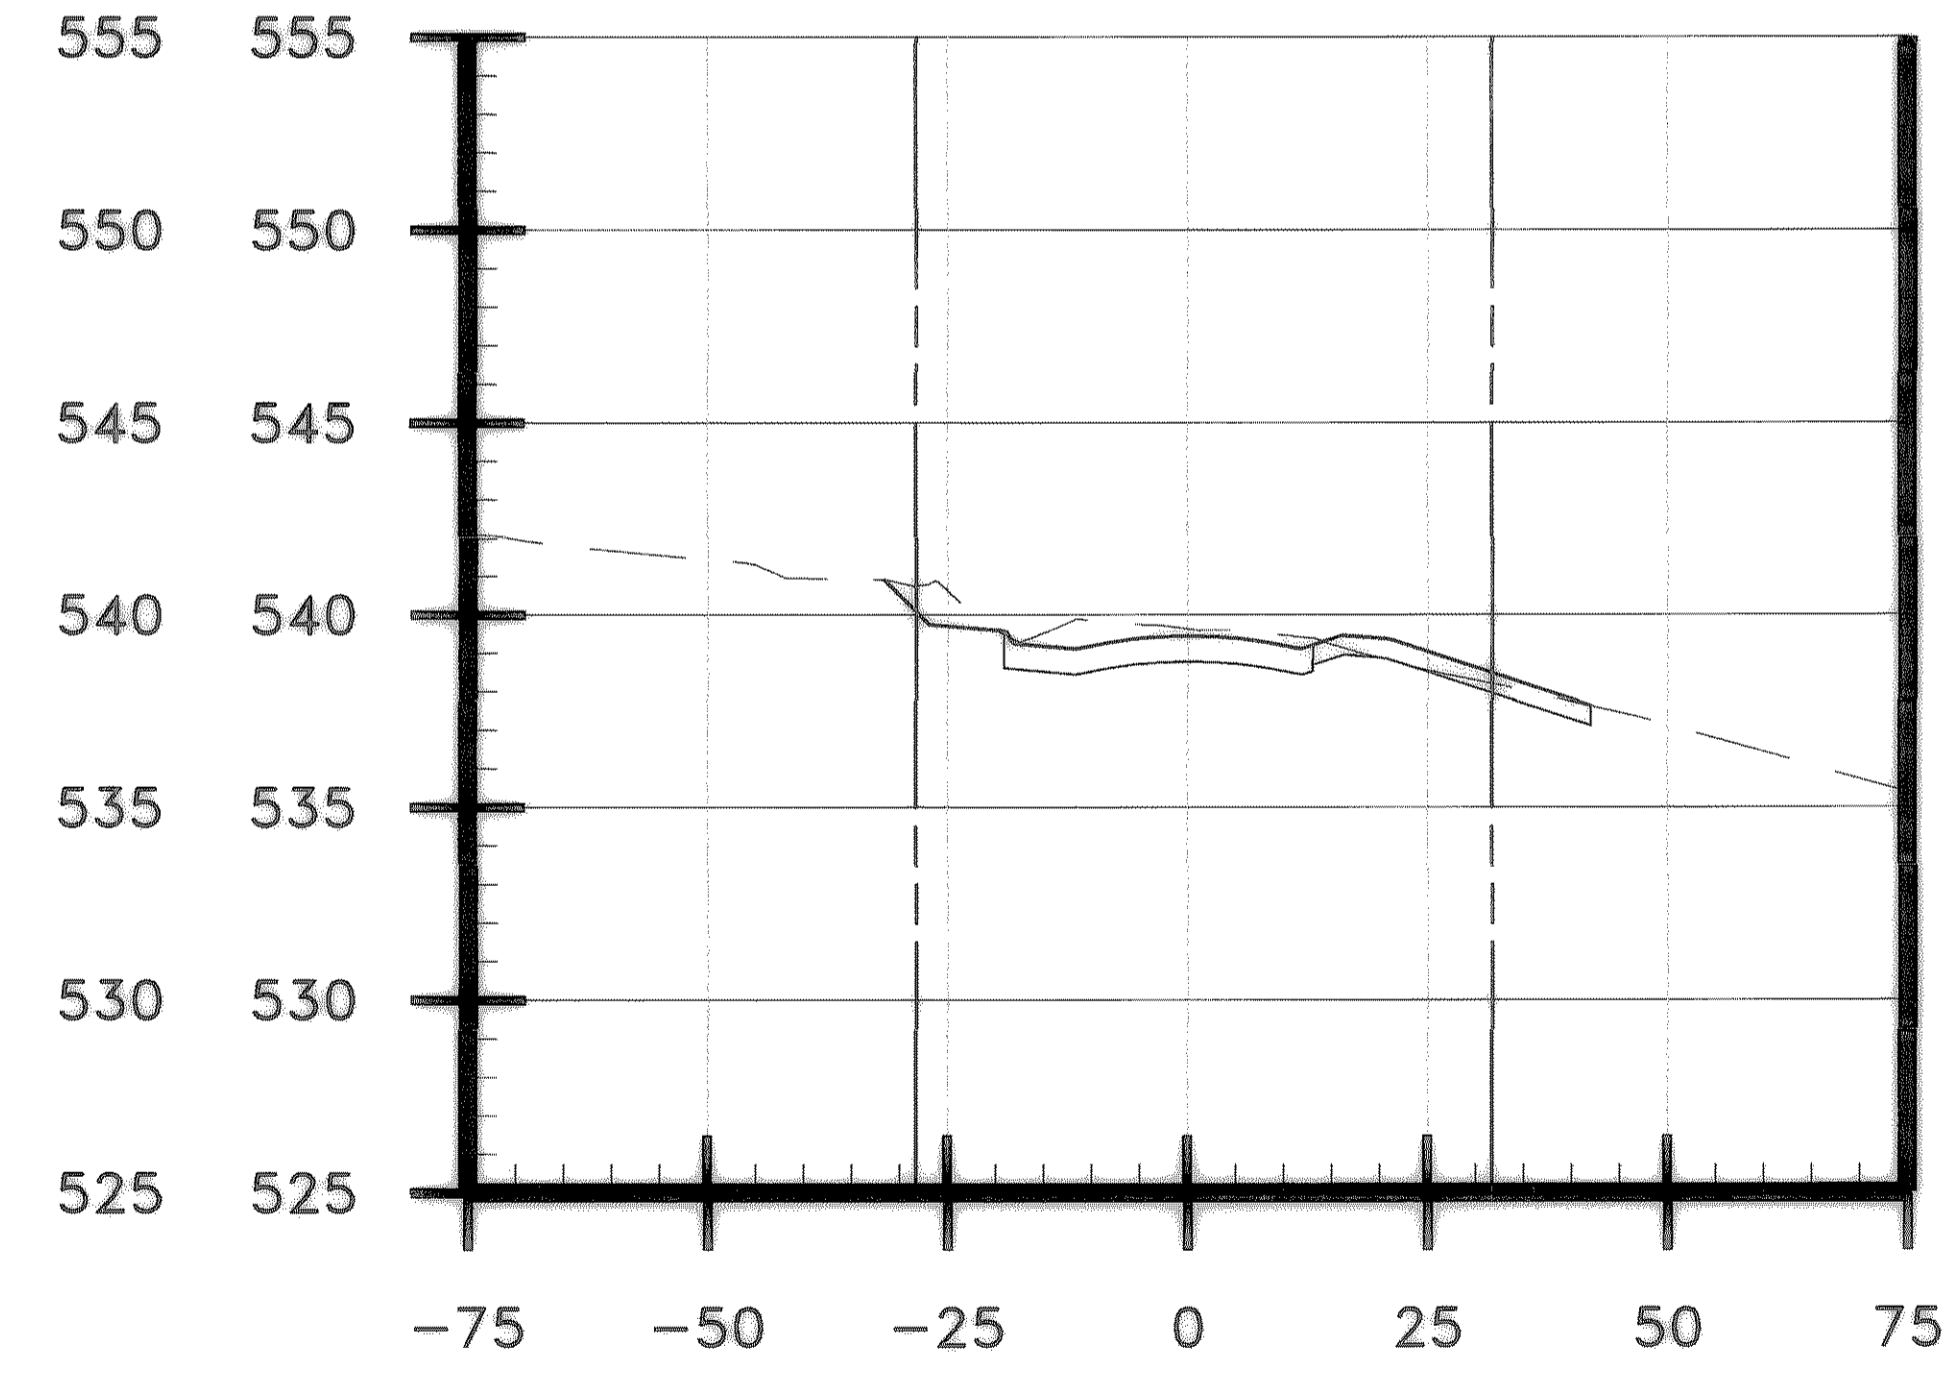

9+50

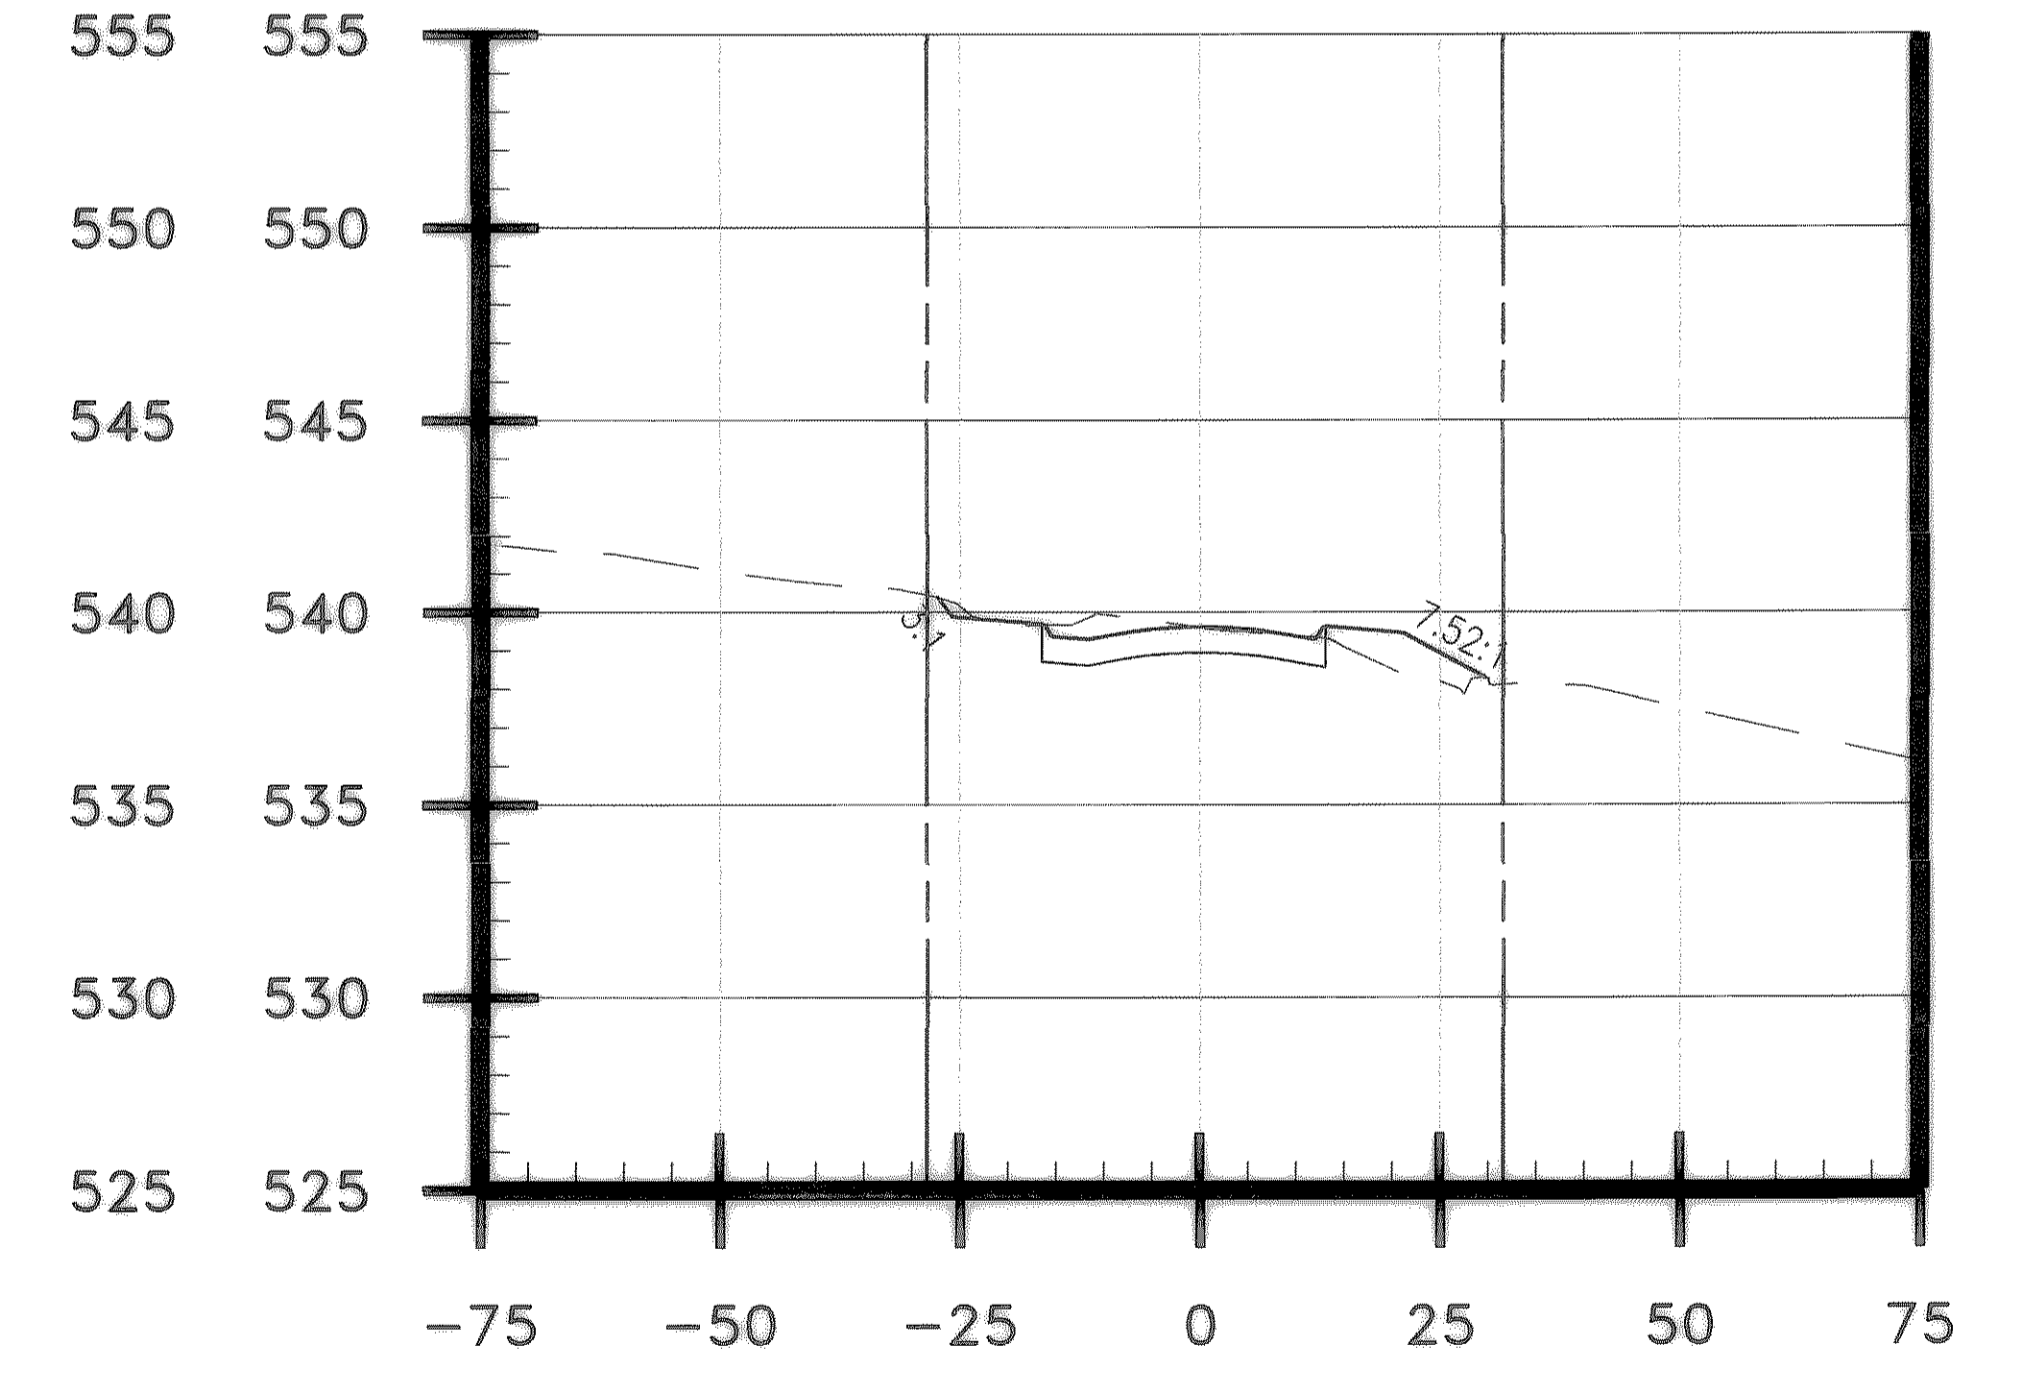

10+00

These plans and related specifications were prepared for construction of this specific project only. Reuse of these documents is not permitted without written authorization of Birkhoff, Hendricks & Conway, L.L.P.


CITY OF ROCKWALL, TEXAS

CLARK STREET CROSS SECTIONS

BIRKHOFF, HENDRICKS & CONWAY, L.L.P. CONSULTING ENGINEERS Dallas, Texas

REVISED TO CONFORM TO CONSTRUCTION RECORDS BY M.H. DATE 12/04/2006

THESE DOCUMENTS ARE FOR BIDDING, CONSTRUCTION, AND PERMIT PURPOSES. DATE: 8/20/04

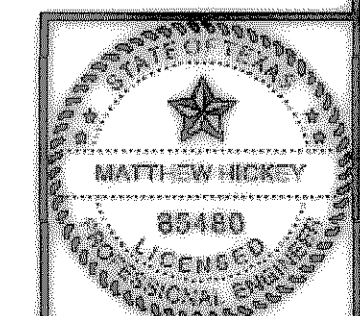

DESIGNED BY: M.H. PROJECT: 2003-120 SHEET NO. 122
DRAWN BY: B.H.C. DATE: AUGUST, 2004 OF SHEETS