




H:\ROCKWALL\2003120\INROADS\GROSS-SEC\CLARK-X\SECT.DWG SCALE: 1=20 XREF: ROCKWALL\2003120\BASE\PROP-BASE  
06/22/04 CAG

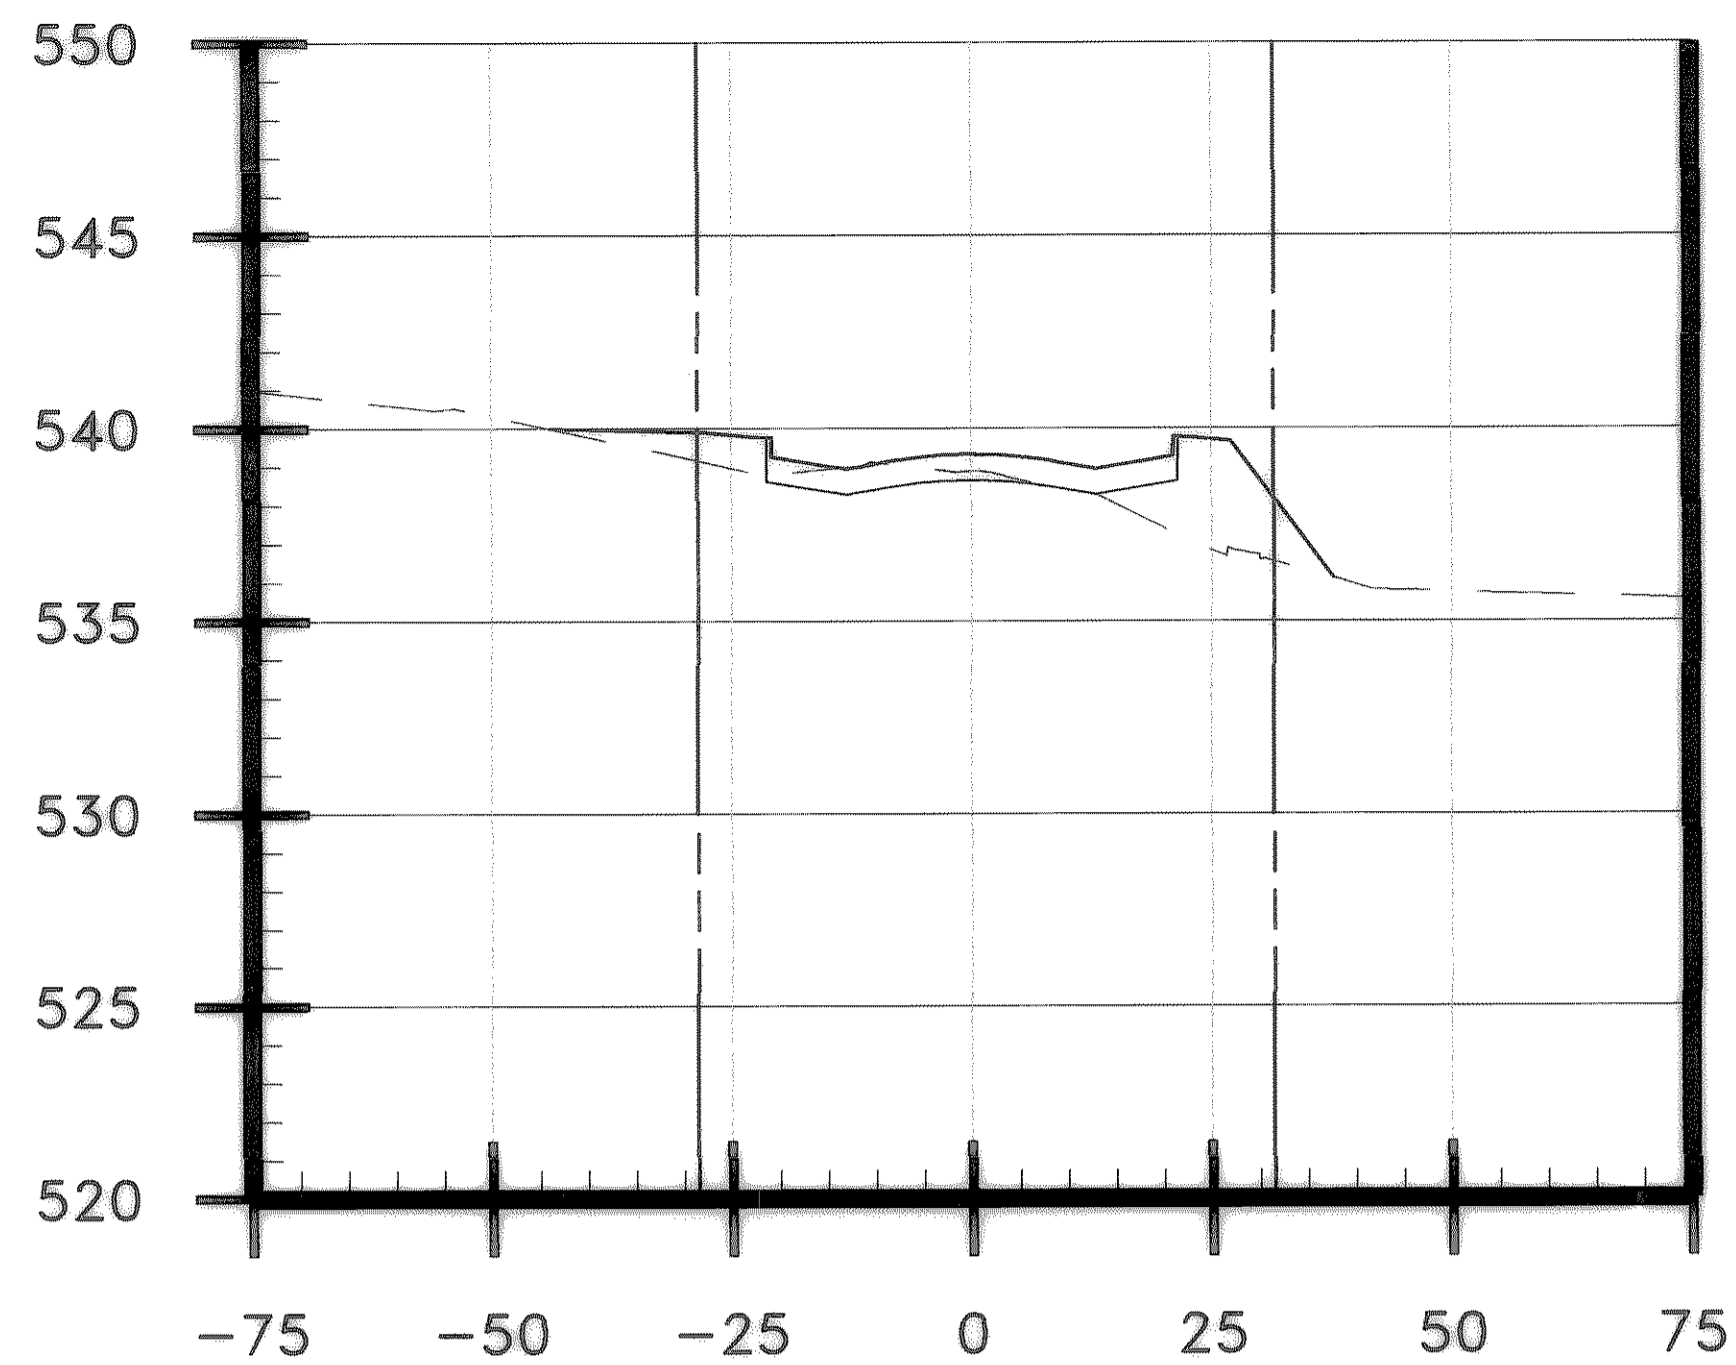


10+75

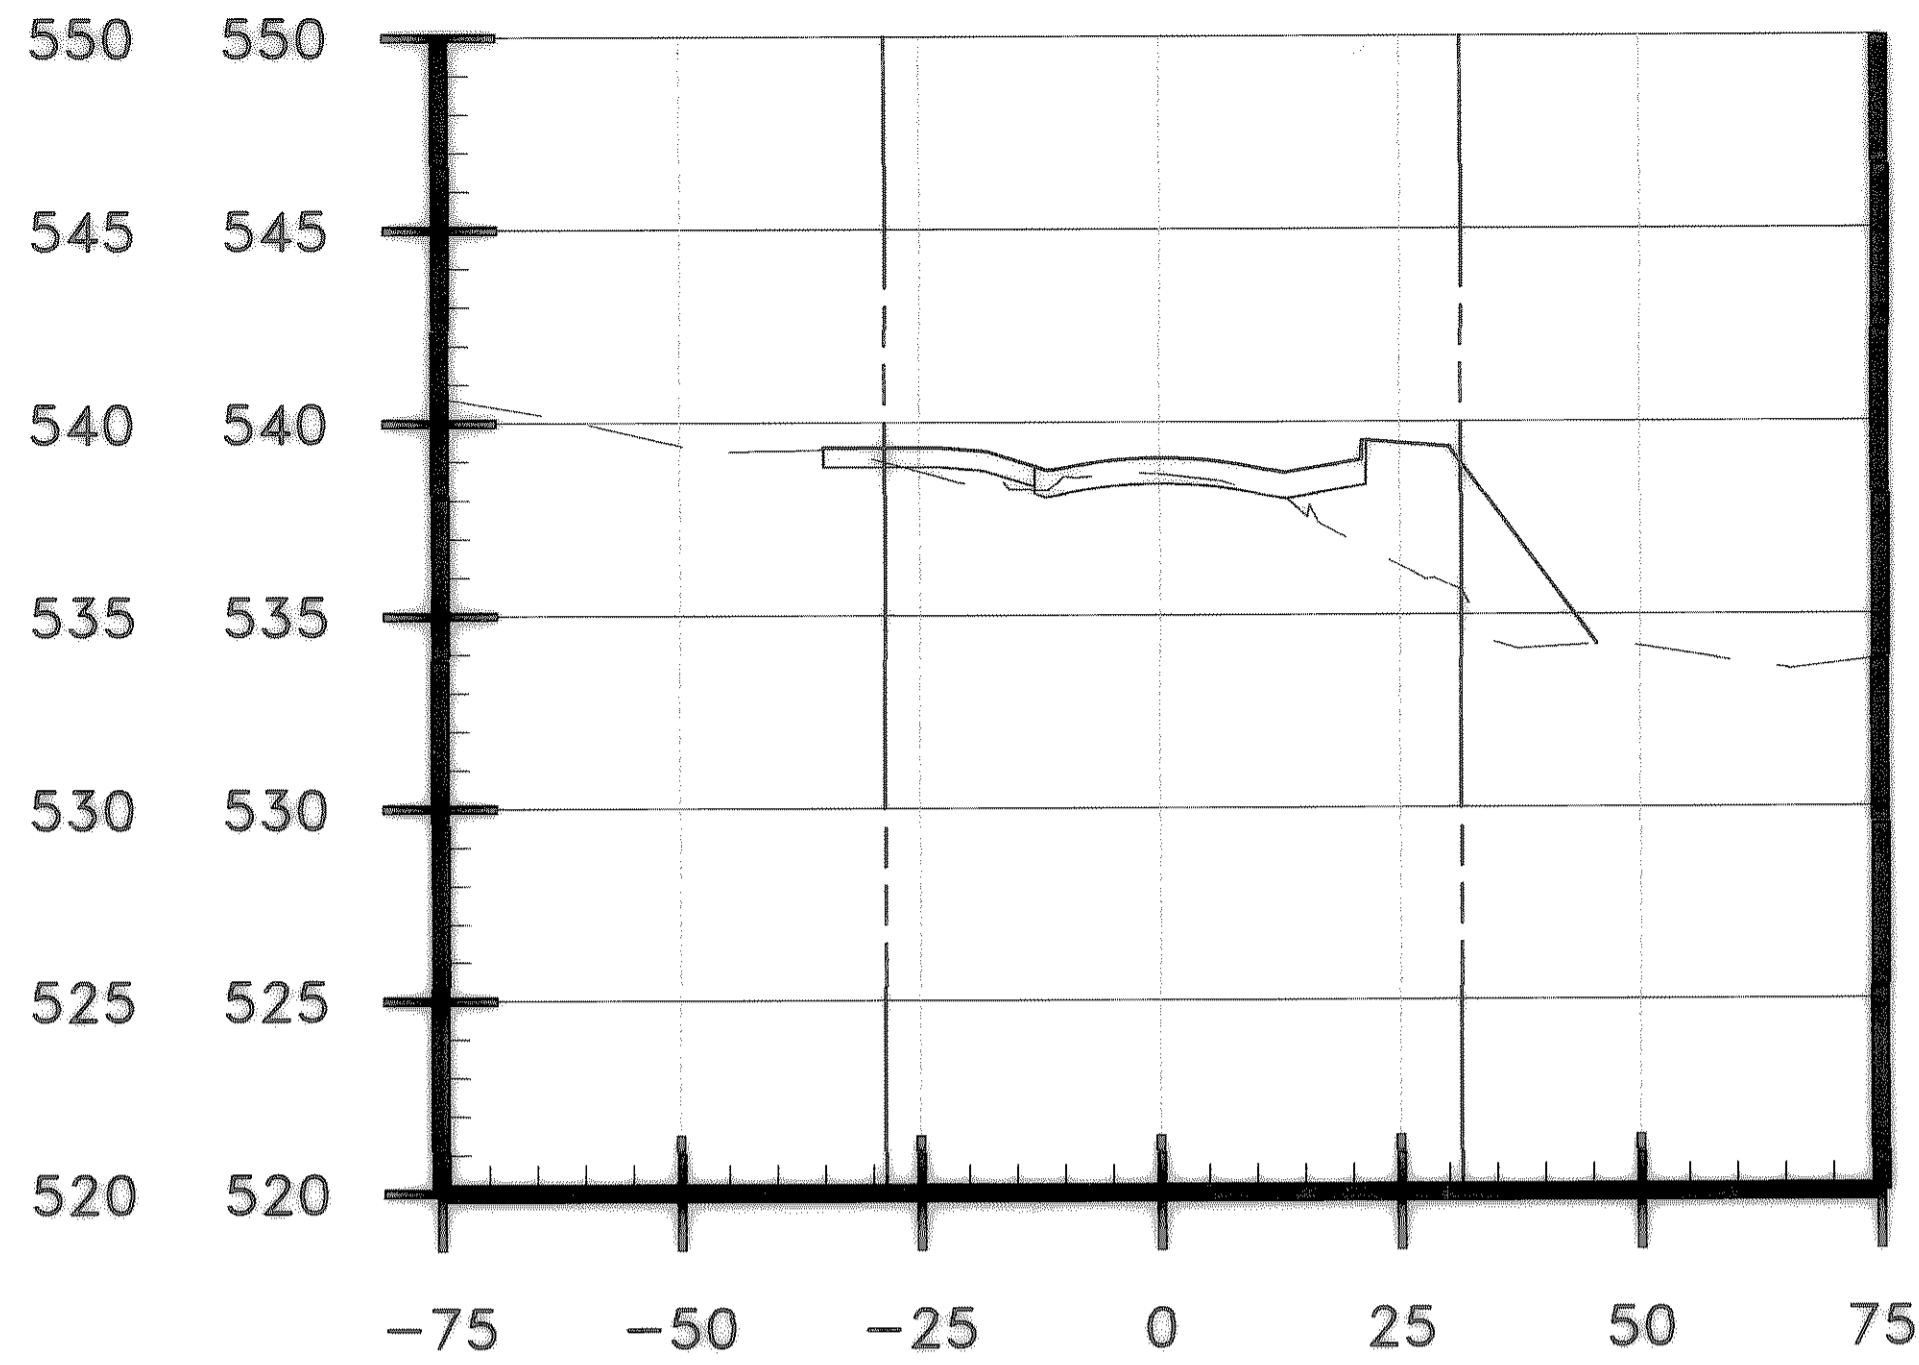


11+25

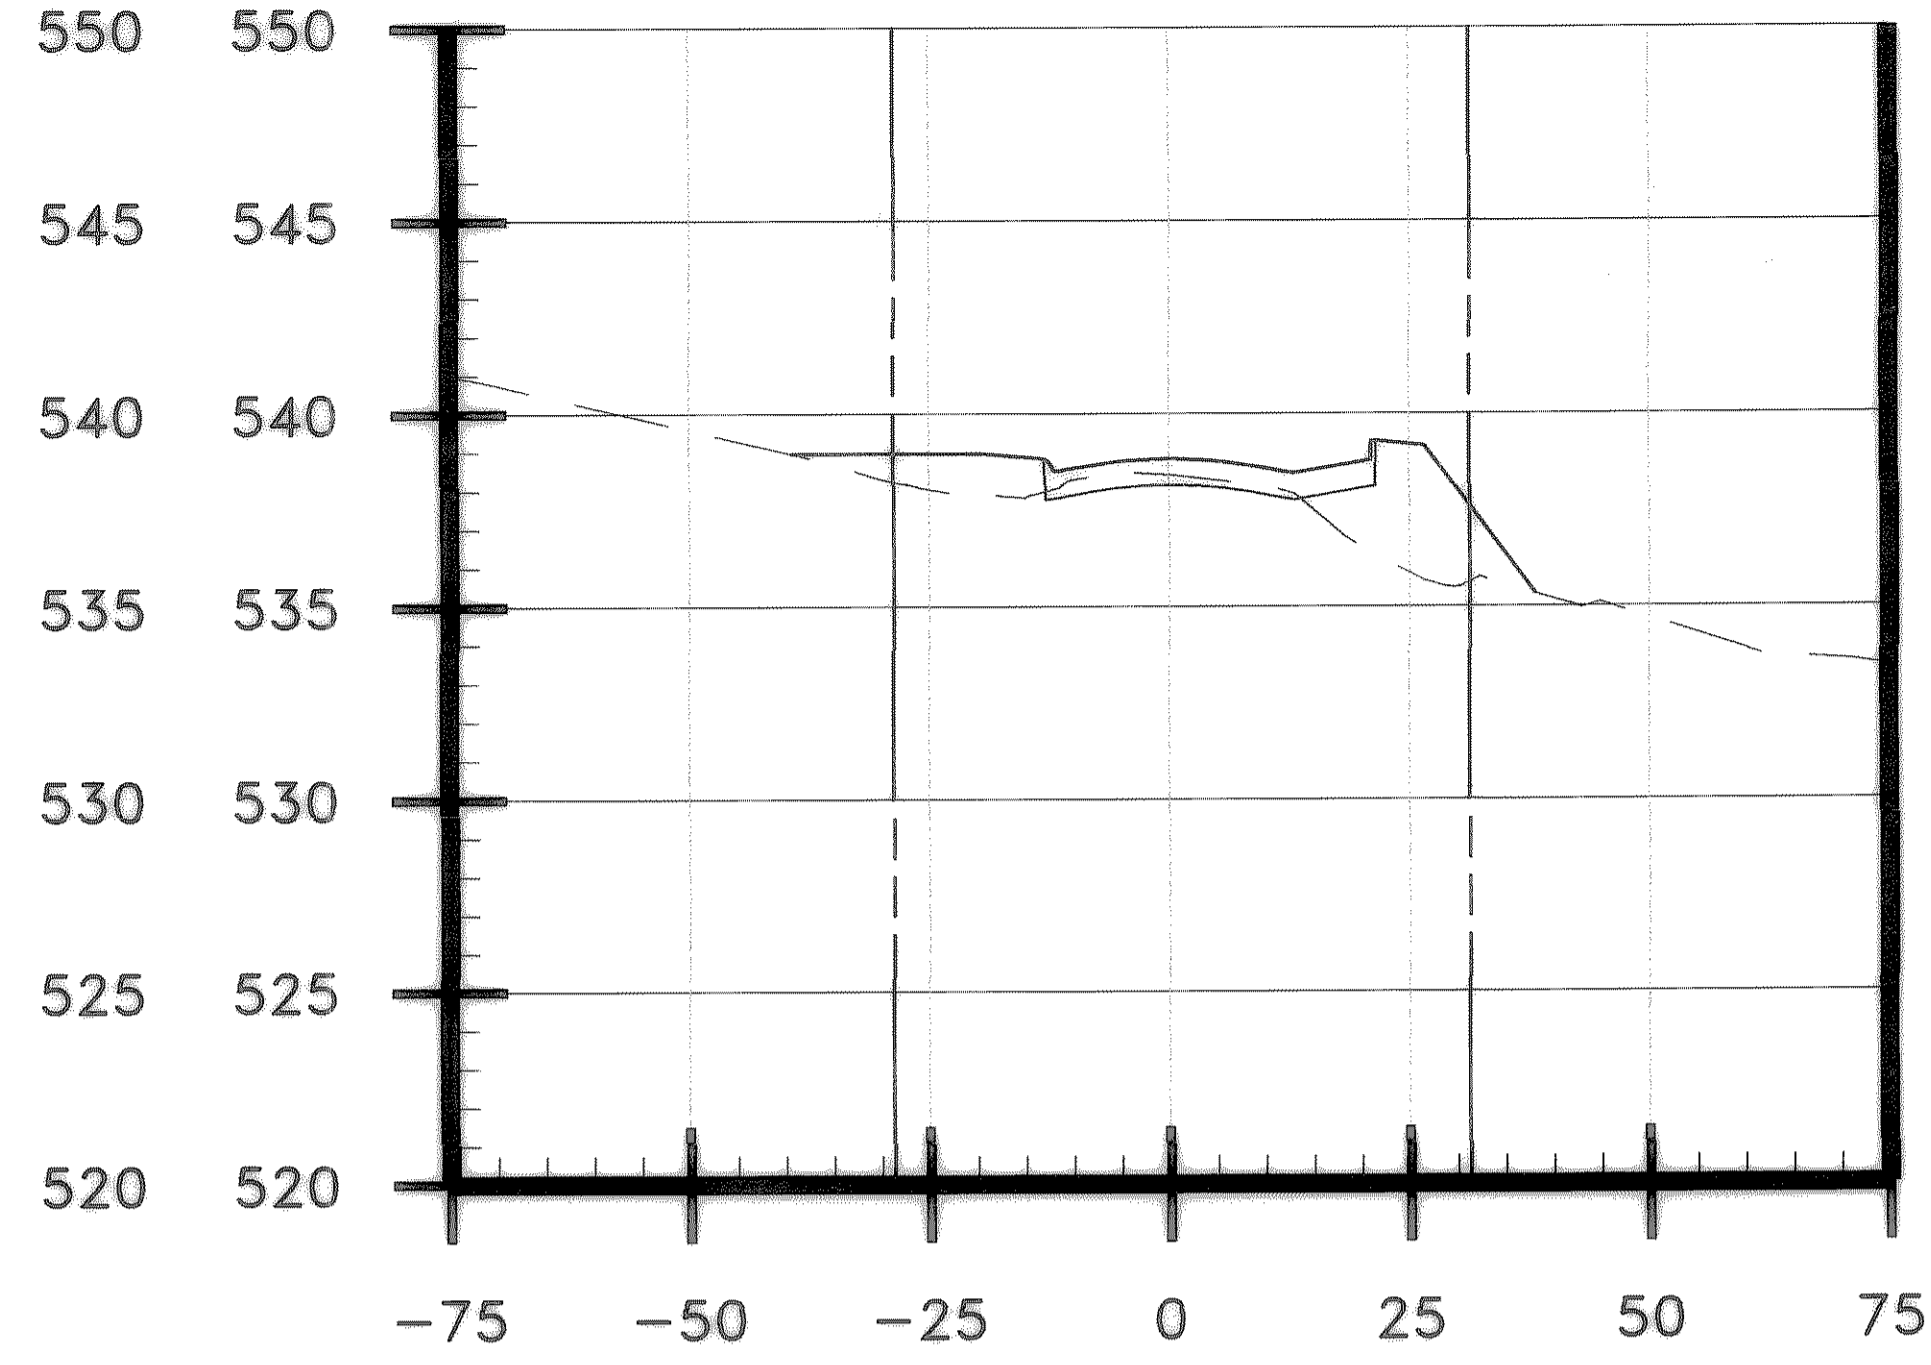


11+75

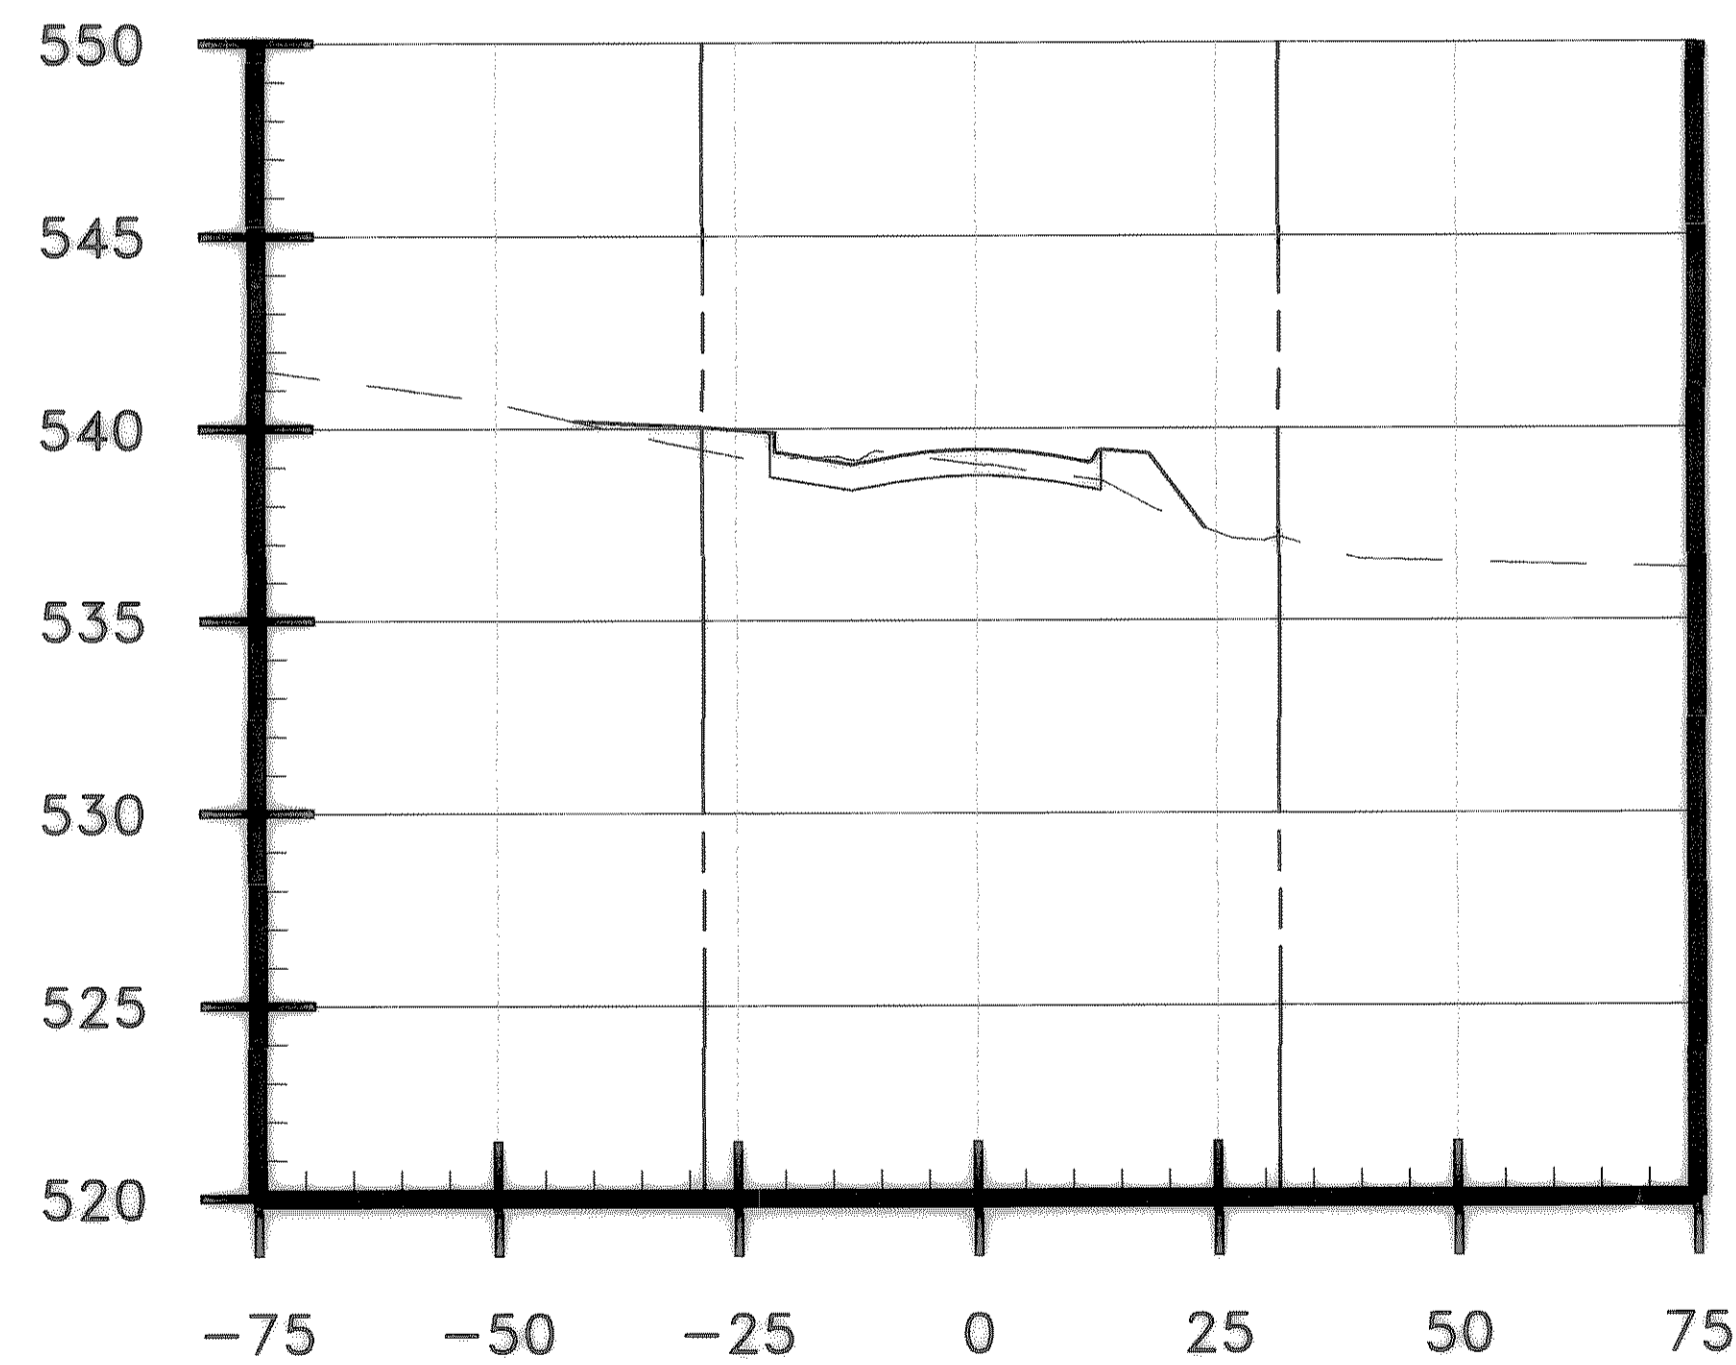

10+50

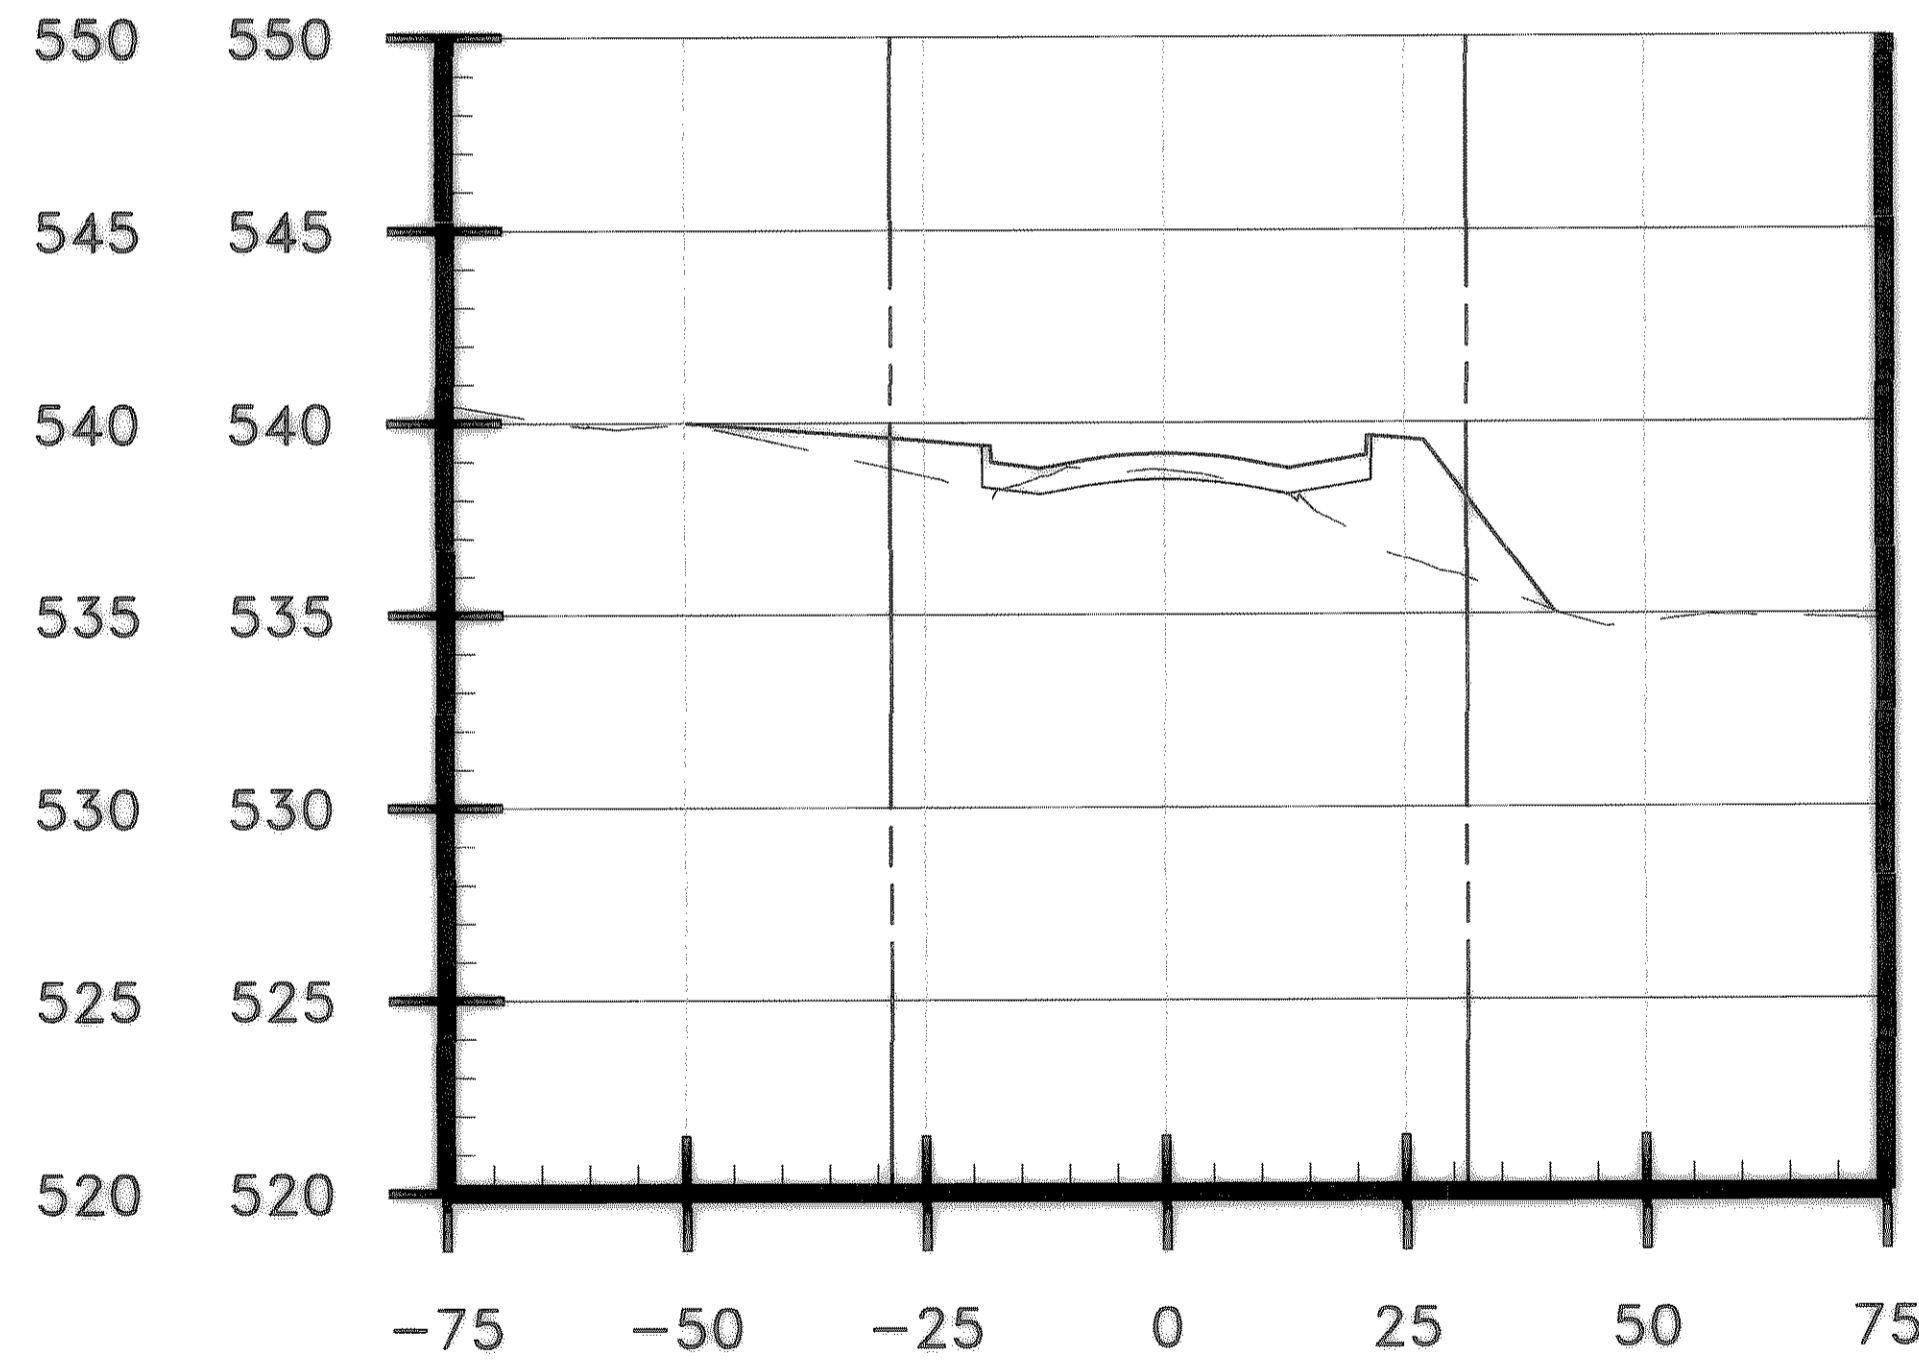

11+00

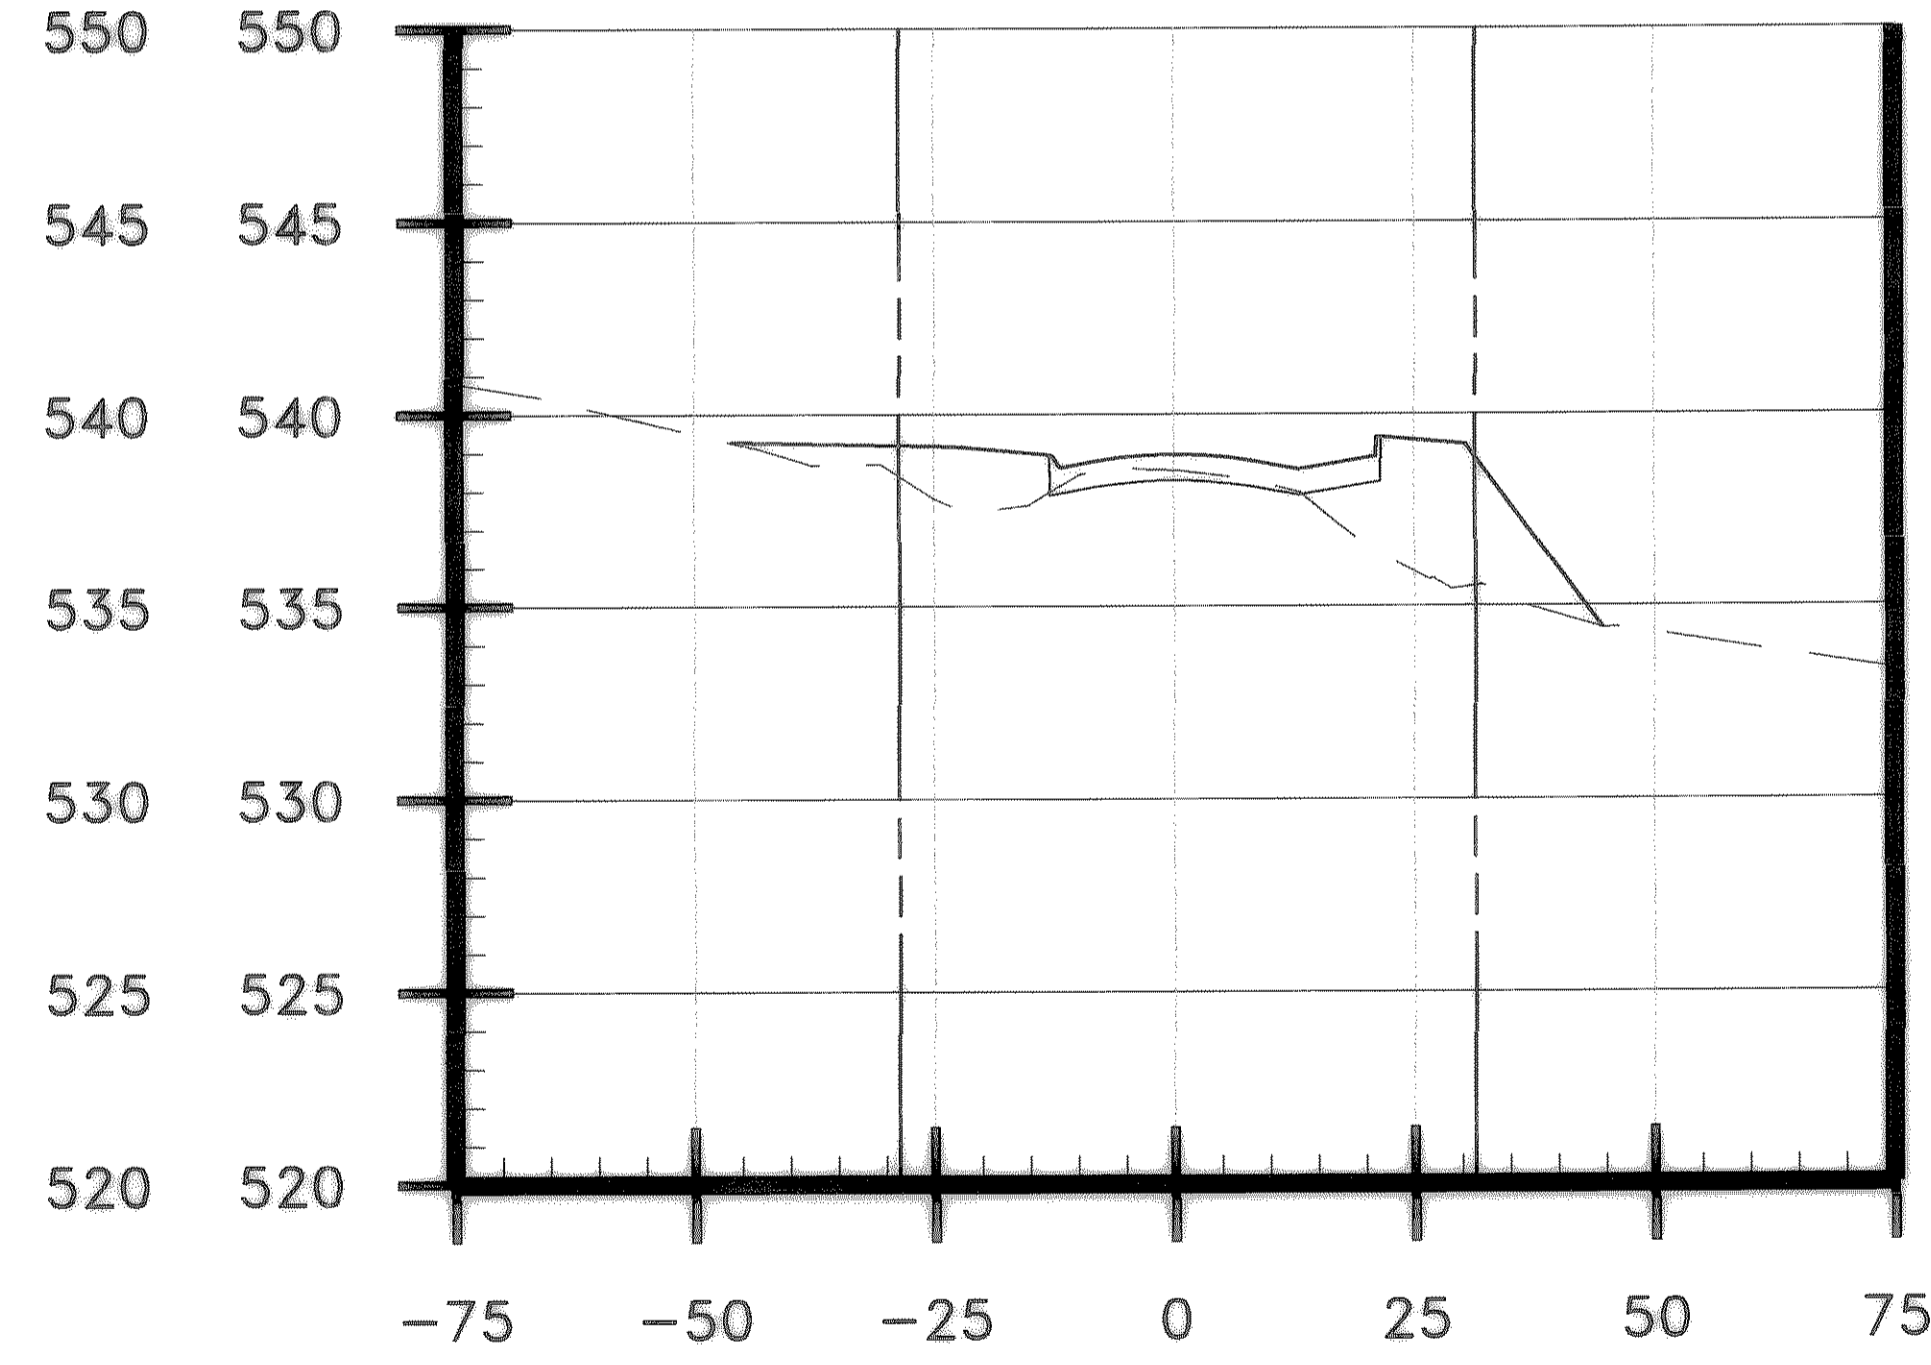


11+50

These plans and related specifications were prepared for construction of this specific project only. Reuse of these documents is not permitted without written authorization of Birkhoff, Hendricks & Conway, L.L.P.

CITY OF ROCKWALL, TEXAS

CLARK STREET  
CROSS SECTIONS

BIRKHOFF, HENDRICKS & CONWAY, L.L.P.  
CONSULTING ENGINEERS  
Dallas, Texas

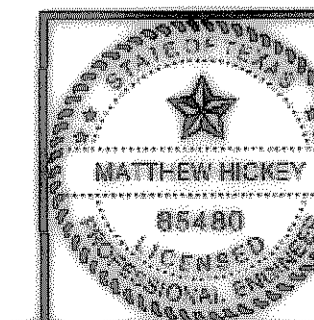

REVISED TO CONFORM  
TO CONSTRUCTION RECORDS  
BY M.H. DATE 12/04/2006

THESE DOCUMENTS ARE FOR  
BIDDING, CONSTRUCTION,  
AND PERMIT PURPOSES.

DATE: 8/1/04

DESIGNED BY: M.H. PROJECT: 2003-120 SHEET NO. 123  
DRAWN BY: B.H.C. DATE: AUGUST, 2004 OF 123 SHEETS