




06/22/04 CAG H:\ROCKWALL\2003120\INFROADS\GROSS-SEC\CLARK-SEC\CLARK-SEC.DWG SCALE: 1=20 XREF: ROCKWALL\2003120\BASE\PROP-BASE

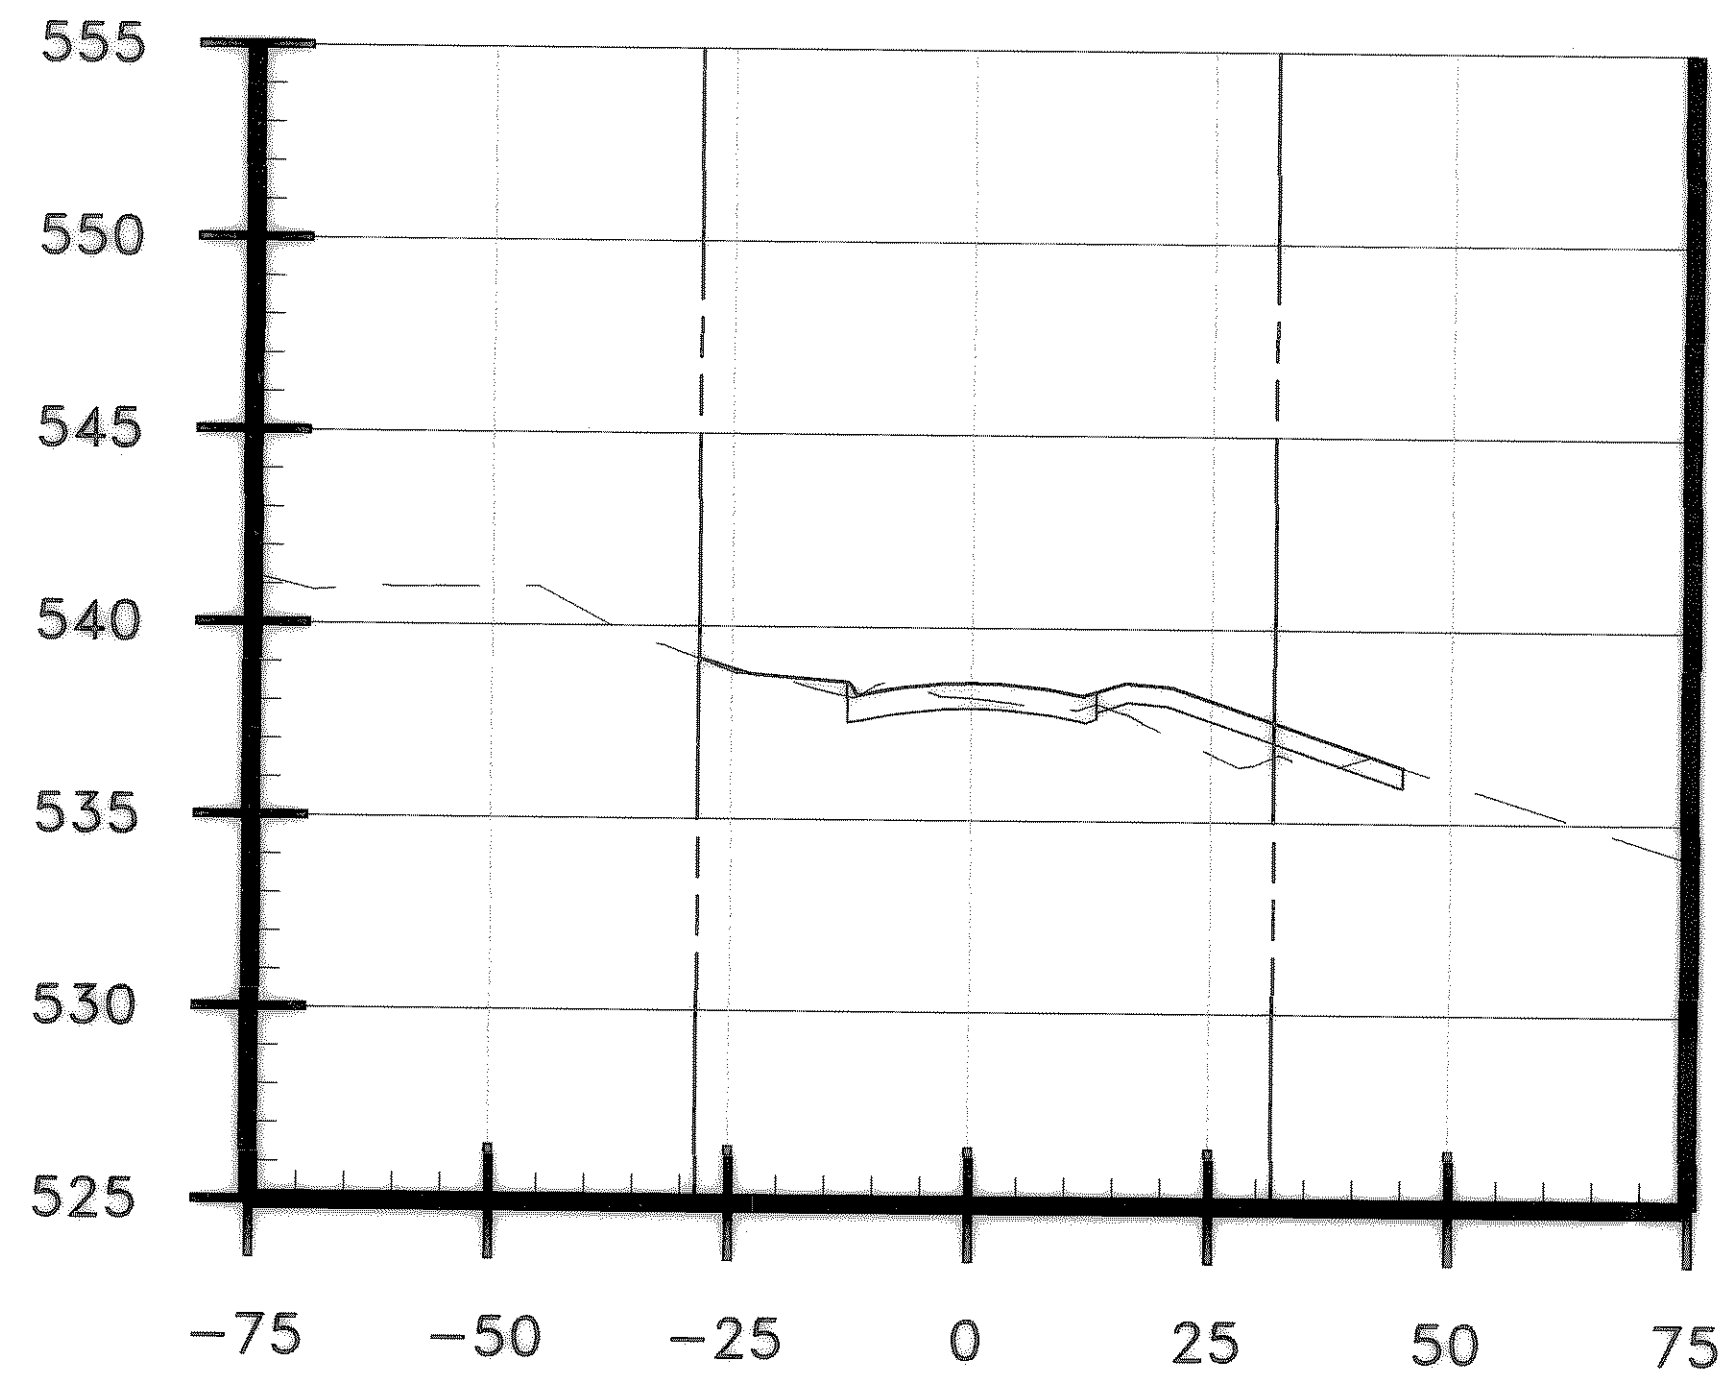


12+25

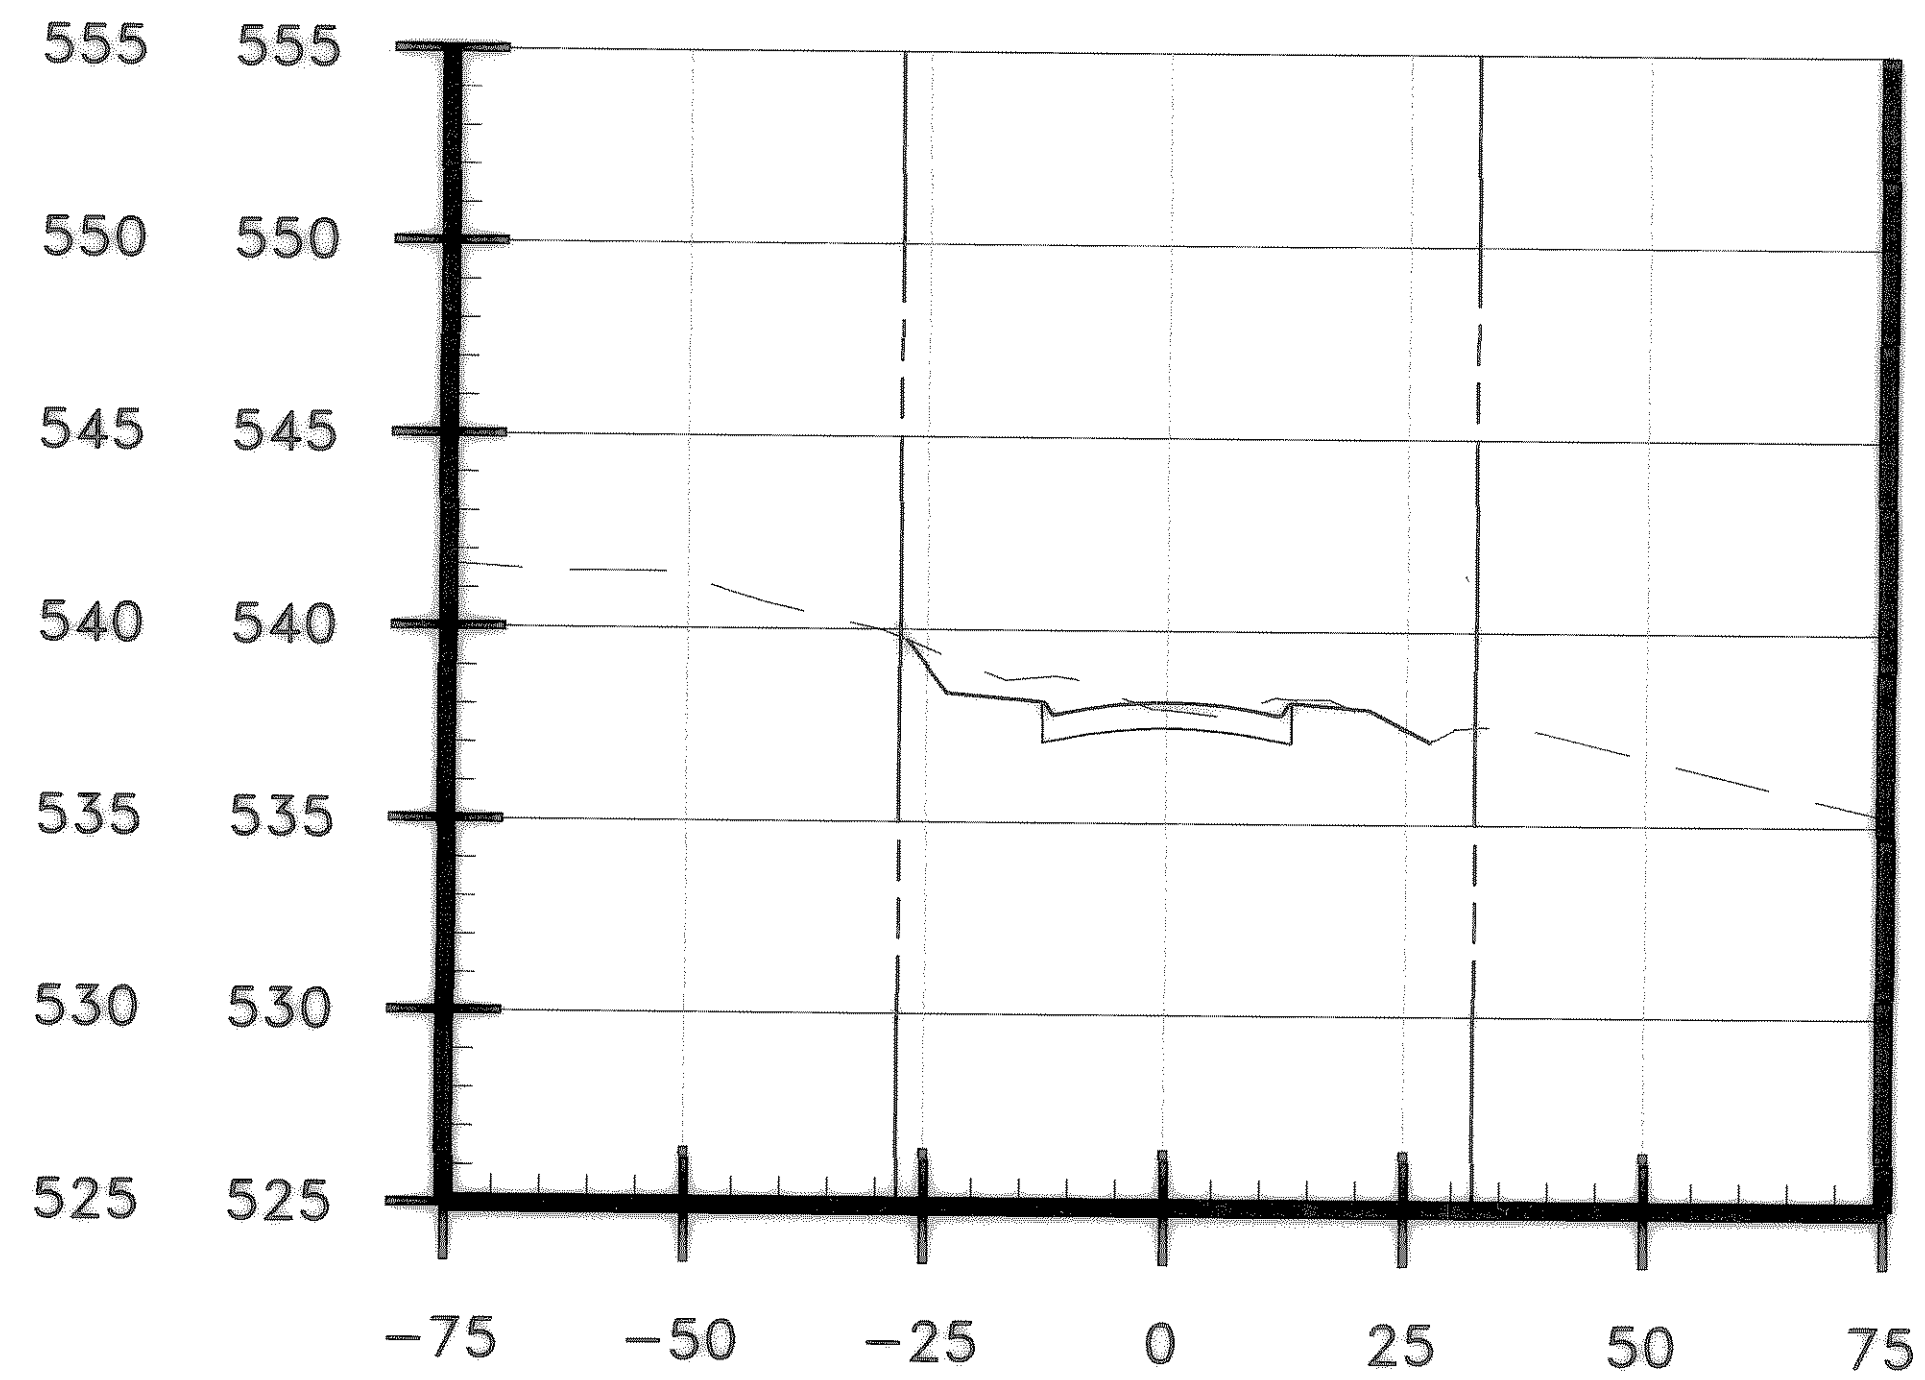


12+75

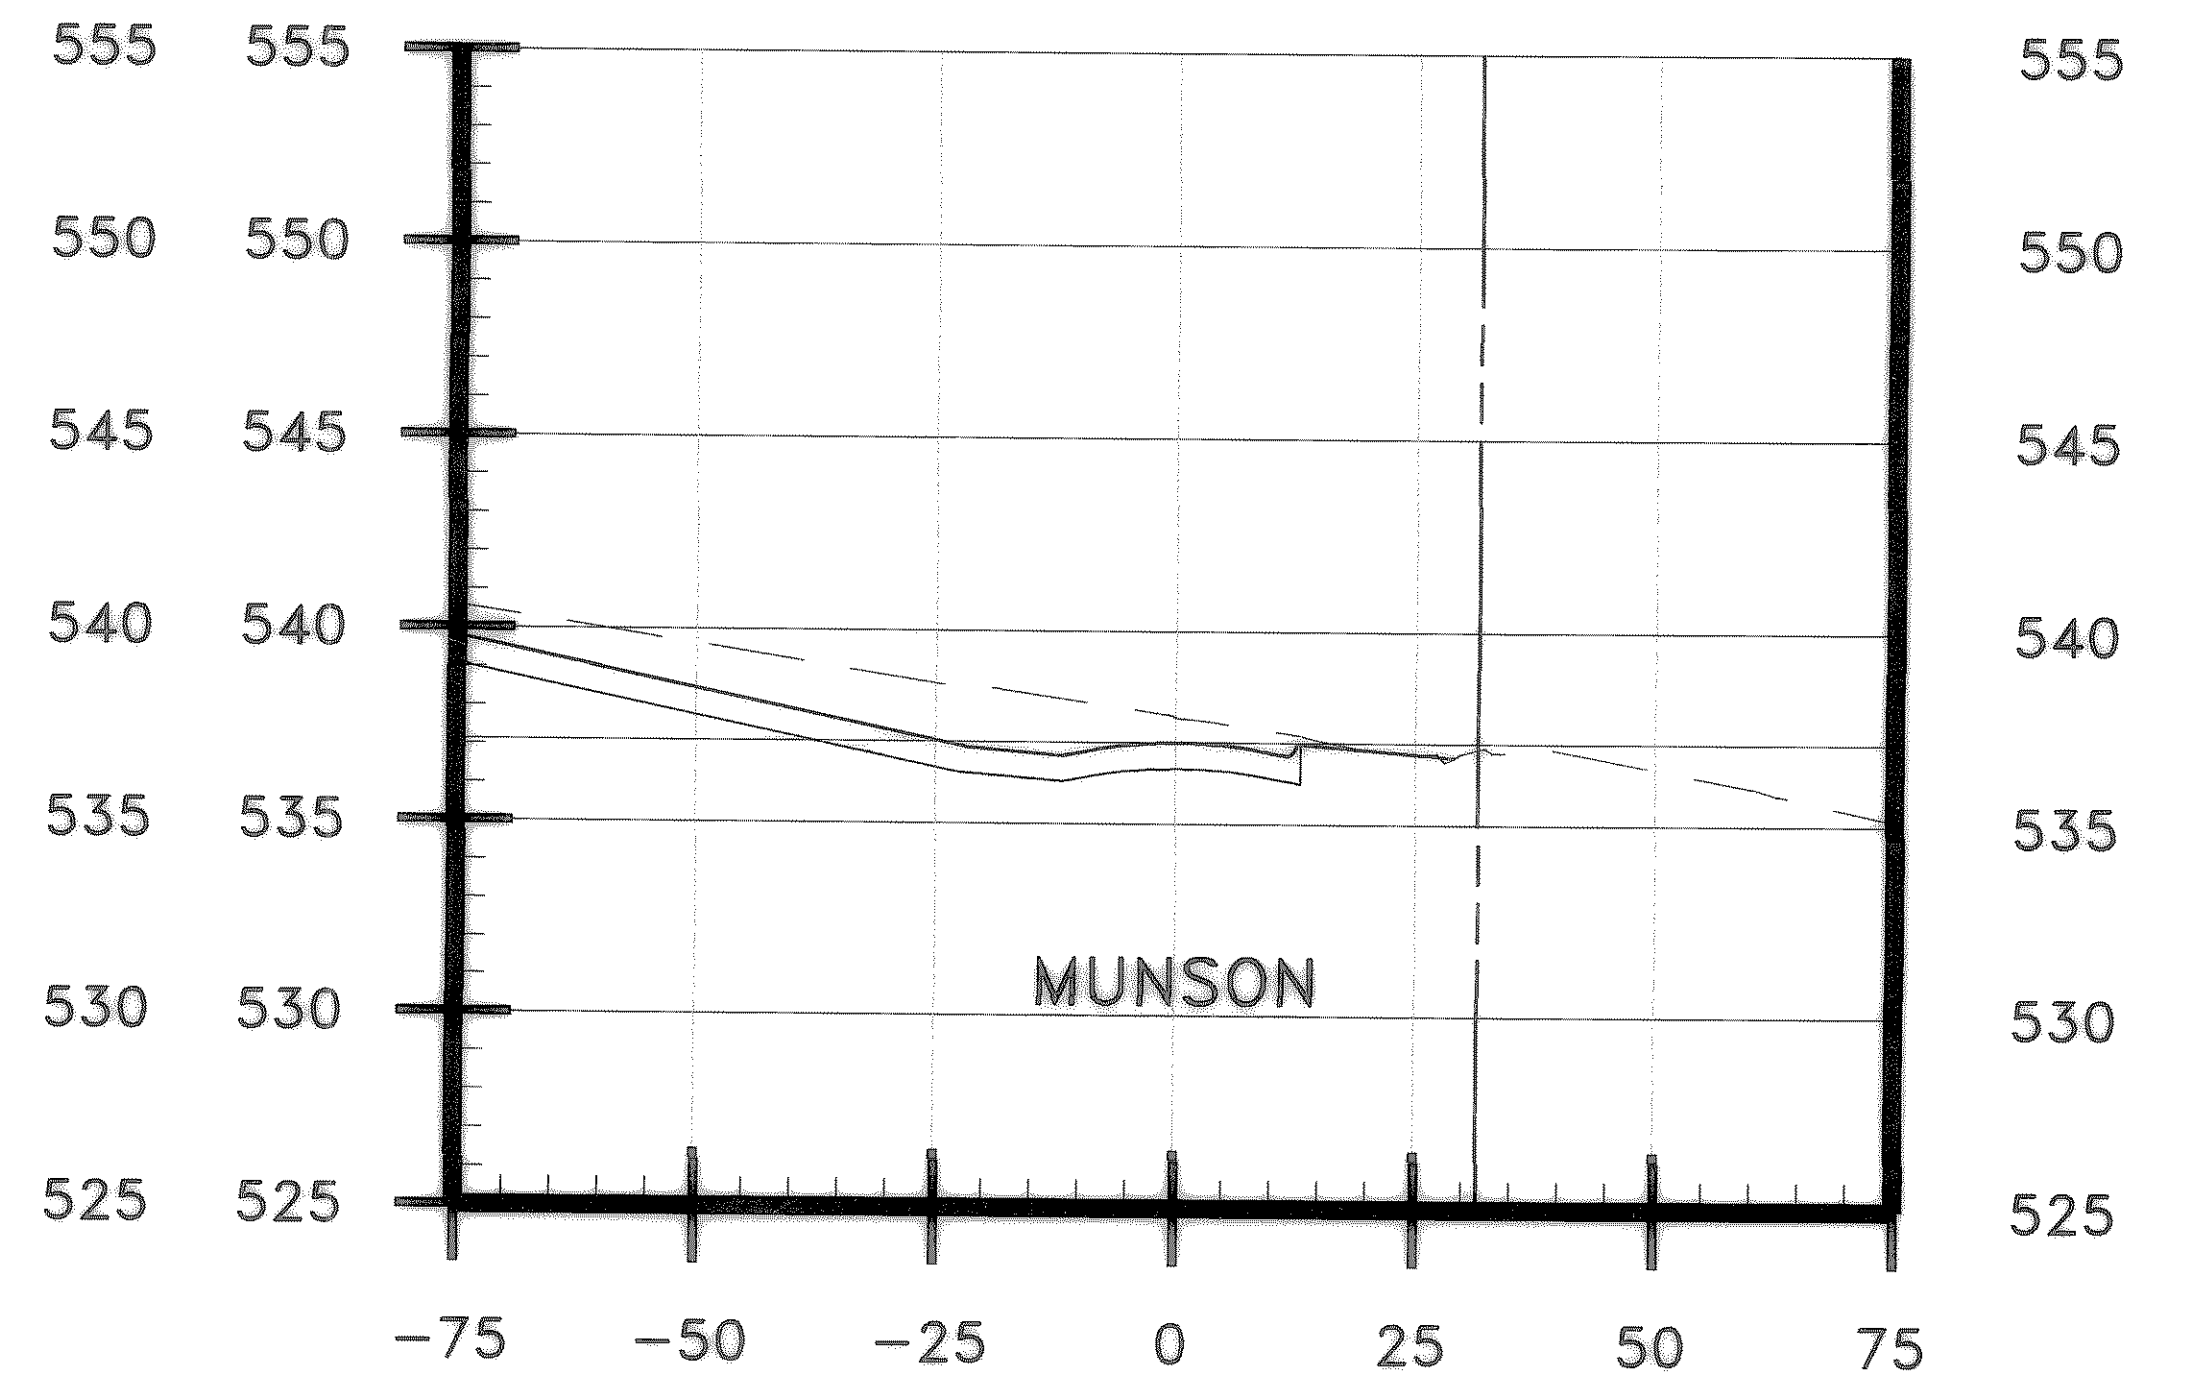


13+25

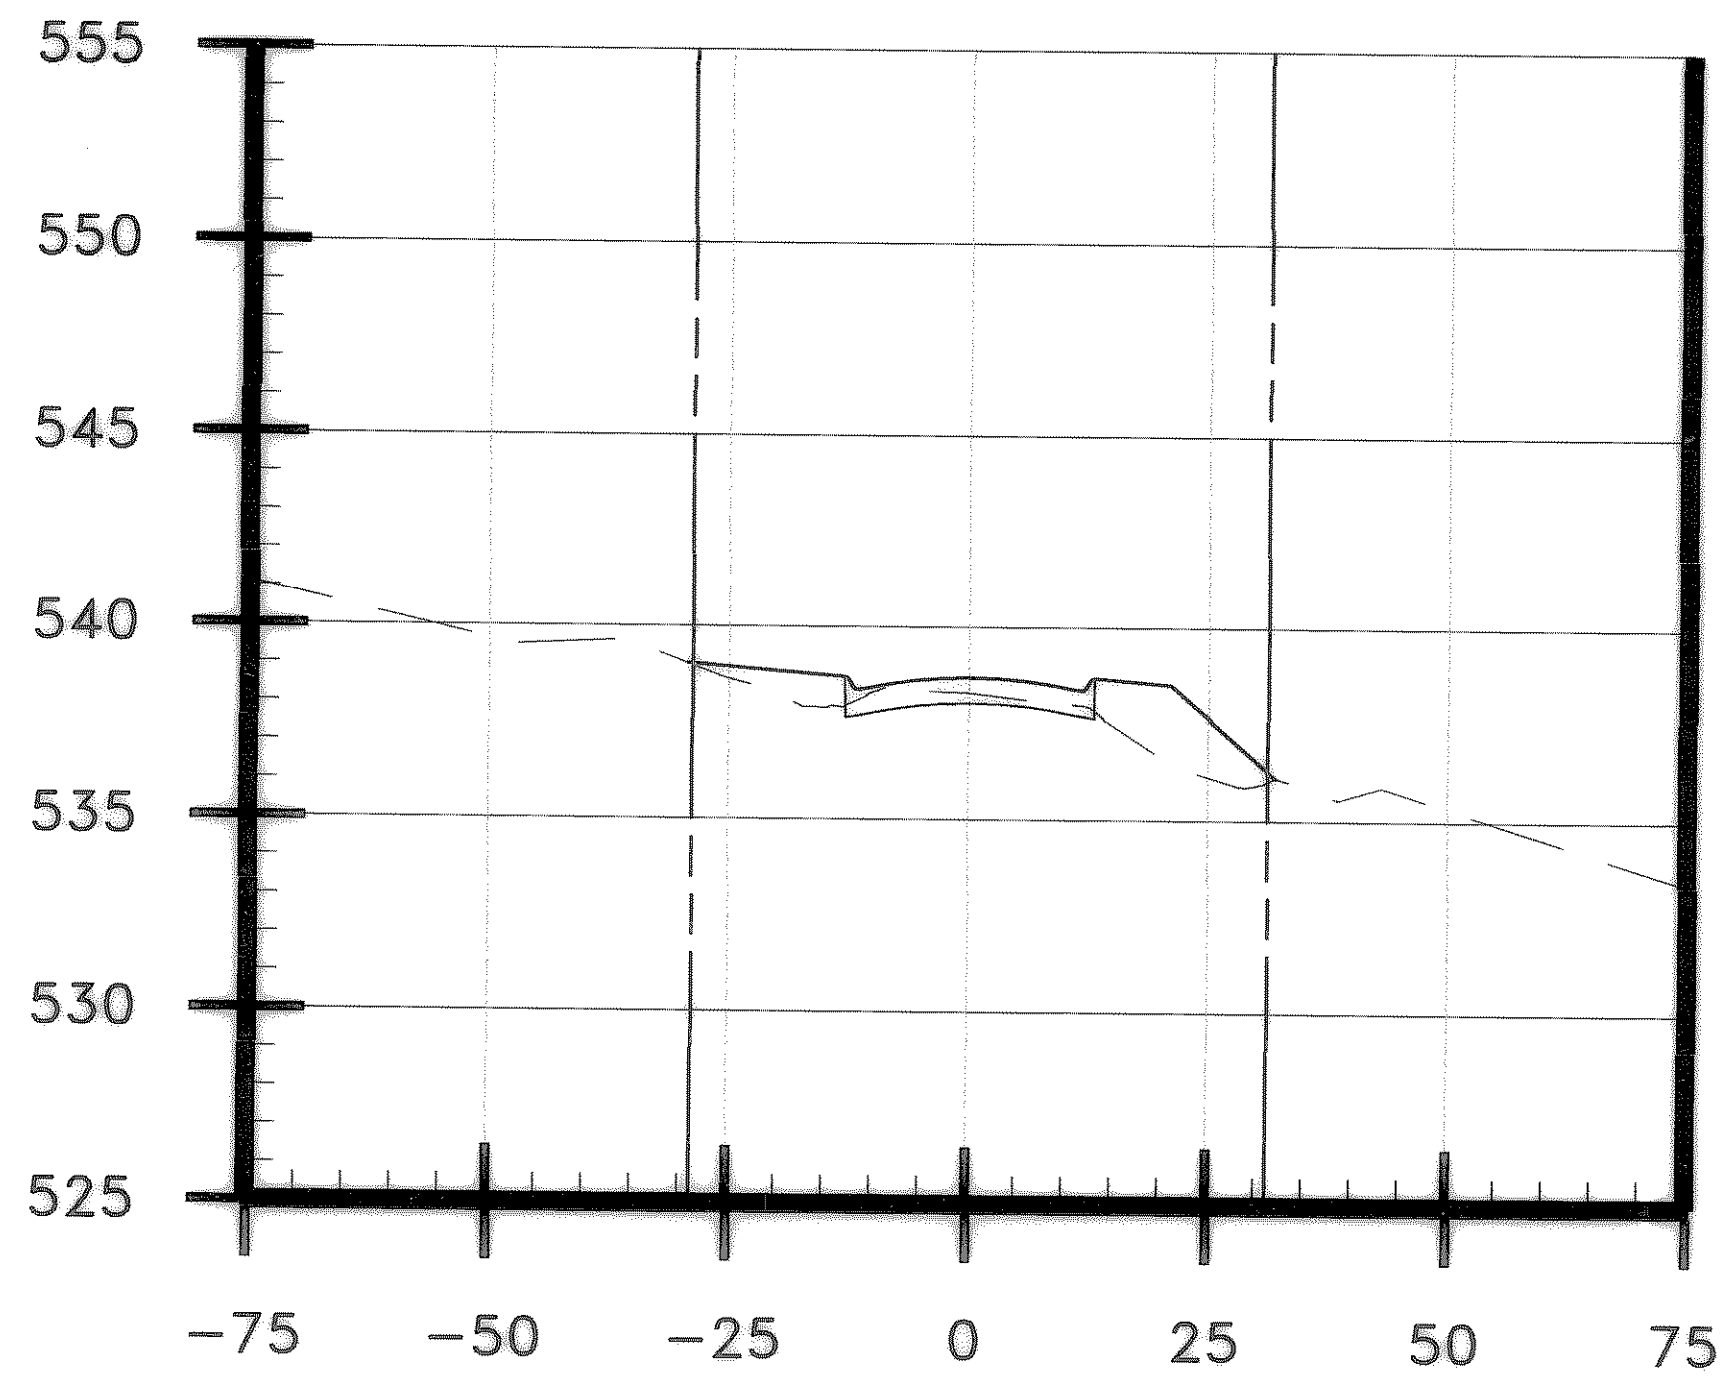

12+00

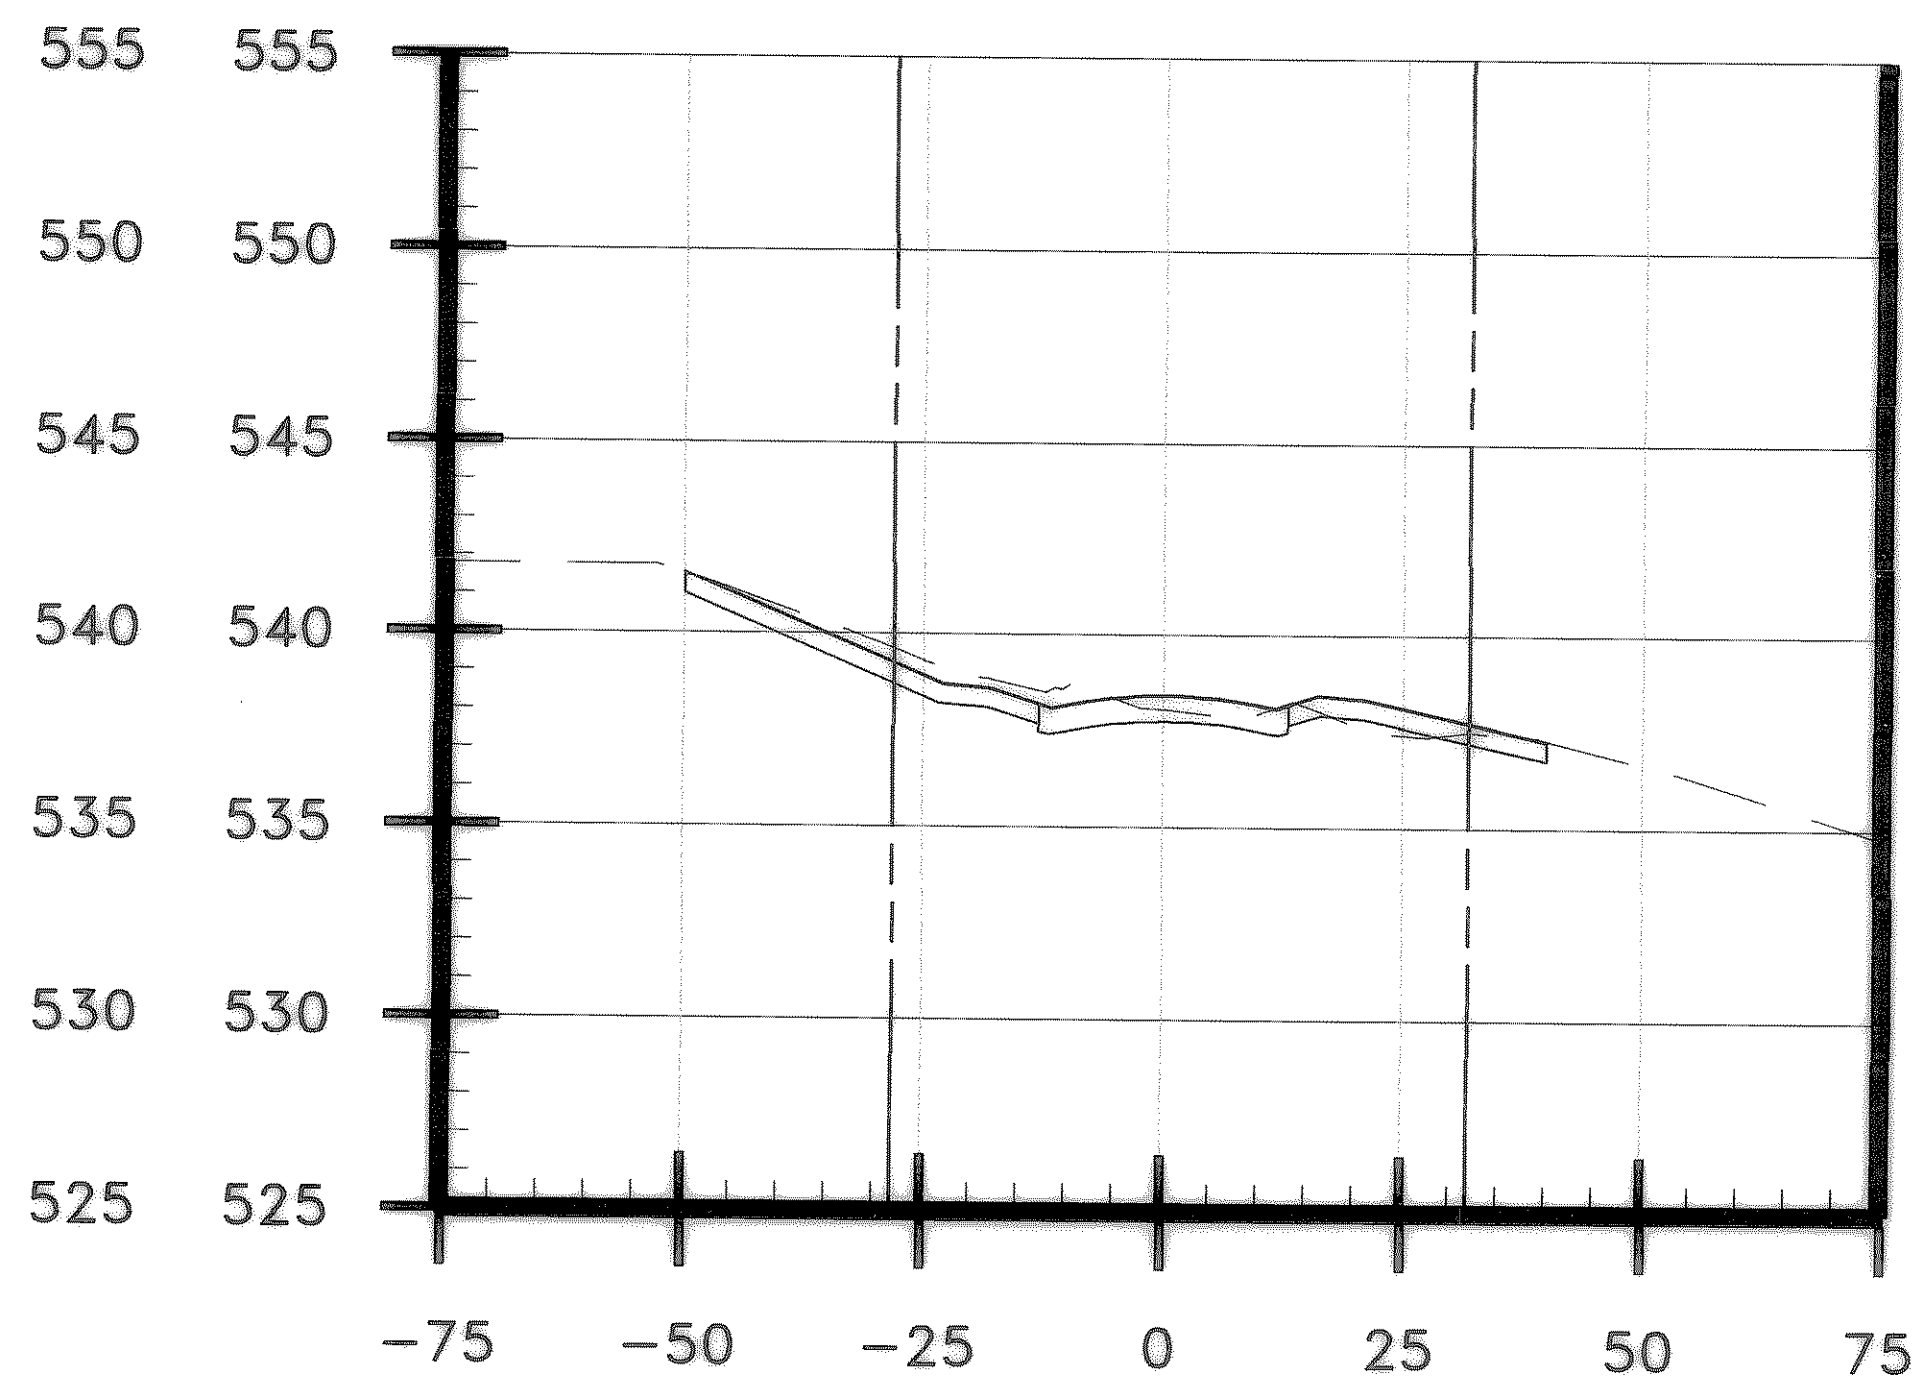

12+50

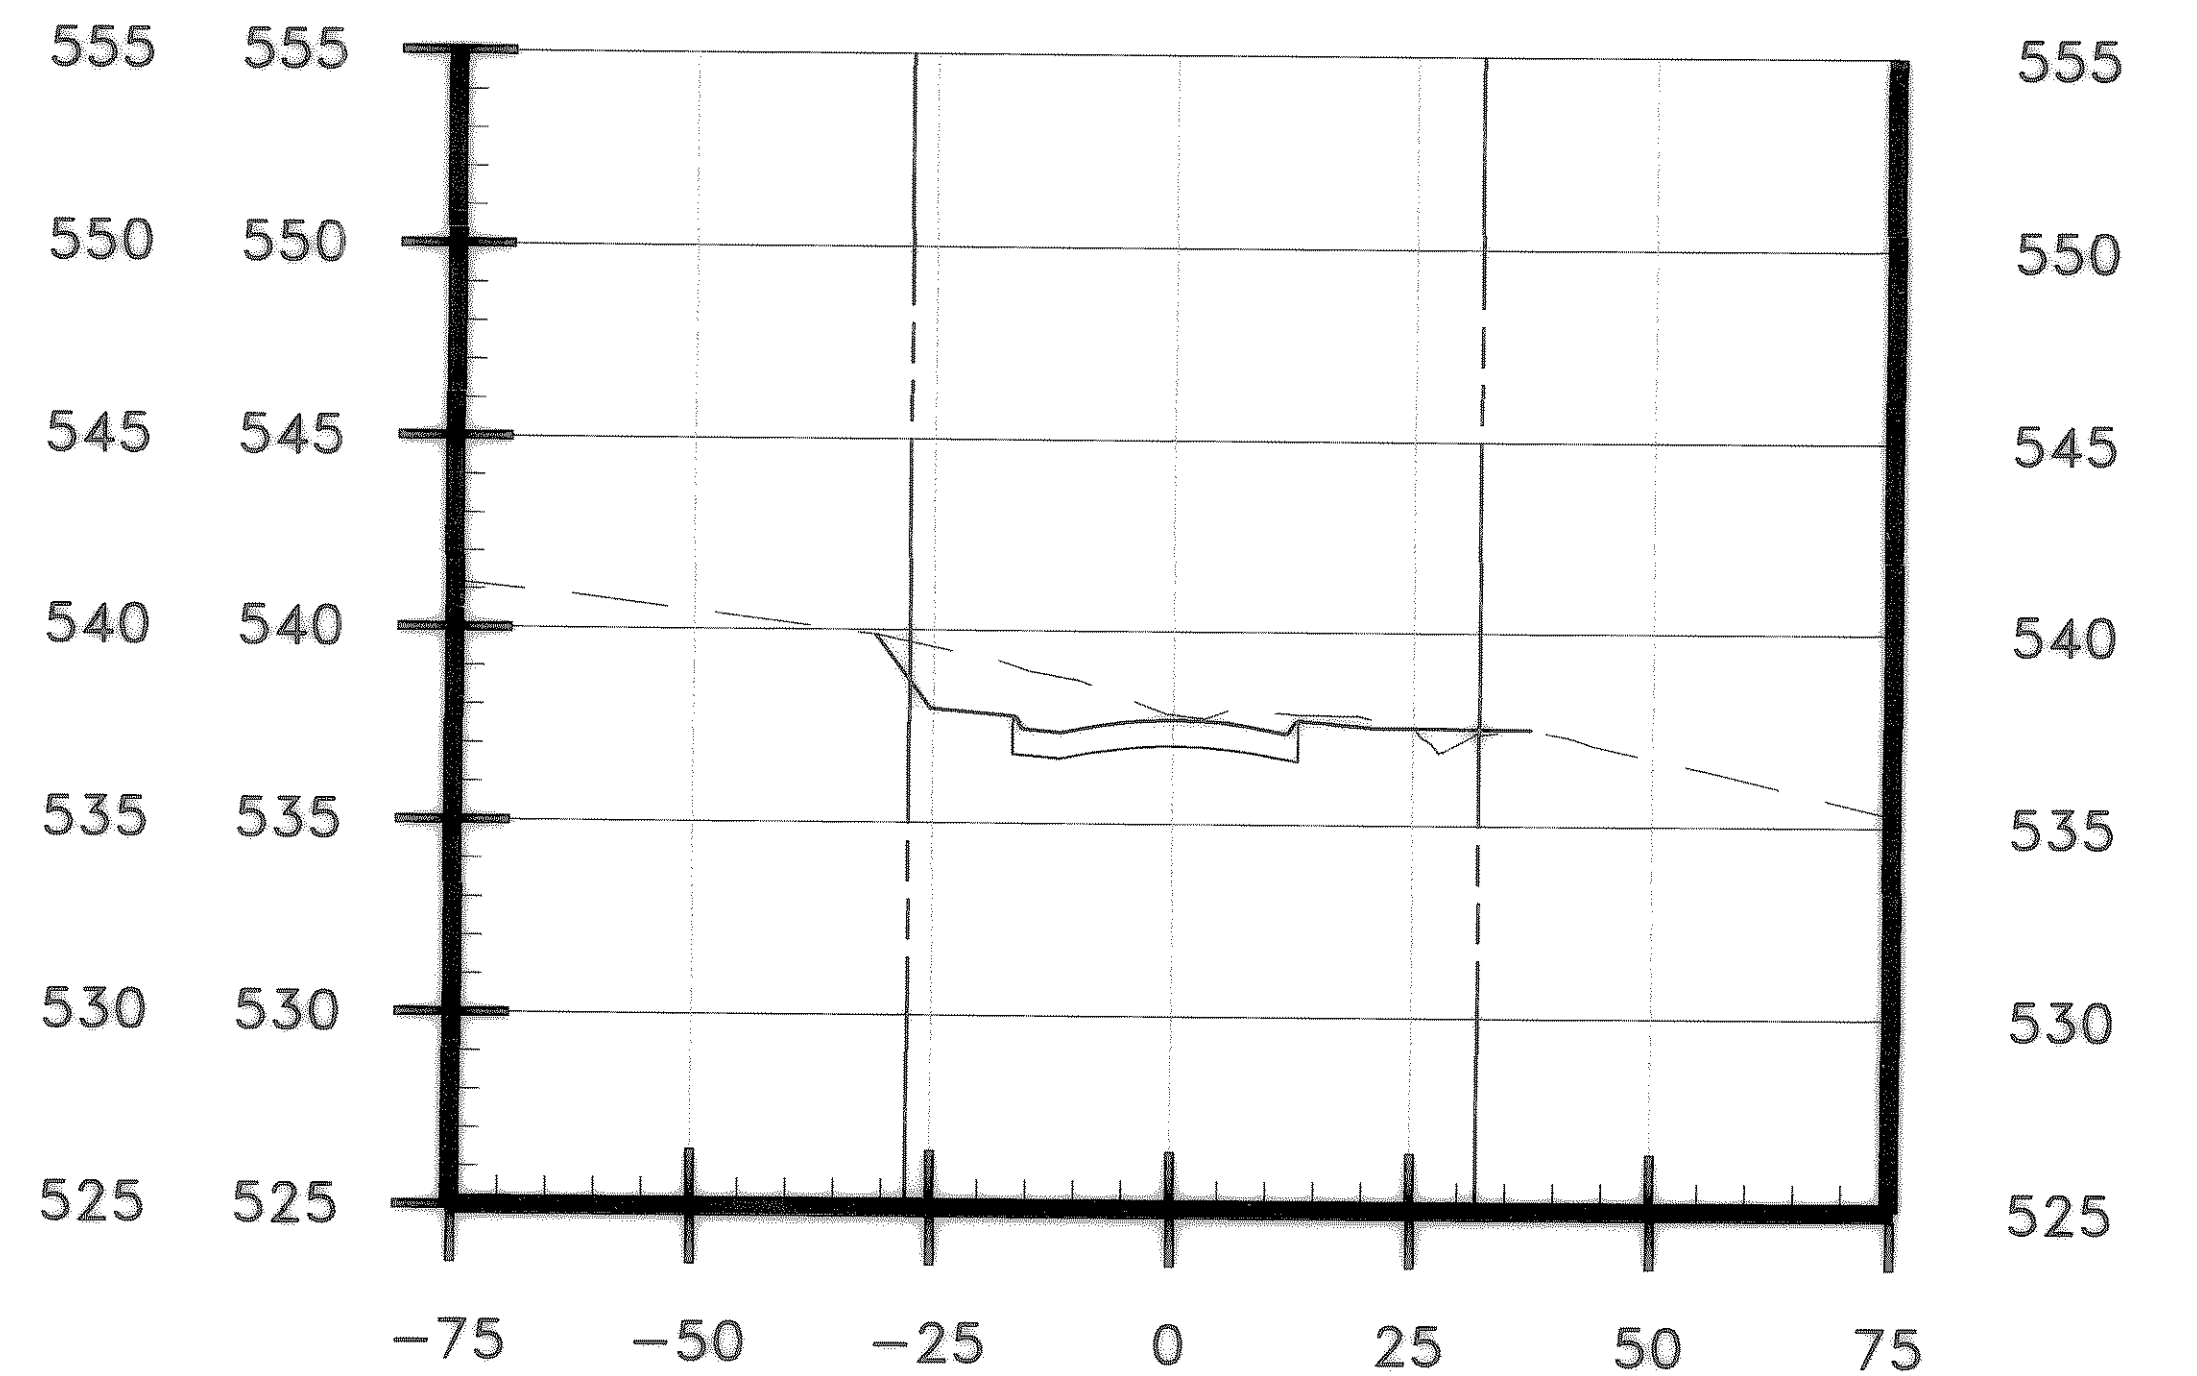

13+00

These plans and related specifications were prepared for construction of this specific project only. Reuse of these documents is not permitted without written authorization of Birkhoff, Hendricks & Conway, L.L.P.


CITY OF ROCKWALL, TEXAS

CLARK STREET
CROSS SECTIONS

BIRKHOFF, HENDRICKS & CONWAY, L.L.P.
CONSULTING ENGINEERS
Dallas, Texas

REVISED TO CONFORM
TO CONSTRUCTION RECORDS
BY M.H. DATE 12/04/2006

THESE DOCUMENTS ARE FOR
BIDDING, CONSTRUCTION,
AND PERMIT PURPOSES.
M.H.
DATE: 12/04/06

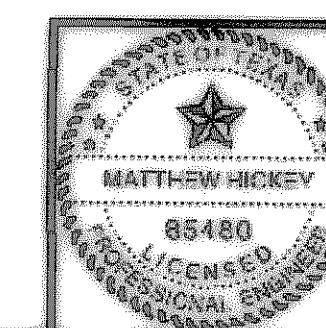

DESIGNED BY: M.H. PROJECT: 2003-120 SHEET NO. 124
DRAWN BY: B.H.C. DATE: AUGUST, 2004 OF 124 SHEETS