




H:\ROCKWALL\2003120\INROADS\GROSS-SEC\CLARK-XSECT.DWG SCALE: 1=20 XREF: ROCKWALL\2003120\BASE\PROP-BASE 06/22/04 CAG

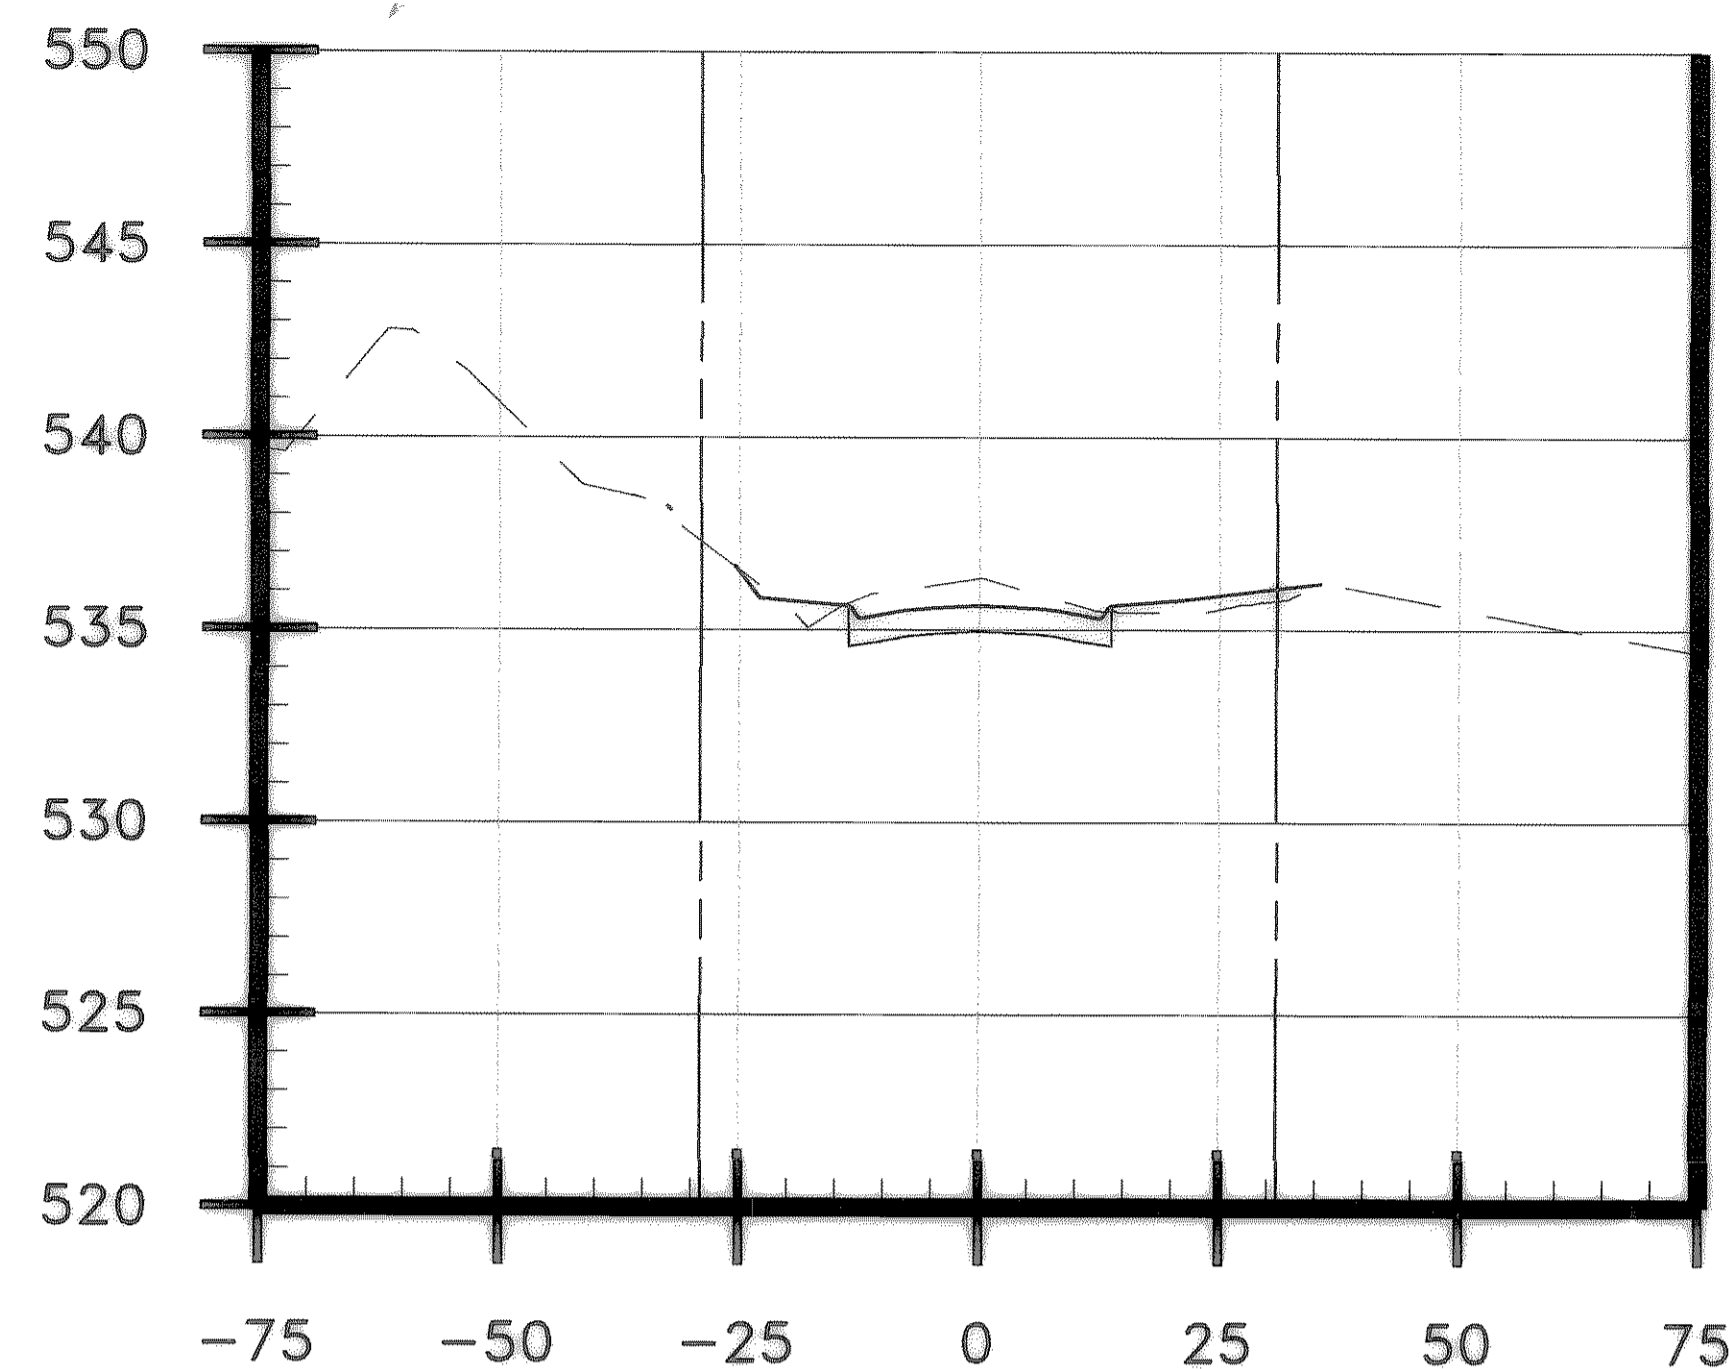


13+75

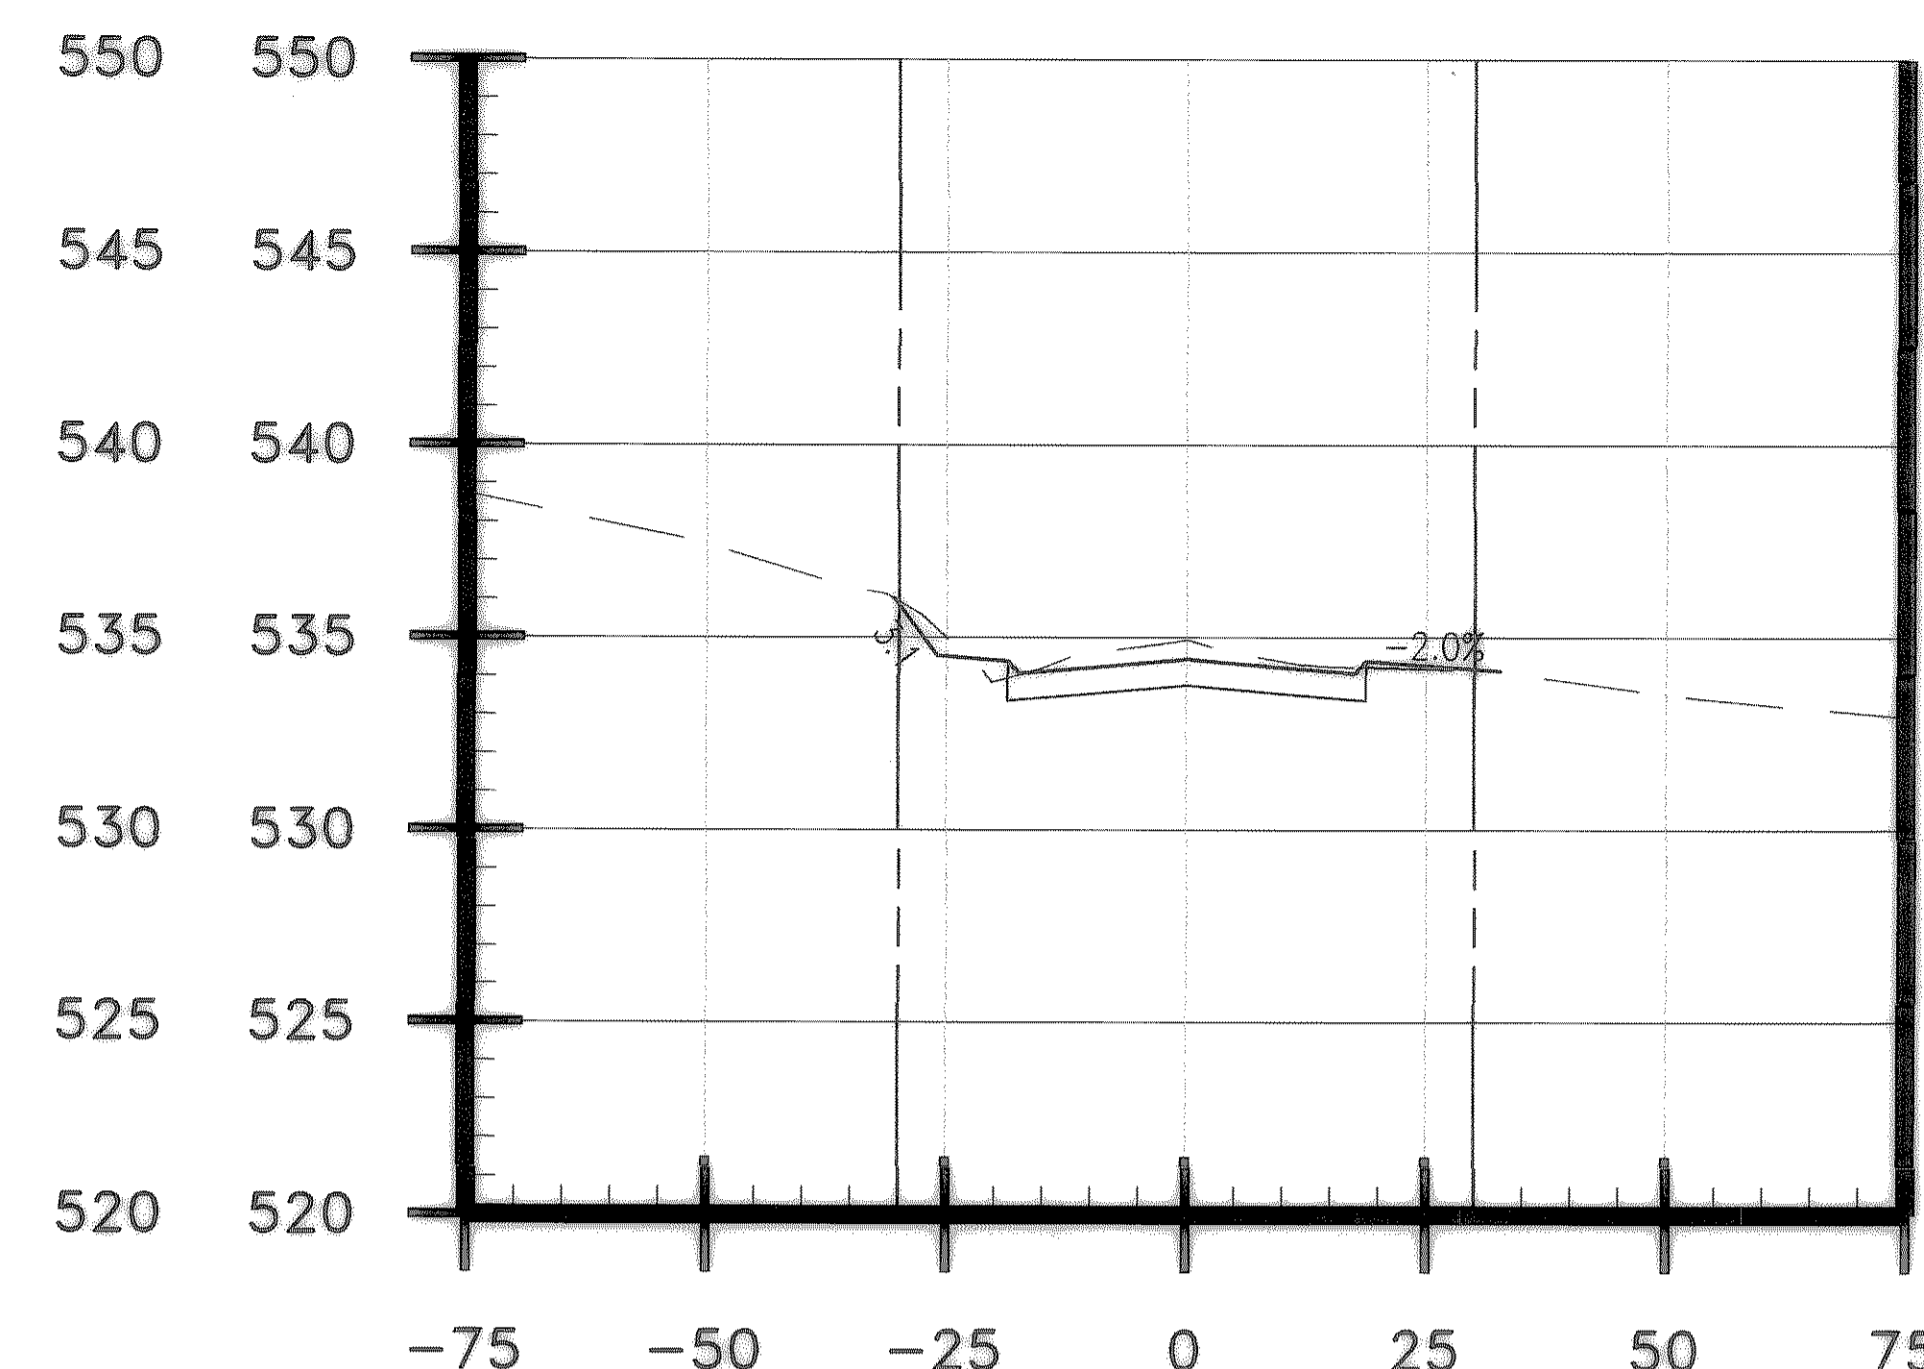


14+25

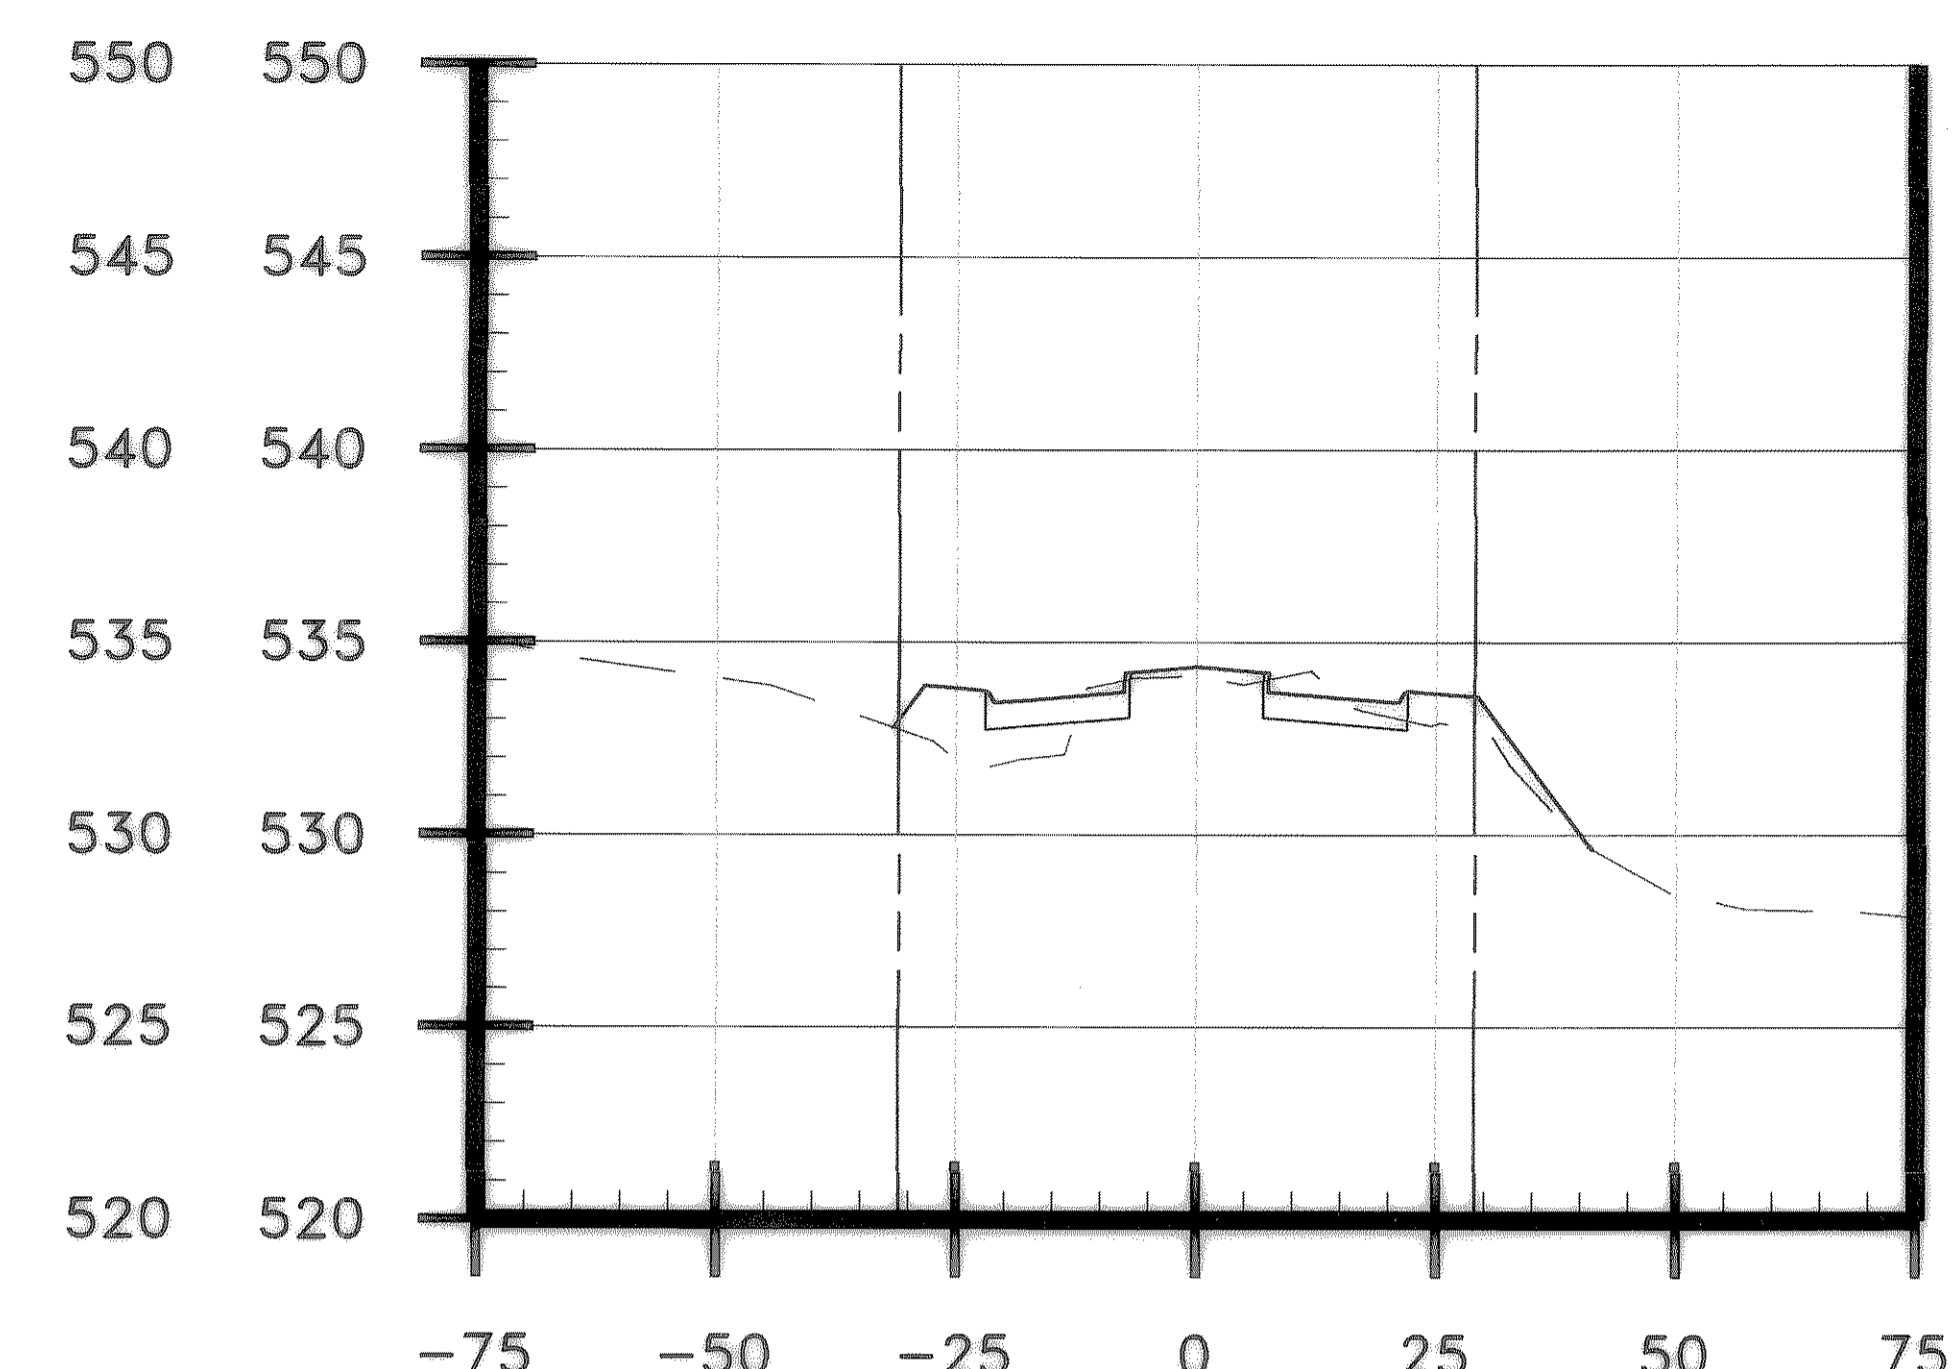


14+75

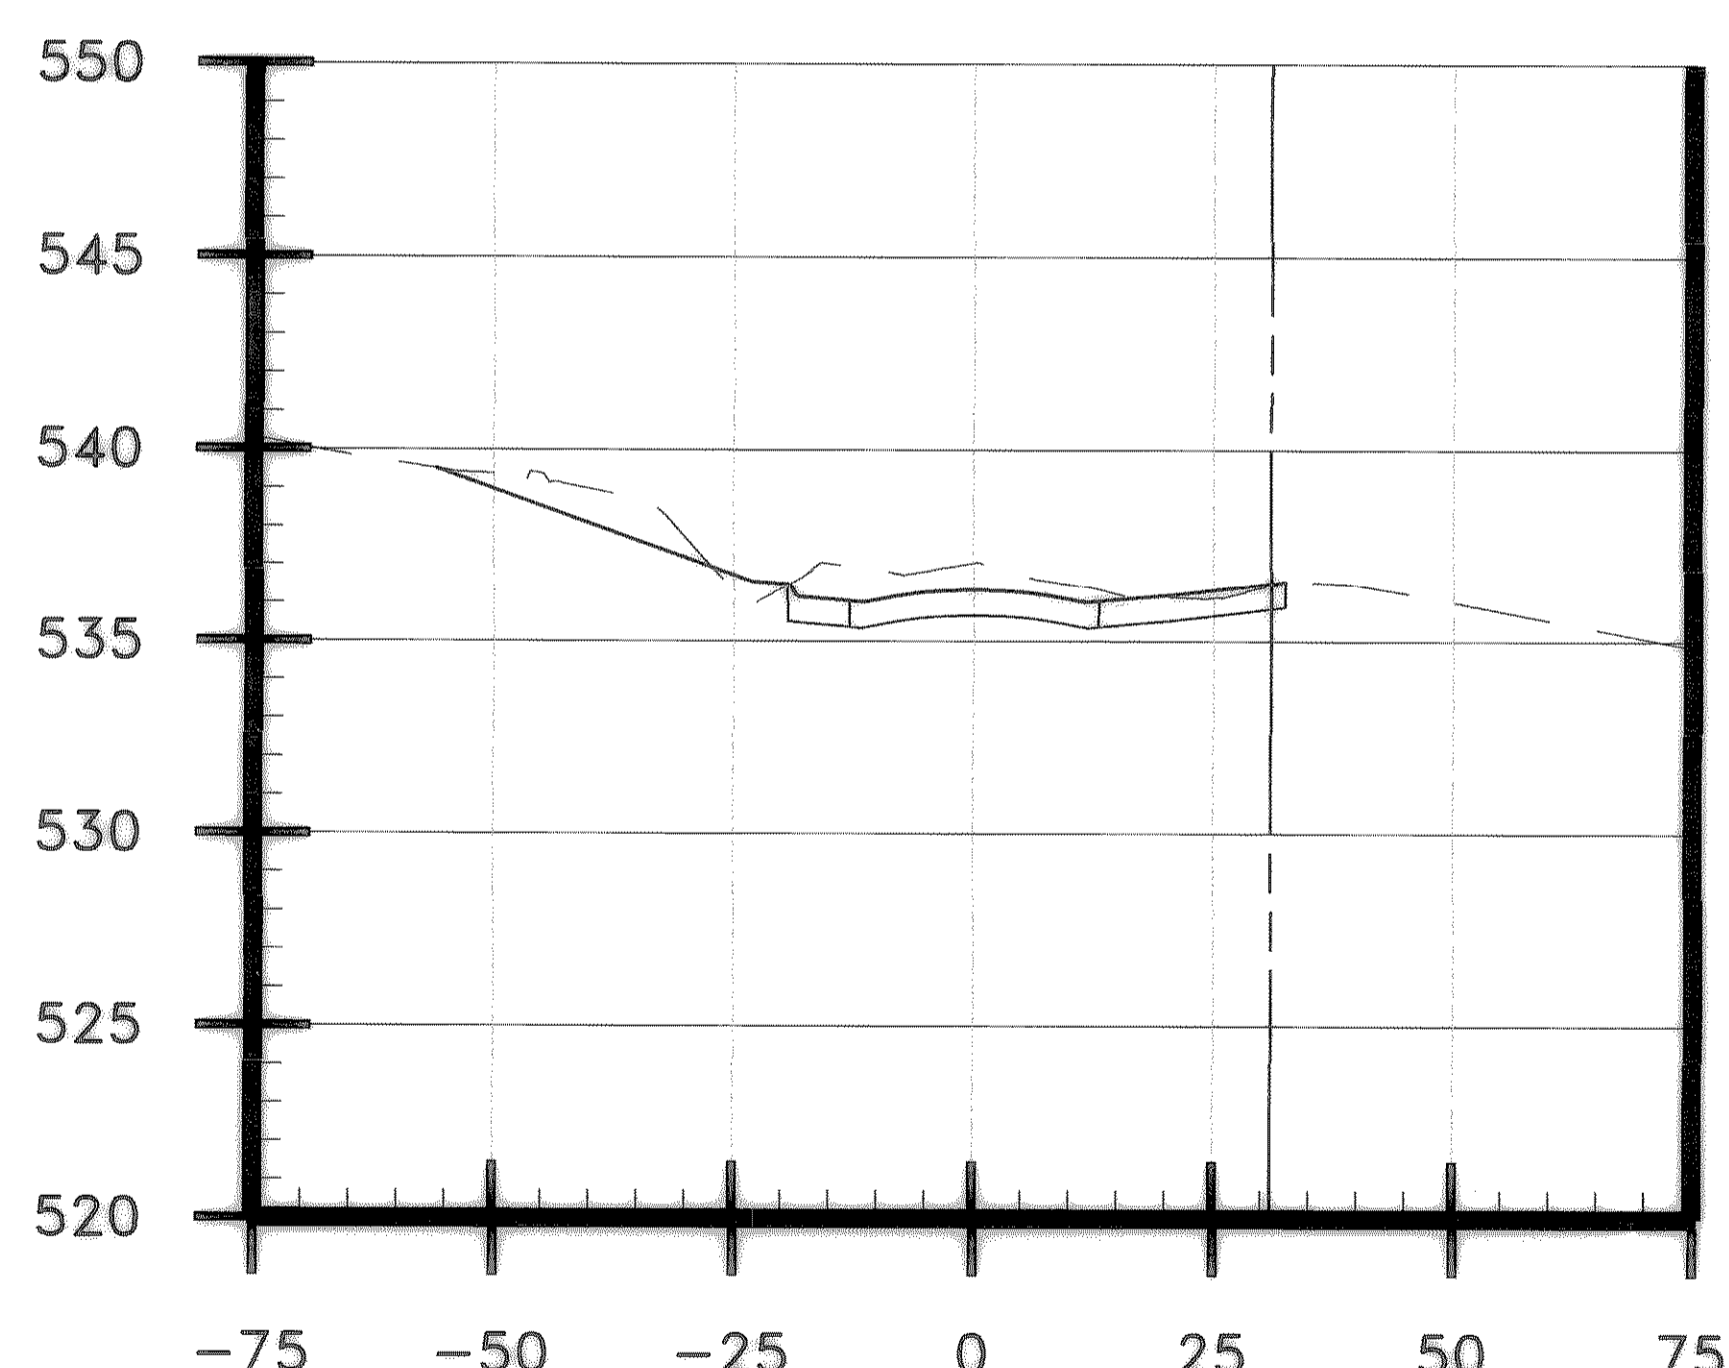

13+50

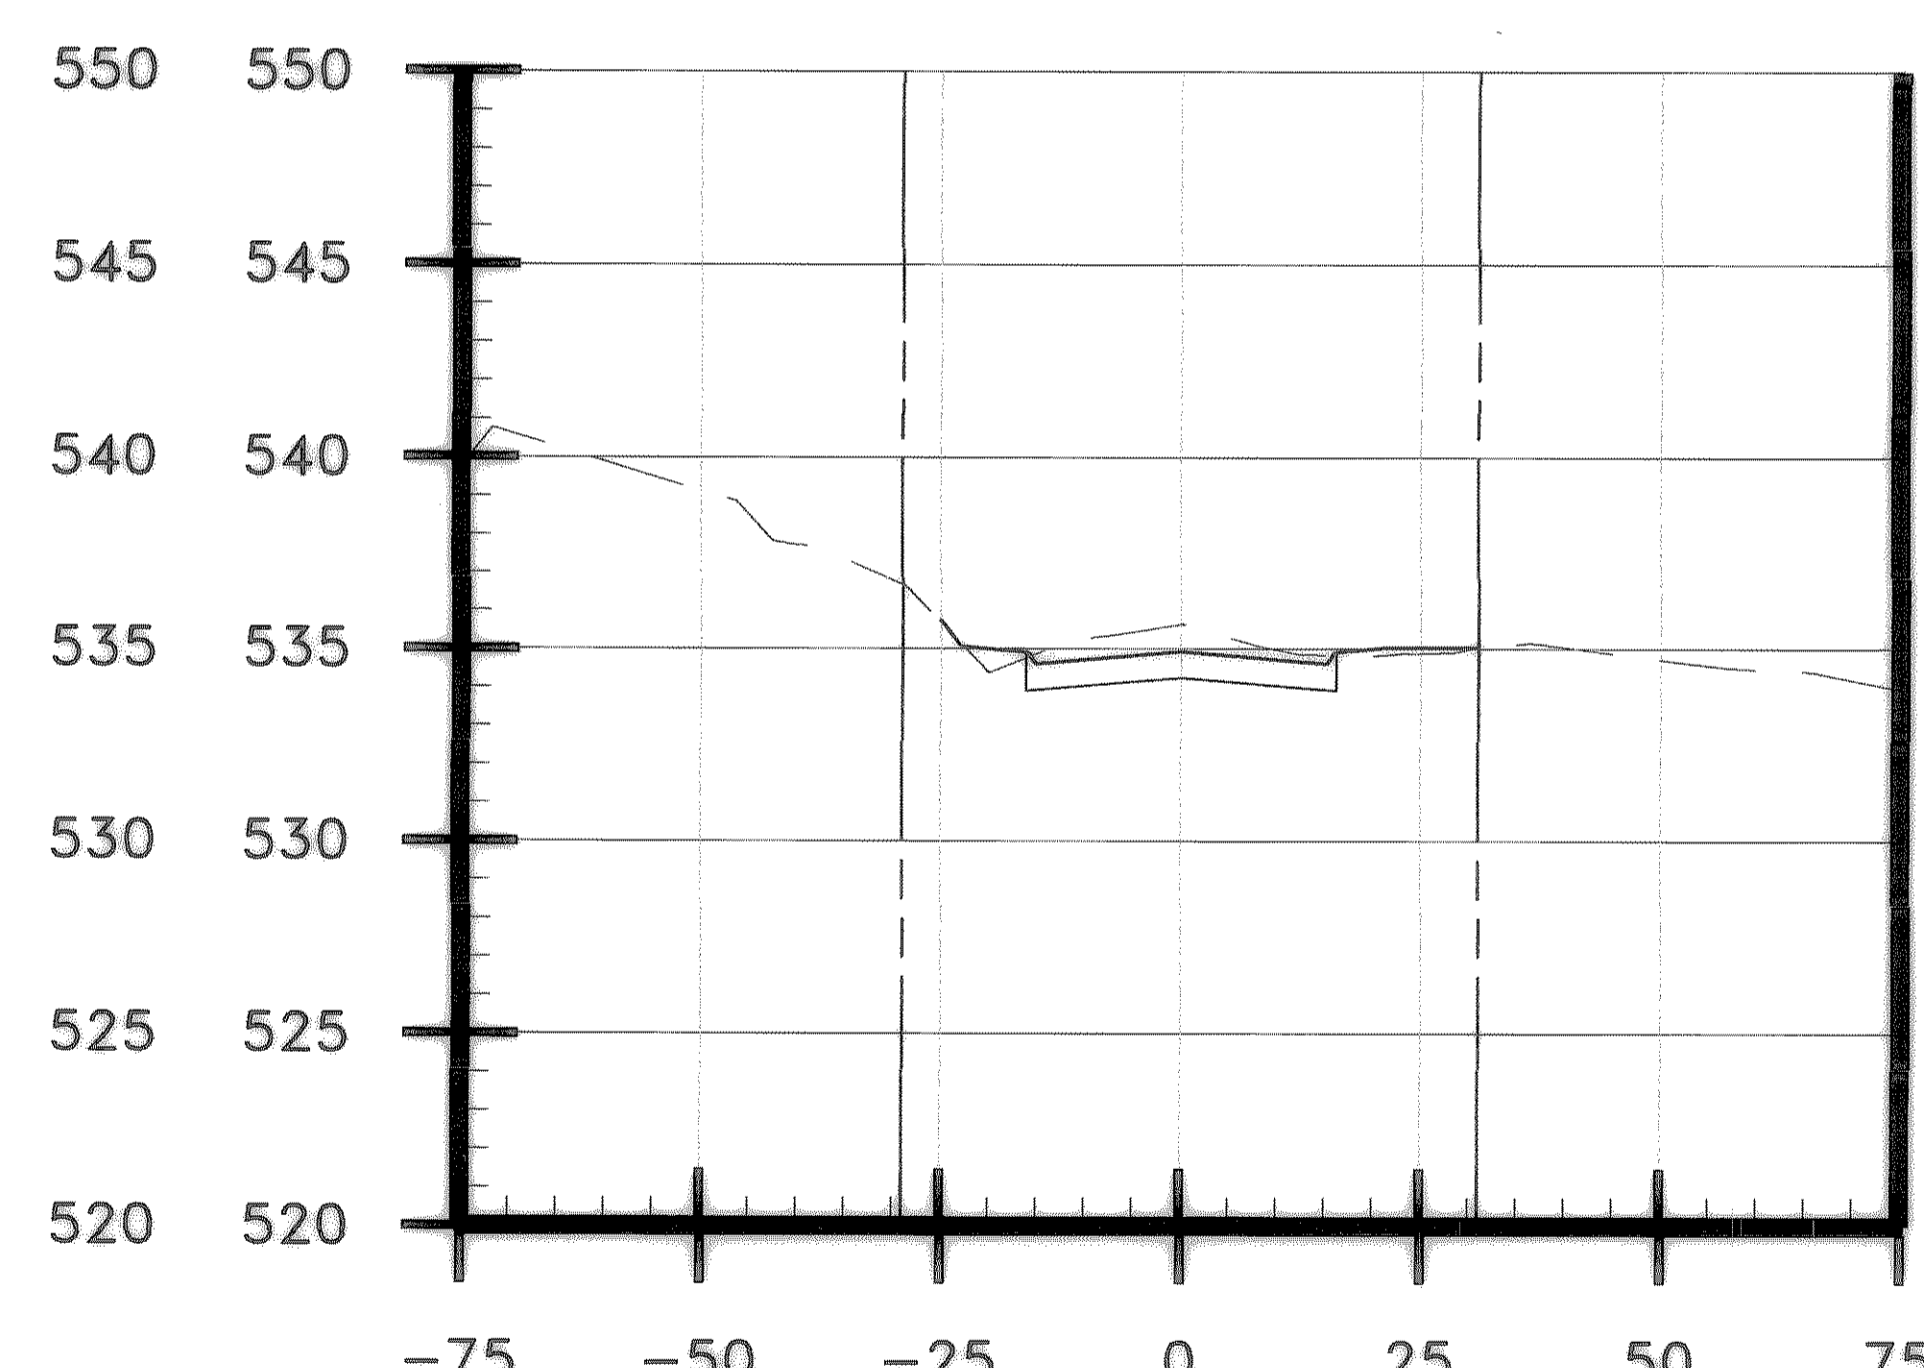

14+00

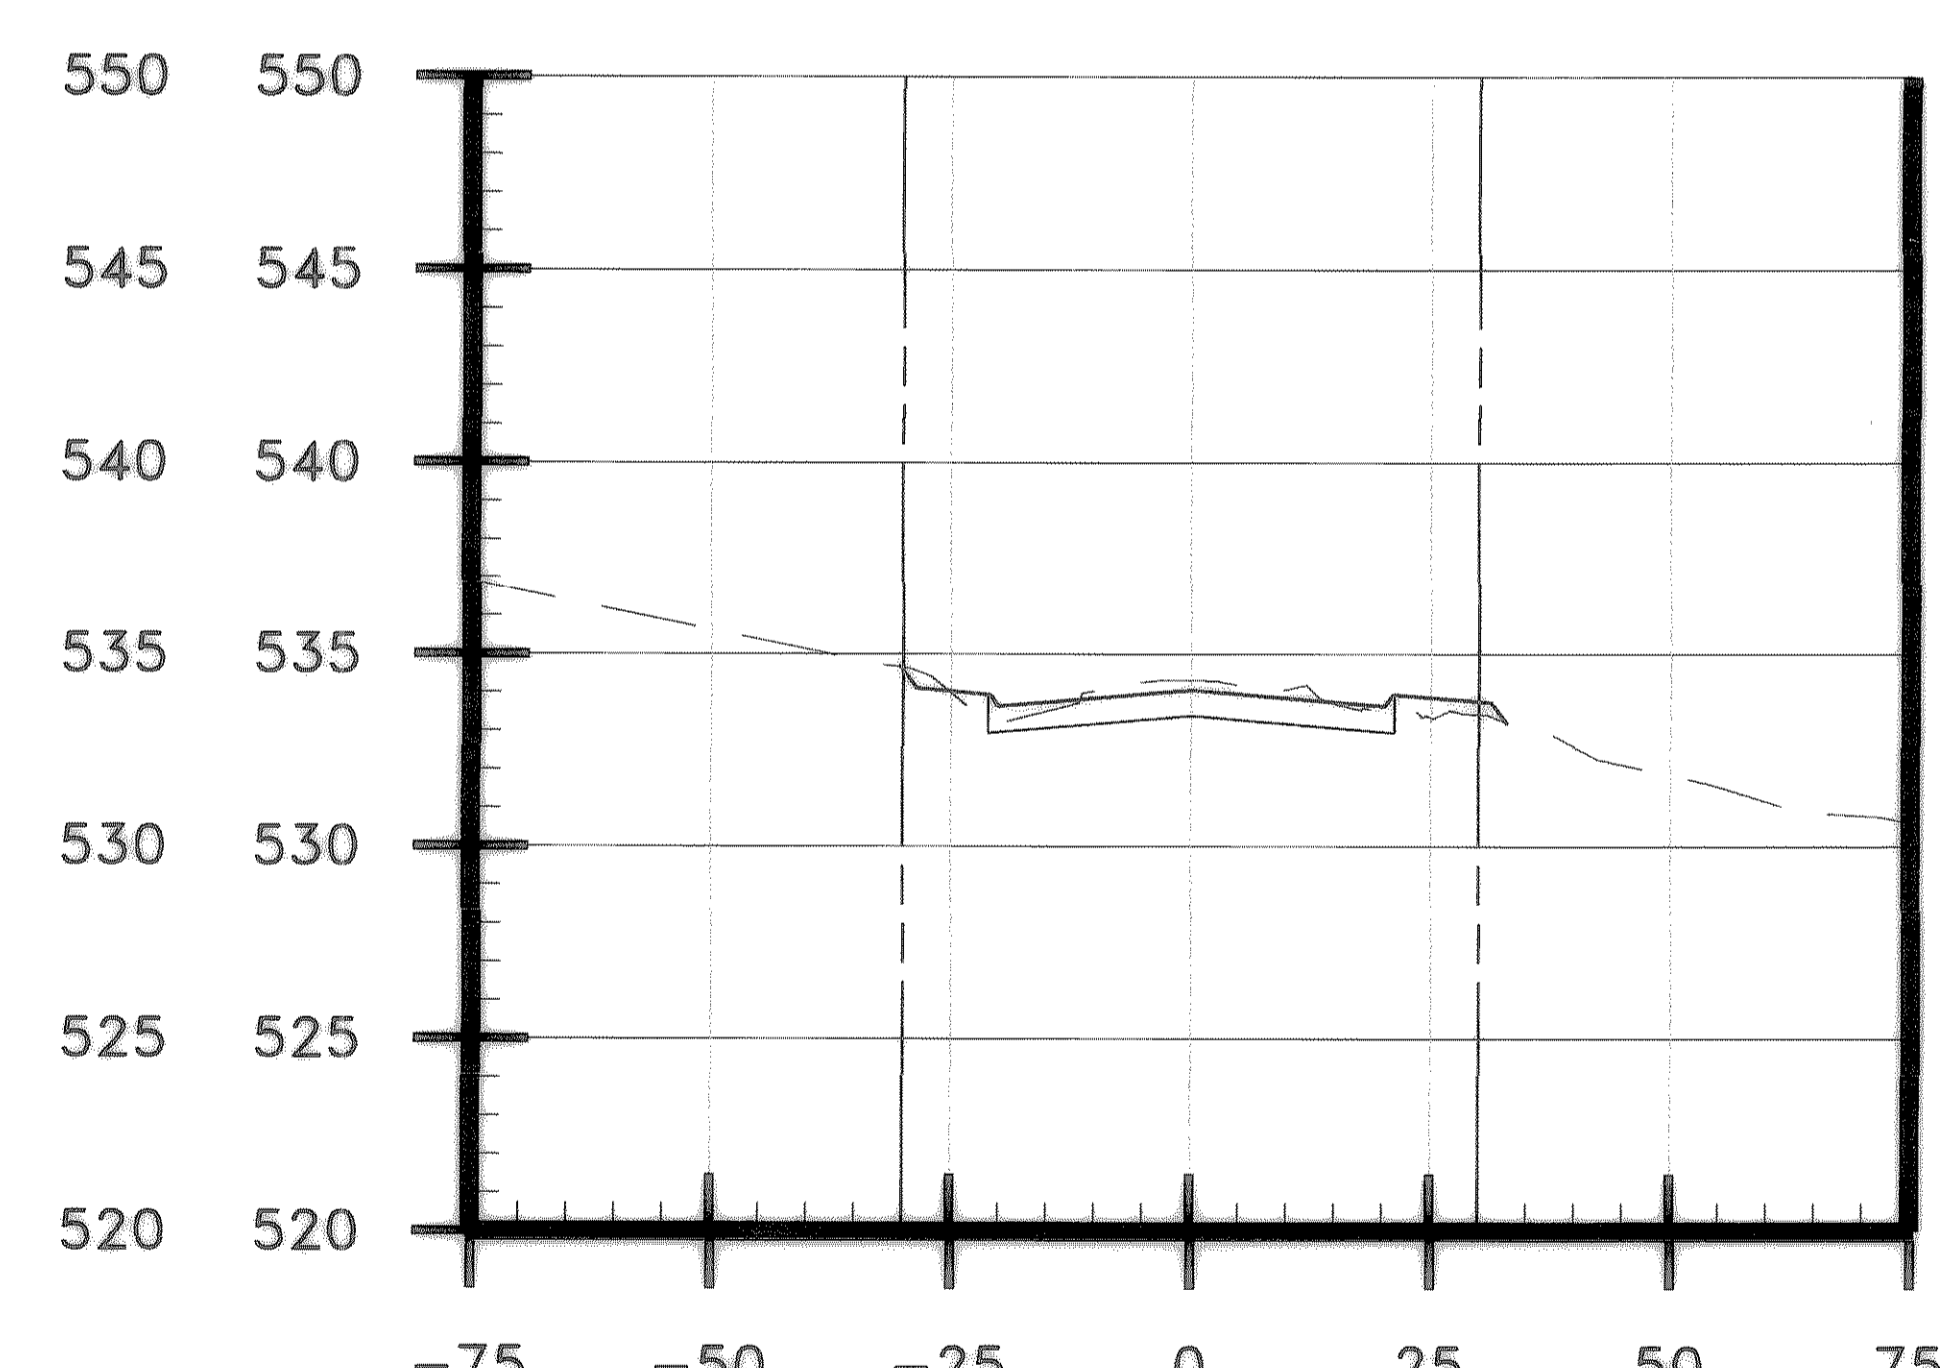

14+50

These plans and related specifications were prepared for construction of this specific project only. Reuse of these documents is not permitted without written authorization of Birkhoff, Hendricks & Conway, L.L.P.


CITY OF ROCKWALL, TEXAS

CLARK STREET CROSS SECTIONS

BIRKHOFF, HENDRICKS & CONWAY, L.L.P.
CONSULTING ENGINEERS
Dallas, Texas

REVISED TO CONFORM TO CONSTRUCTION RECORDS
BY M.H. DATE 12/04/2006

THESE DOCUMENTS ARE FOR BIDDING, CONSTRUCTION, AND PERMIT PURPOSES.
DATE: 8/1/04

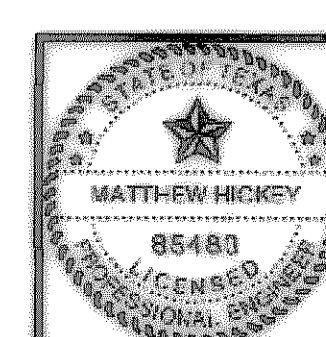

DESIGNED BY: M.H.	PROJECT: 2003-120	SHEET NO. 125
DRAWN BY: B.H.C.	DATE: AUGUST, 2004	OF SHEETS