




06/22/04 CAG H:\ROCKWALL\2003120\INFRASTRUCTURE\GROSS-SECTION\CLARK-XSECTION\DWG SCALE: 1=20 XREF: ROCKWALL\2003120\BASE\PROP-BASE

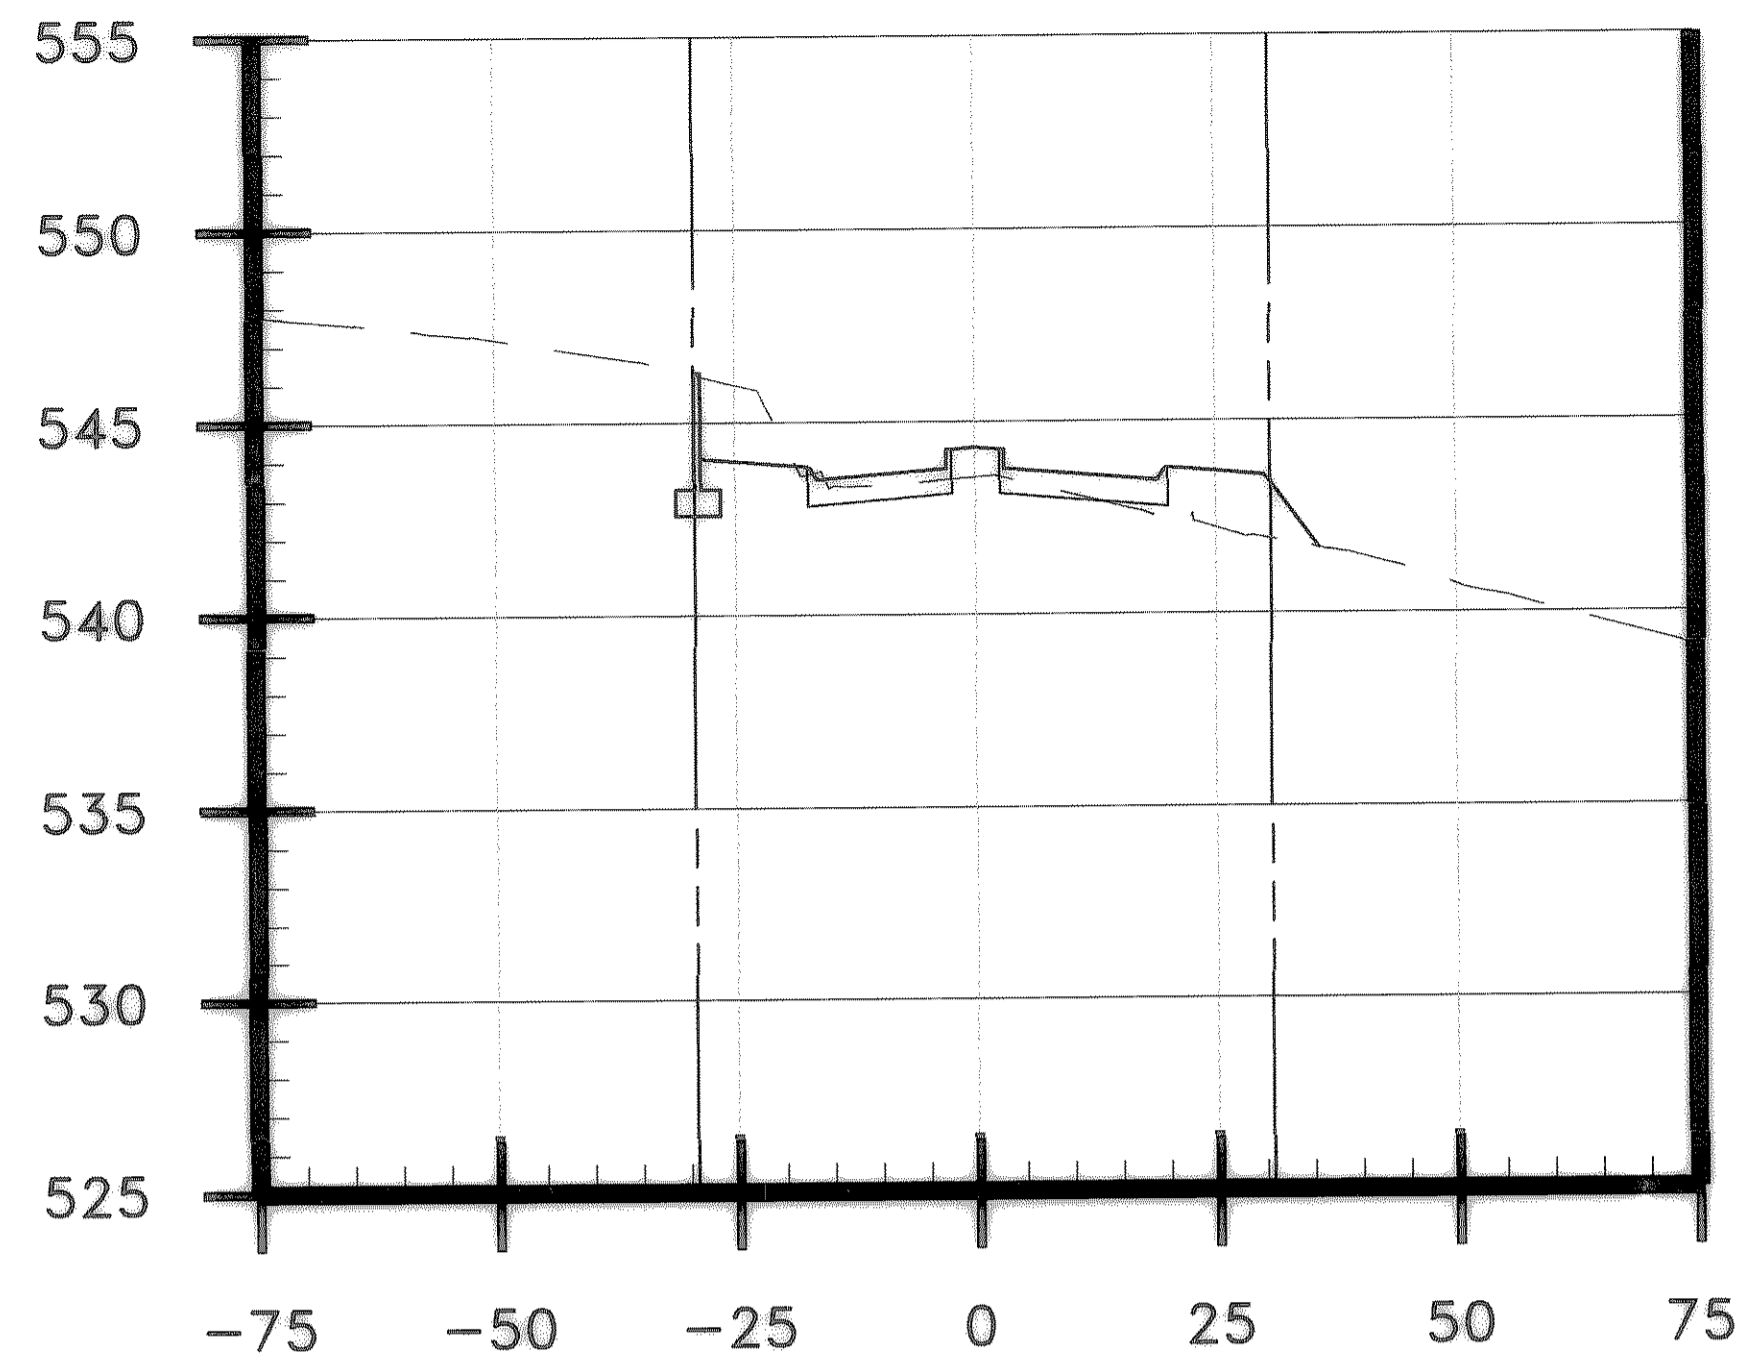


21+25

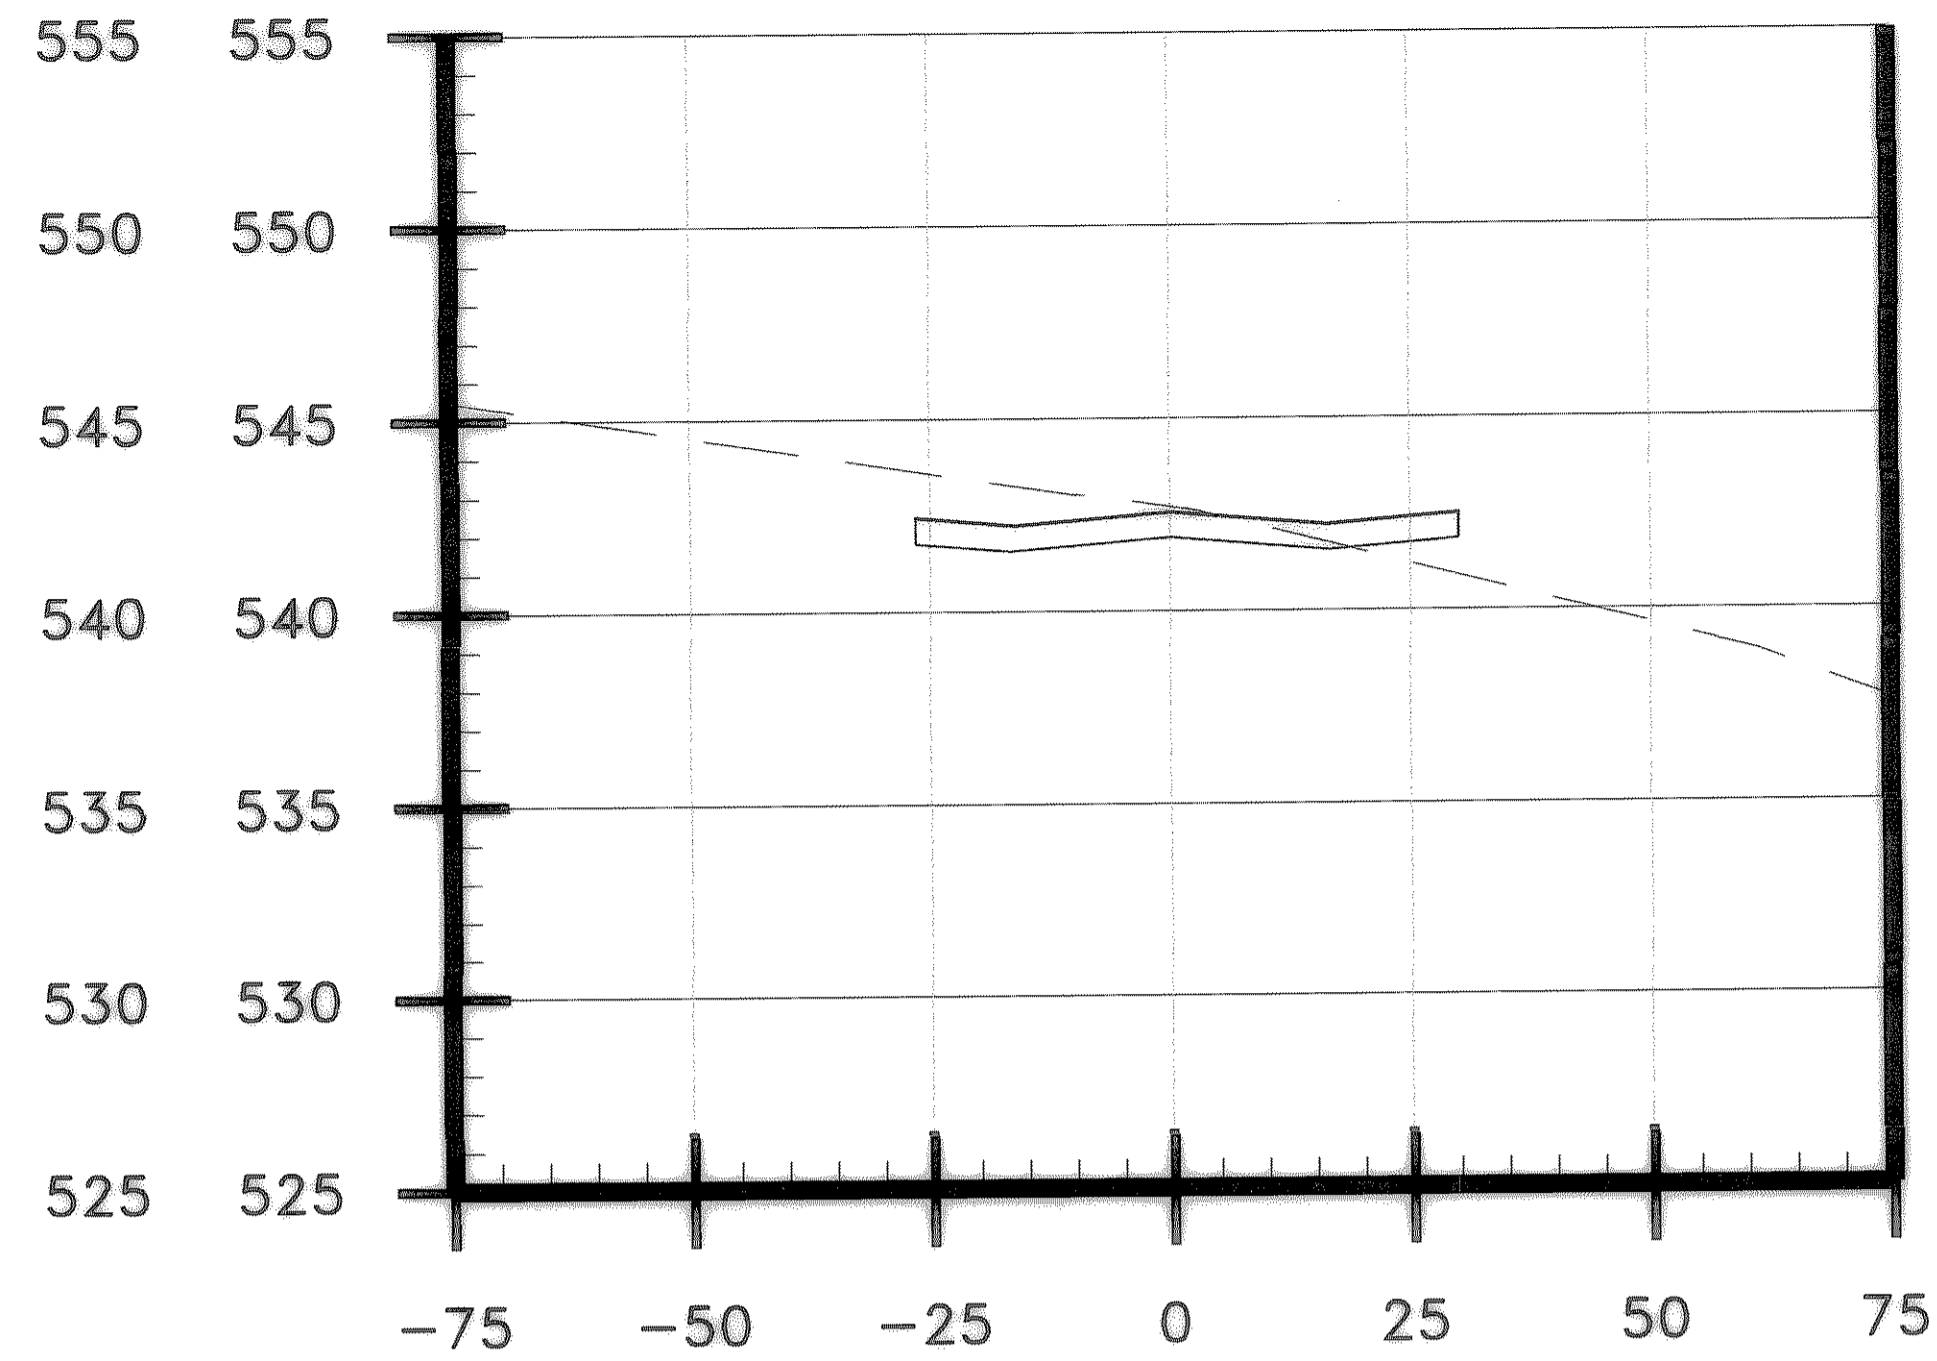


21+75

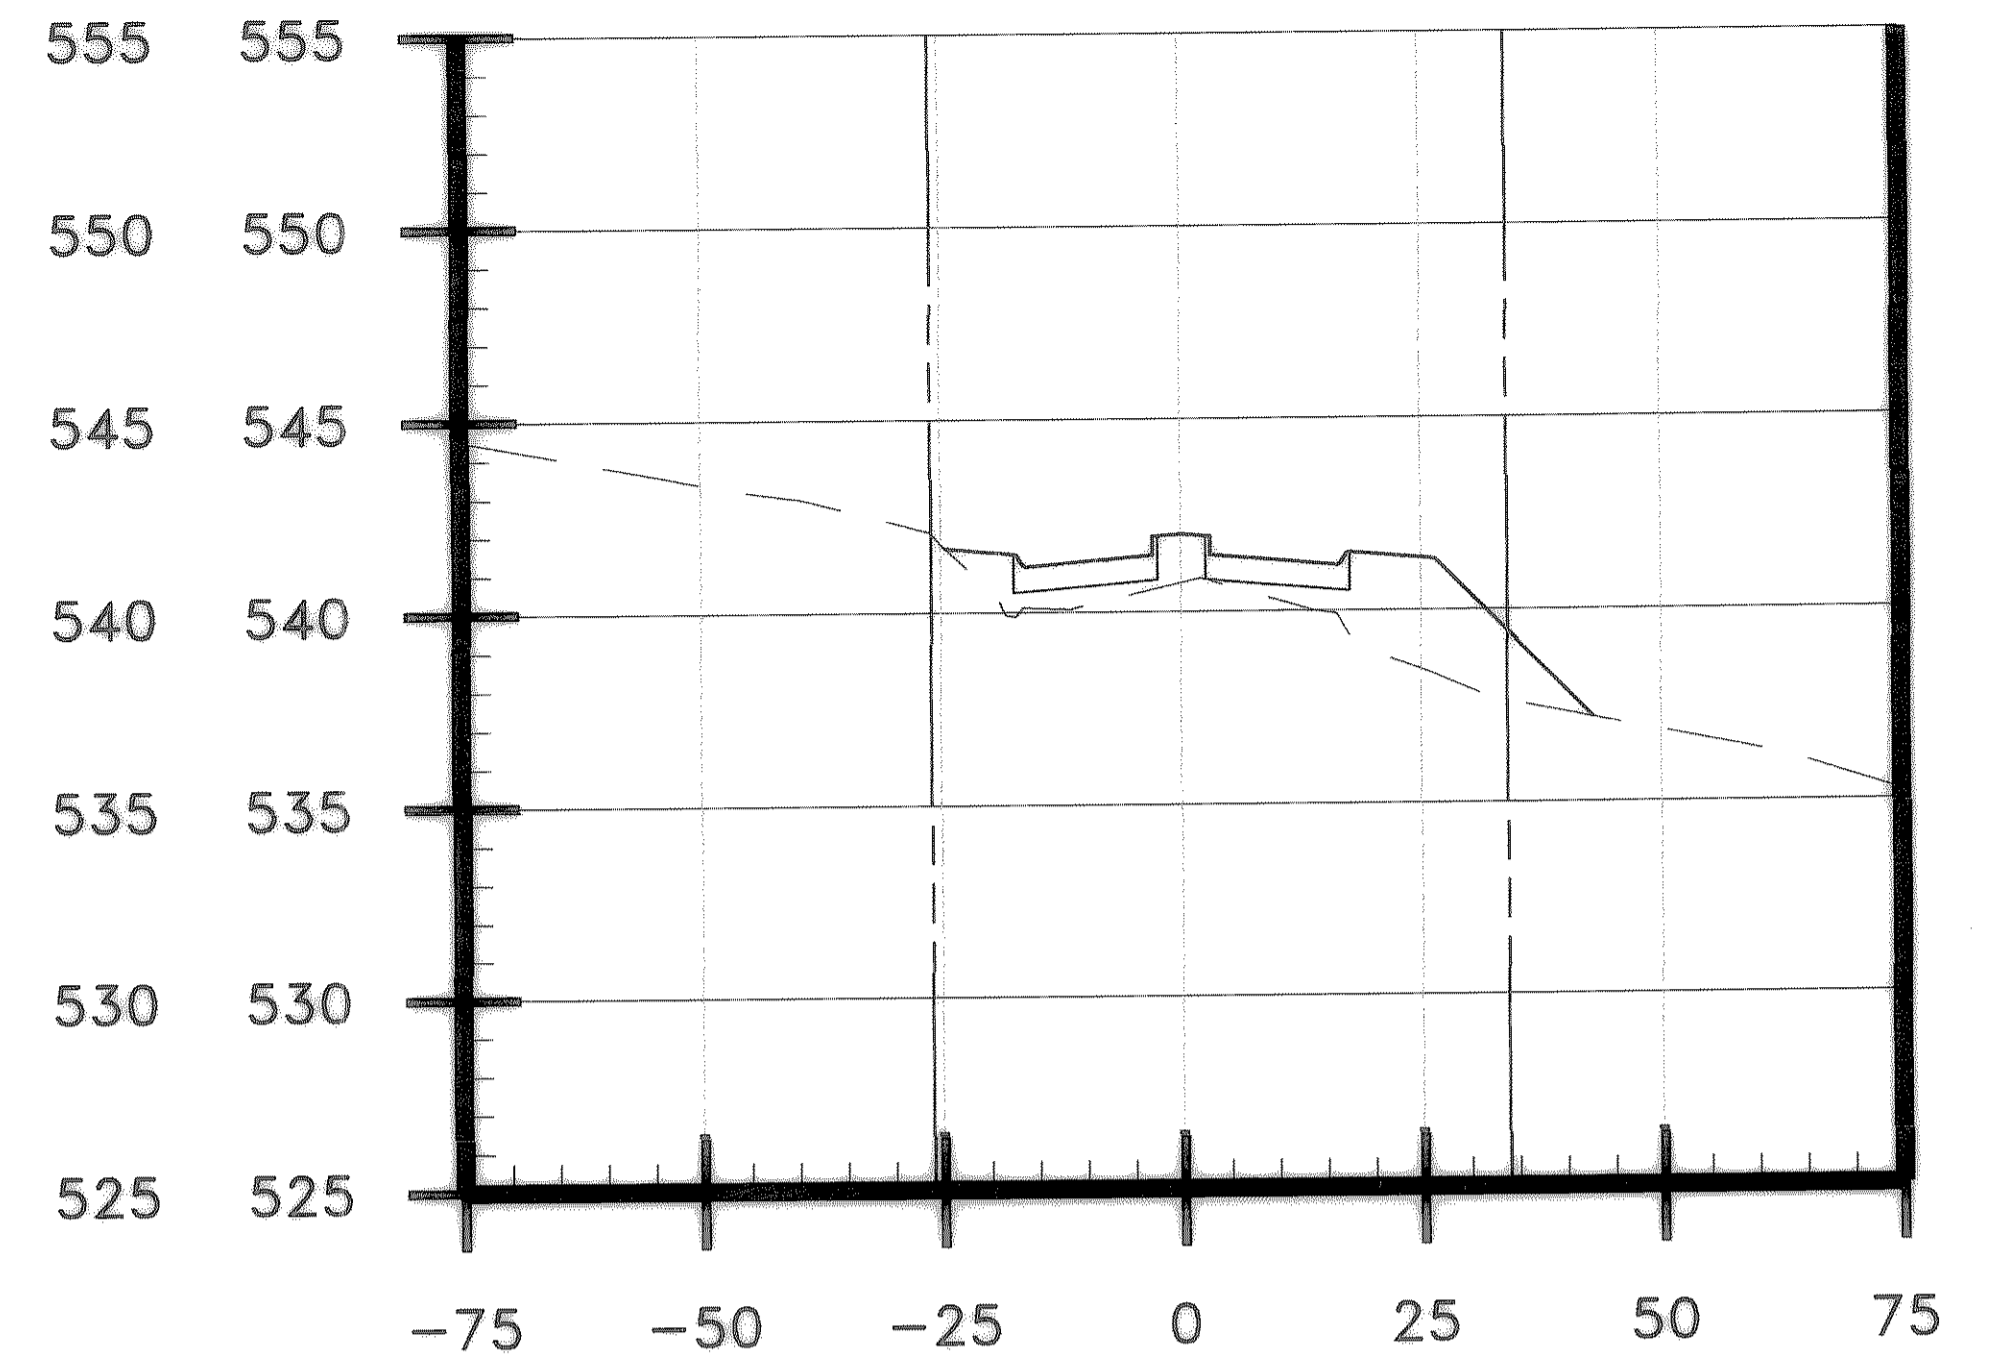


22+25

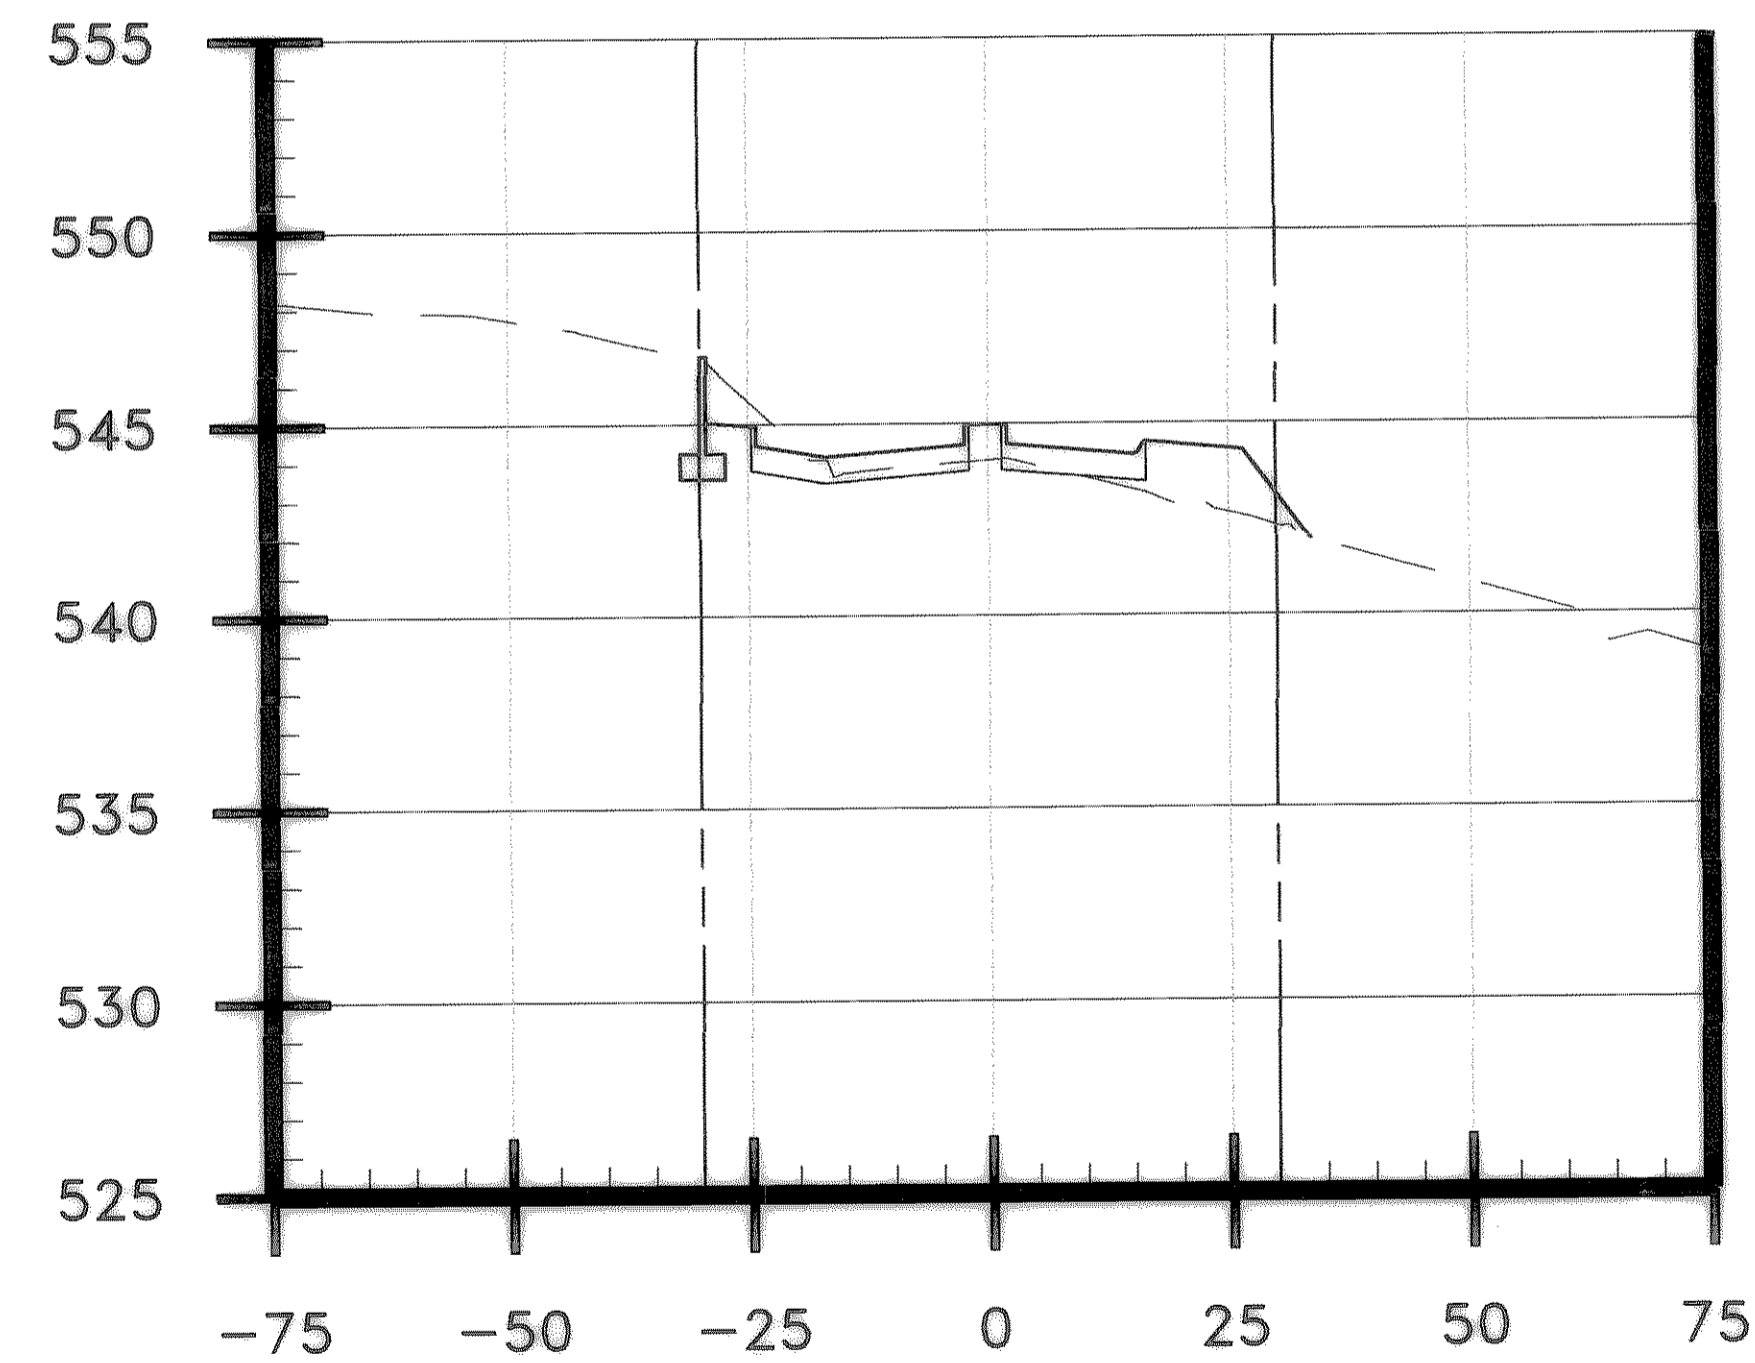

21+00

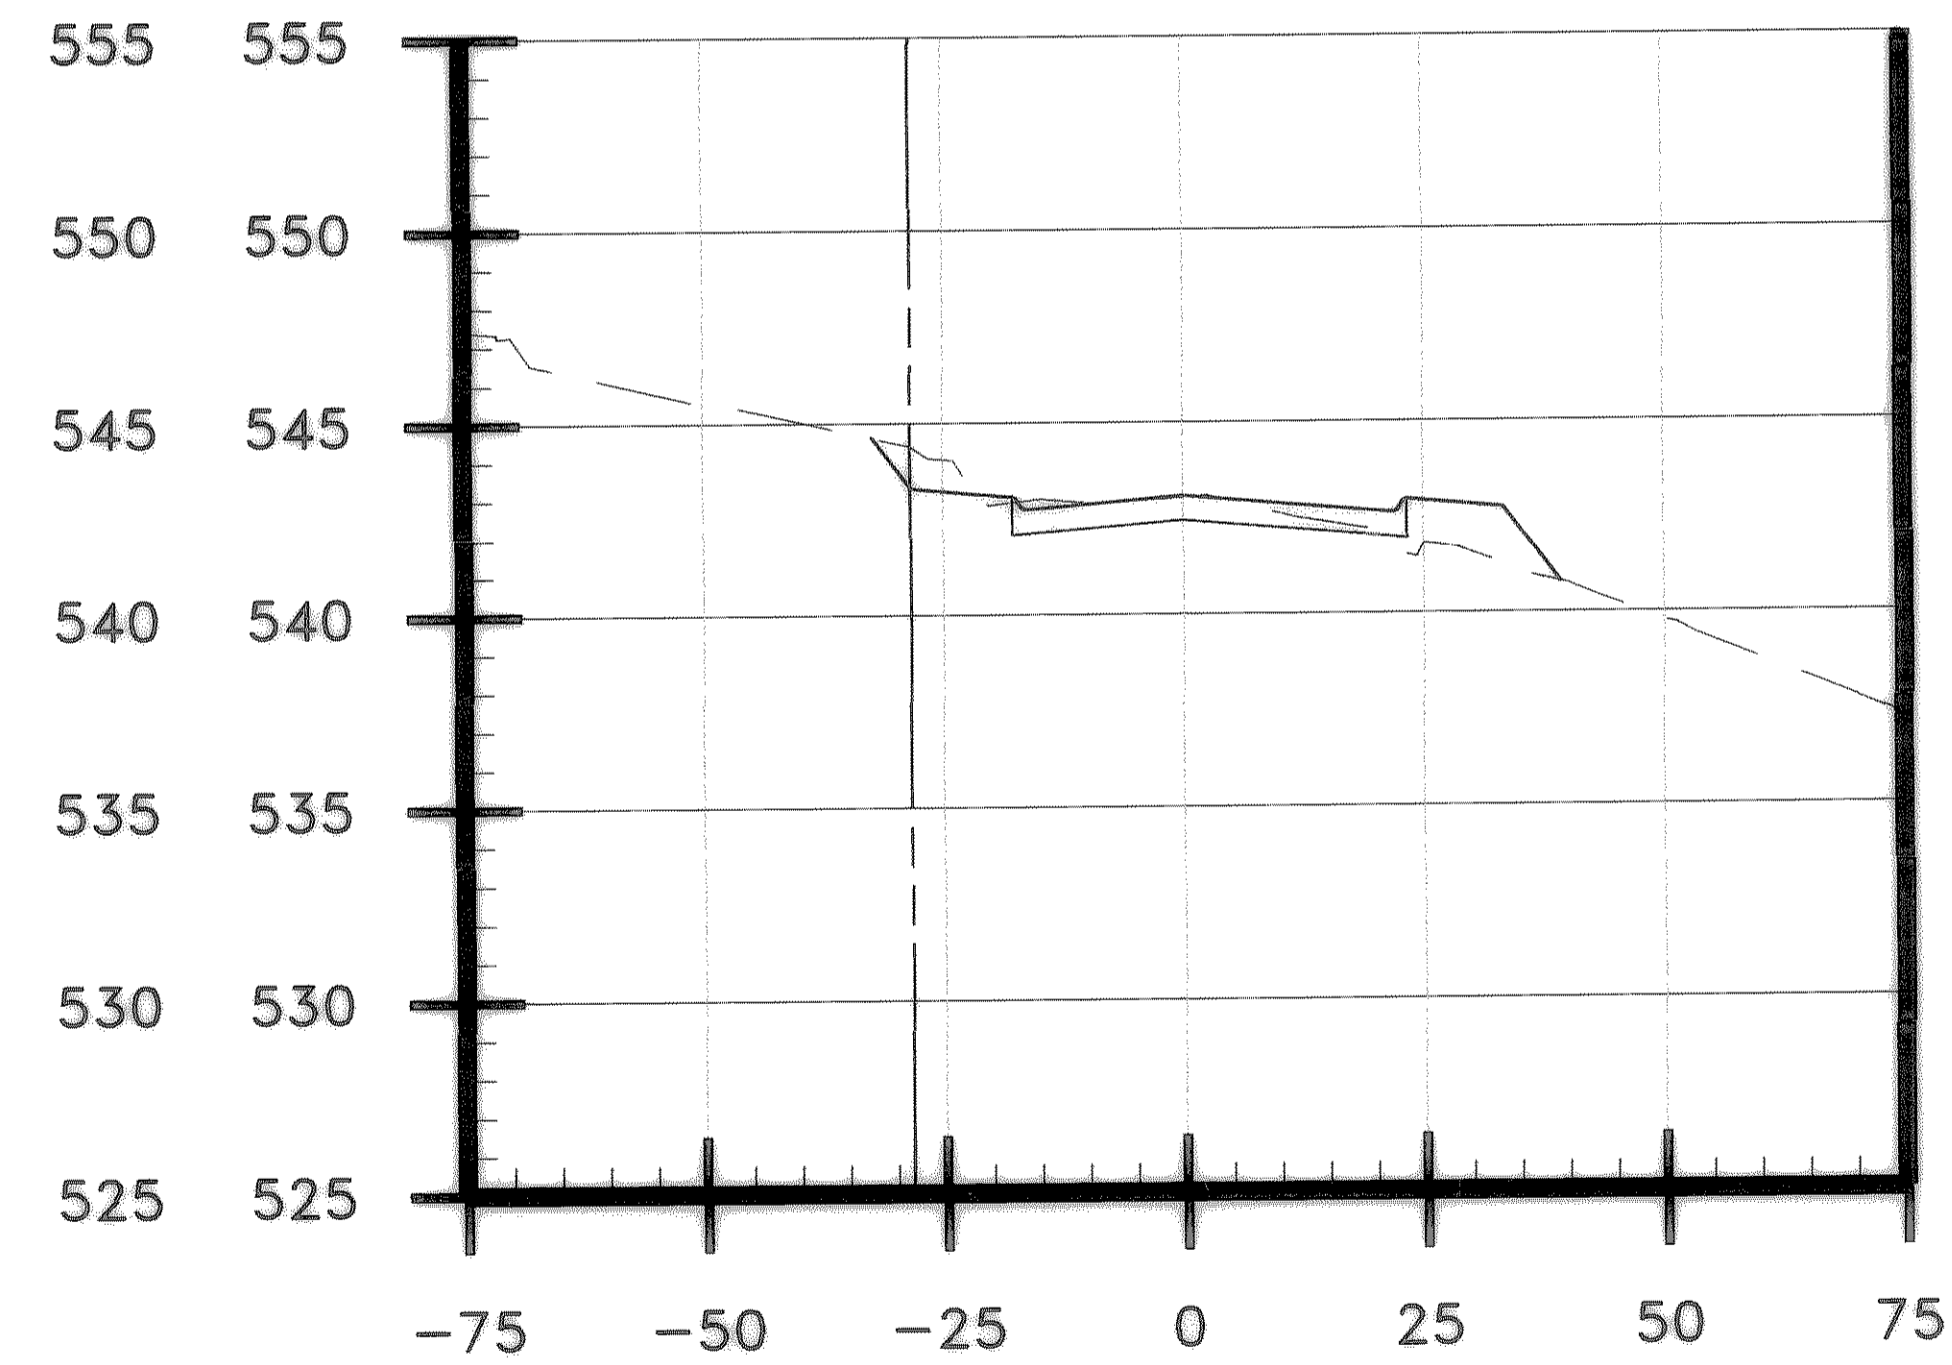

21+50

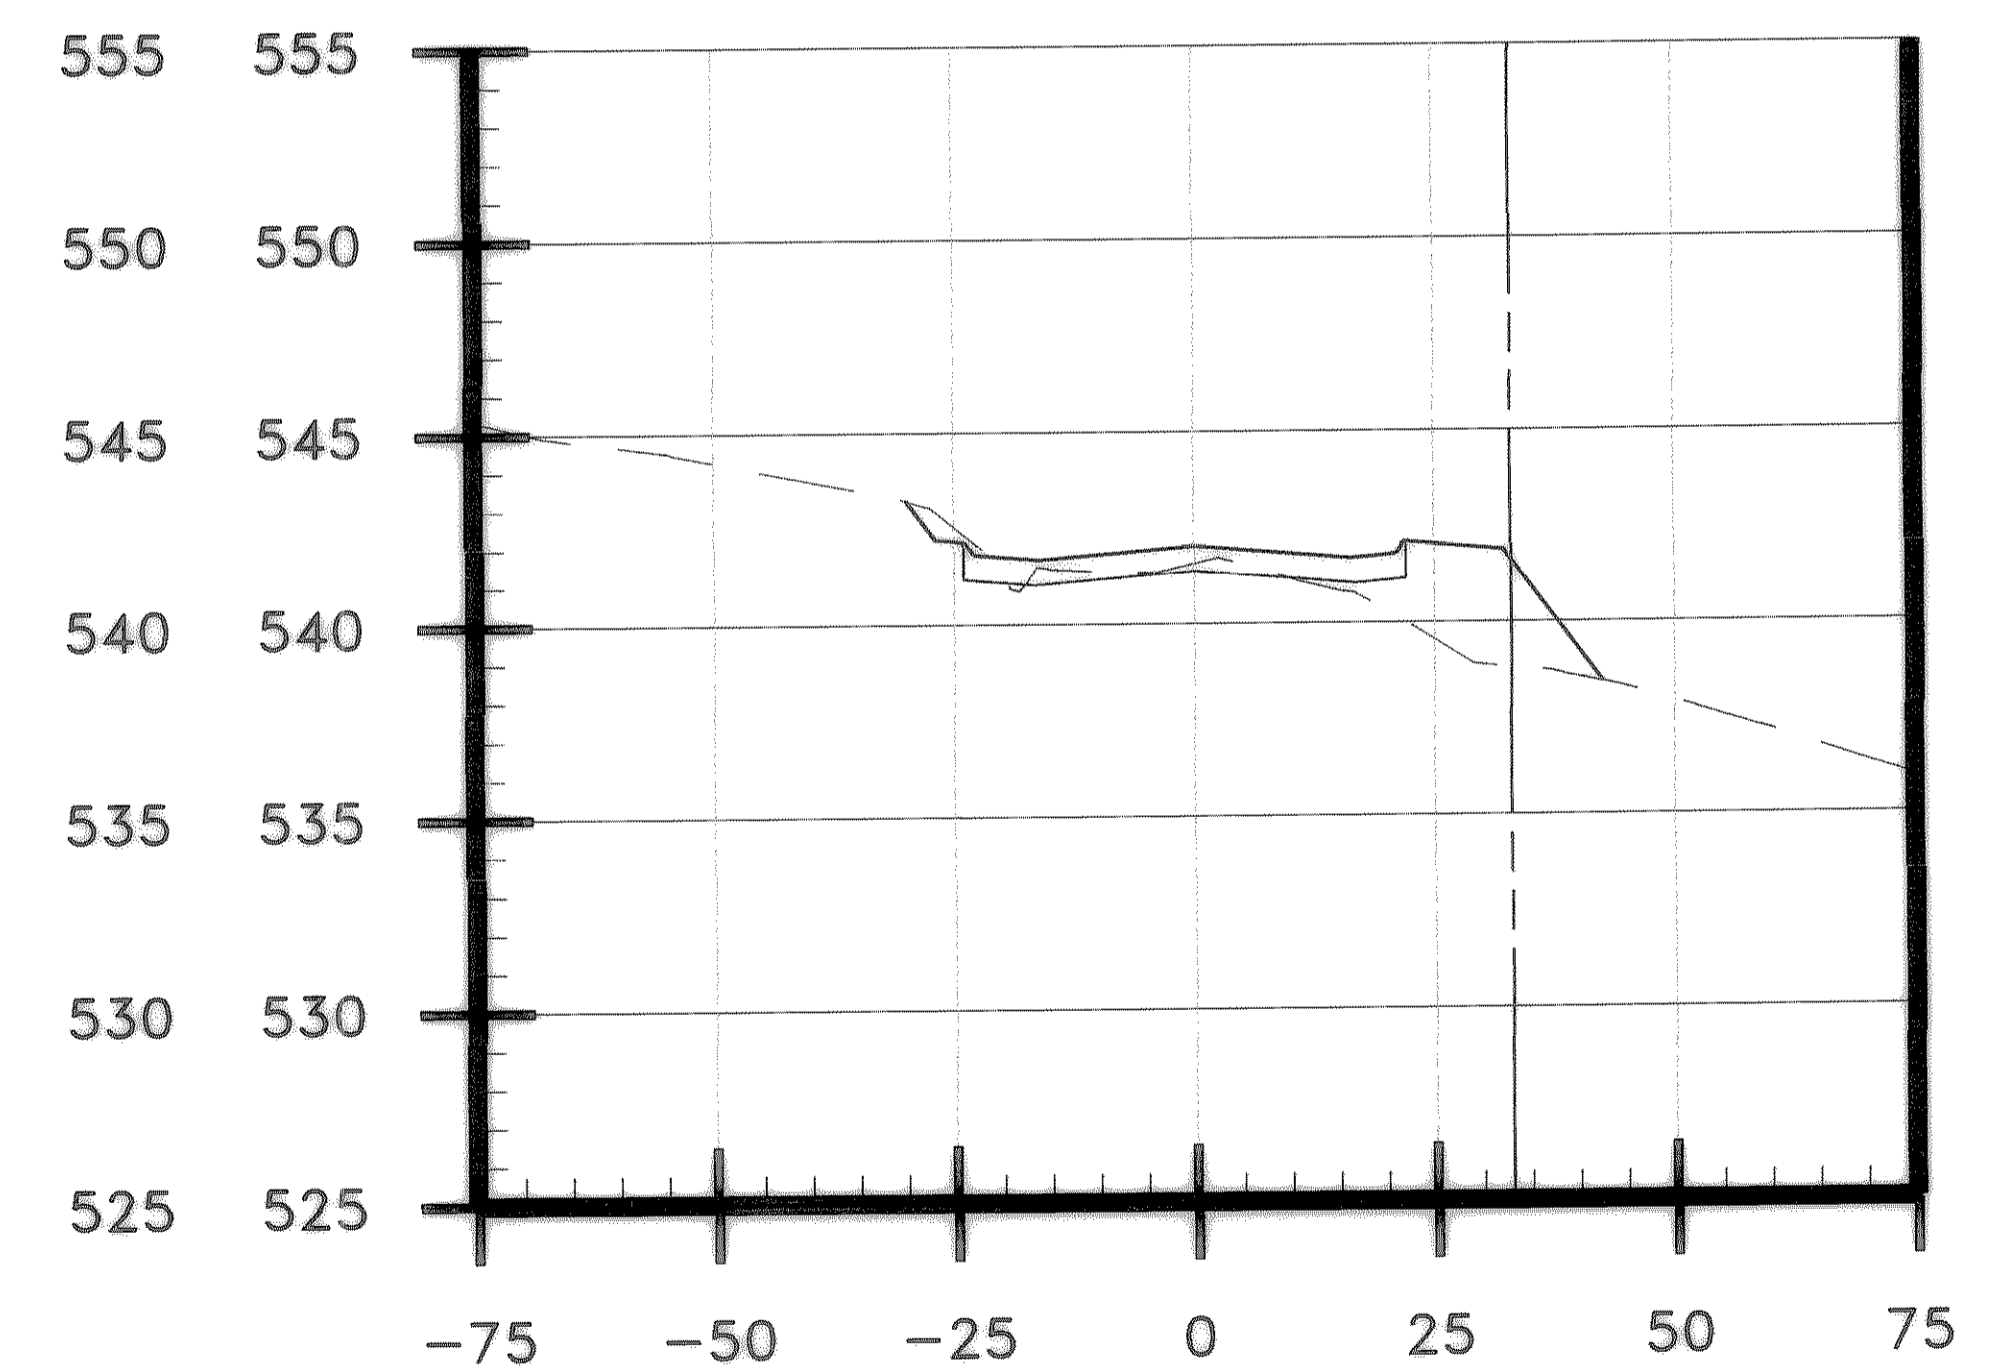

22+00

These plans and related specifications were prepared for construction of this specific project only. Reuse of these documents is not permitted without written authorization of Birkhoff, Hendricks & Conway, L.L.P.

REVISED TO CONFORM TO CONSTRUCTION RECORDS
BY M.H. DATE 12/04/2006

THESE DOCUMENTS ARE FOR BIDDING, CONSTRUCTION, AND PERMIT PURPOSES.
M.H.
DATE: 8/2/04



CITY OF ROCKWALL, TEXAS

CLARK STREET
CROSS SECTIONS

BIRKHOFF, HENDRICKS & CONWAY, L.L.P.
CONSULTING ENGINEERS
Dallas, Texas

DESIGNED BY: M.H. PROJECT: 2003-120
DRAWN BY: B.H.C. DATE: AUGUST, 2004

SHEET NO. 130
OF SHEETS