




H:\ROCKWALL\2003\120\INROADS\CROSS-SECTION\CLARK-Y\SECT.DWG SCALE: 1=20 XREF: ROCKWALL_2003\120\BASE\PROP-BASE 06/22/04 CAG

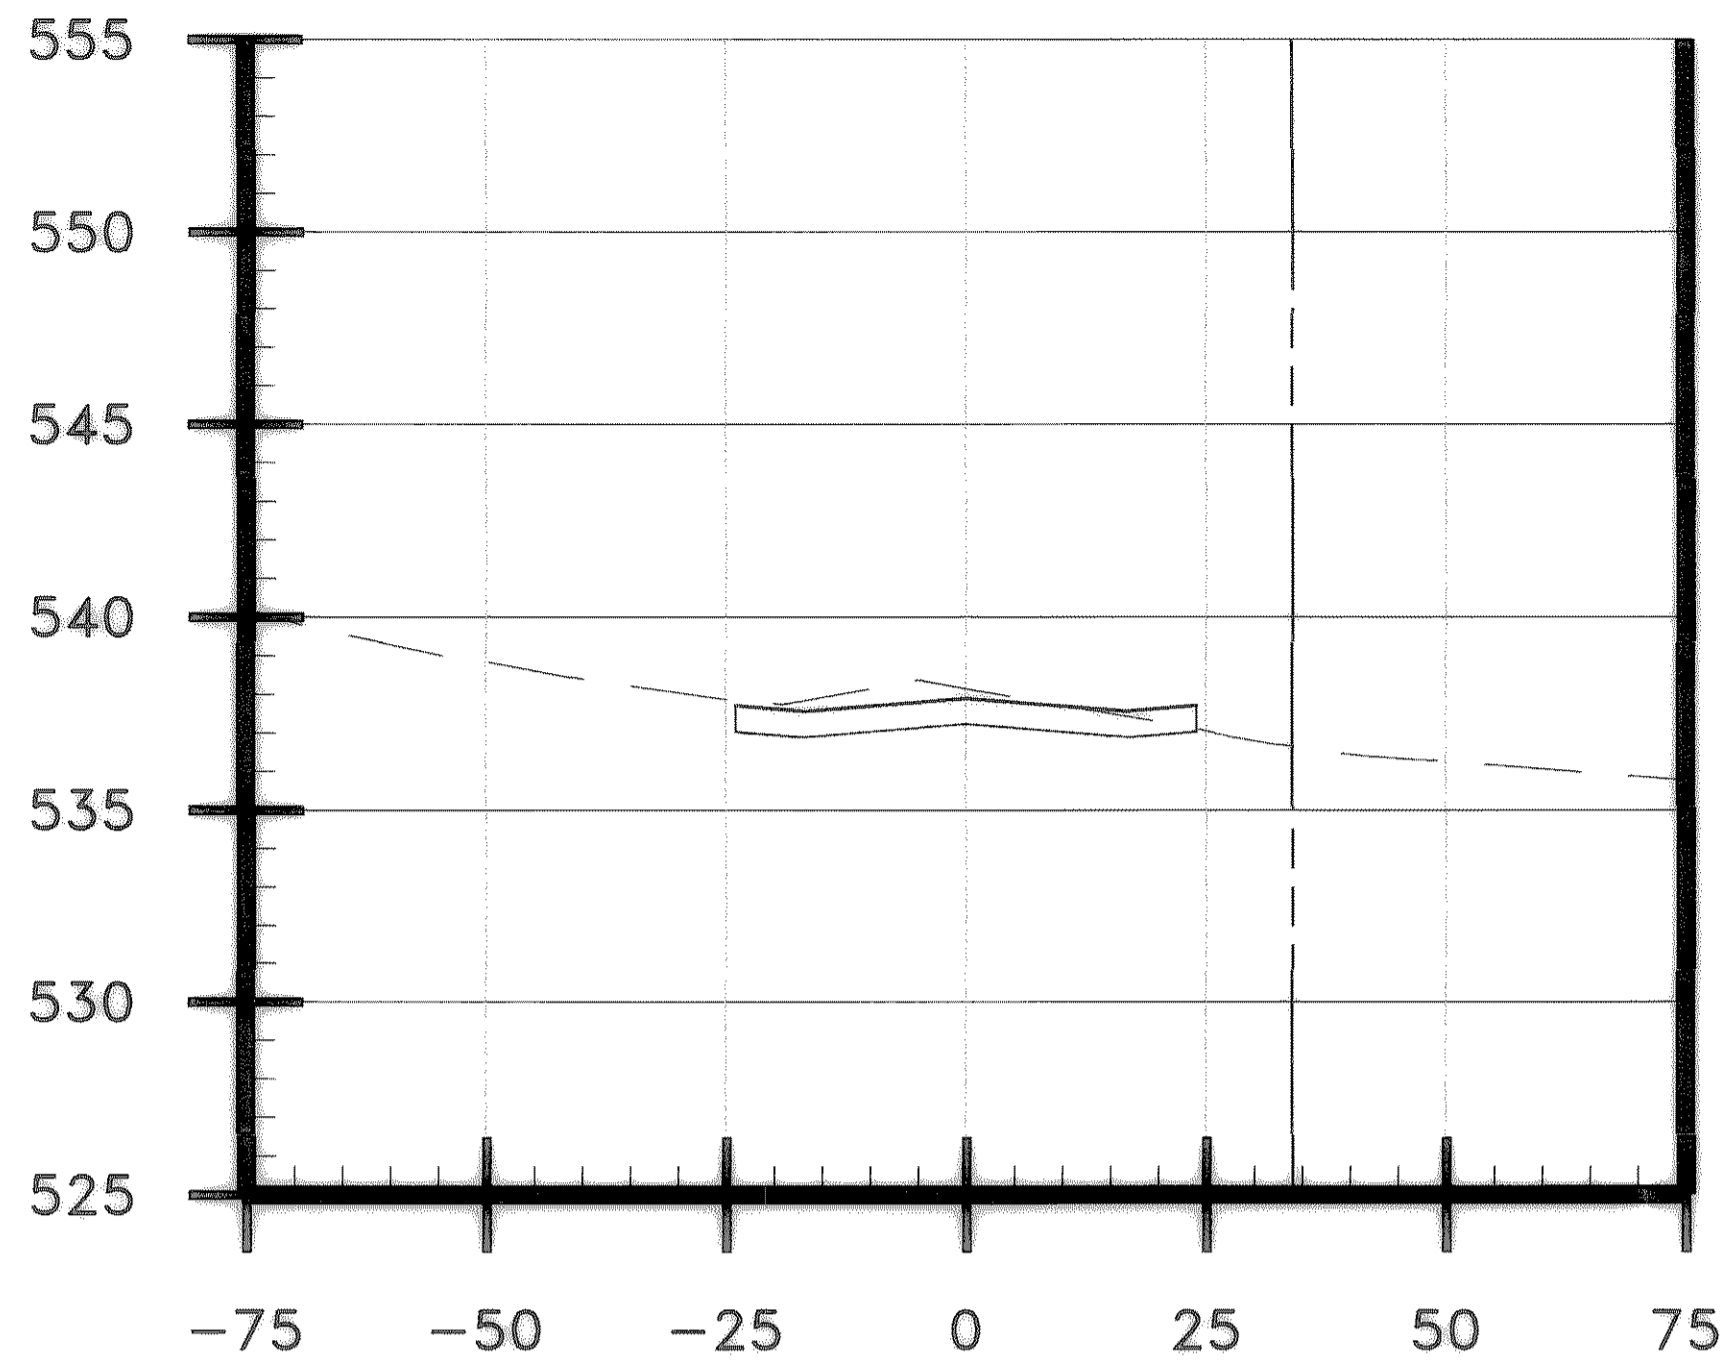


24+25

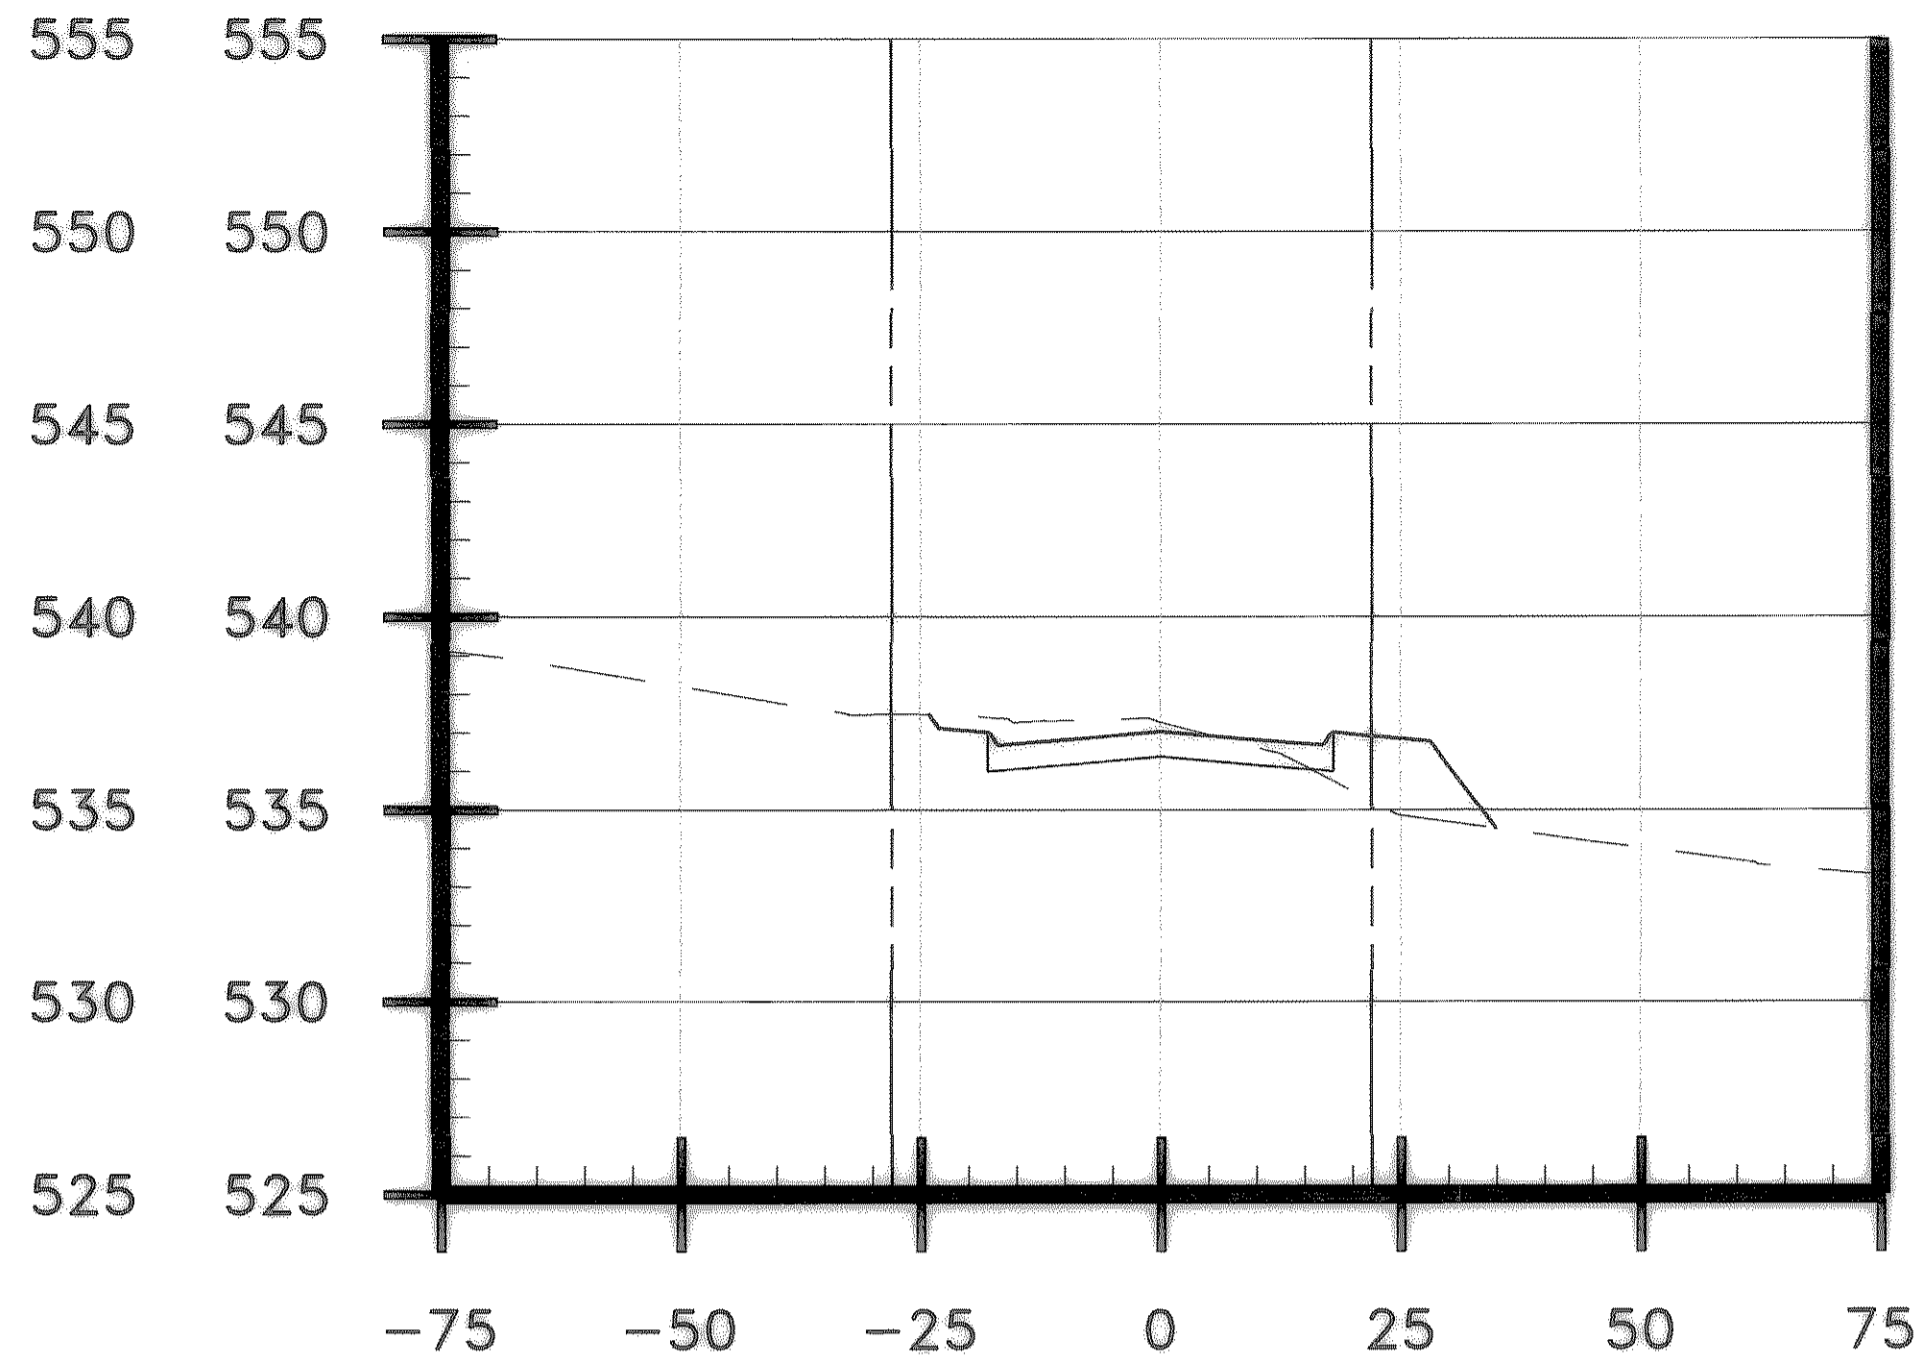


24+75

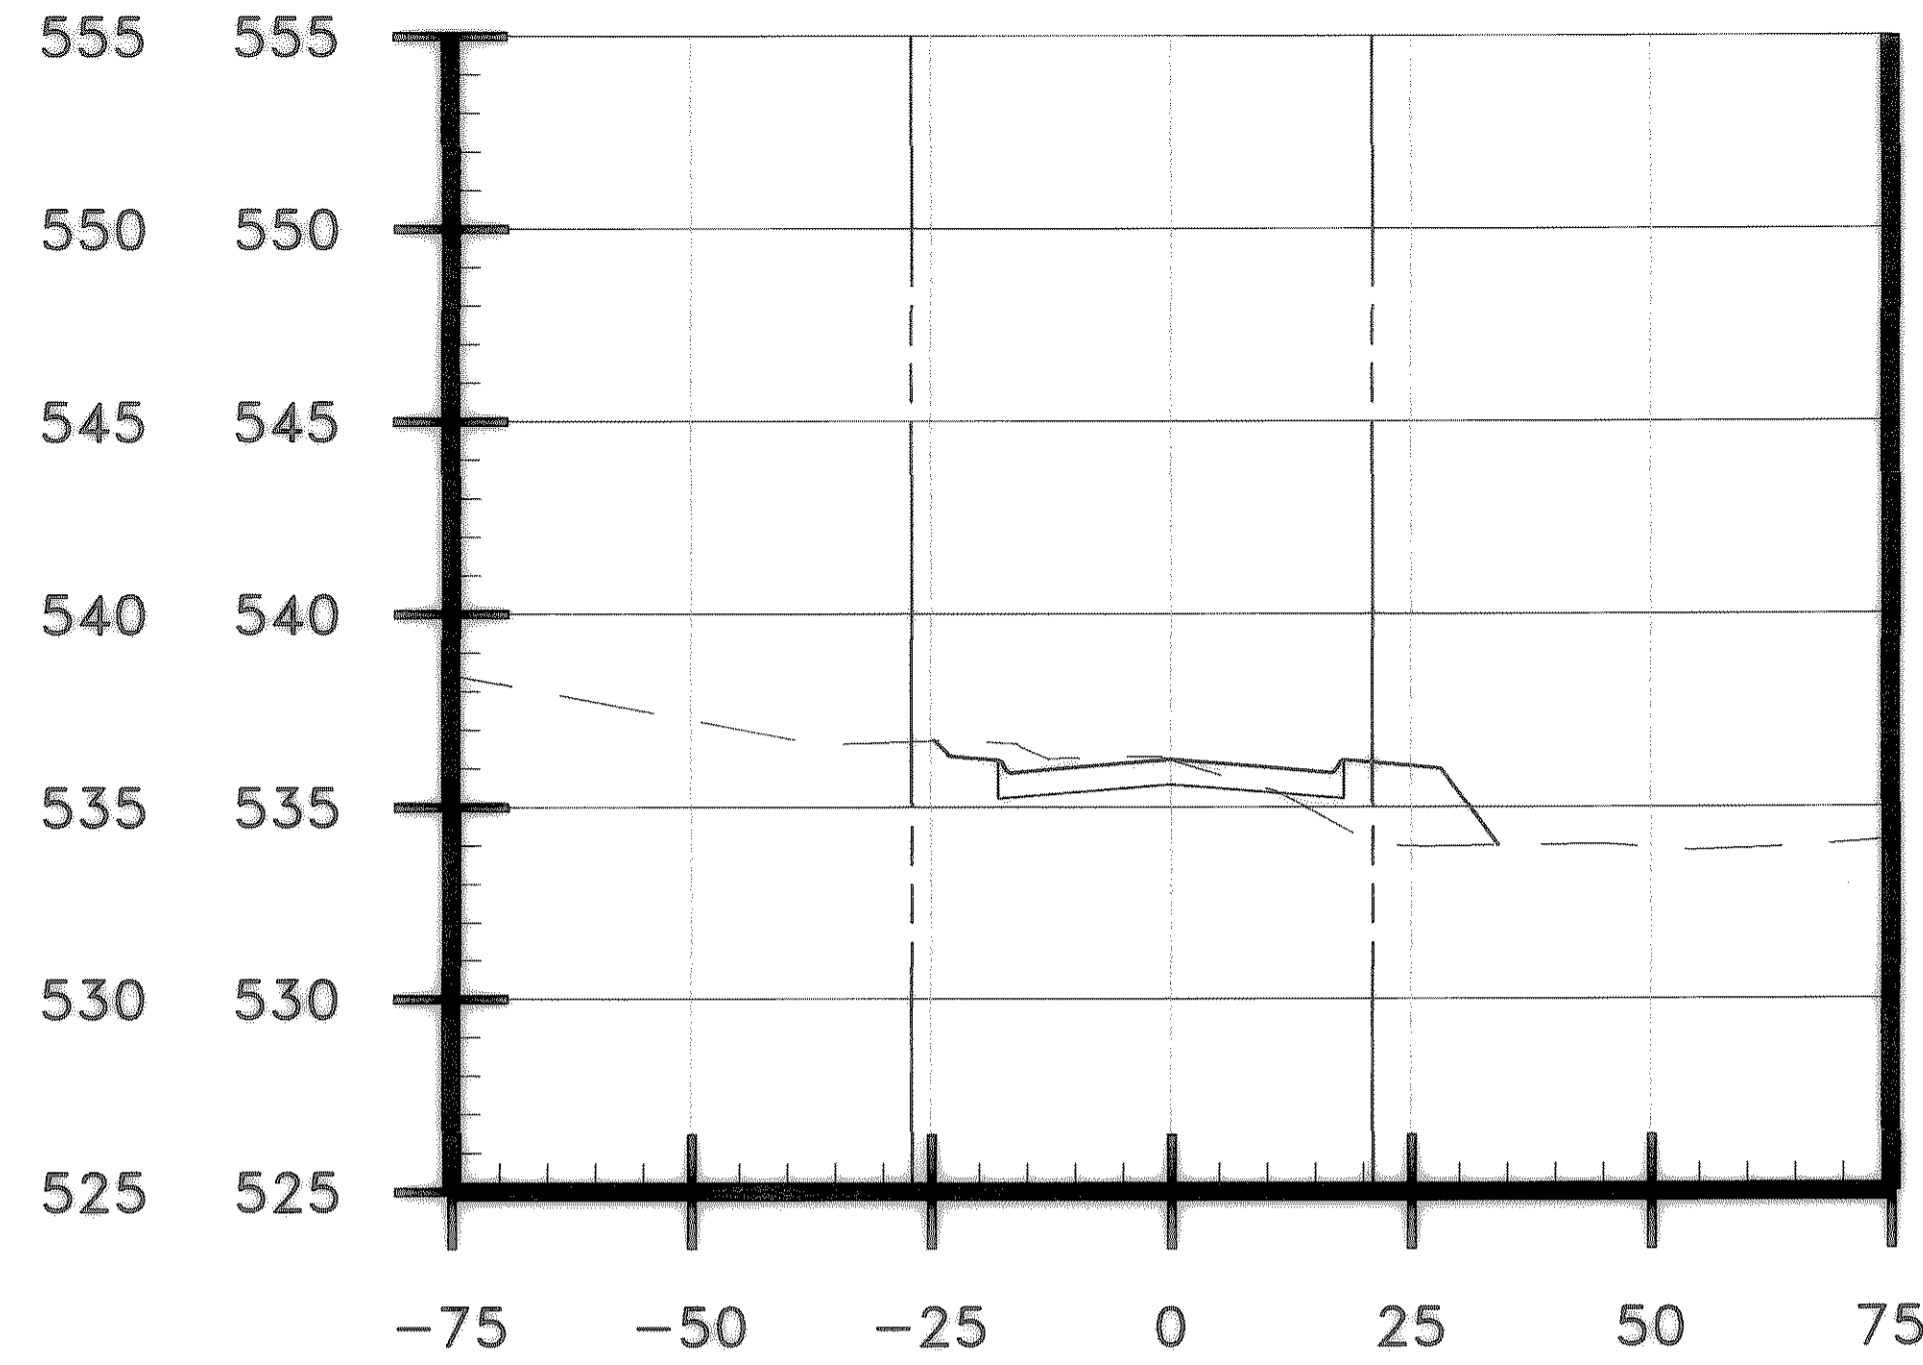


25+25

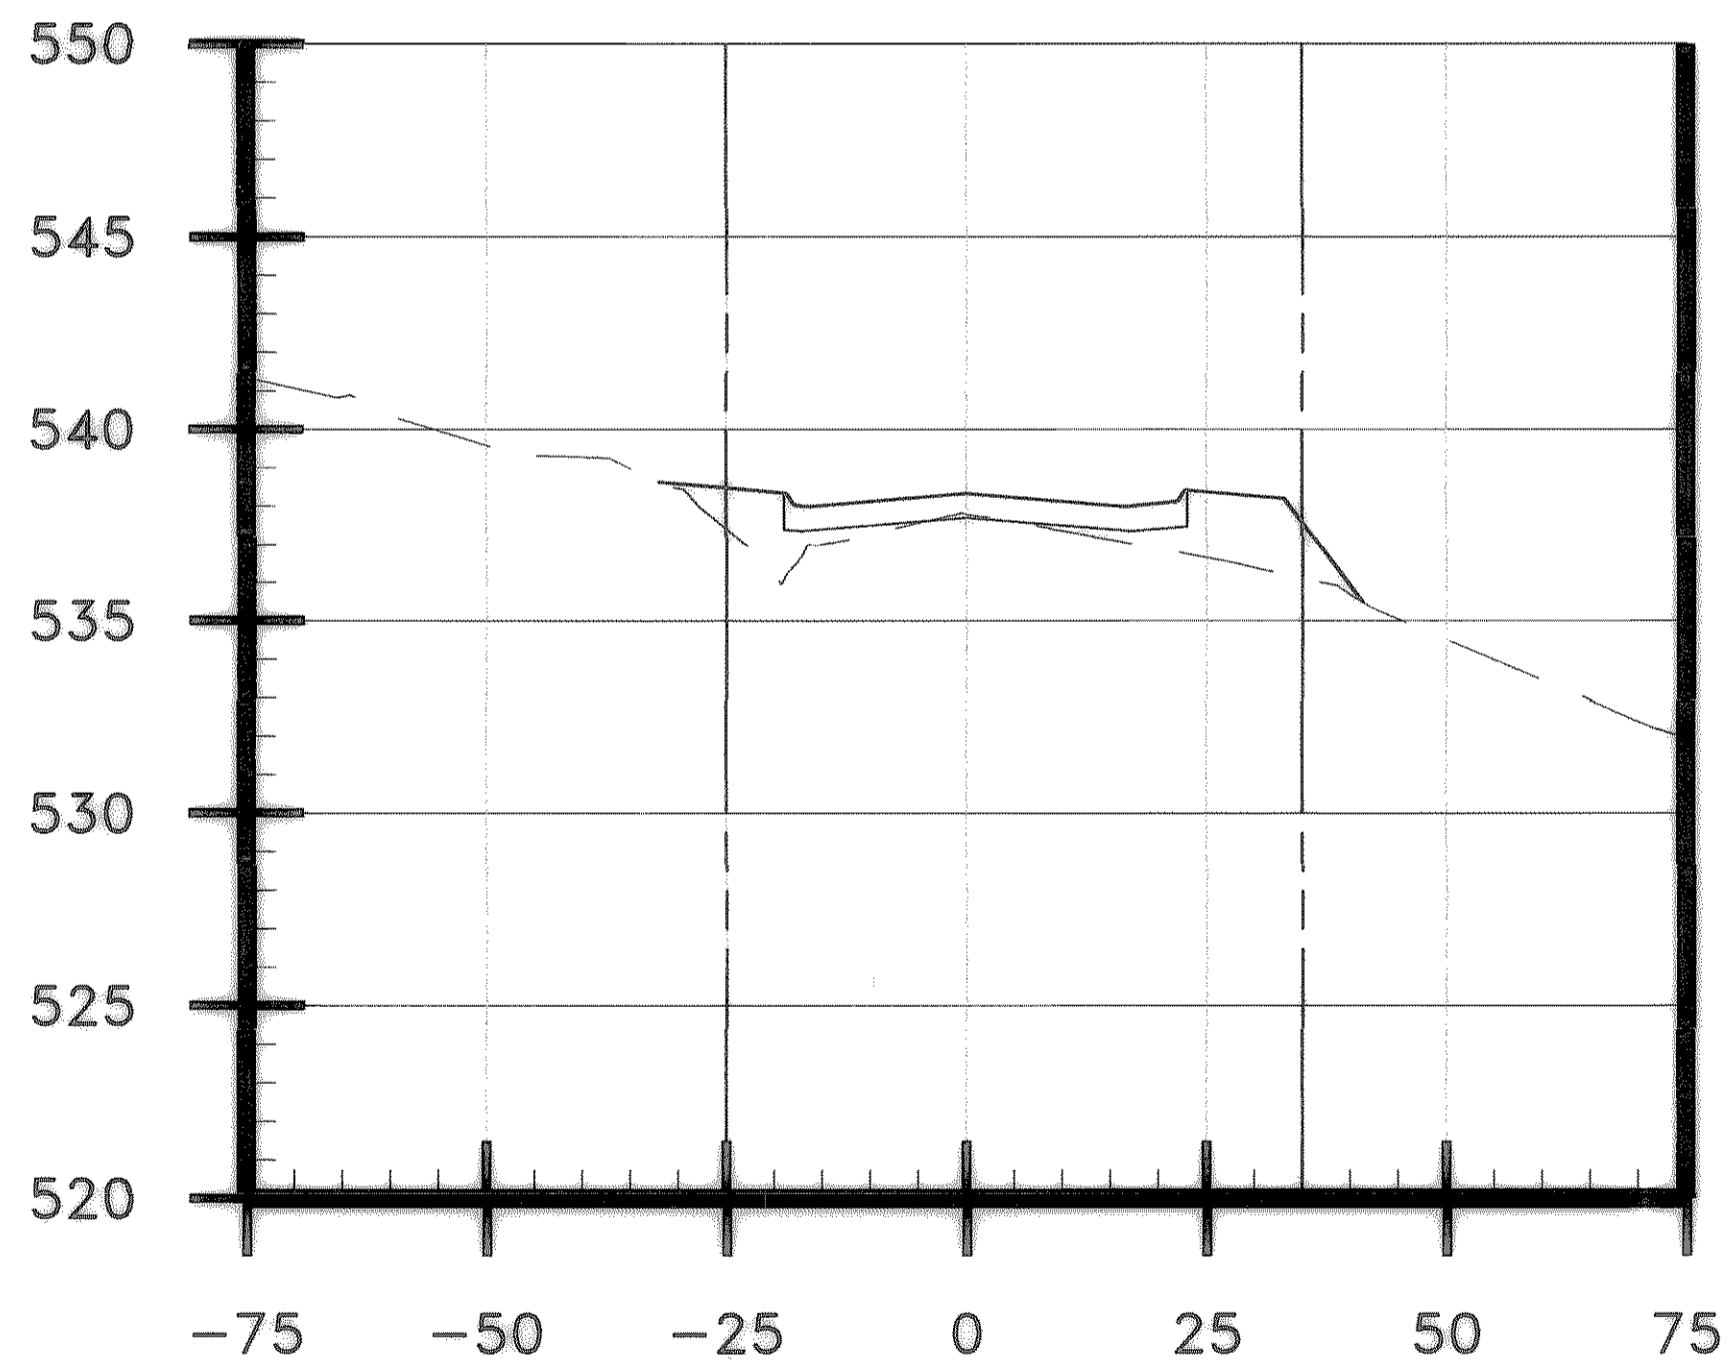

24+00

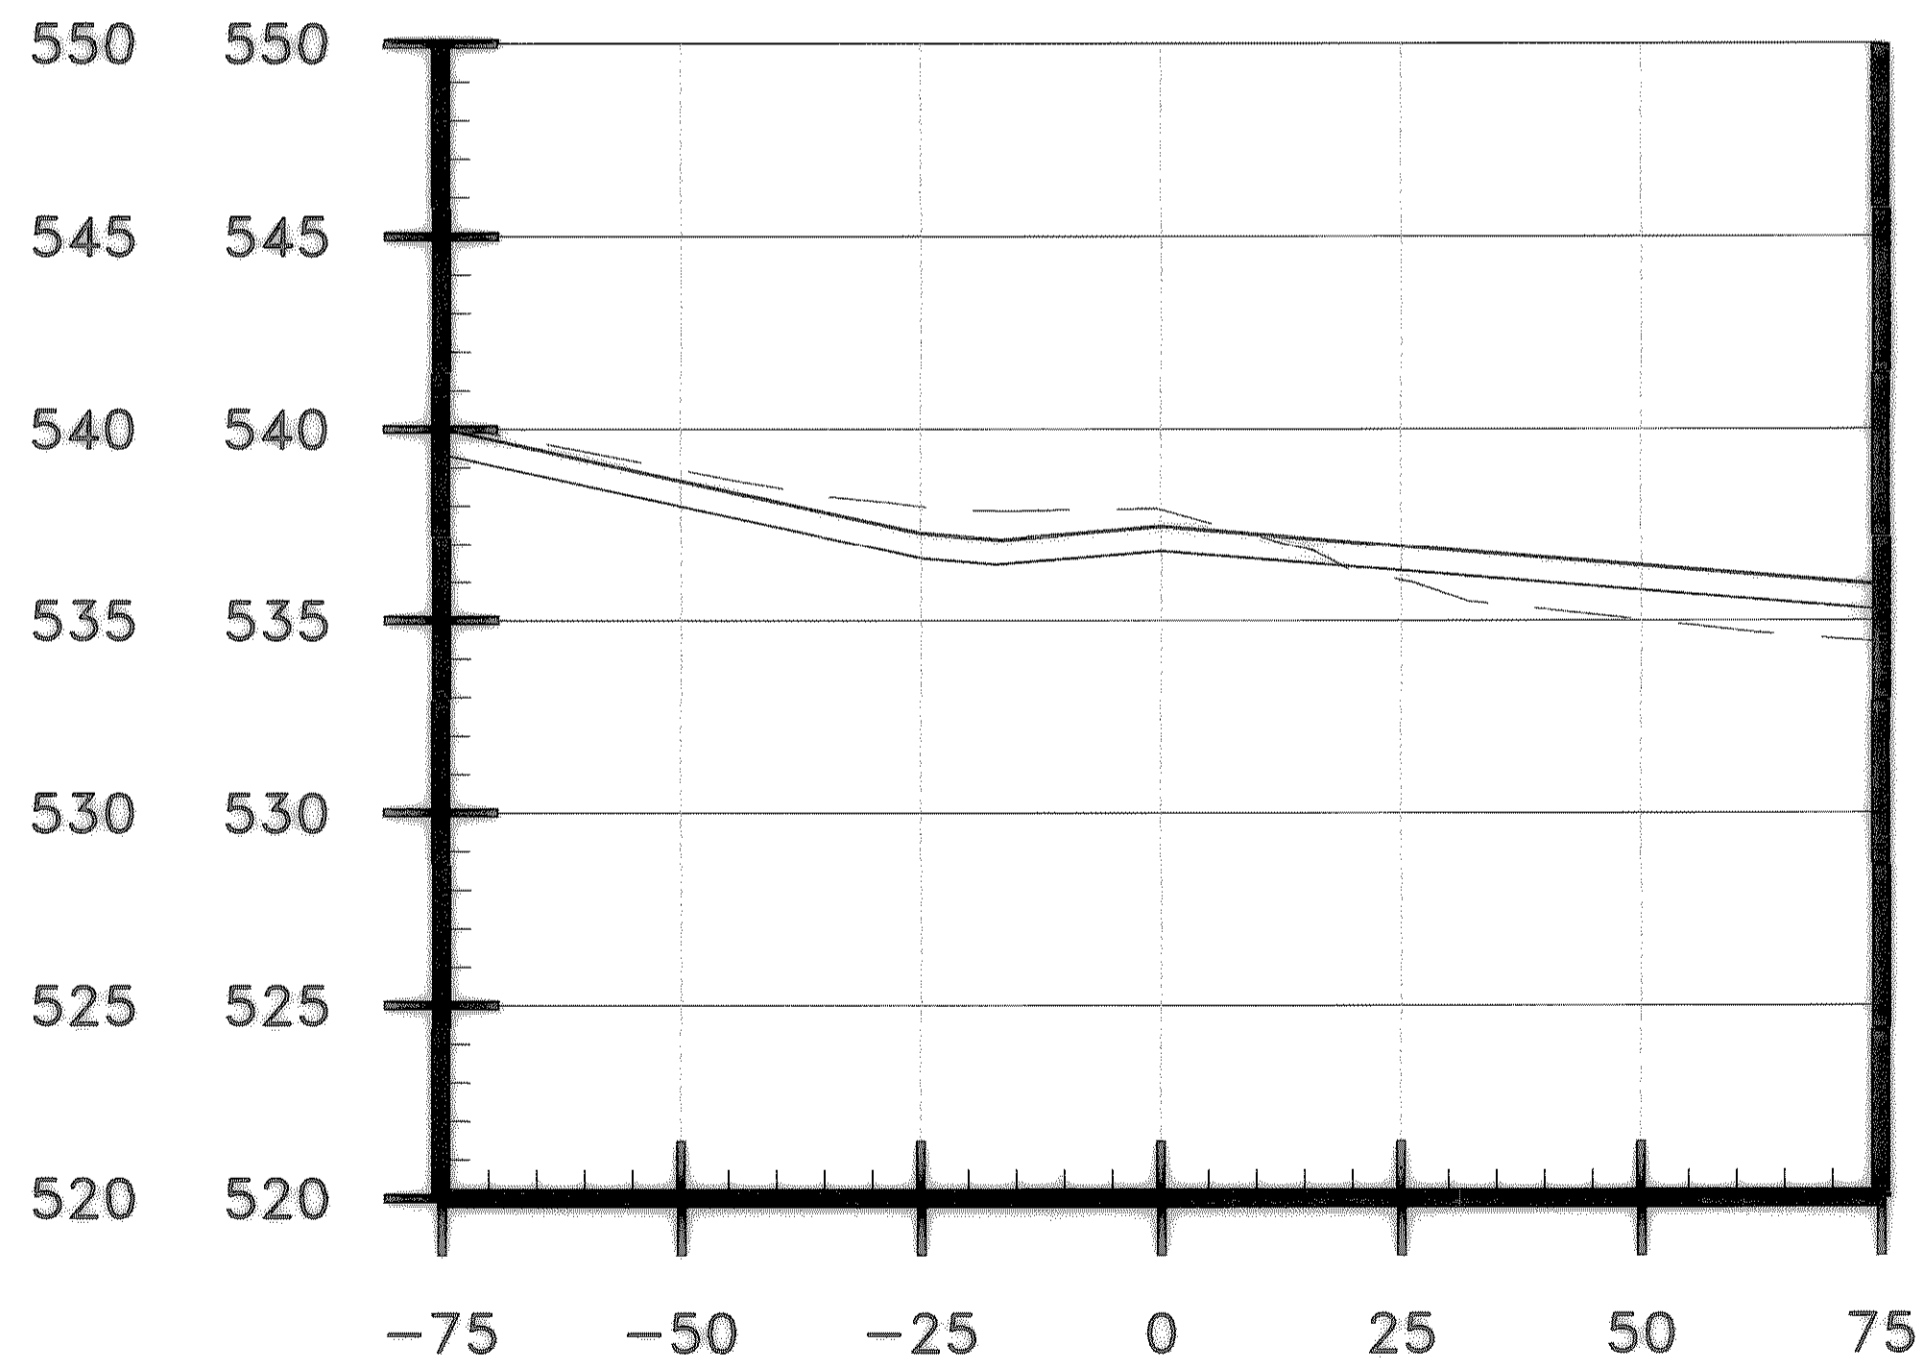

24+50

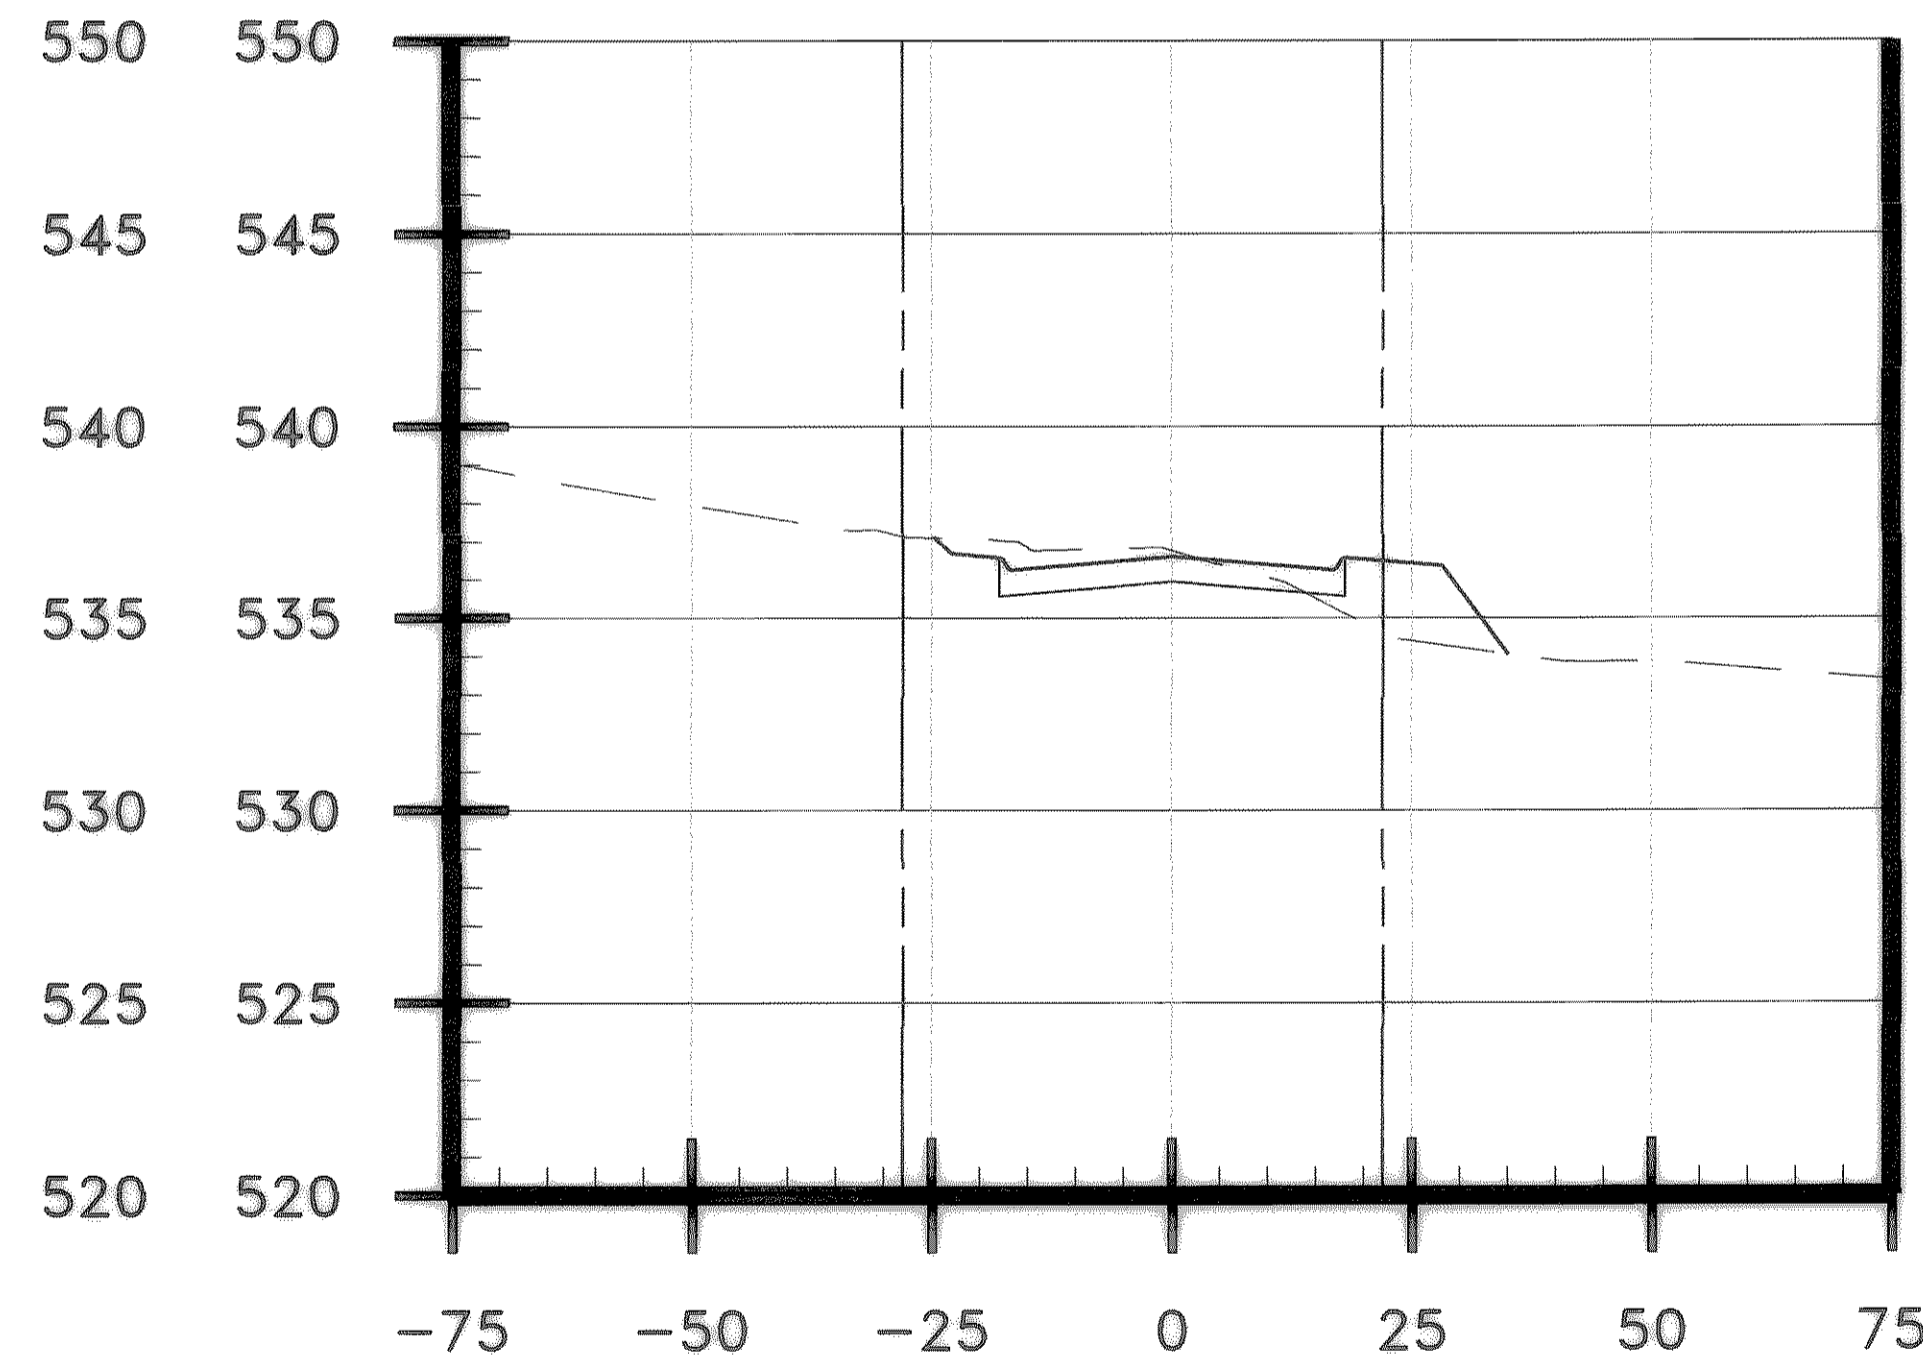

25+00

These plans and related specifications were prepared for construction of this specific project only. Reuse of these documents is not permitted without written authorization of Birkhoff, Hendricks & Conway, L.L.P.


CITY OF ROCKWALL, TEXAS

CLARK STREET CROSS SECTIONS

BIRKHOFF, HENDRICKS & CONWAY, L.L.P. CONSULTING ENGINEERS Dallas, Texas

REVISED TO CONFORM TO CONSTRUCTION RECORDS BY M.H. DATE 12/04/2006

THESE DOCUMENTS ARE FOR BIDDING, CONSTRUCTION, AND PERMIT PURPOSES. DATE: 8/6/04

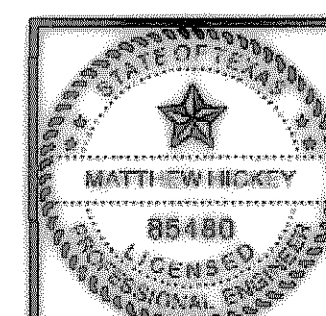

DESIGNED BY: M.H. PROJECT: 2003-120 SHEET NO. 132
DRAWN BY: B.H.C. DATE: AUGUST, 2004 OF SHEETS