




H:\ROCKWALL\2003120\INROADS\GROSS-SEC\CLARK-X\SECTION SCALE: 1=20 XREF: ROCKWALL\2003120\BASE\PROP-BASE

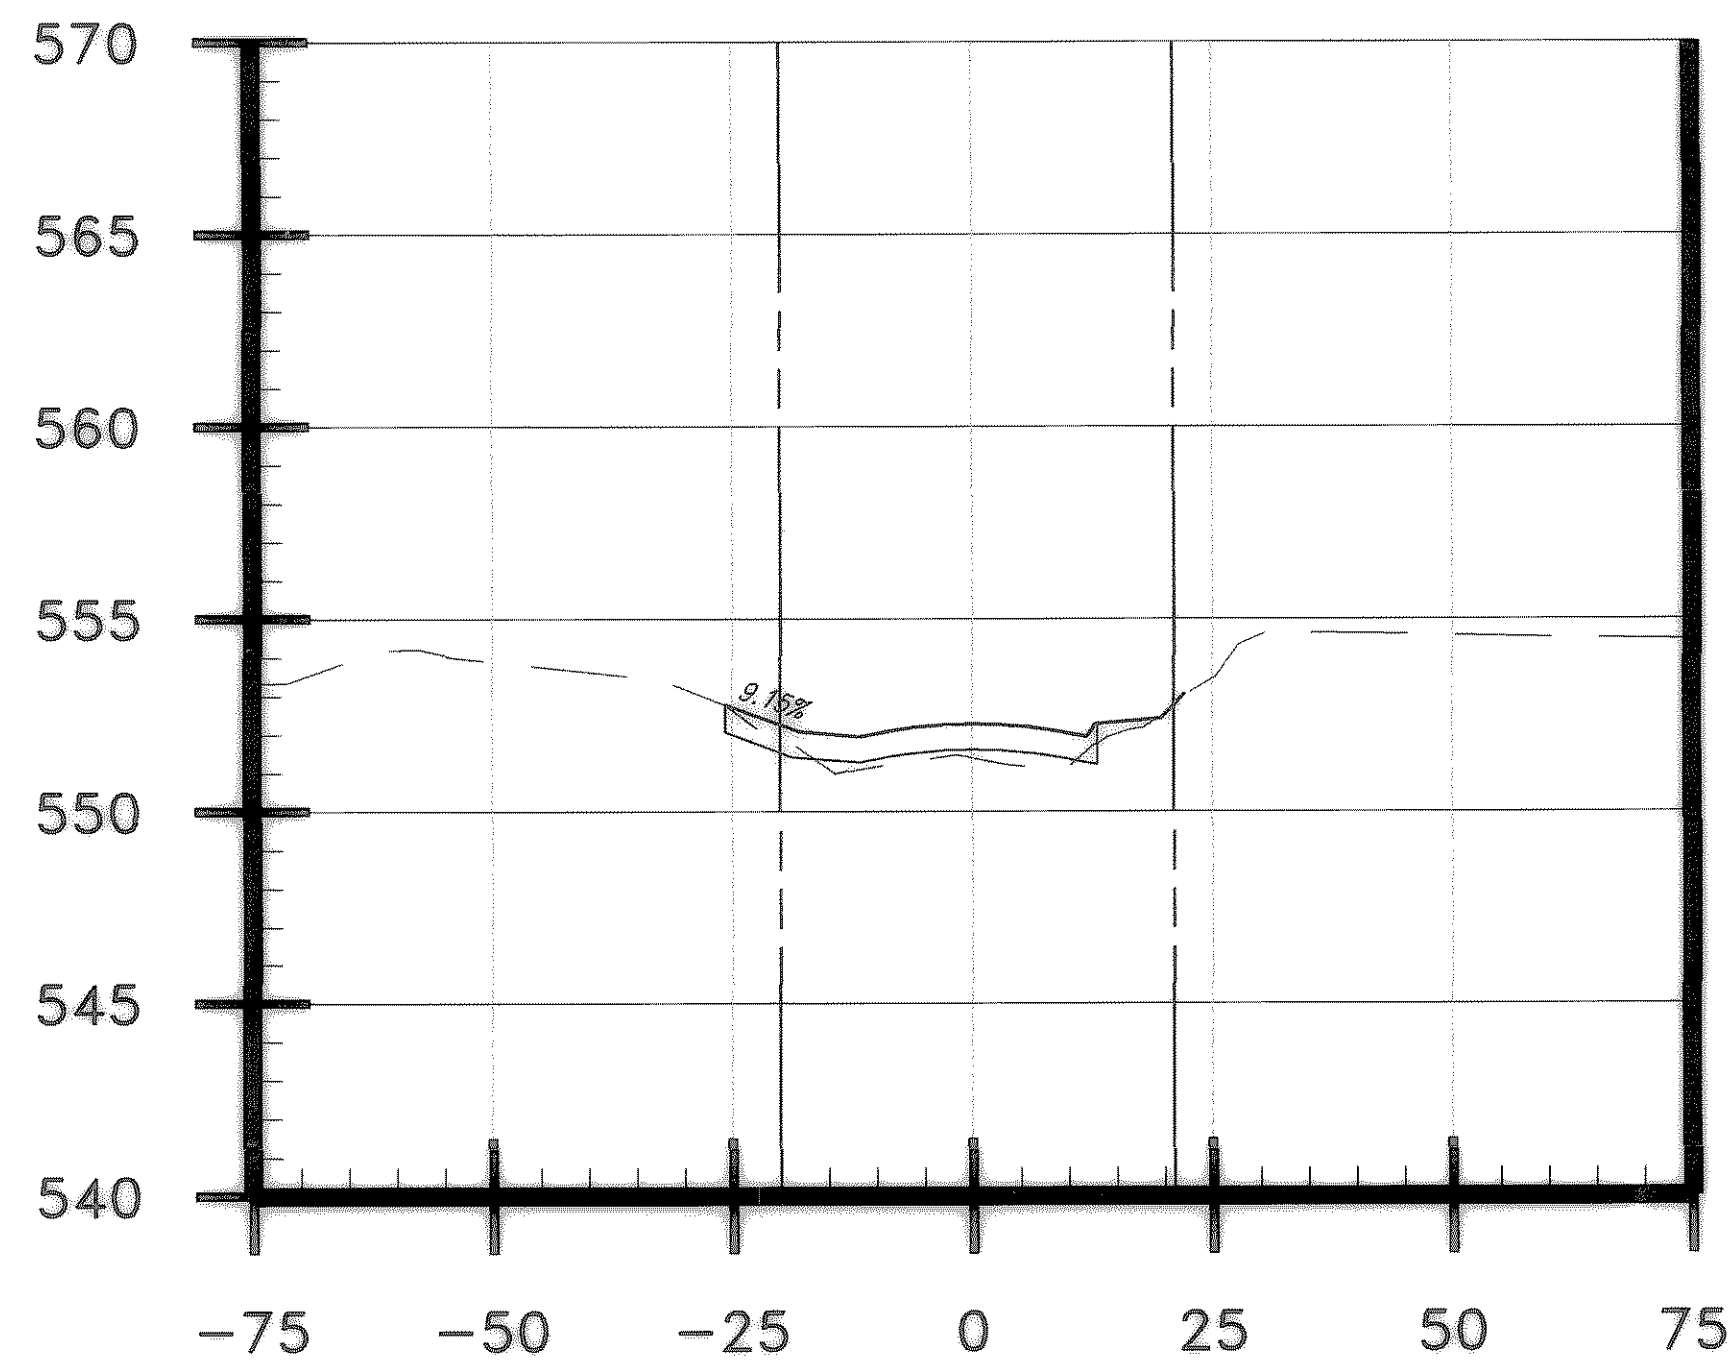


30+25

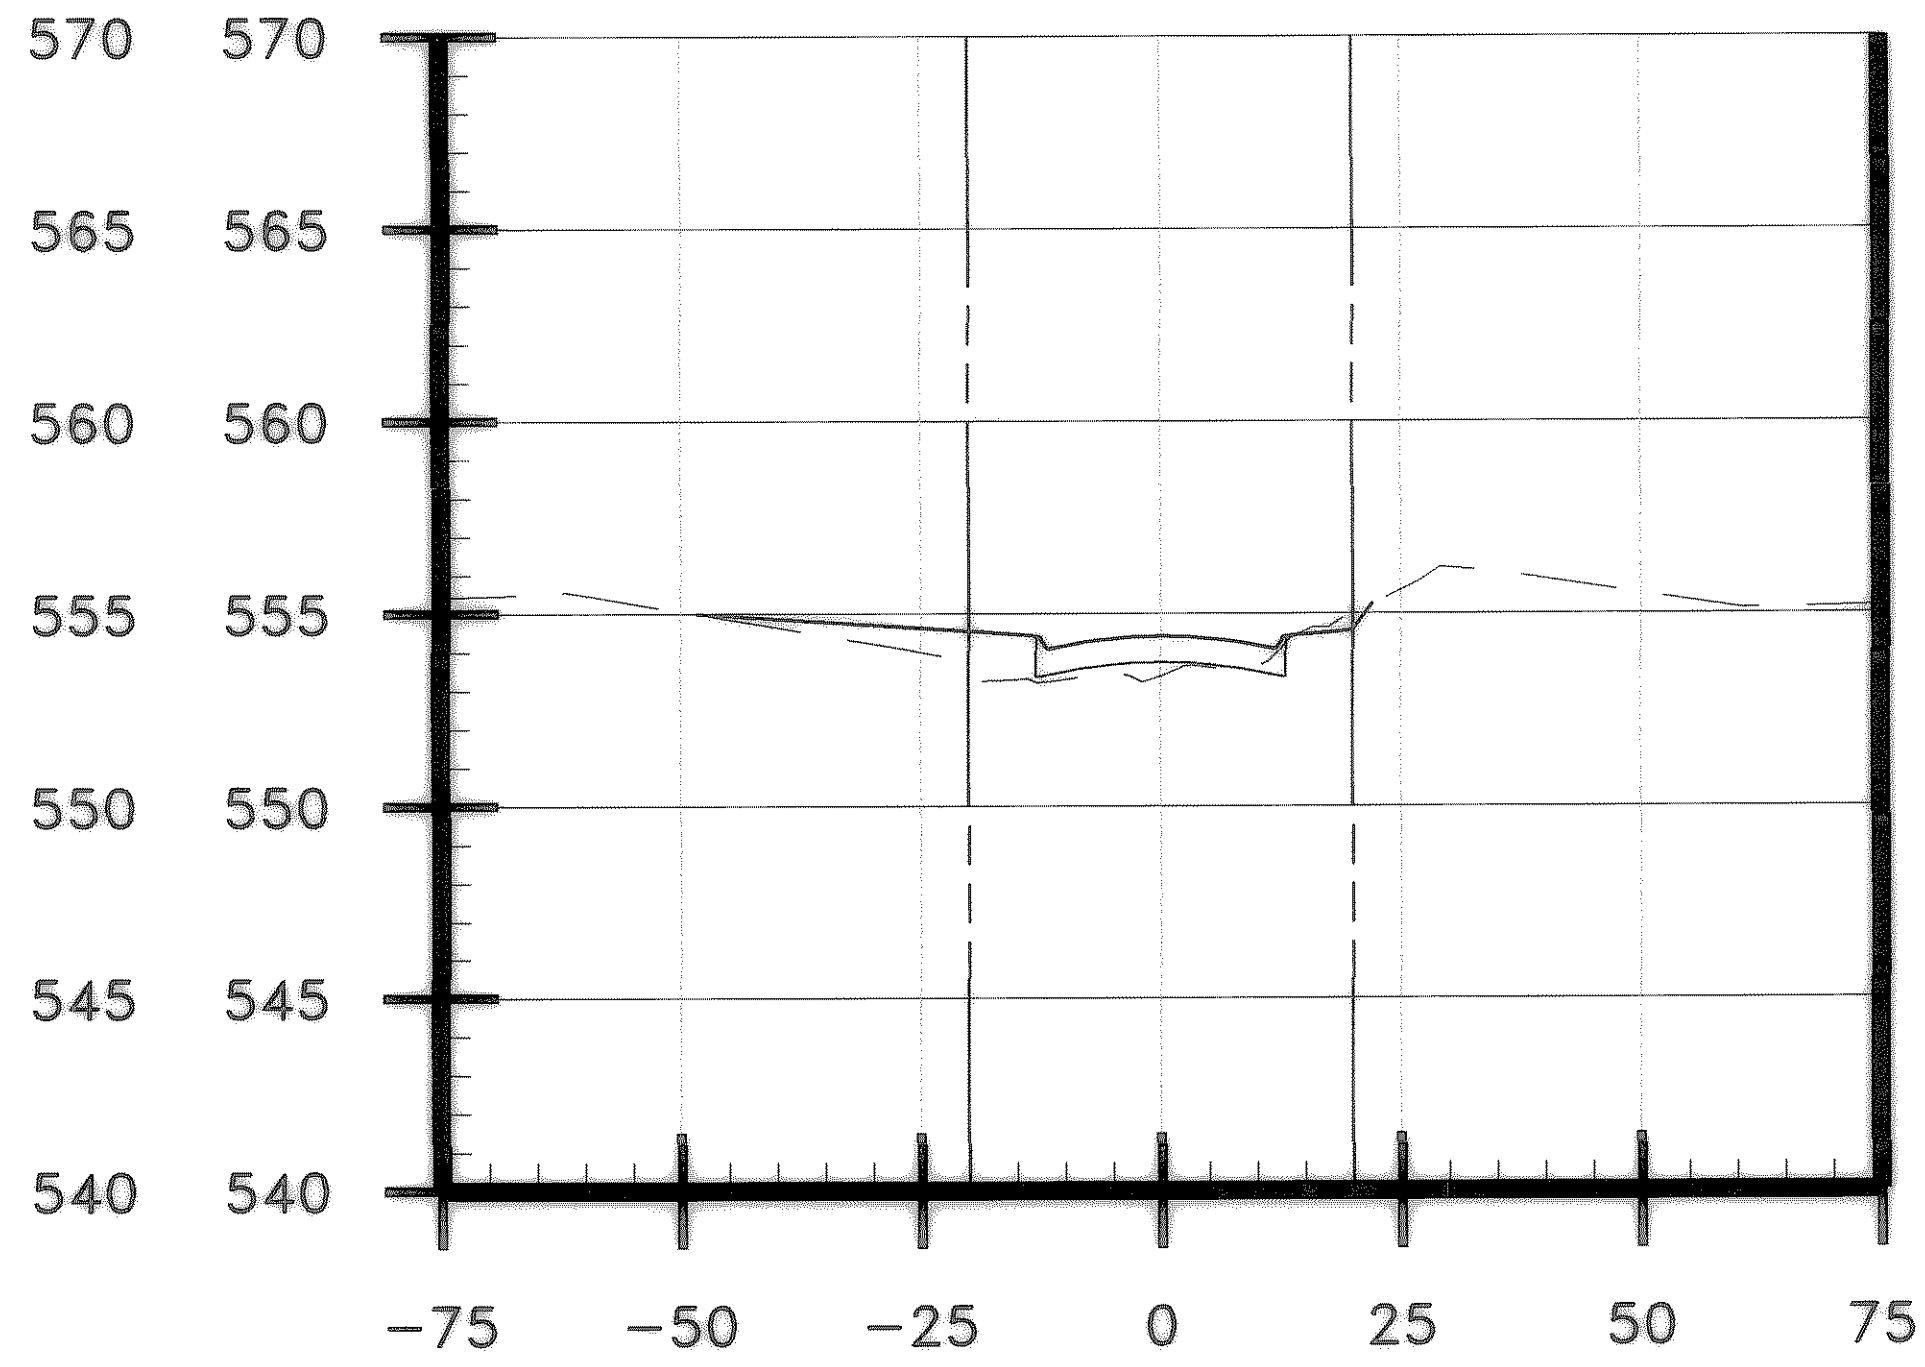


30+75

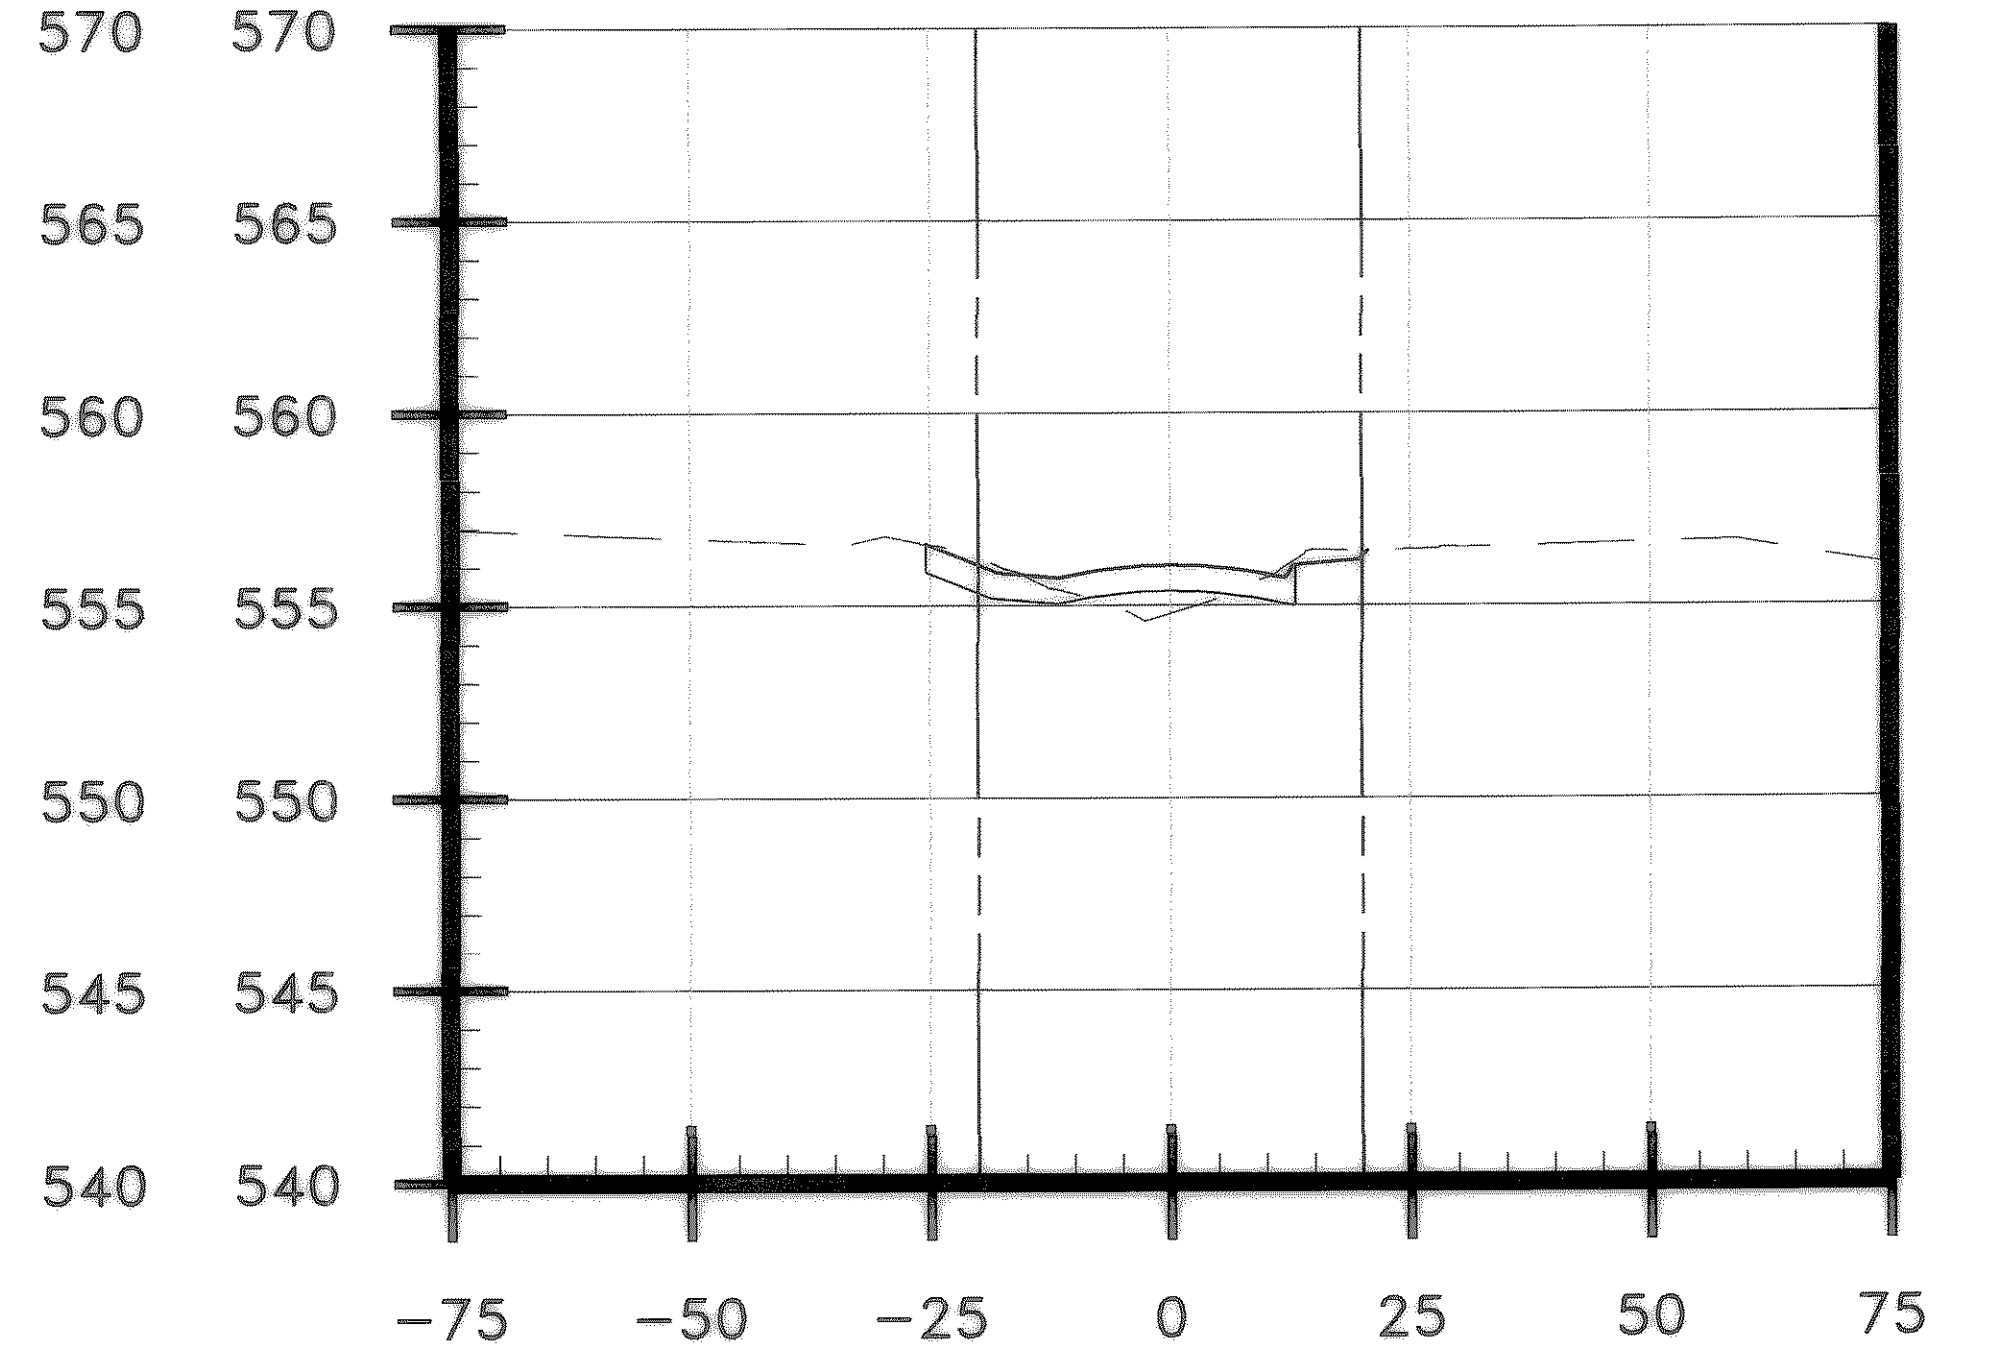


31+25

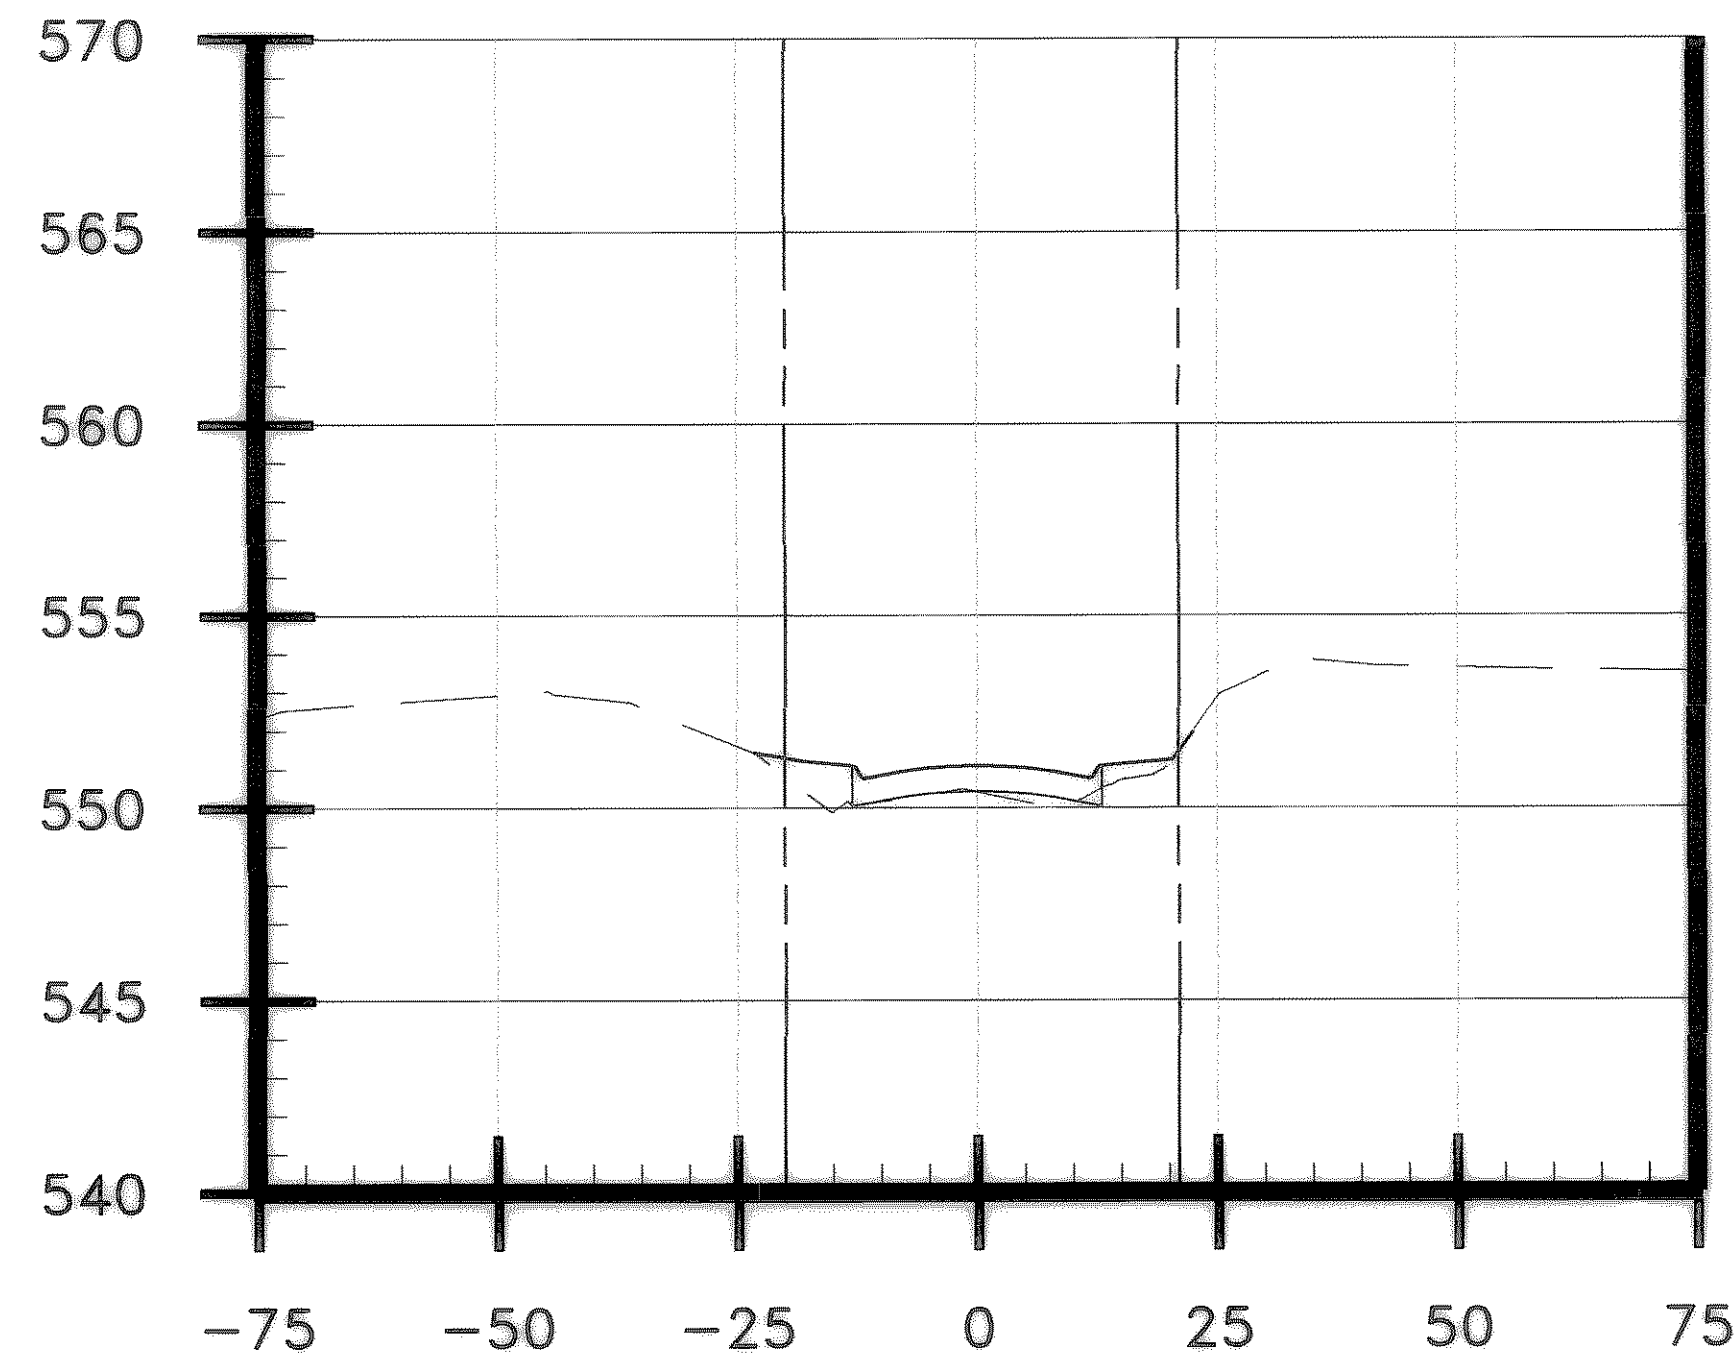

30+00

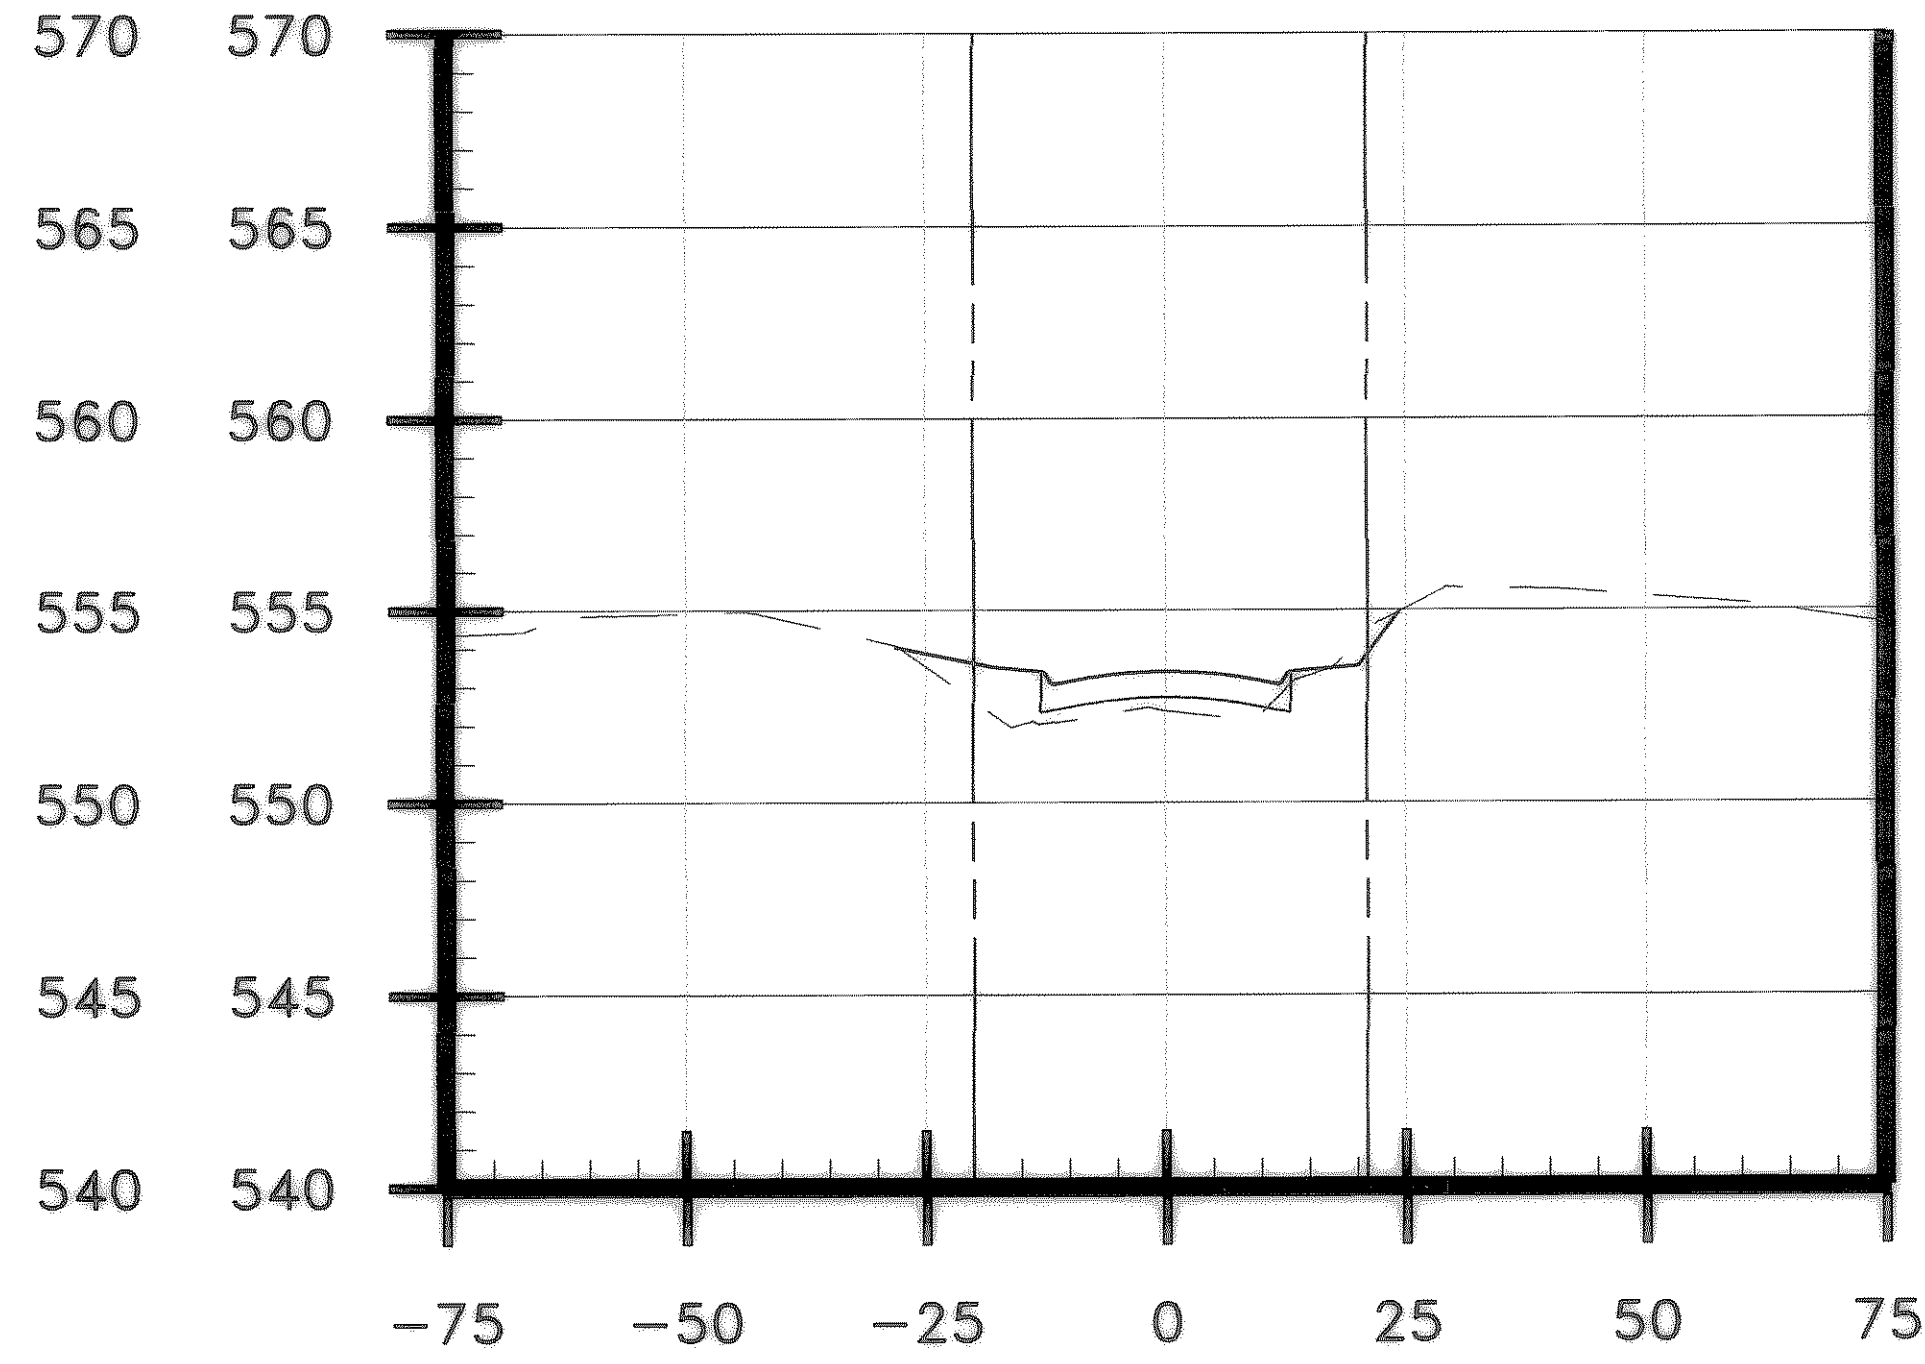

30+50

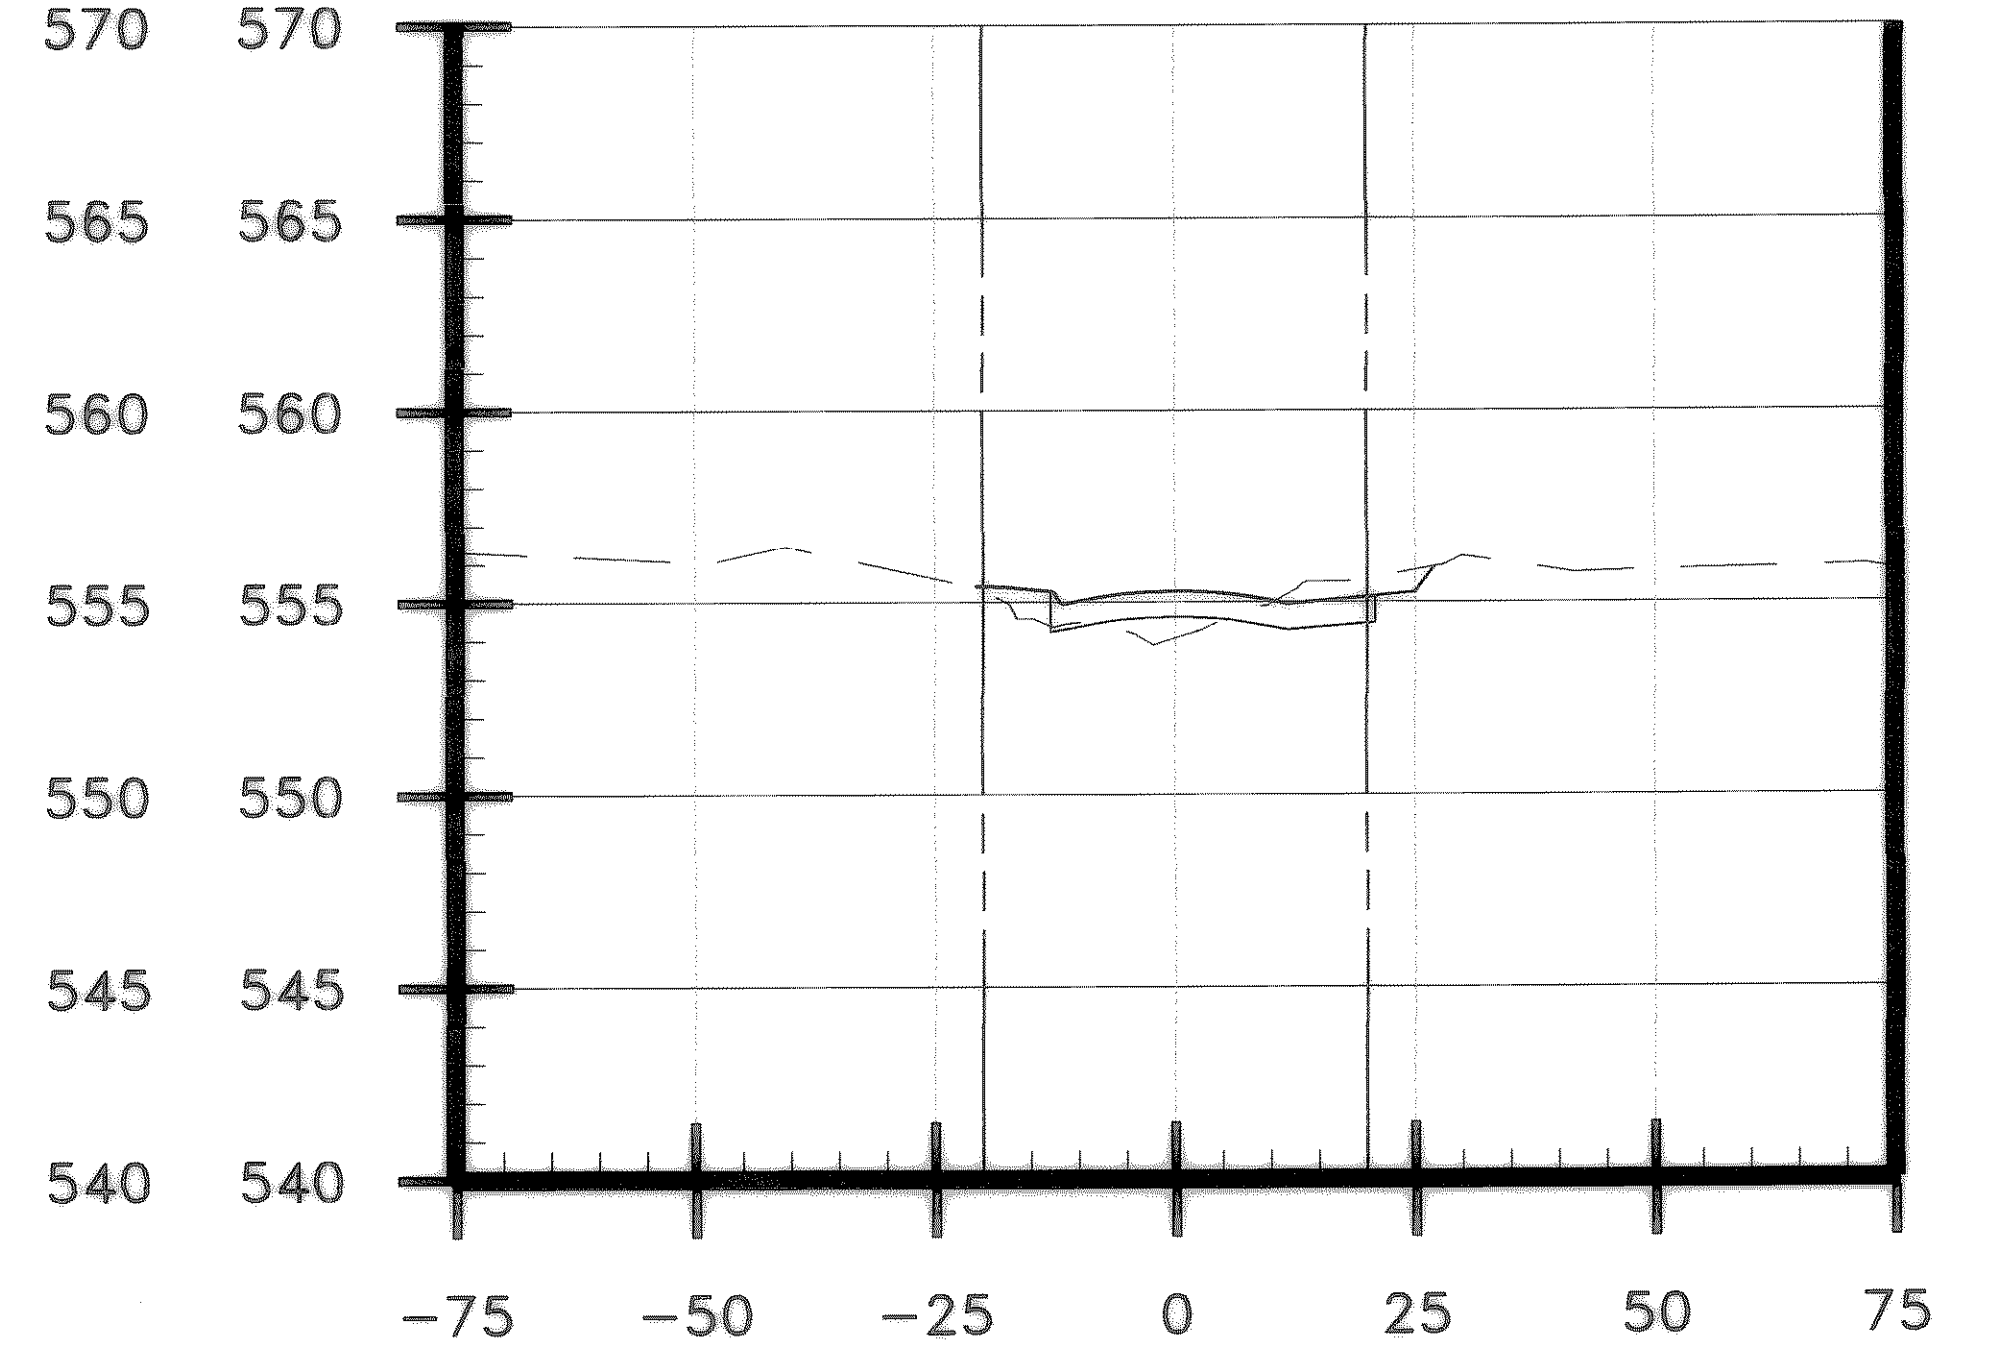

31+00

These plans and related specifications were prepared for construction of this specific project only. Reuse of these documents is not permitted without written authorization of Birkhoff, Hendricks & Conway, L.L.P.


CITY OF ROCKWALL, TEXAS

CLARK STREET CROSS SECTIONS

BIRKHOFF, HENDRICKS & CONWAY, L.L.P.  
CONSULTING ENGINEERS  
Dallas, Texas

REVISED TO CONFORM TO CONSTRUCTION RECORDS  
BY M.H. DATE 12/04/2006

THESE DOCUMENTS ARE FOR BIDDING, CONSTRUCTION, AND PERMIT PURPOSES.  
Matthew Hickey  
DATE: 8/2/04

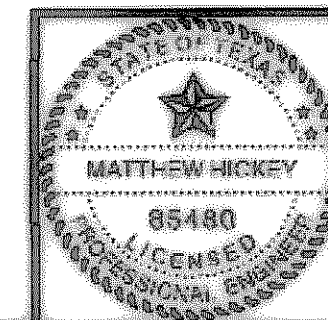

DESIGNED BY: M.H. PROJECT: 2003-120 SHEET NO. 136  
DRAWN BY: B.H.C. DATE: AUGUST, 2004 OF 136 SHEETS