
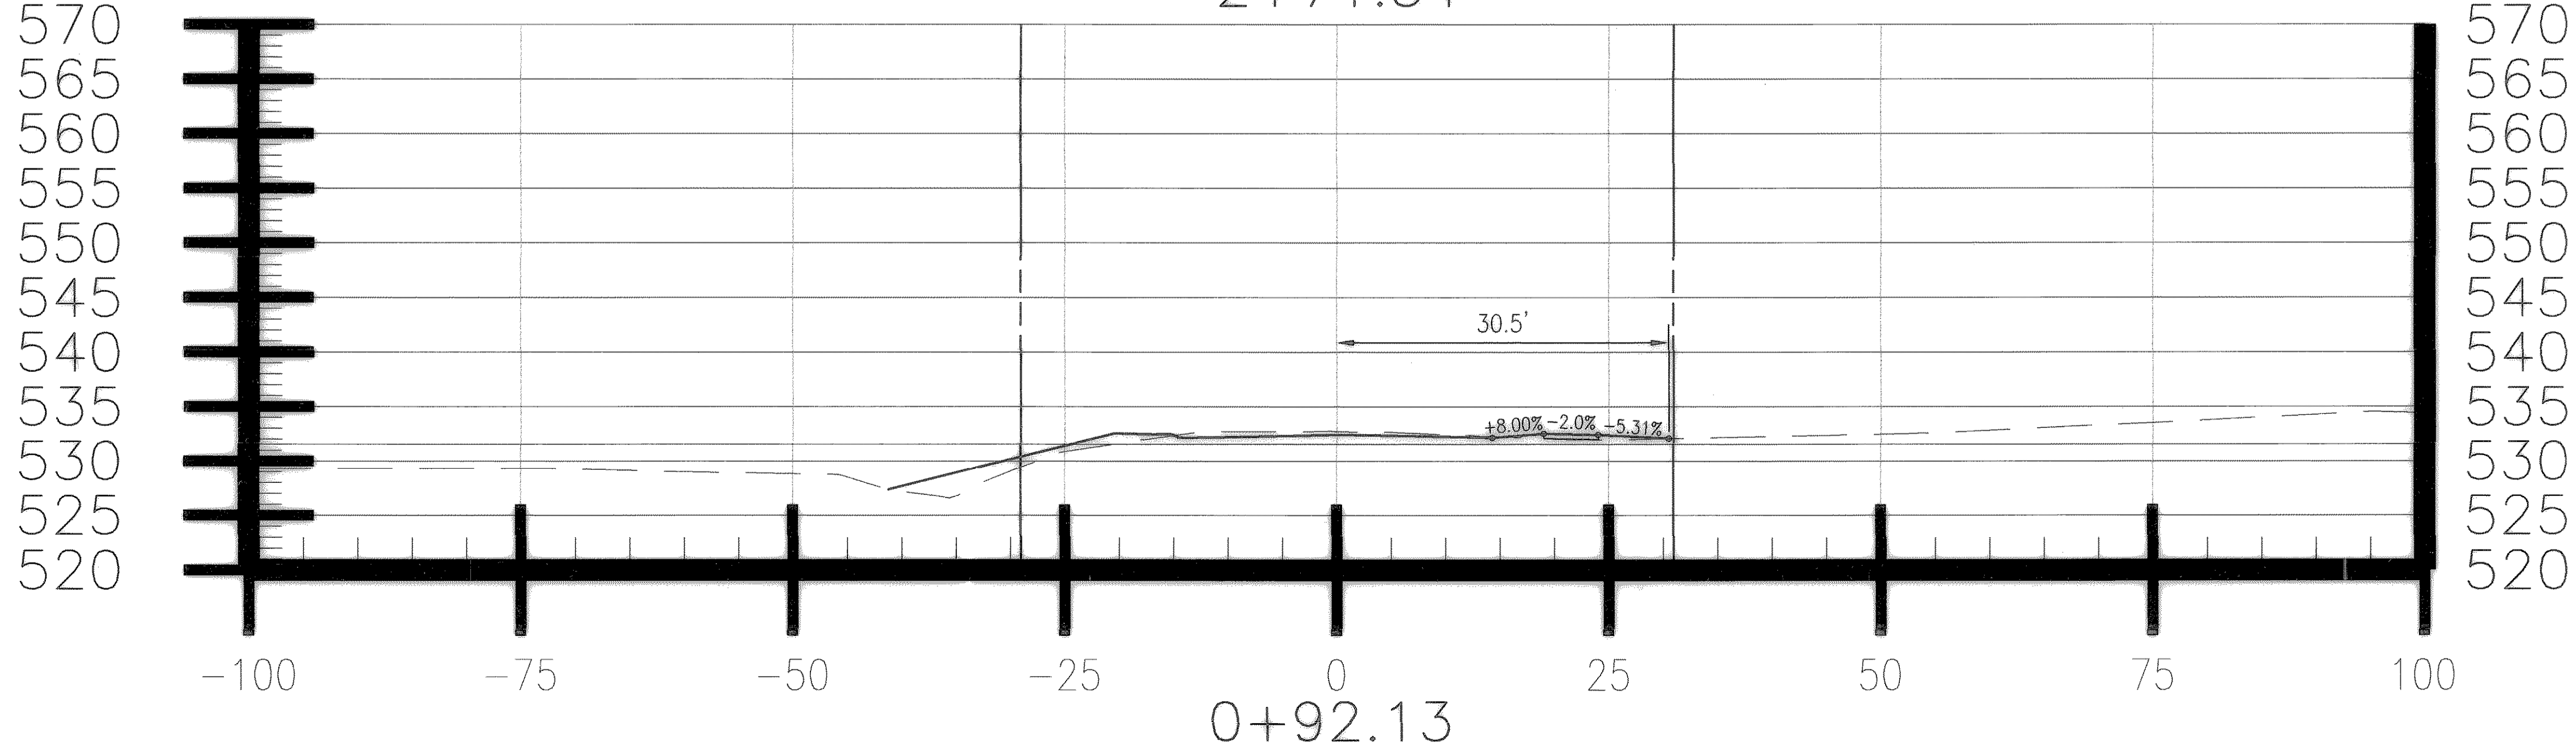
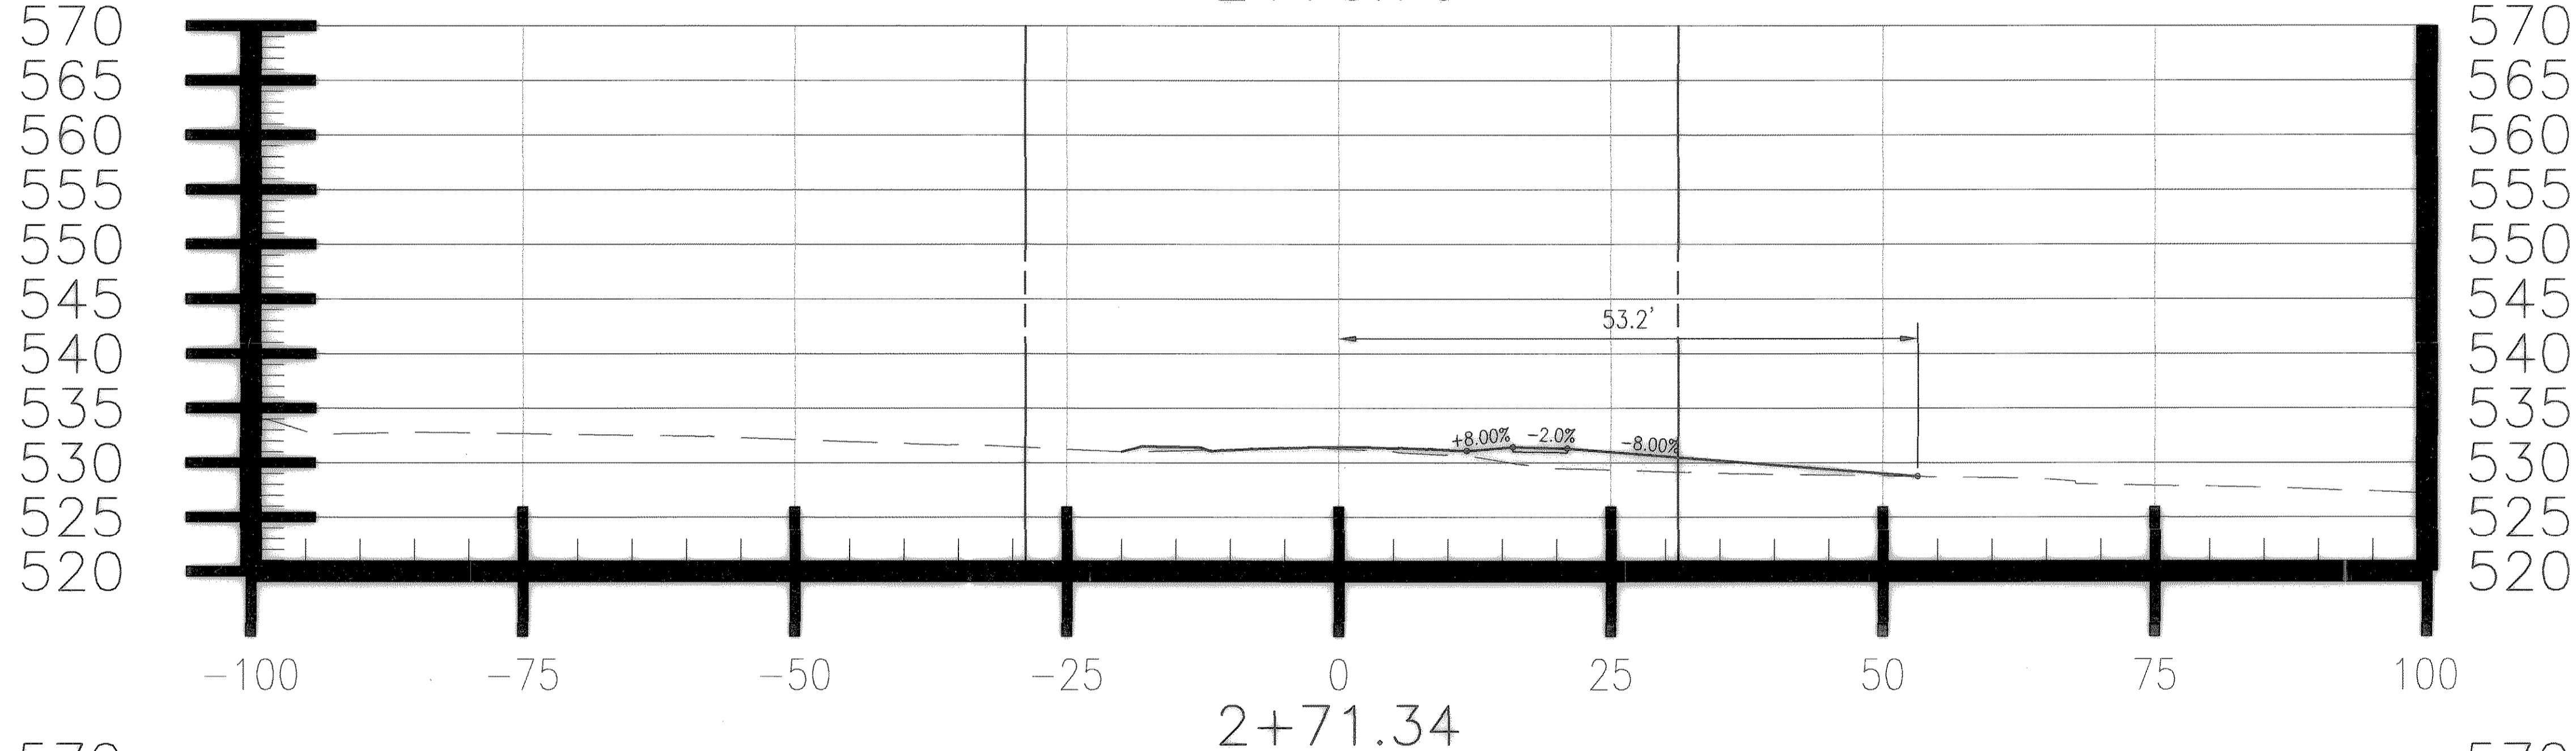



08/05/04 LBS H:\ROCKWALL\2003120\ROADS\MAIN-DWAY-PROF.DWG SCALE: 1=10 REF: X

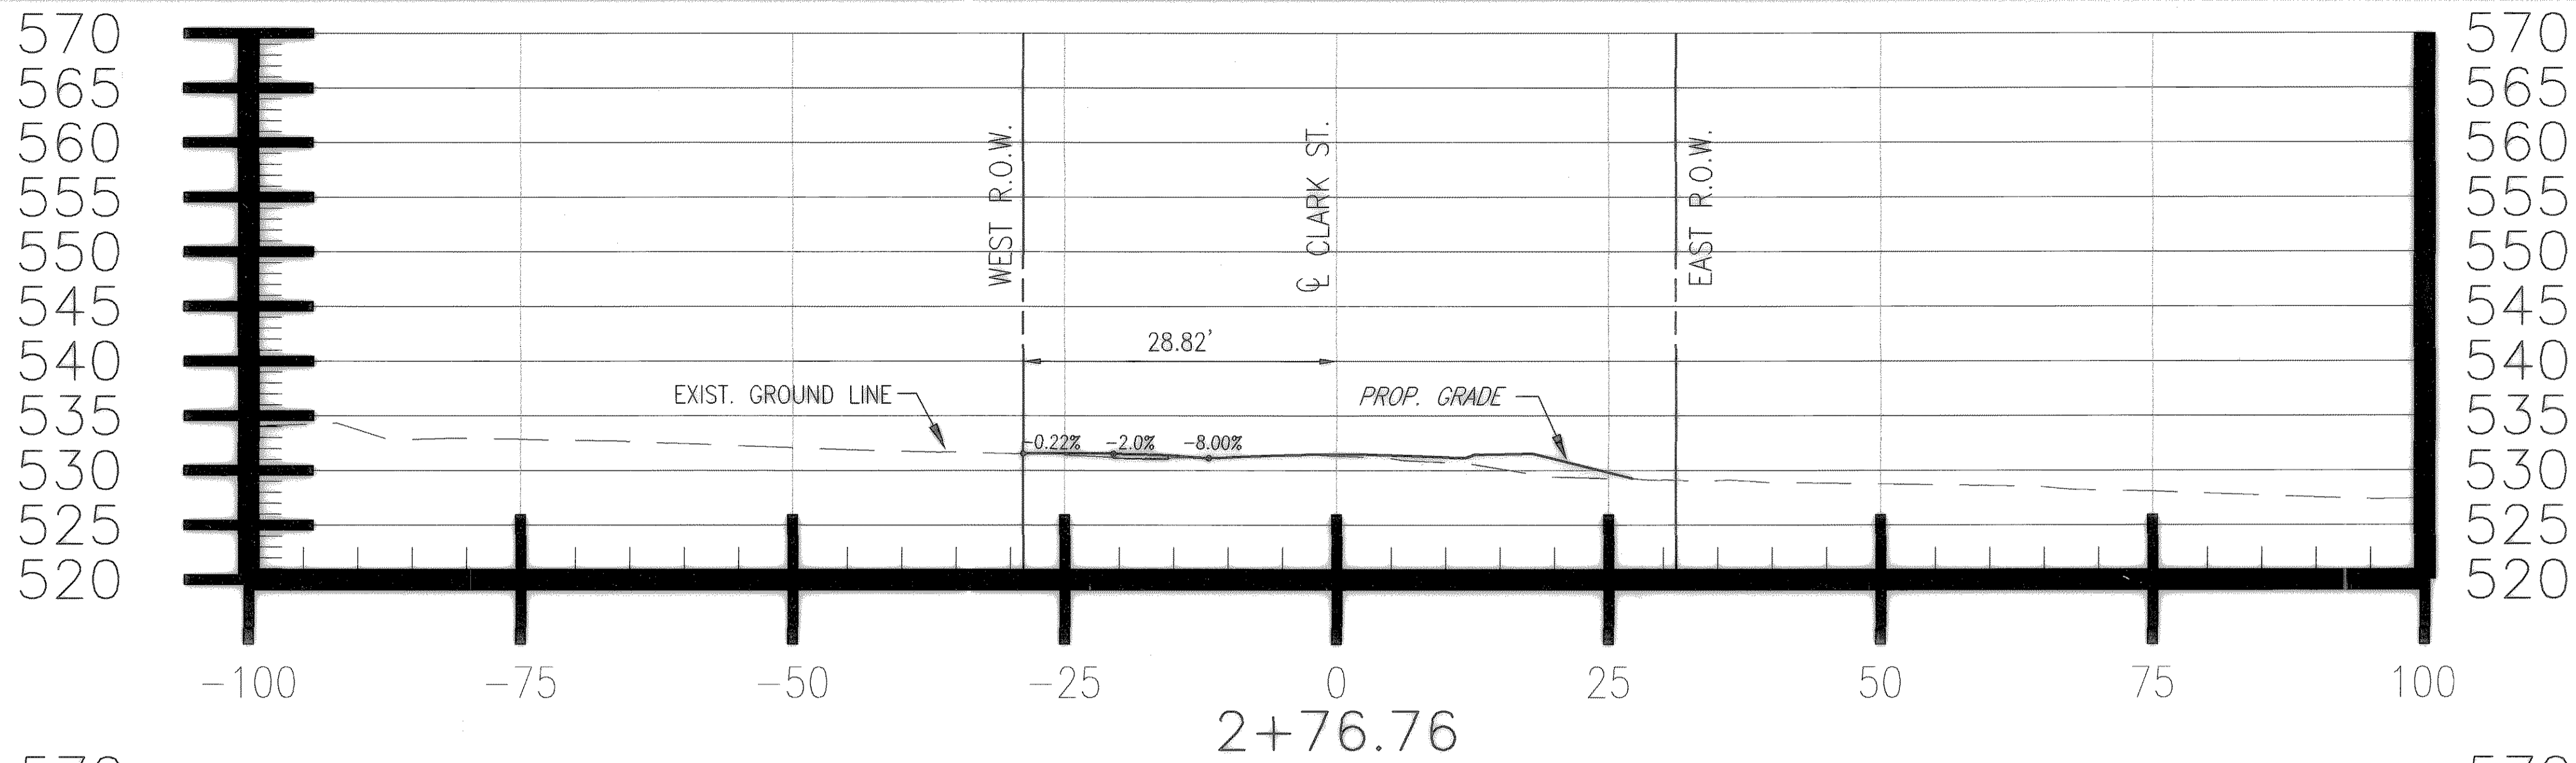

REVISED TO CONFORM
 TO CONSTRUCTION RECORDS
 BY M.H. DATE 12/04/2006

These plans and related specifications
 were prepared for construction of this
 specific project only. Reuse of these
 documents is not permitted without
 written authorization of Birkhoff,
 Hendricks & Conway, L.L.P.

THESE DOCUMENTS ARE FOR
 BIDDING, CONSTRUCTION,
 AND PERMIT PURPOSES.
Matthew Hickey
 DATE: 8/26/04

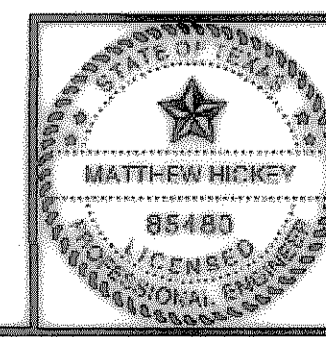

CITY OF ROCKWALL, TEXAS			
CLARK STREET DRIVEWAY CROSS SECTIONS			
BIRKHOFF, HENDRICKS & CONWAY, L.L.P. CONSULTING ENGINEERS Dallas, Texas			
DESIGNED BY: <u>M.H.</u>	PROJECT: <u>2003-120</u>	SHEET NO. <u>139</u>	
DRAWN BY: <u>B.H.C.</u>	DATE: <u>AUGUST, 2004</u>	OF <u> </u> SHEETS	