




08/05/04 LBS H:\ROCKWALL\2003120\ROADS\MAIN-DWAY-PROF.DWG SCALE: 1=10 XREF: X

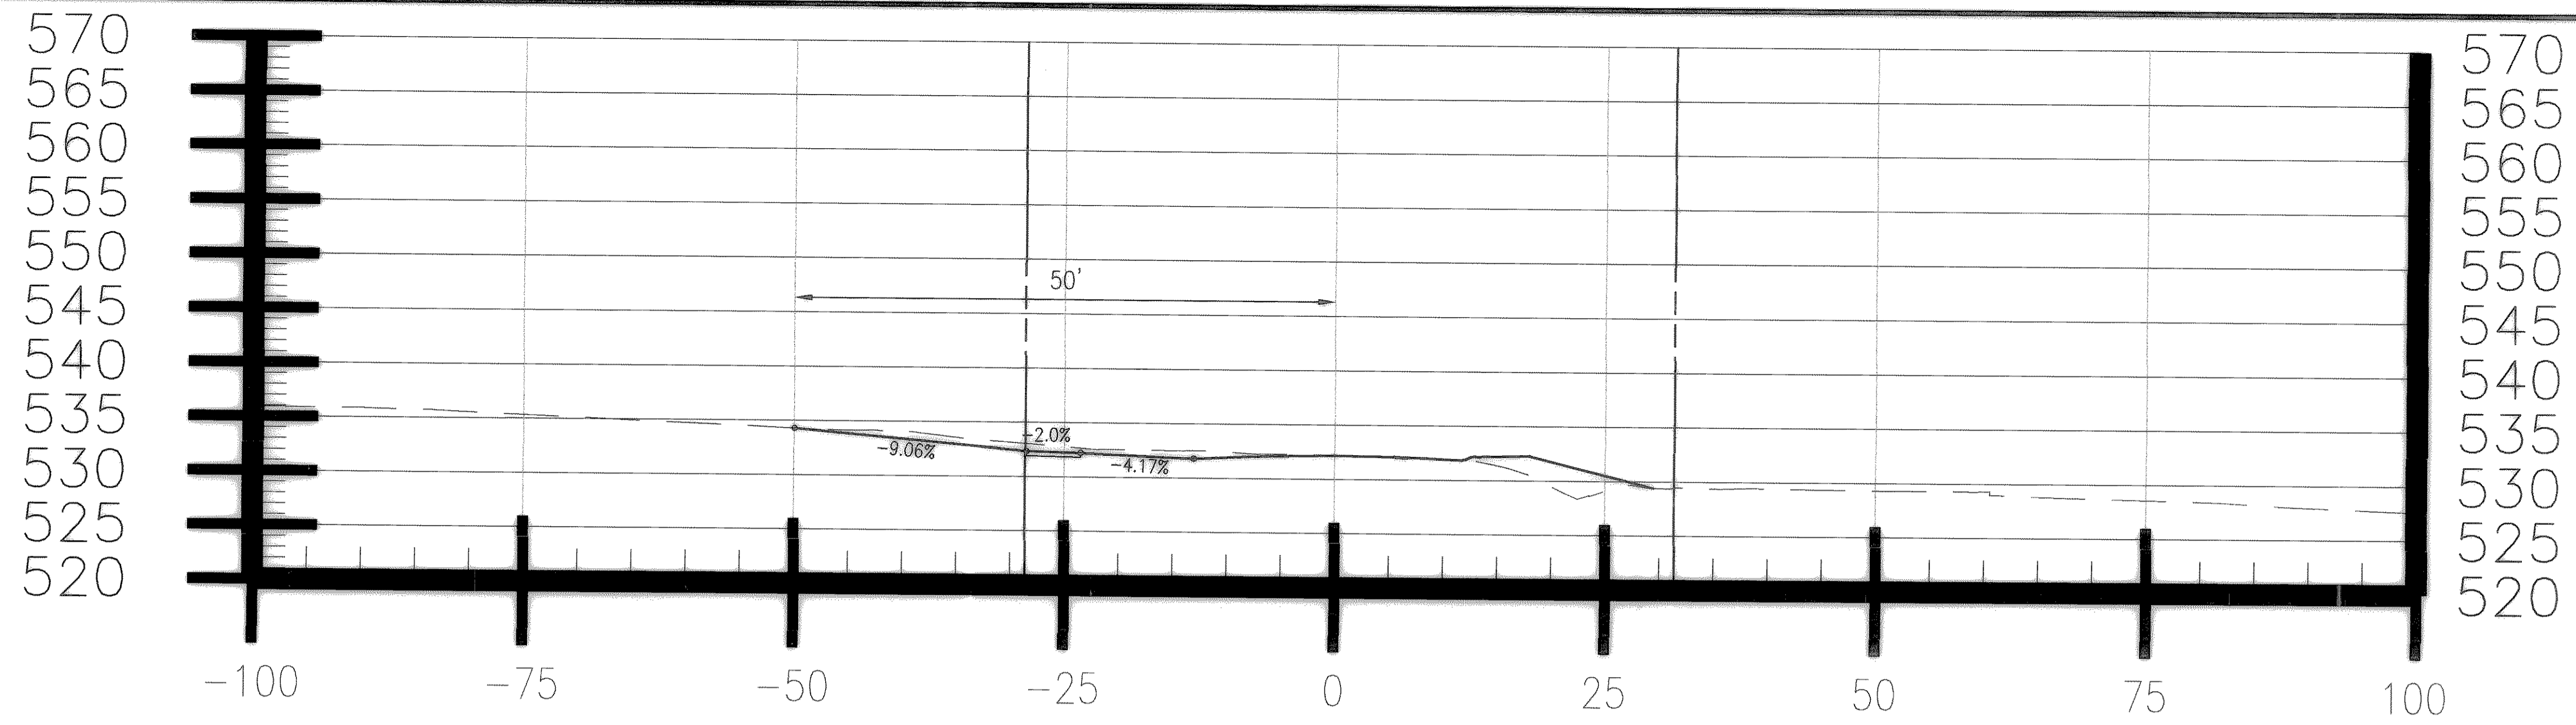

4+20.07

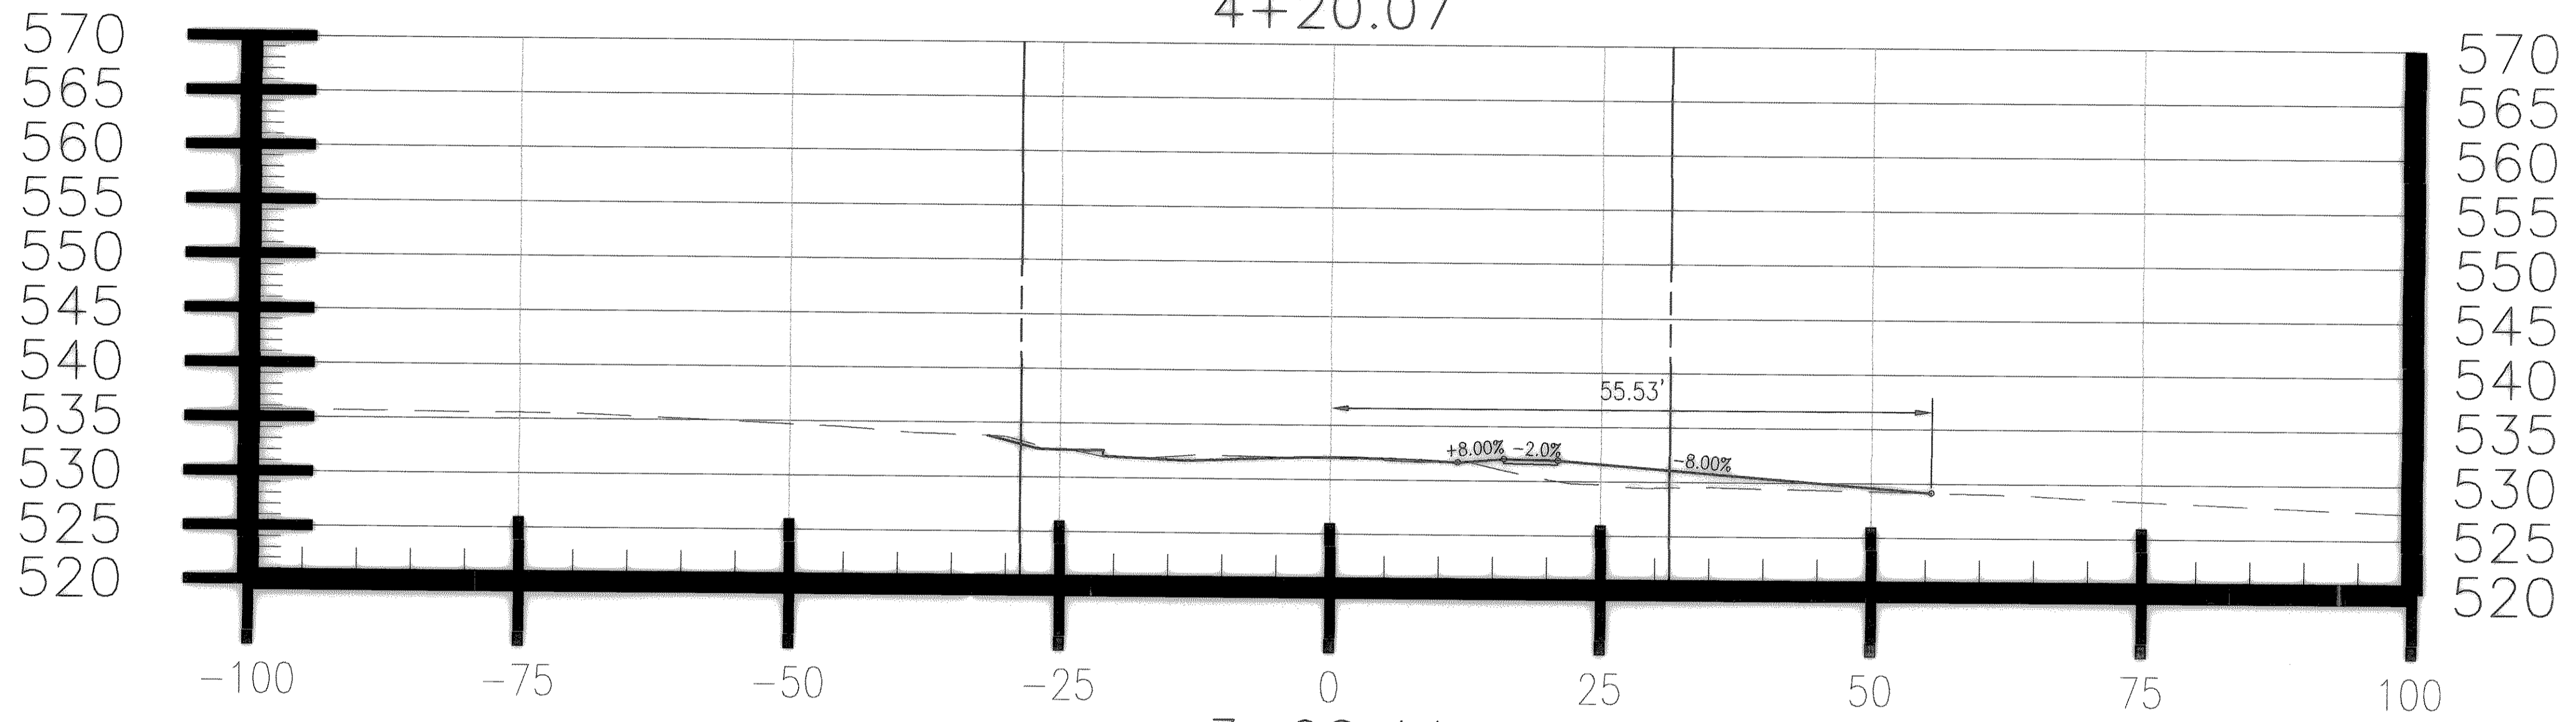

3+90.44

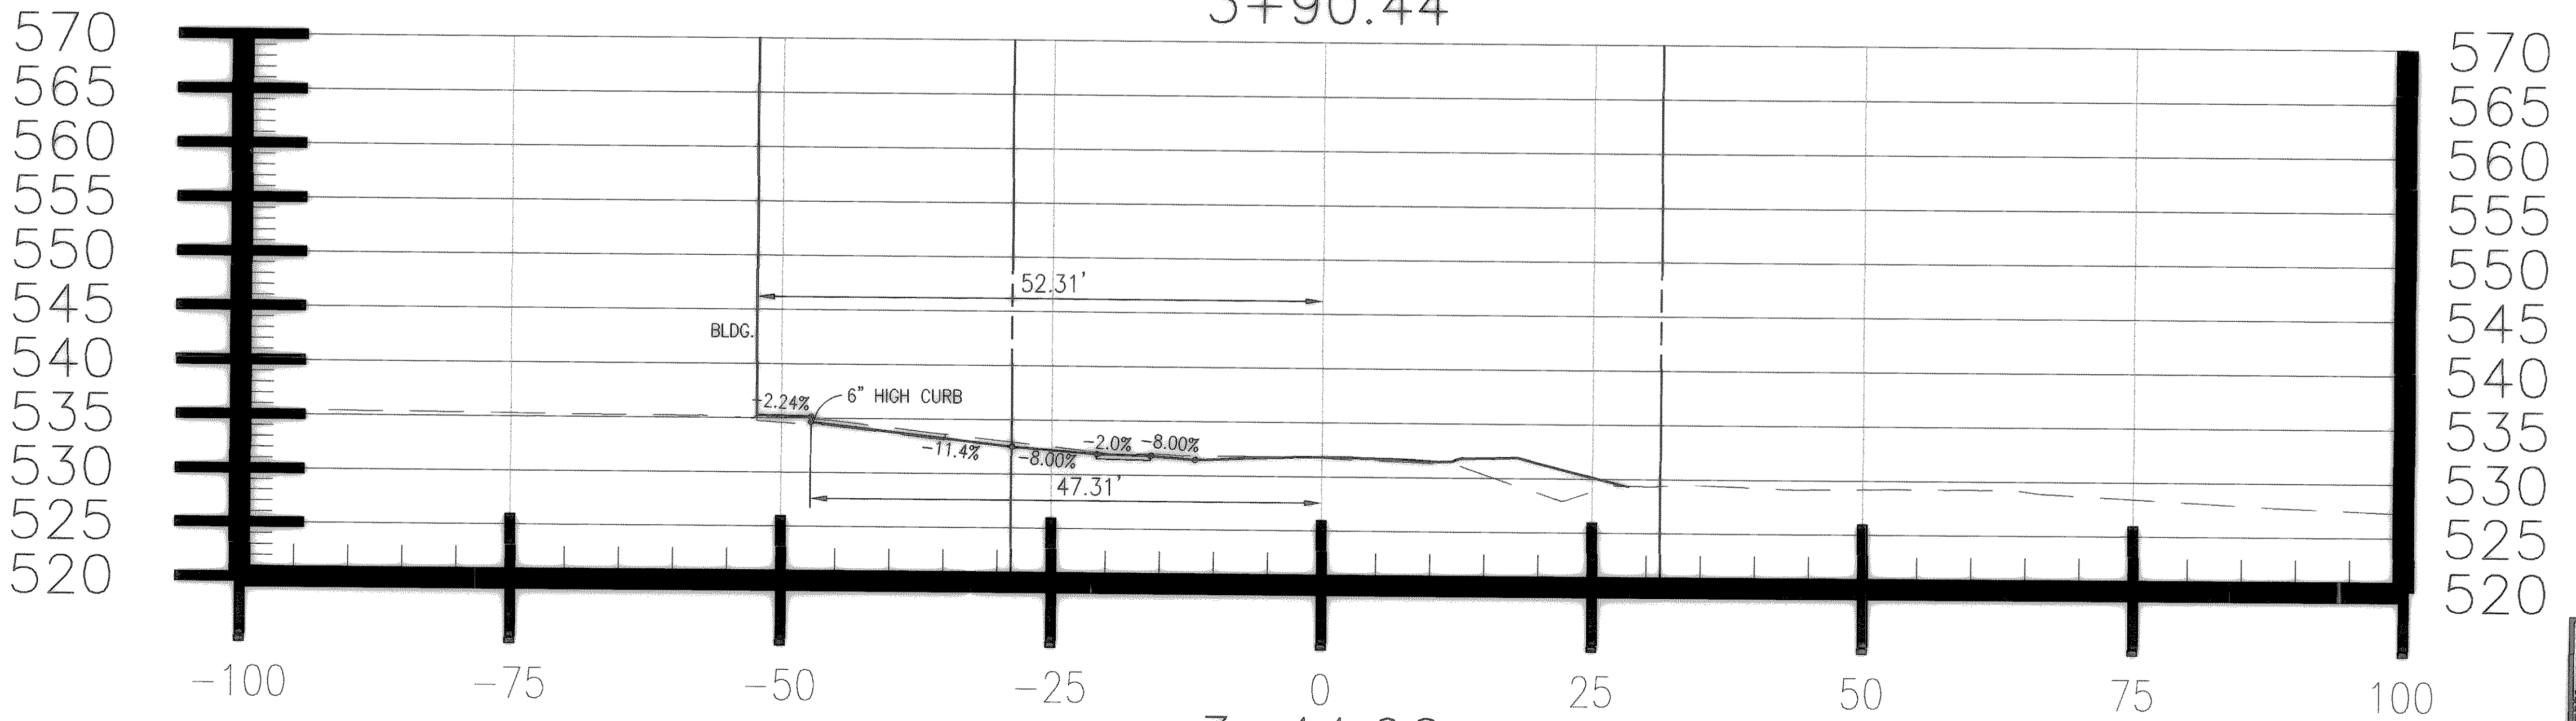


3+44.96

REVISED TO CONFORM
TO CONSTRUCTION RECORDS
BY M.H. DATE 12/04/2006

These plans and related specifications were prepared for construction of this specific project only. Reuse of these documents is not permitted without written authorization of Birkhoff, Hendricks & Conway, L.L.P.

THESE DOCUMENTS ARE FOR
BIDDING, CONSTRUCTION,
AND PERMIT PURPOSES.
Matthew Hickey
DATE: 8/6/04

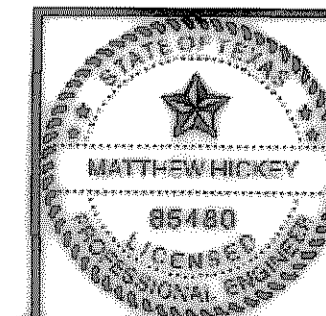

CITY OF ROCKWALL, TEXAS	
CLARK STREET DRIVEWAY CROSS SECTIONS	
BIRKHOFF, HENDRICKS & CONWAY, L.L.P. CONSULTING ENGINEERS <small>Dallas, Texas</small>	
DESIGNED BY: <u>M.H.</u>	PROJECT: <u>2003-120</u>
DRAWN BY: <u>B.H.C.</u>	DATE: <u>AUGUST, 2004</u>
SHEET NO. 141 OF SHEETS	