




08/05/04 LBS H:\ROCKWALL\2003120\ROADS\MAIN-DWAY-PROF.DWG SCALE: 1"=10' XREF: X

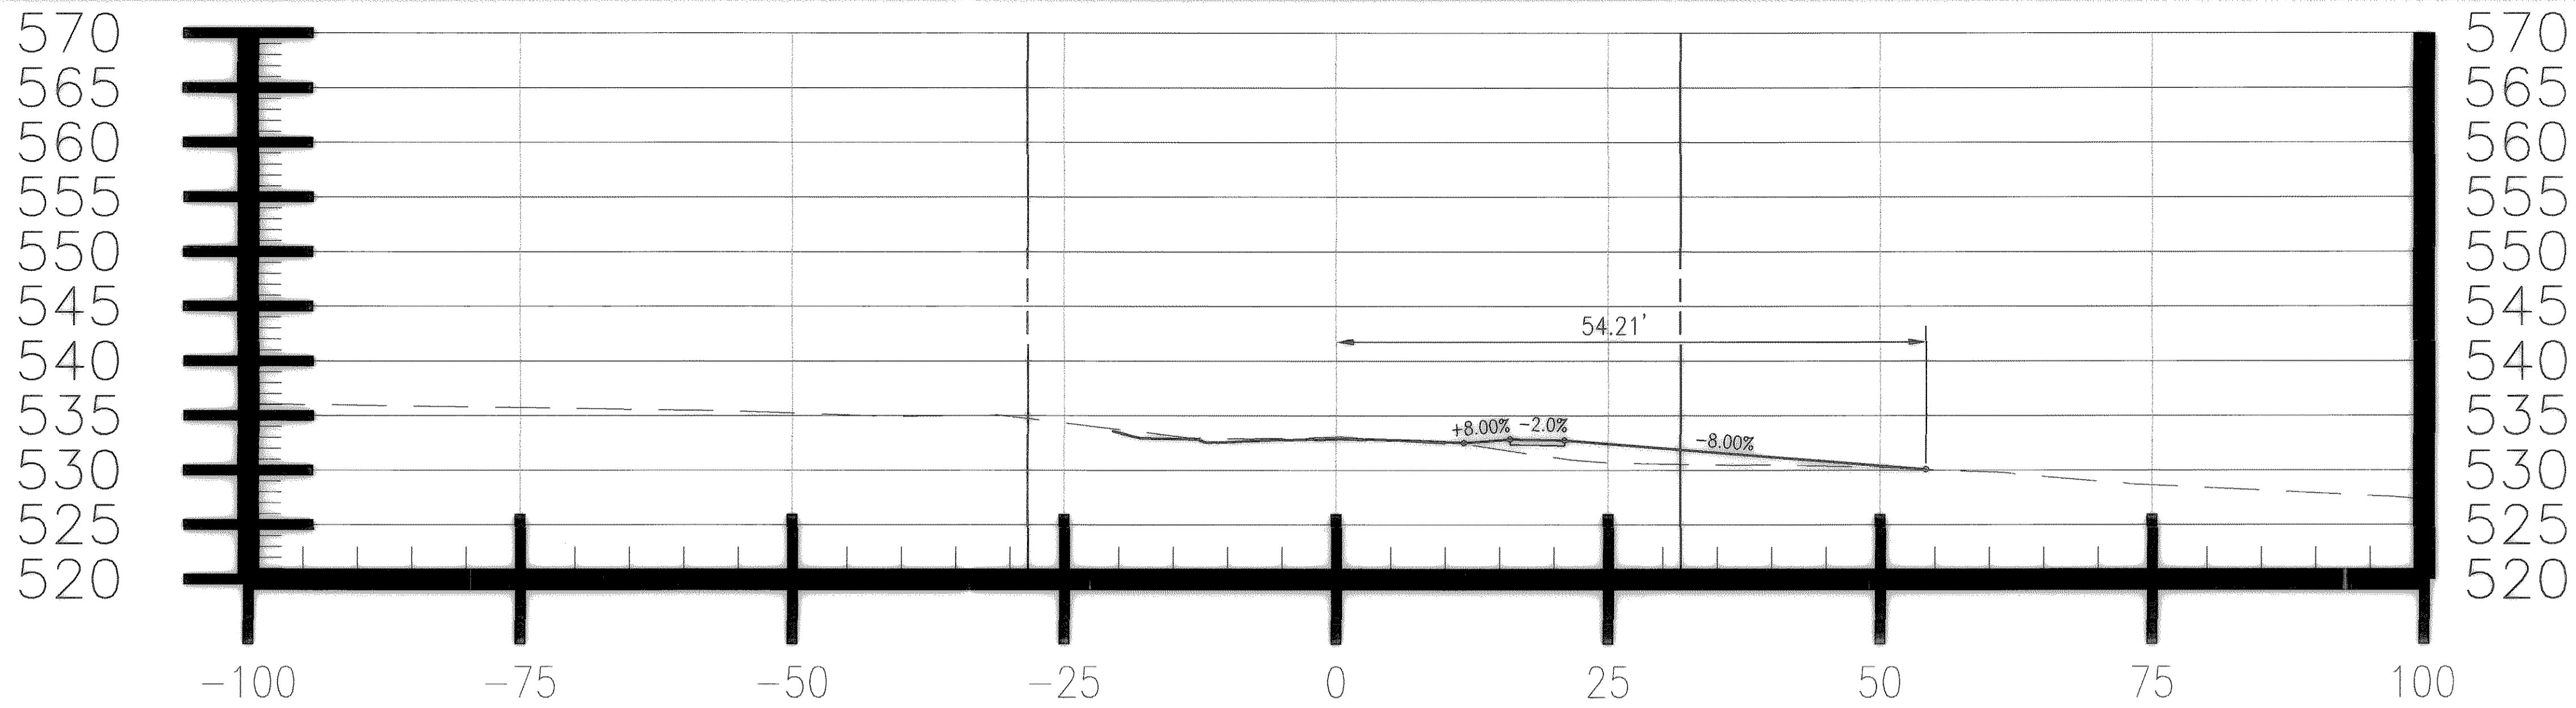

5+52.72

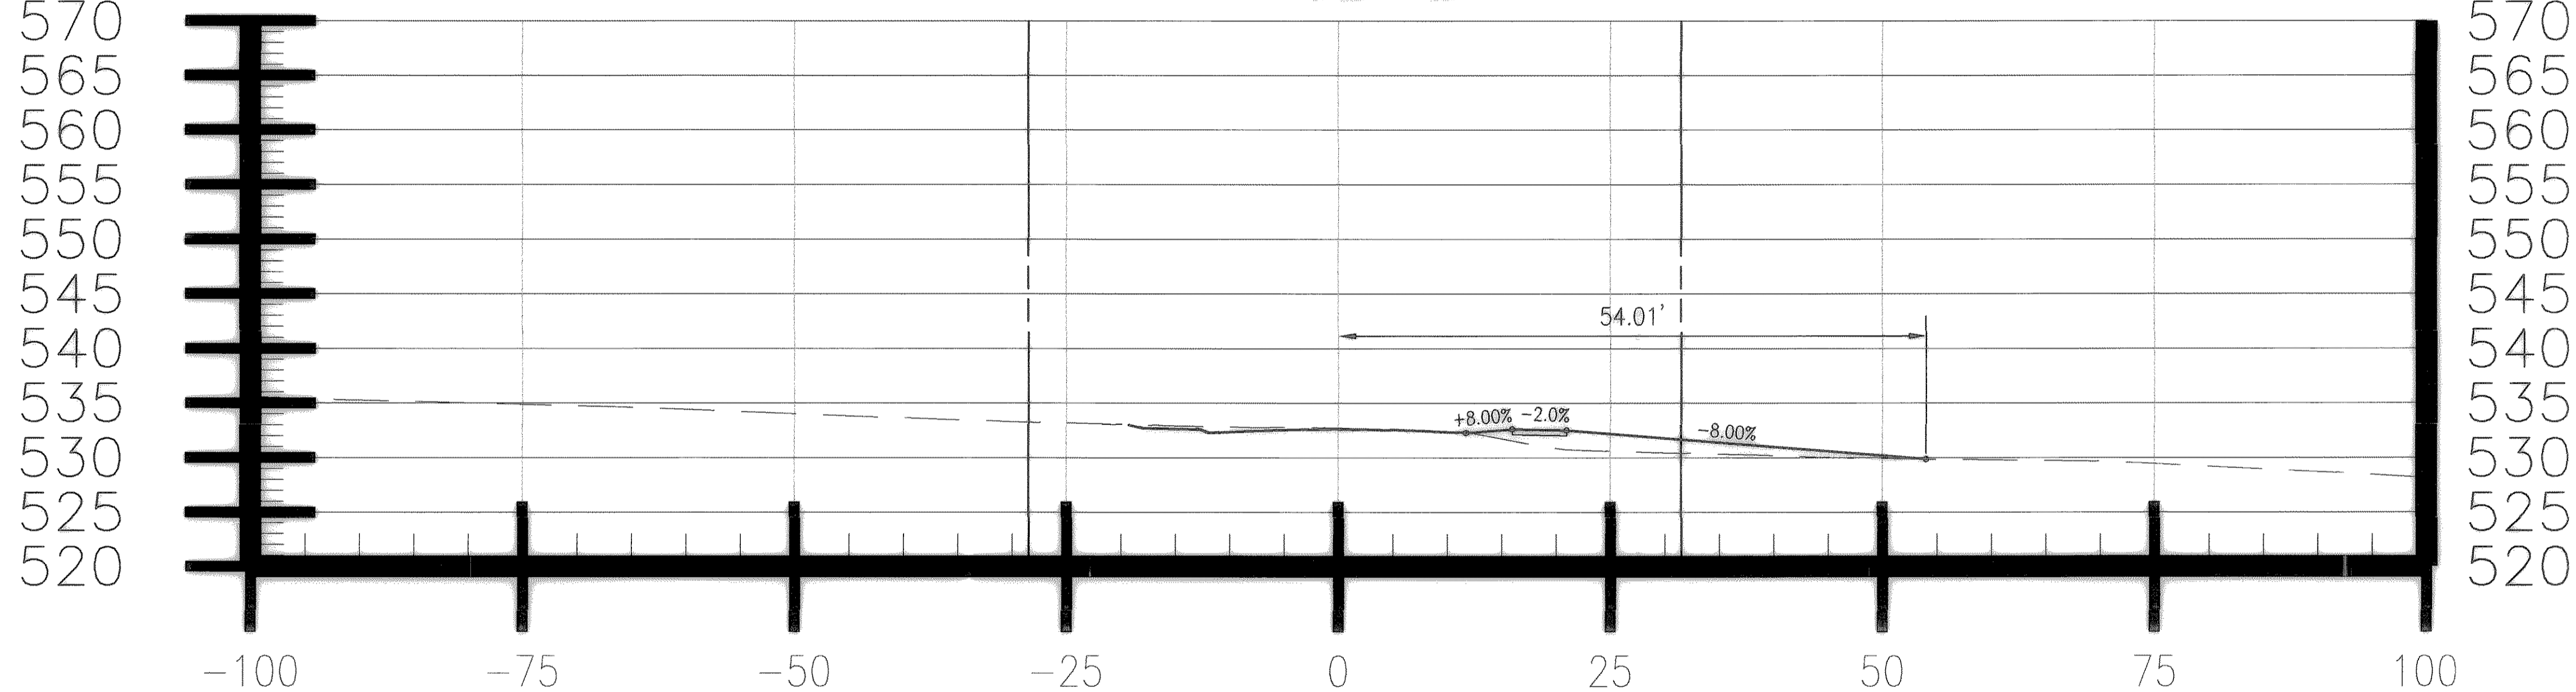

5+07.34

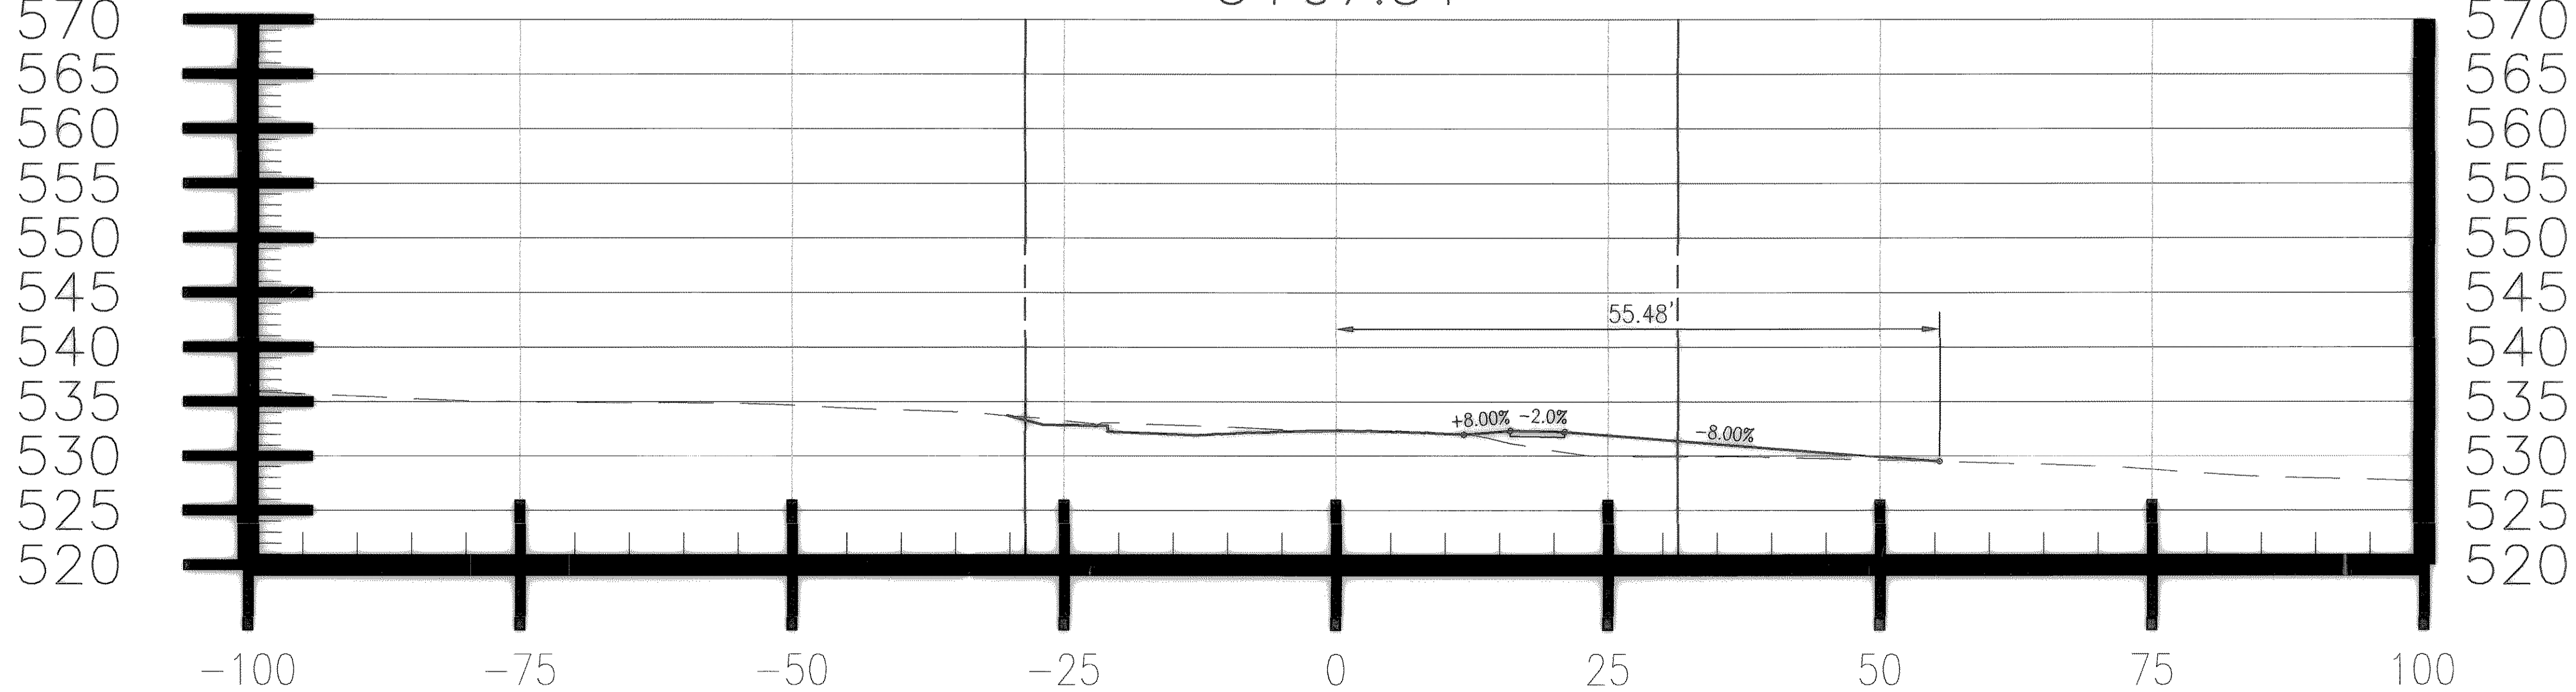

4+51.66


REVISED TO CONFORM TO CONSTRUCTION RECORDS BY M.H. DATE 12/04/2006

These plans and related specifications were prepared for construction of this specific project only. Reuse of these documents is not permitted without written authorization of Birkhoff, Hendricks & Conway, L.L.P.

THESE DOCUMENTS ARE FOR BIDDING, CONSTRUCTION, AND PERMIT PURPOSES. Matthew Hickey DATE: 8/6/04

CITY OF ROCKWALL, TEXAS
CLARK STREET
DRIVEWAY CROSS SECTIONS

BIRKHOFF, HENDRICKS & CONWAY, L.L.P.
CONSULTING ENGINEERS
Dallas, Texas

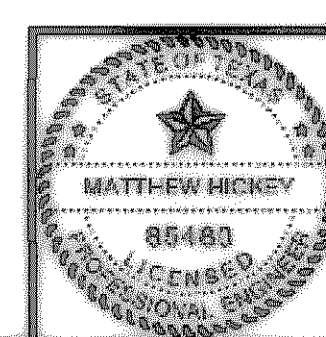

DESIGNED BY: M.H.	PROJECT: 2003-120	SHEET NO. 142
DRAWN BY: B.H.C.	DATE: AUGUST, 2004	OF SHEETS