




08/05/04 LBS H:\ROCKWALL\2003\20\INROADS\MAIN-DWAY-PROF.DWG SCALE: 1"=10' XREF: X

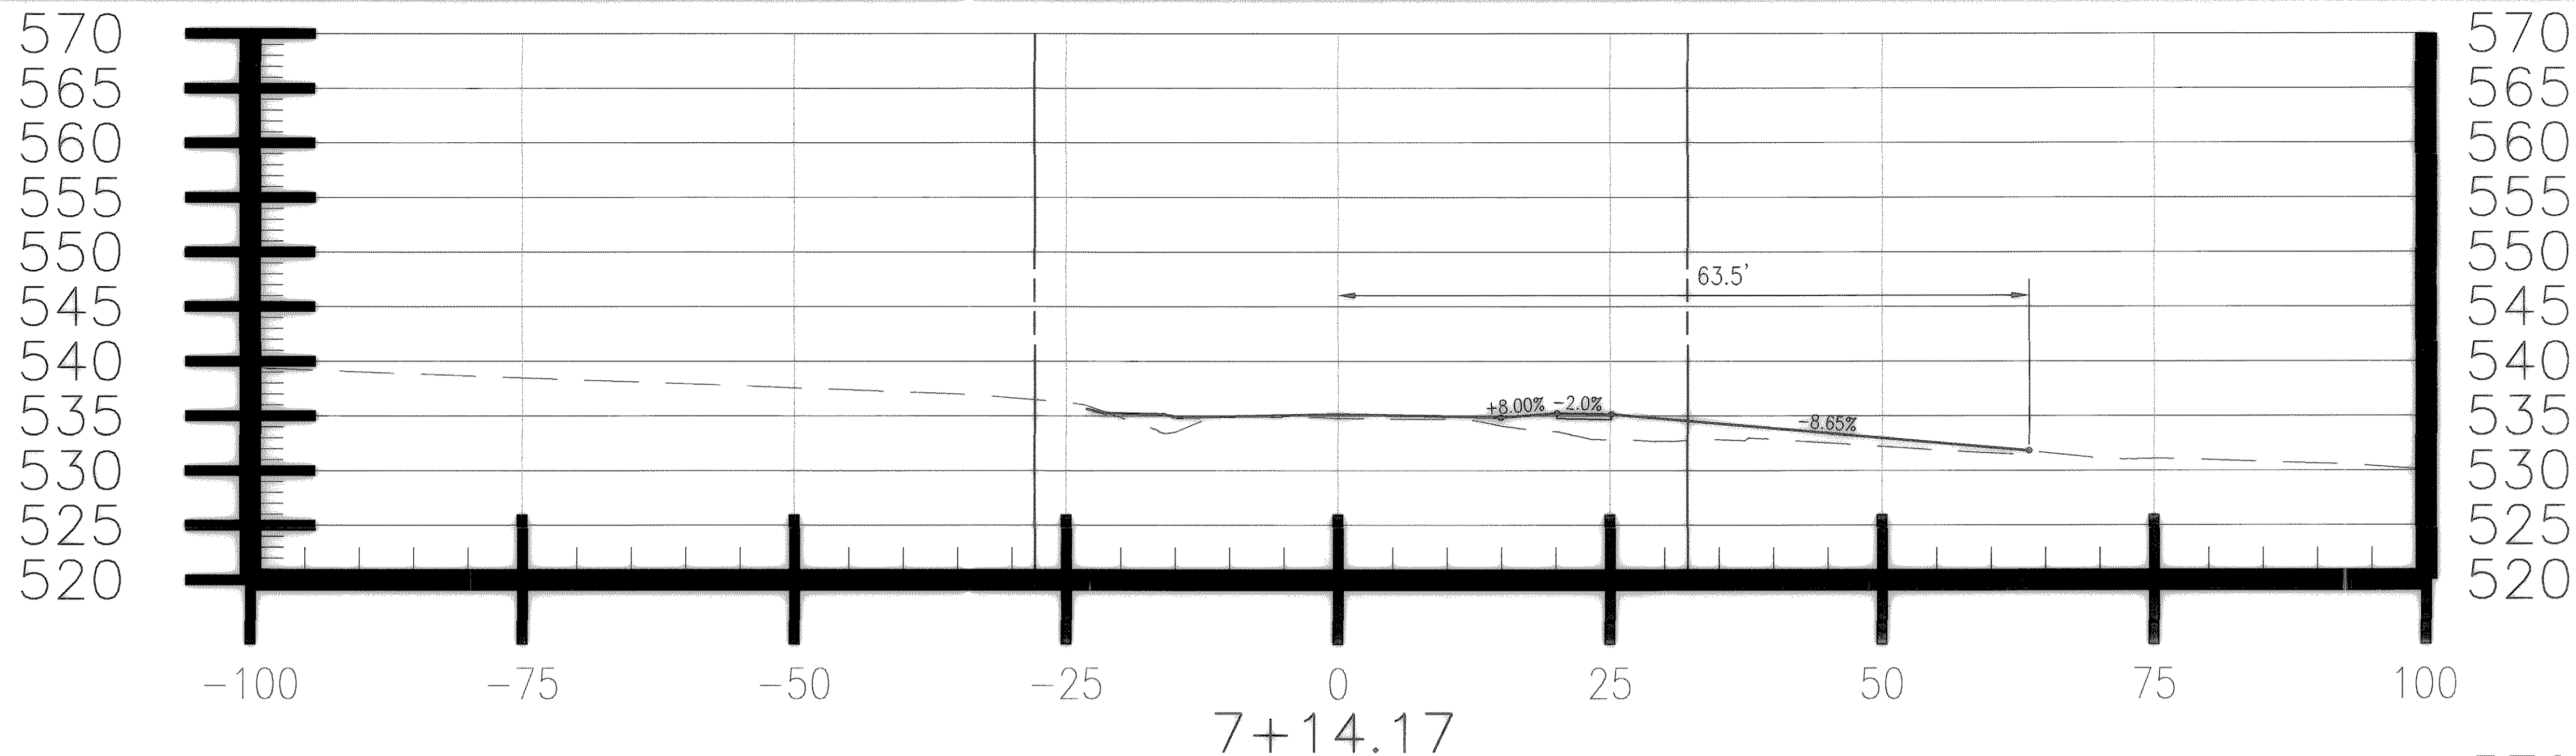

7+14.17

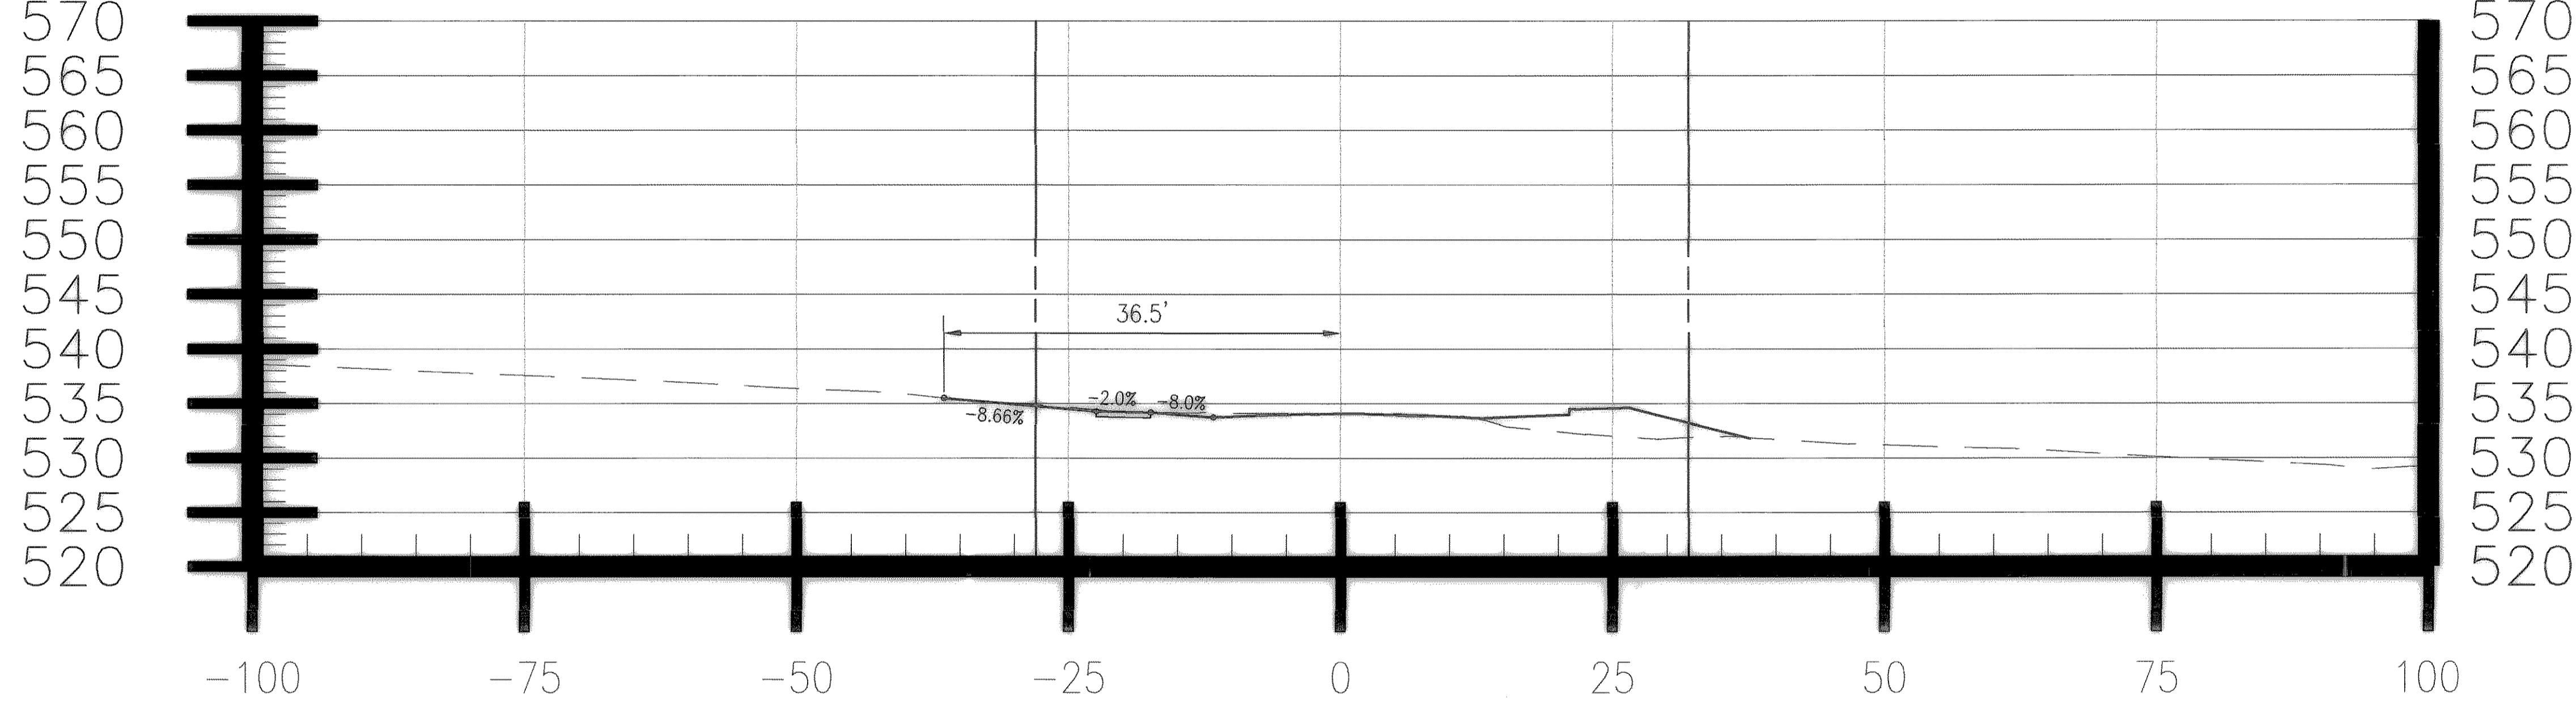

6+67.54

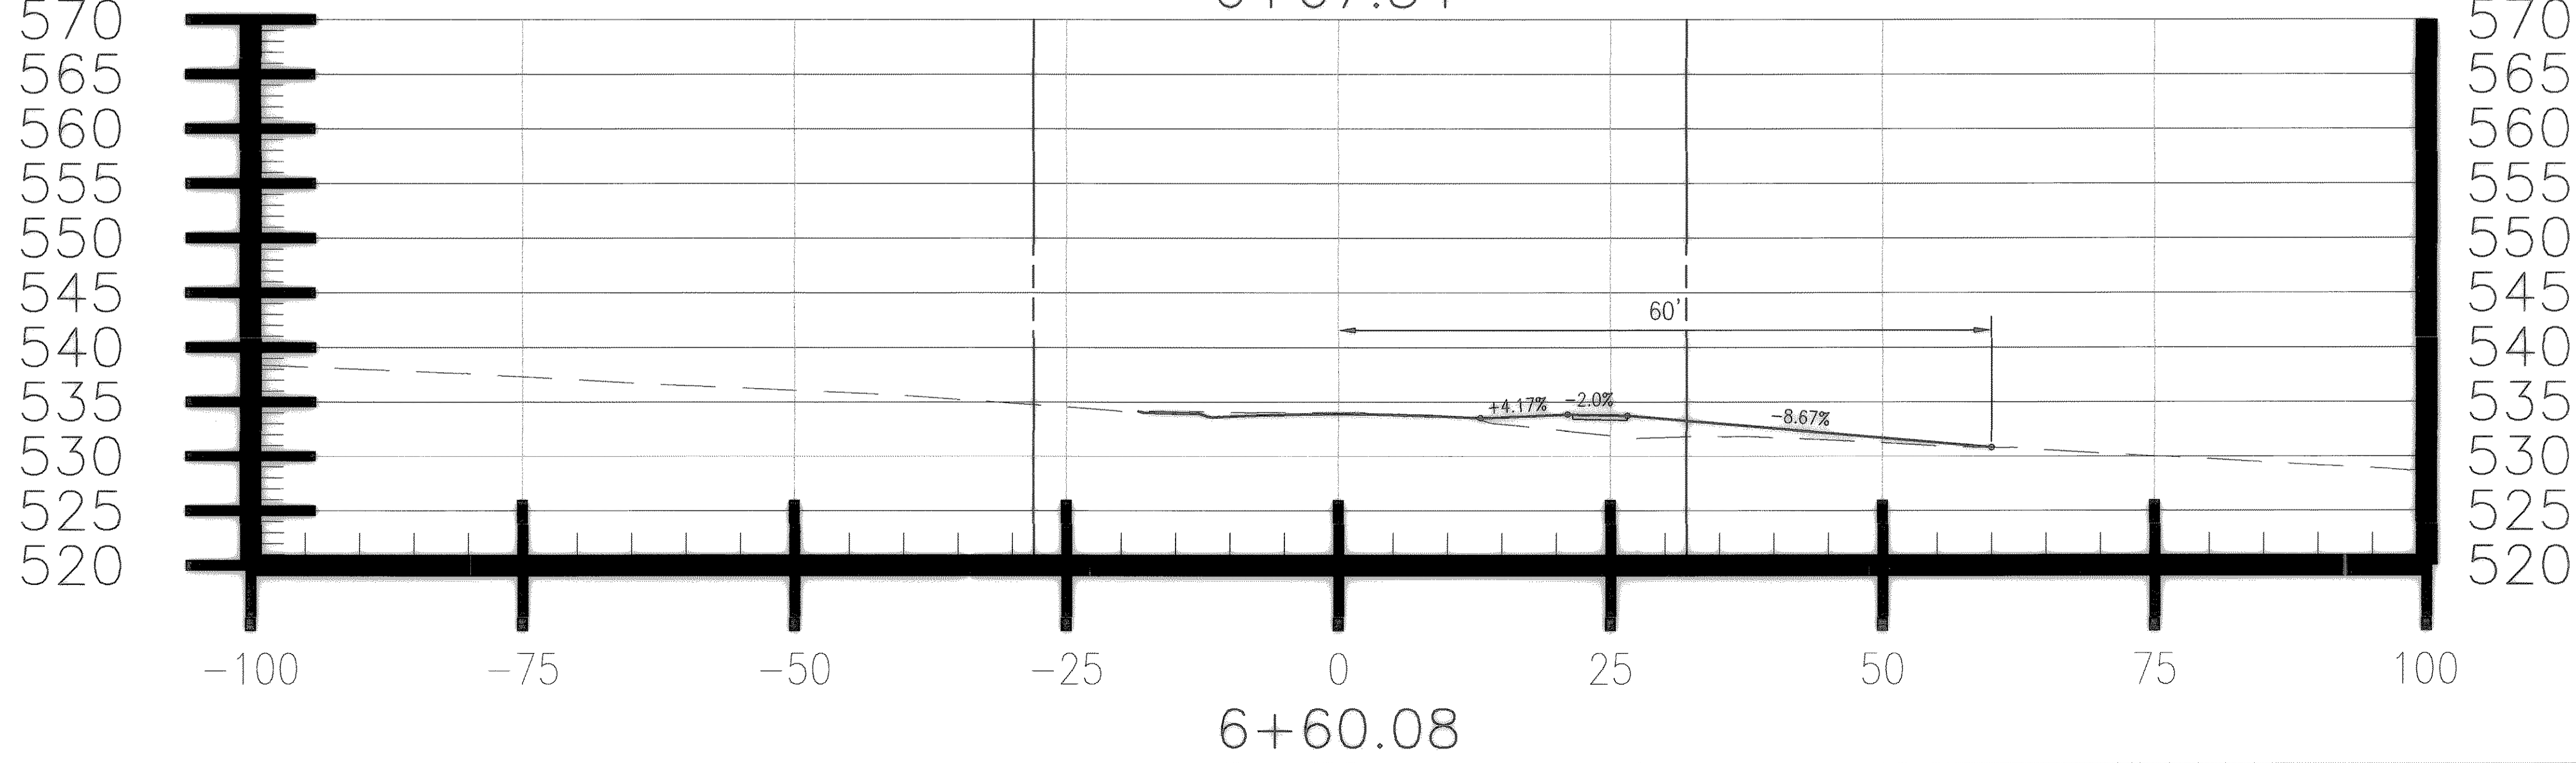

6+60.08


REVISED TO CONFORM  
 TO CONSTRUCTION RECORDS  
 BY M.H. DATE 12/04/2006

These plans and related specifications  
 were prepared for construction of this  
 specific project only. Reuse of these  
 documents is not permitted without  
 written authorization of Birkhoff,  
 Hendricks & Conway, L.L.P.

THESE DOCUMENTS ARE FOR  
 BIDDING, CONSTRUCTION,  
 AND PERMIT PURPOSES.  
 DATE: 8/6/04

**CITY OF ROCKWALL, TEXAS**  
**CLARK STREET**  
**DRIVEWAY CROSS SECTIONS**

**BIRKHOFF, HENDRICKS & CONWAY, L.L.P.**  
 CONSULTING ENGINEERS  
 Dallas, Texas

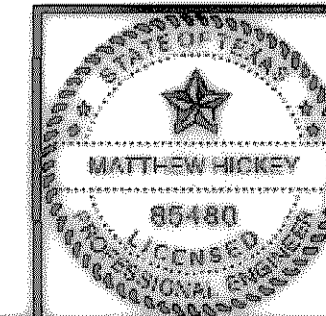

DESIGNED BY: M.H.	PROJECT: 2003-120	SHEET NO. 143
DRAWN BY: B.H.C.	DATE: AUGUST, 2004	OF SHEETS