



12+14.29

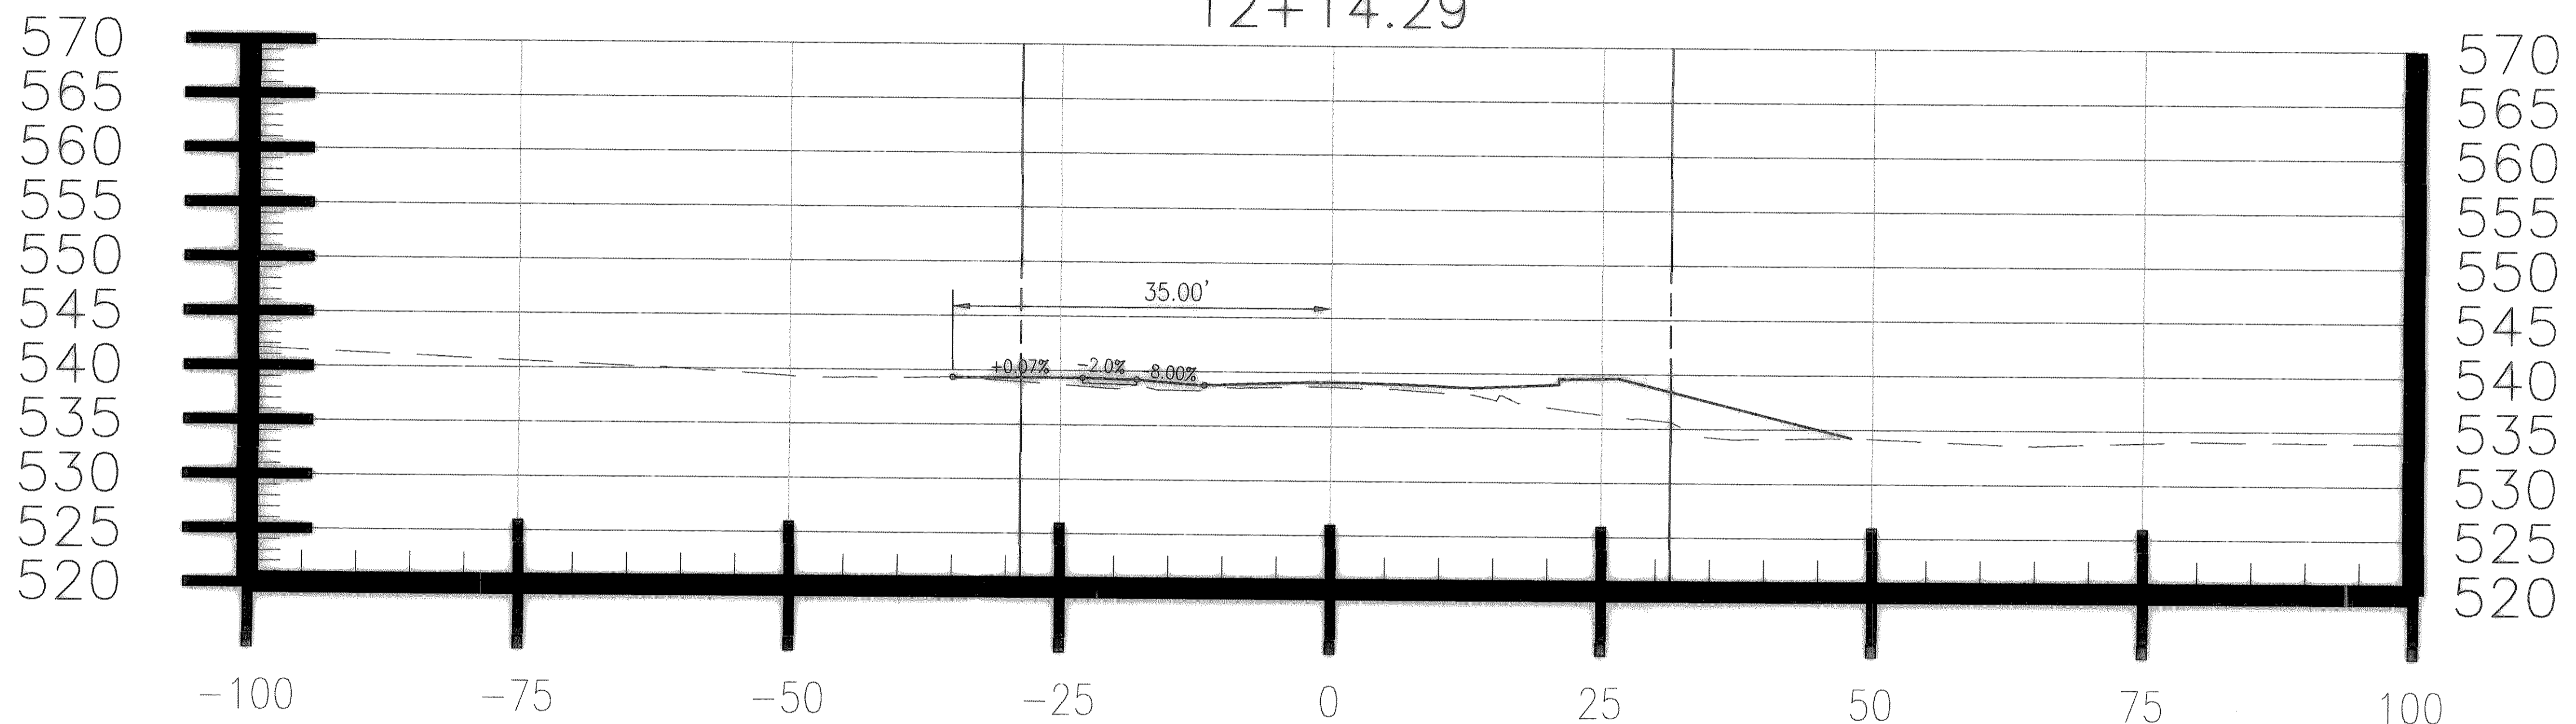

11+24.20

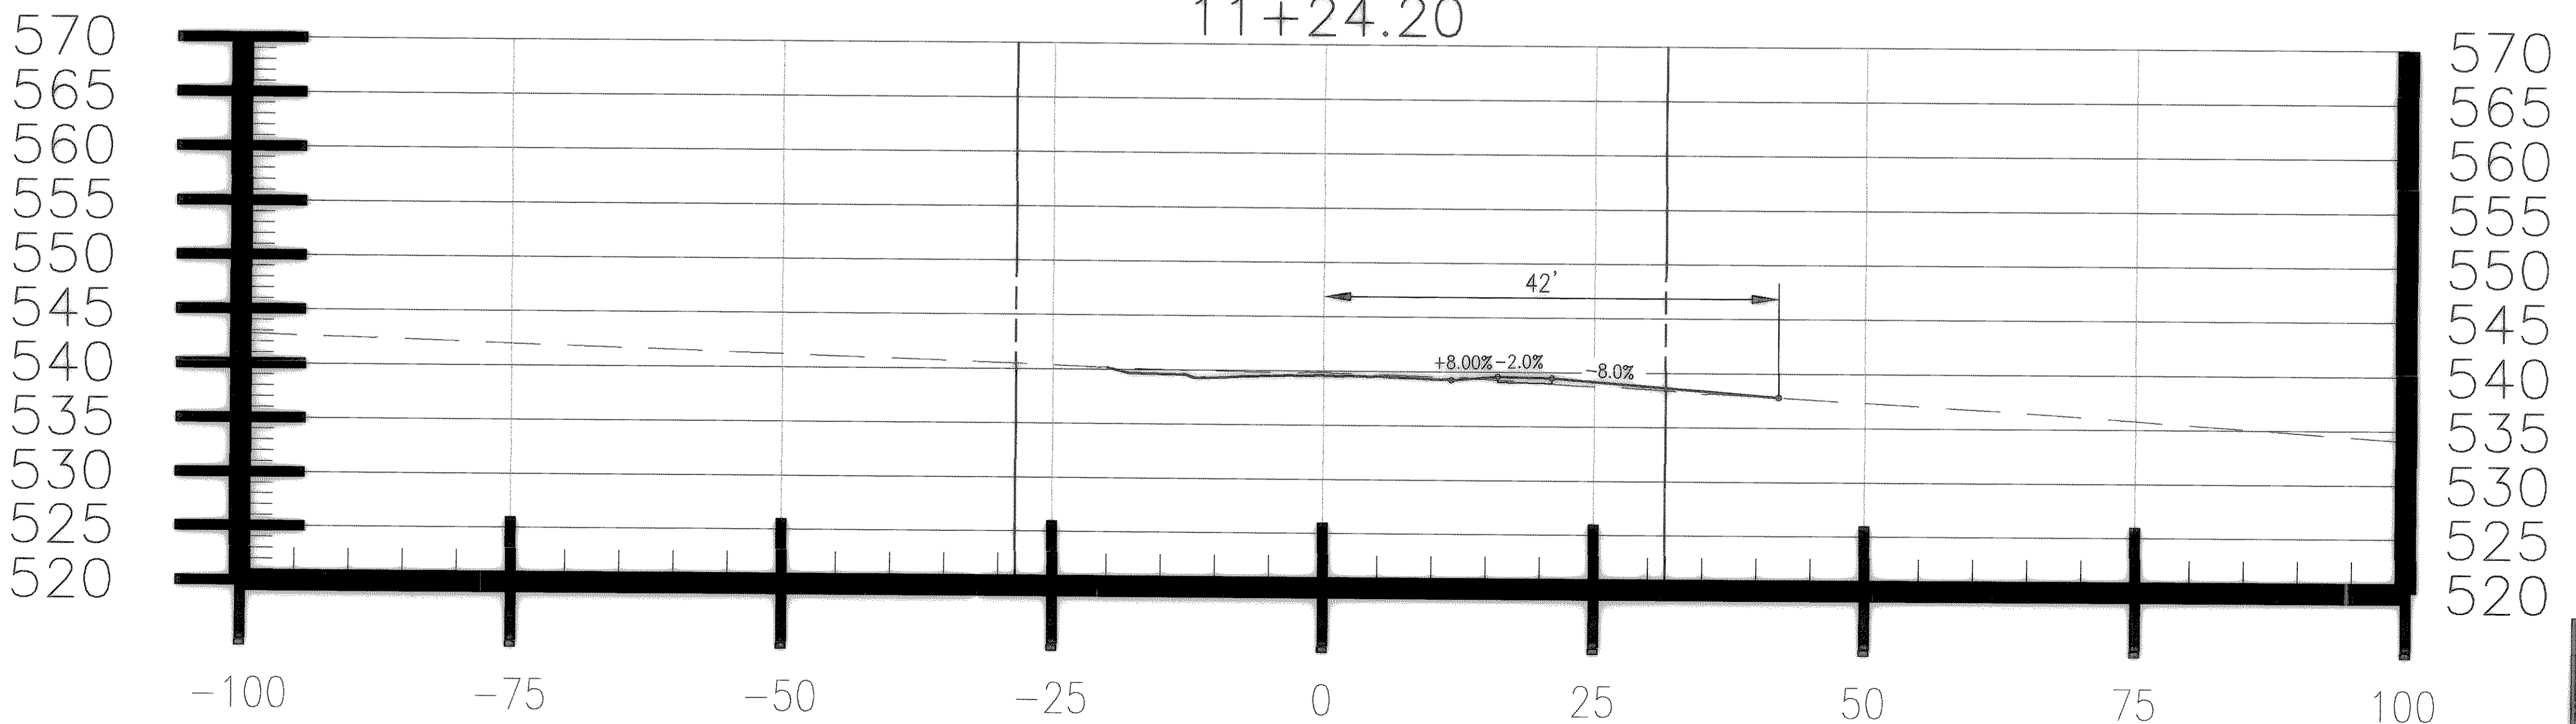

9+76.72


REVISED TO CONFORM
TO CONSTRUCTION RECORDS
BY M.H. DATE 12/04/2006

These plans and related specifications were prepared for construction of this specific project only. Reuse of these documents is not permitted without written authorization of Birkhoff, Hendricks & Conway, L.L.P.

THESE DOCUMENTS ARE FOR BIDDING, CONSTRUCTION, AND PERMIT PURPOSES.
Matthew Hickey
DATE: 2/16/04

CITY OF ROCKWALL, TEXAS
CLARK STREET
DRIVEWAY CROSS SECTIONS

BIRKHOFF, HENDRICKS & CONWAY, L.L.P.
CONSULTING ENGINEERS
Dallas, Texas

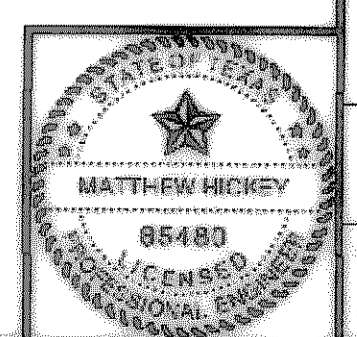

DESIGNED BY: <u>M.H.</u>	PROJECT: <u>2003-120</u>	SHEET NO. <u>145</u>
DRAWN BY: <u>B.H.C.</u>	DATE: <u>AUGUST, 2004</u>	OF <u>145</u> SHEETS

08/05/04 LBS H:\ROCKWALL\2003120\INROADS\MAIN-DWAY-PROF.DWG SCALE: 1"=10' XREF: X