




H:\ROCKWALL\2003120\ROADS\MAIN-DWA-PROF.DWG SCALE: 1"=10' XREF: X  
 08/05/04 LBS

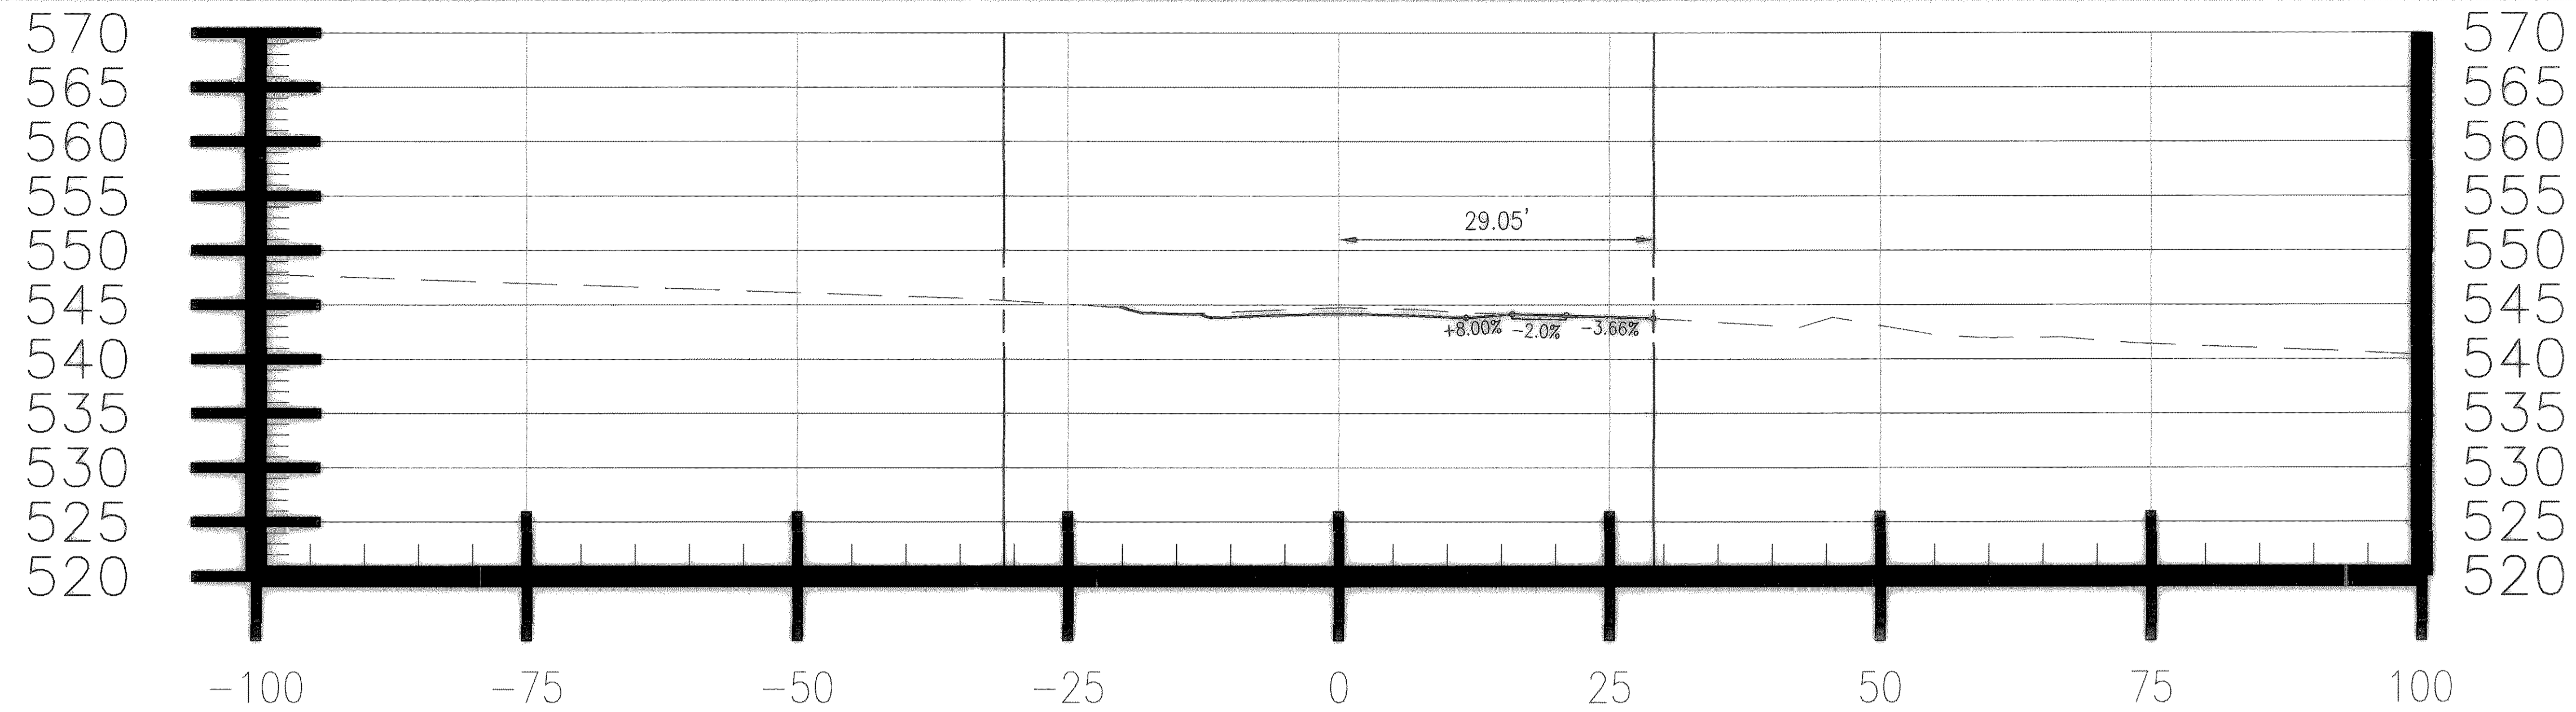

18+24.63

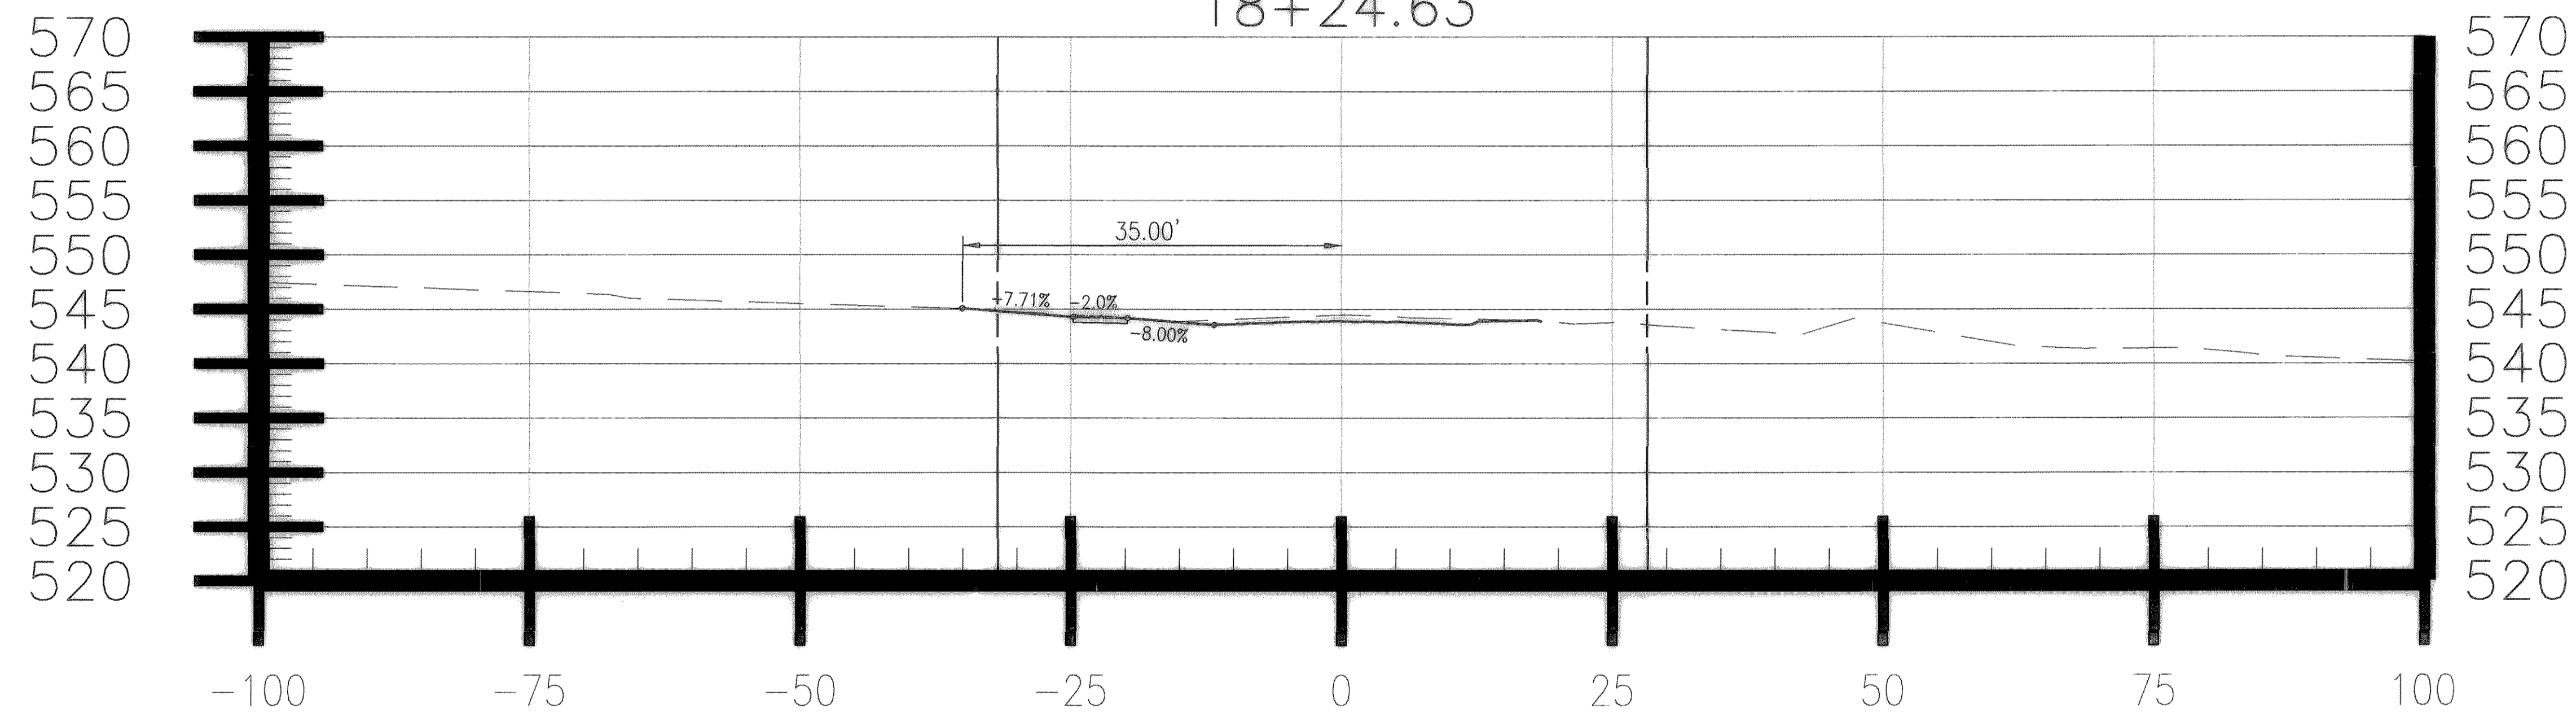

18+13.69

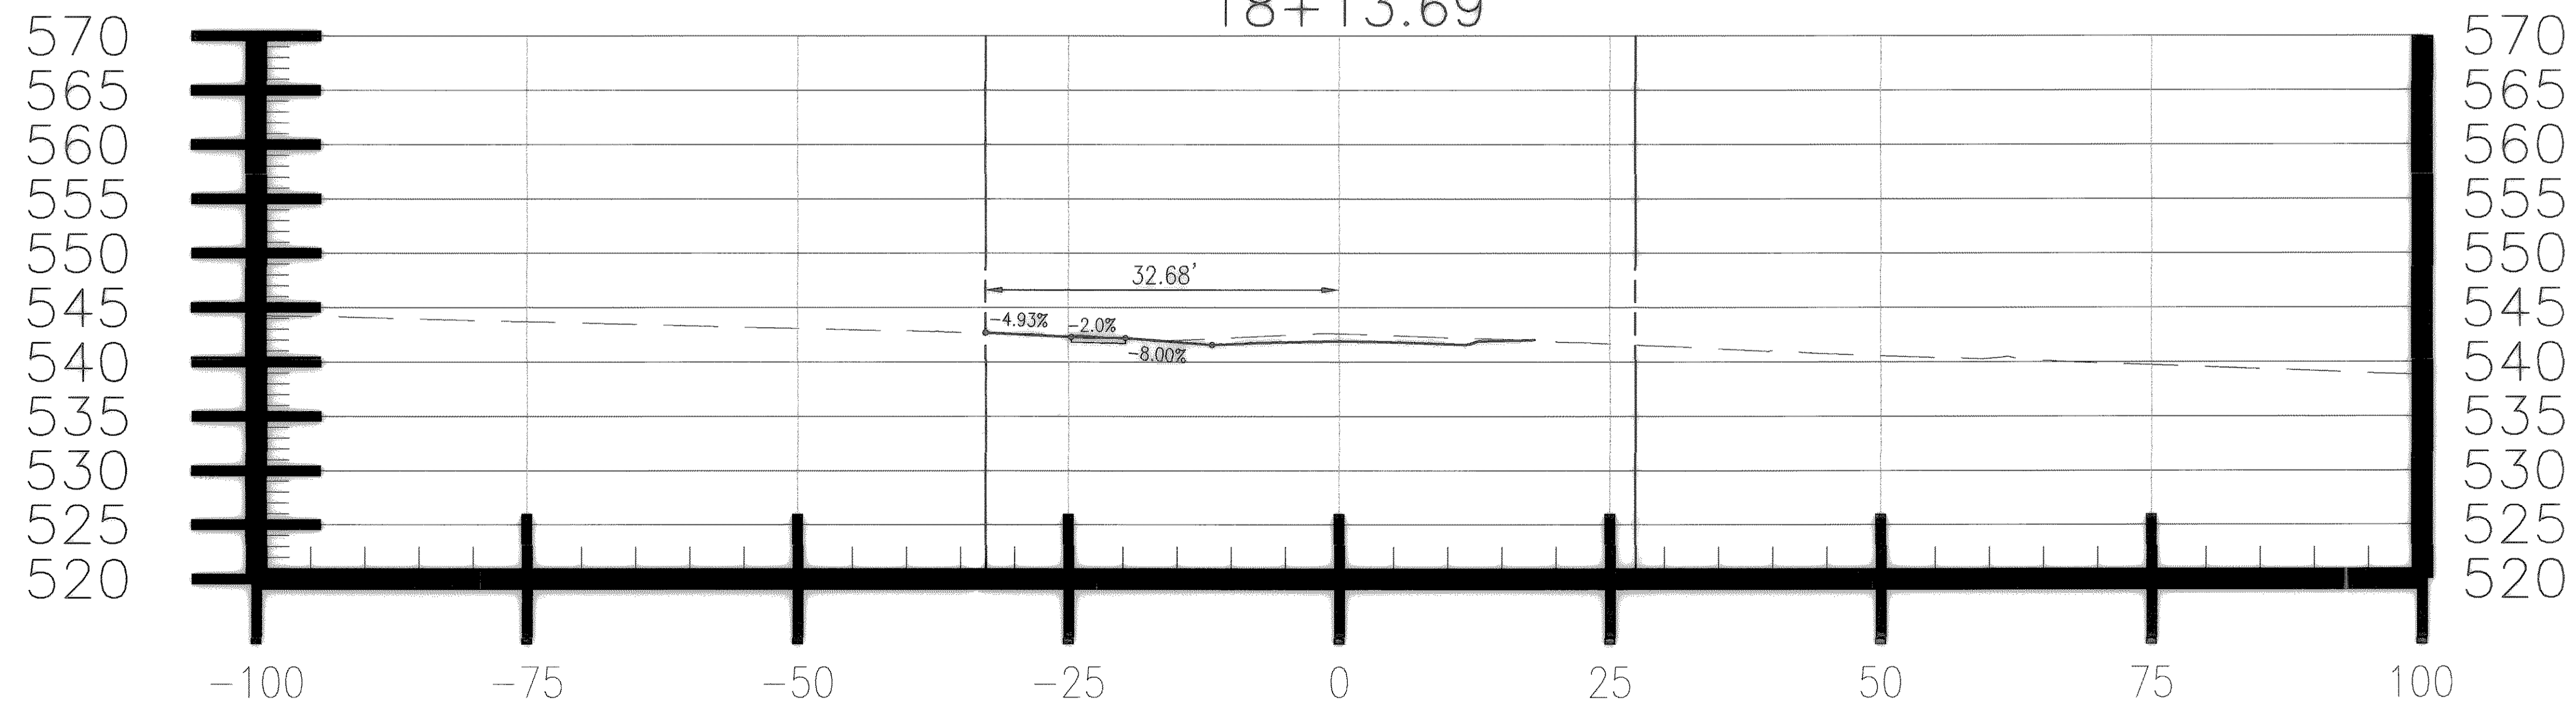

1749.62


REVISED TO CONFORM  
 TO CONSTRUCTION RECORDS  
 BY M.H. DATE 12/04/2006

These plans and related specifications  
 were prepared for construction of this  
 specific project only. Reuse of these  
 documents is not permitted without  
 written authorization of Birkhoff,  
 Hendricks & Conway, L.L.P.

THESE DOCUMENTS ARE FOR  
 BIDDING, CONSTRUCTION,  
 AND PERMIT PURPOSES.  
*M.H.*  
 DATE: 12/4/06

**CITY OF ROCKWALL, TEXAS**  
**CLARK STREET**  
**DRIVEWAY CROSS SECTIONS**

**BIRKHOFF, HENDRICKS & CONWAY, L.L.P.**  
 CONSULTING ENGINEERS  
 Dallas, Texas

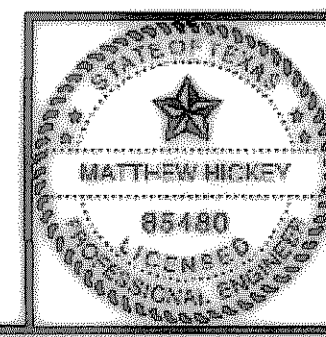

DESIGNED BY: <u>M.H.</u>	PROJECT: <u>2003-120</u>	SHEET NO. <u>148</u>
DRAWN BY: <u>B.H.C.</u>	DATE: <u>AUGUST, 2004</u>	OF <u>      </u> SHEETS