




08/06/04 LBS H:\ROCKWALL\2003120\INFRASTRUCTURE\MAIN-DWAY-PROF.DWG SCALE: 1"=10' XREF: X

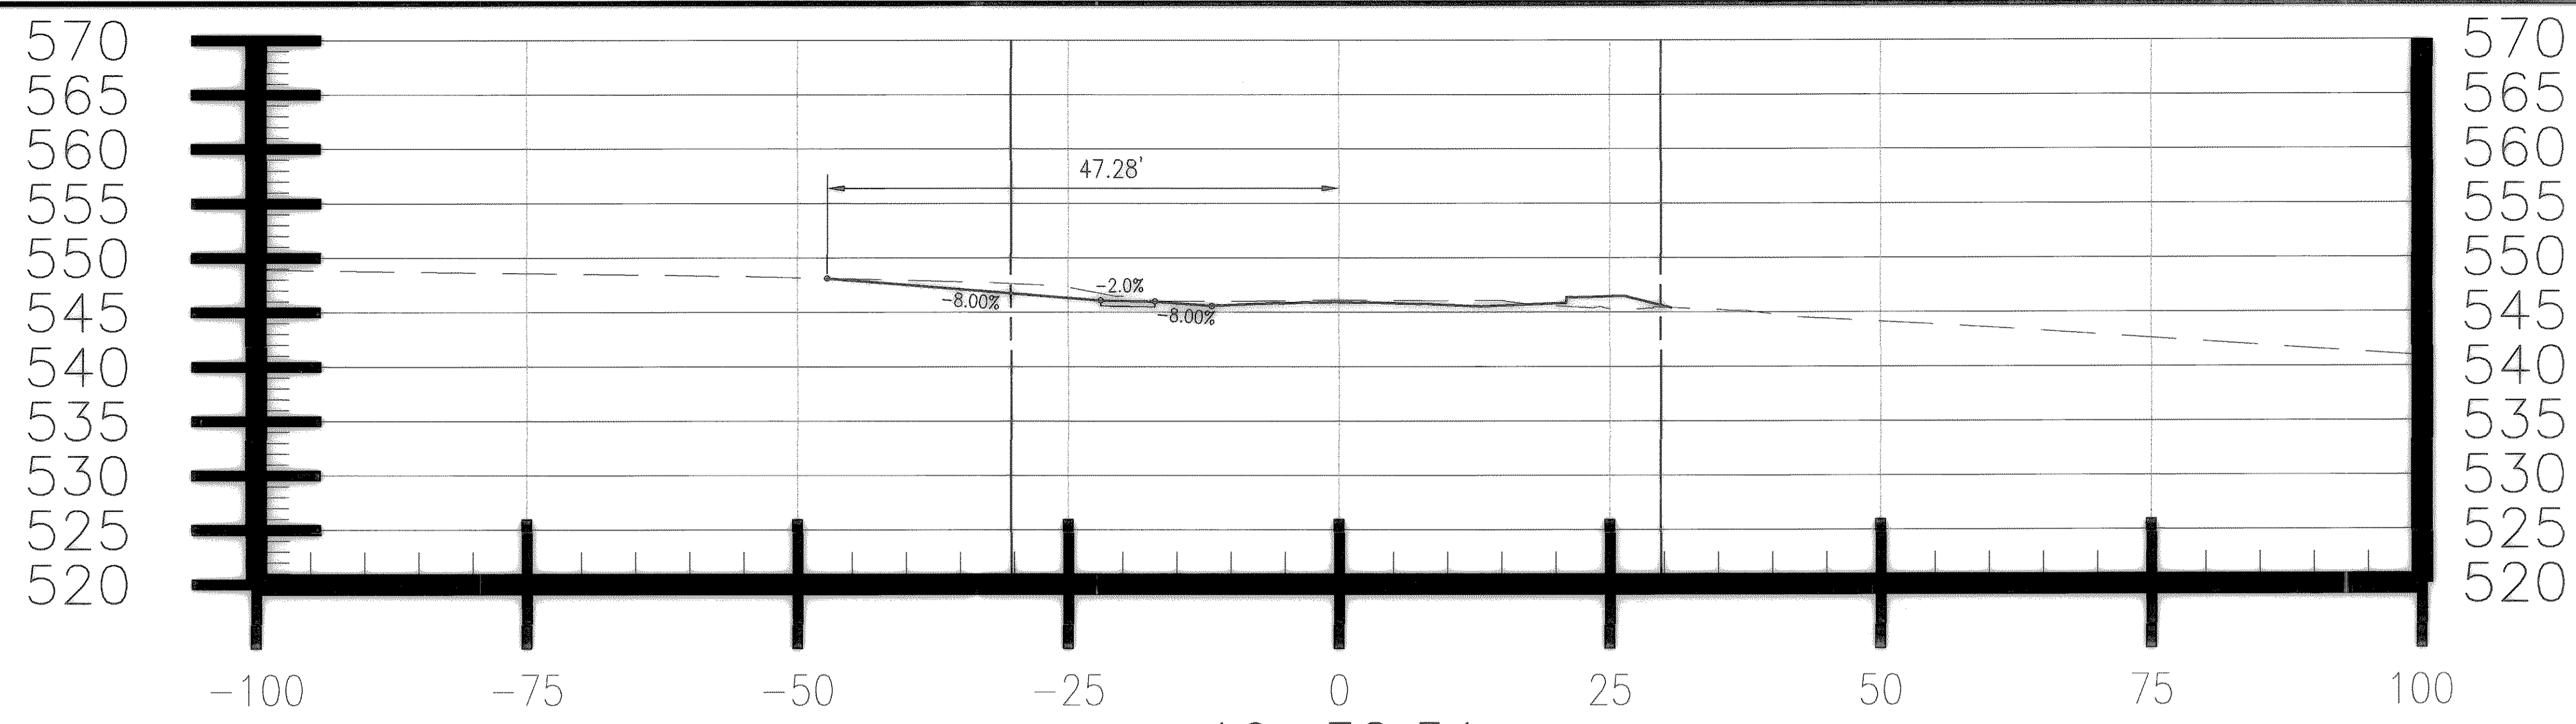

19+32.51

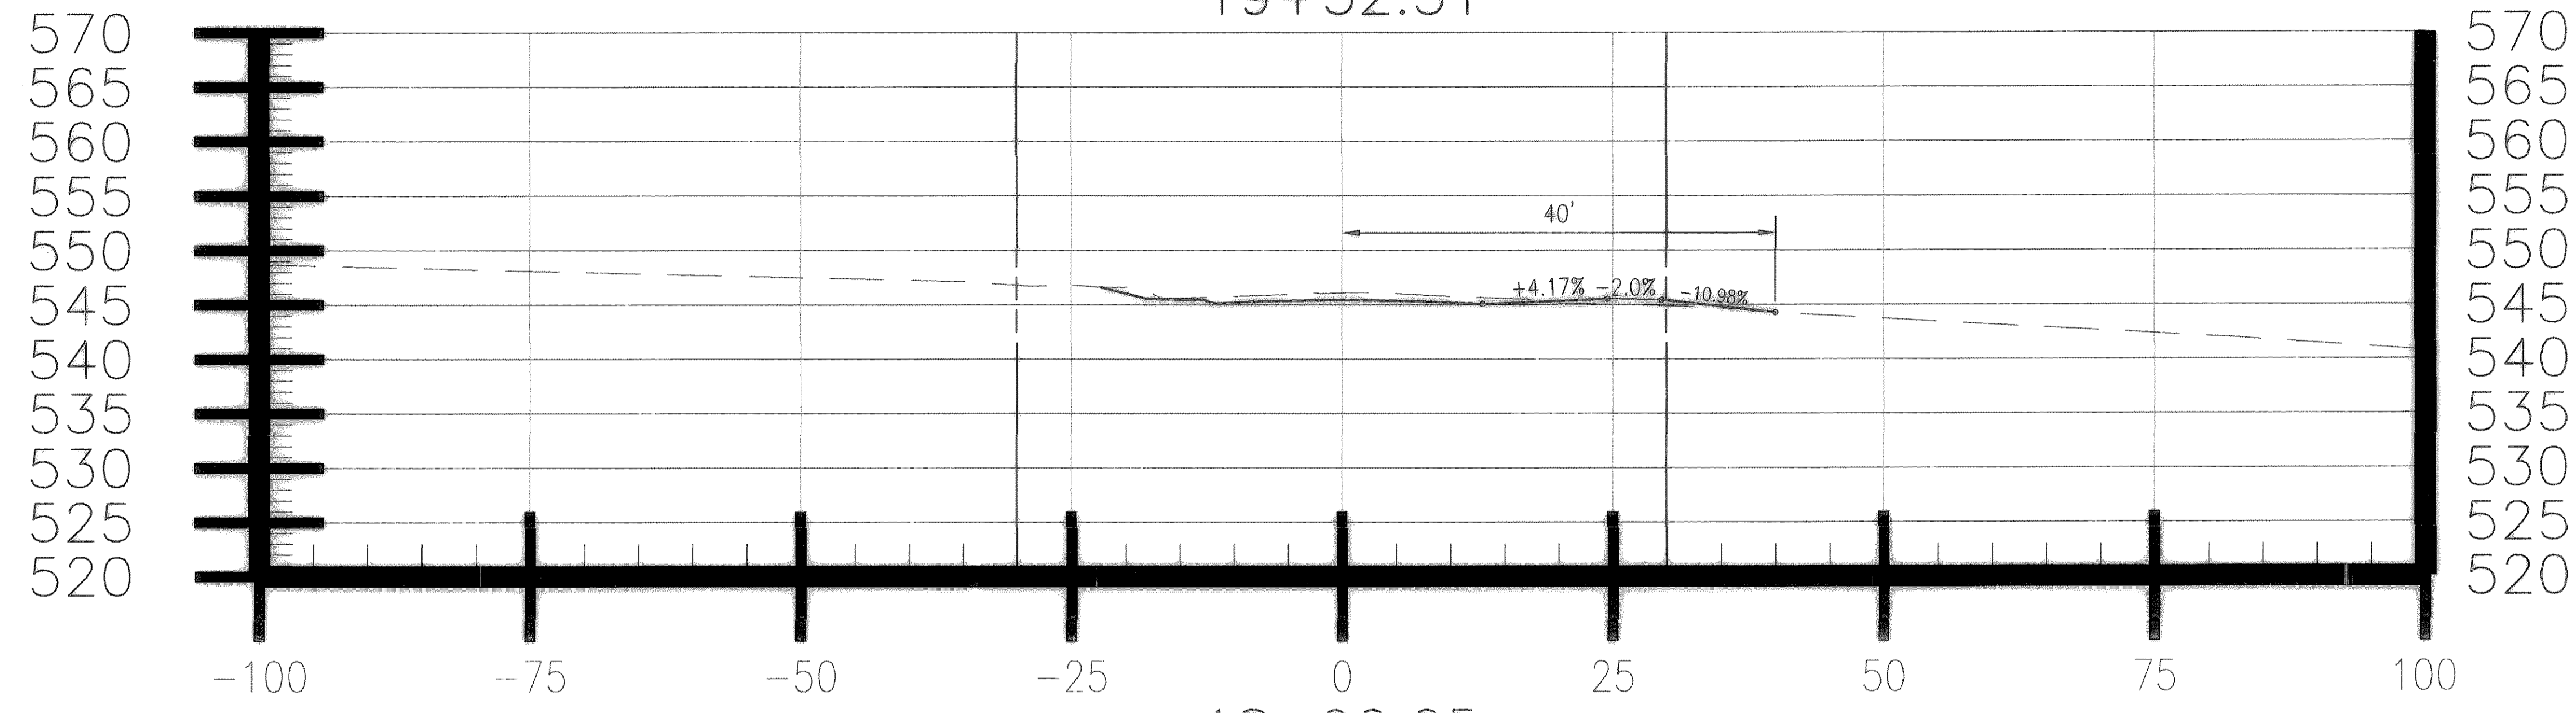

18+90.05

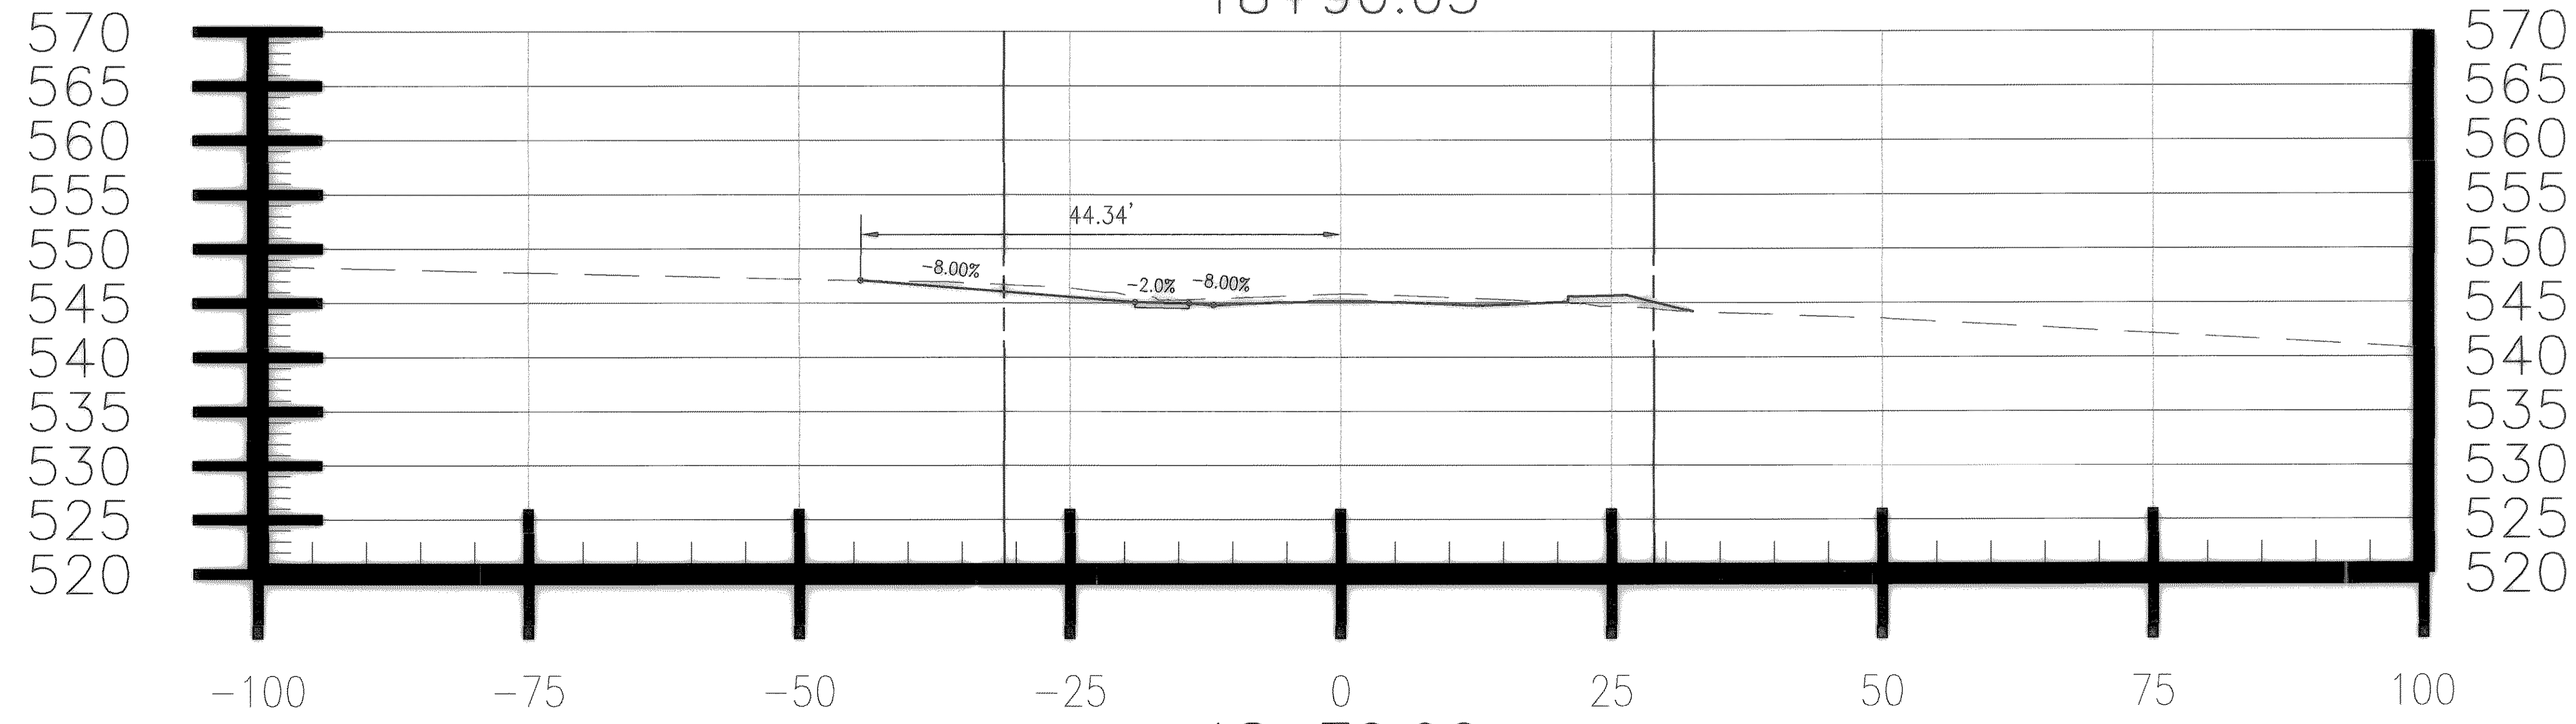

18+70.96


REVISED TO CONFORM TO CONSTRUCTION RECORDS
BY M.H. DATE 12/04/2006

These plans and related specifications were prepared for construction of this specific project only. Reuse of these documents is not permitted without written authorization of Birkhoff, Hendricks & Conway, L.L.P.

THESE DOCUMENTS ARE FOR BIDDING, CONSTRUCTION, AND PERMIT PURPOSES.
Matthew Hickey
DATE: 8/6/04

CITY OF ROCKWALL, TEXAS
CLARK STREET
DRIVEWAY CROSS SECTIONS

BIRKHOFF, HENDRICKS & CONWAY, L.L.P.
CONSULTING ENGINEERS
Dallas, Texas

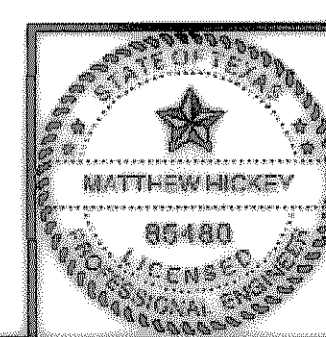

DESIGNED BY: <u>M.H.</u>	PROJECT: <u>2003-120</u>	SHEET NO. <u>149</u>
DRAWN BY: <u>B.H.C.</u>	DATE: <u>AUGUST, 2004</u>	OF <u> </u> SHEETS