




08/05/04 LBS H:\ROCKWALL\2003\20\INFROADS\MAIN-DRAW-PROF.DWG SCALE: 1"=10' XREF: X

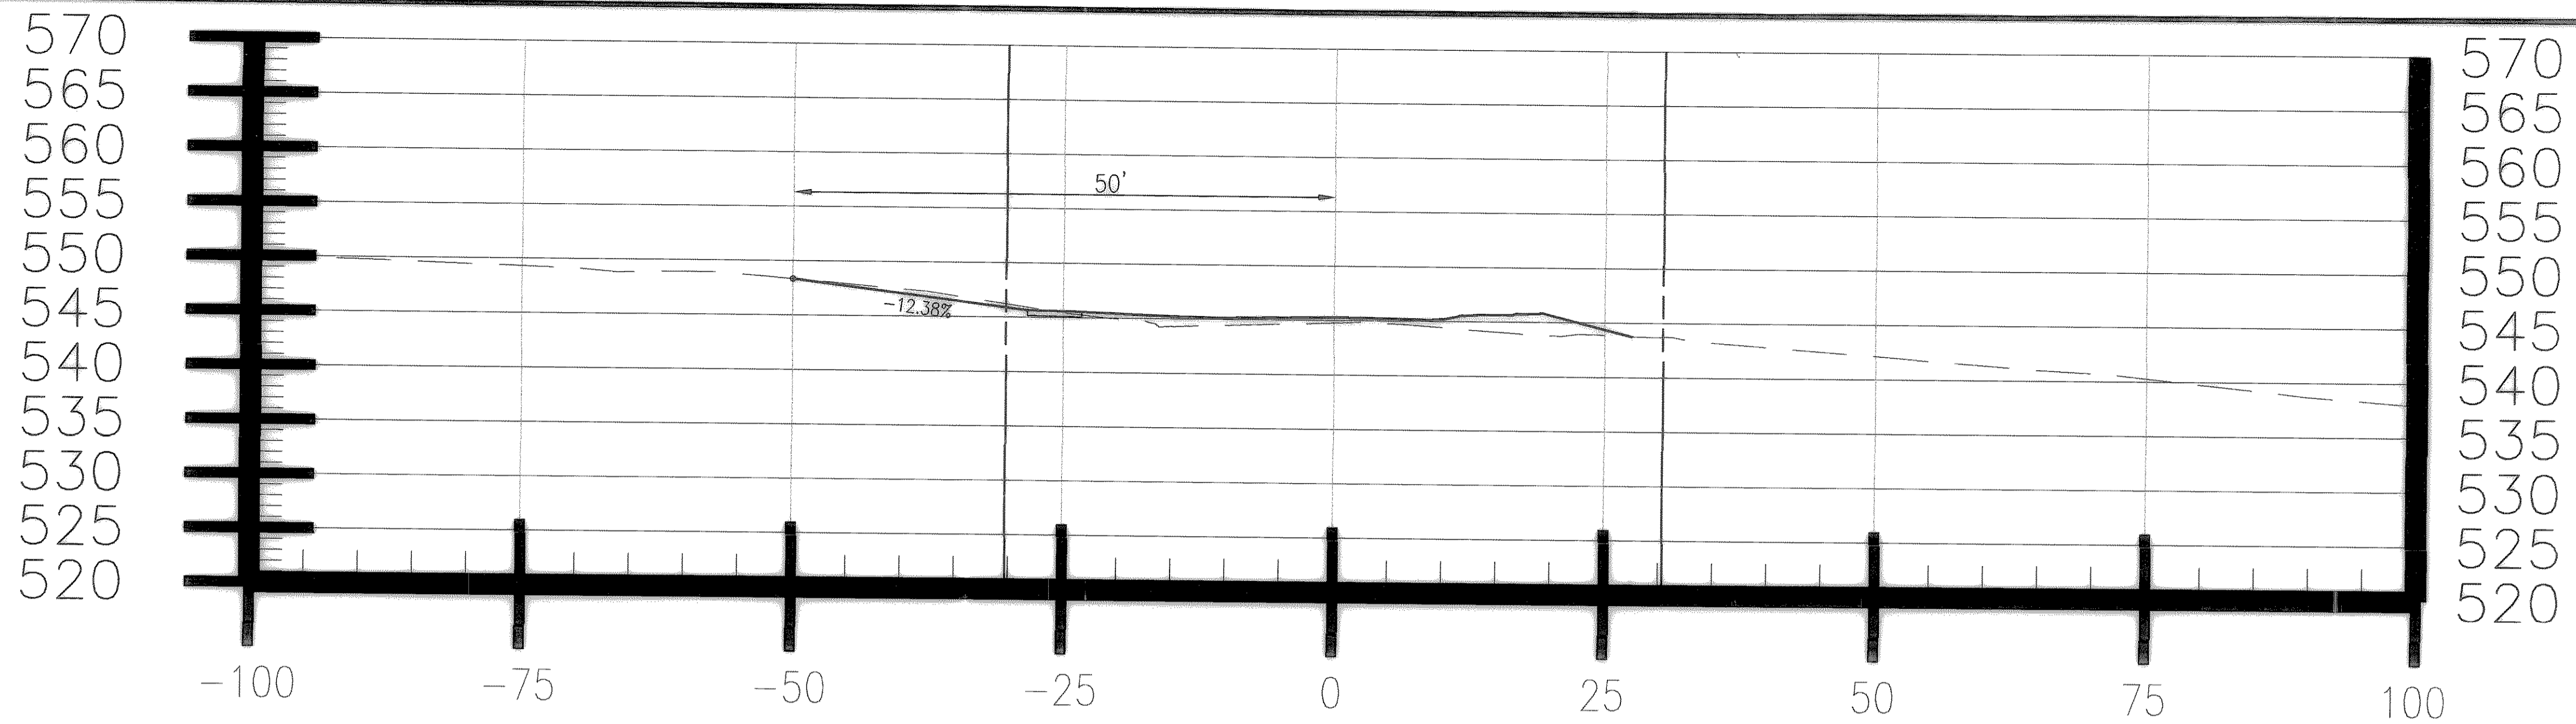

20+61.67

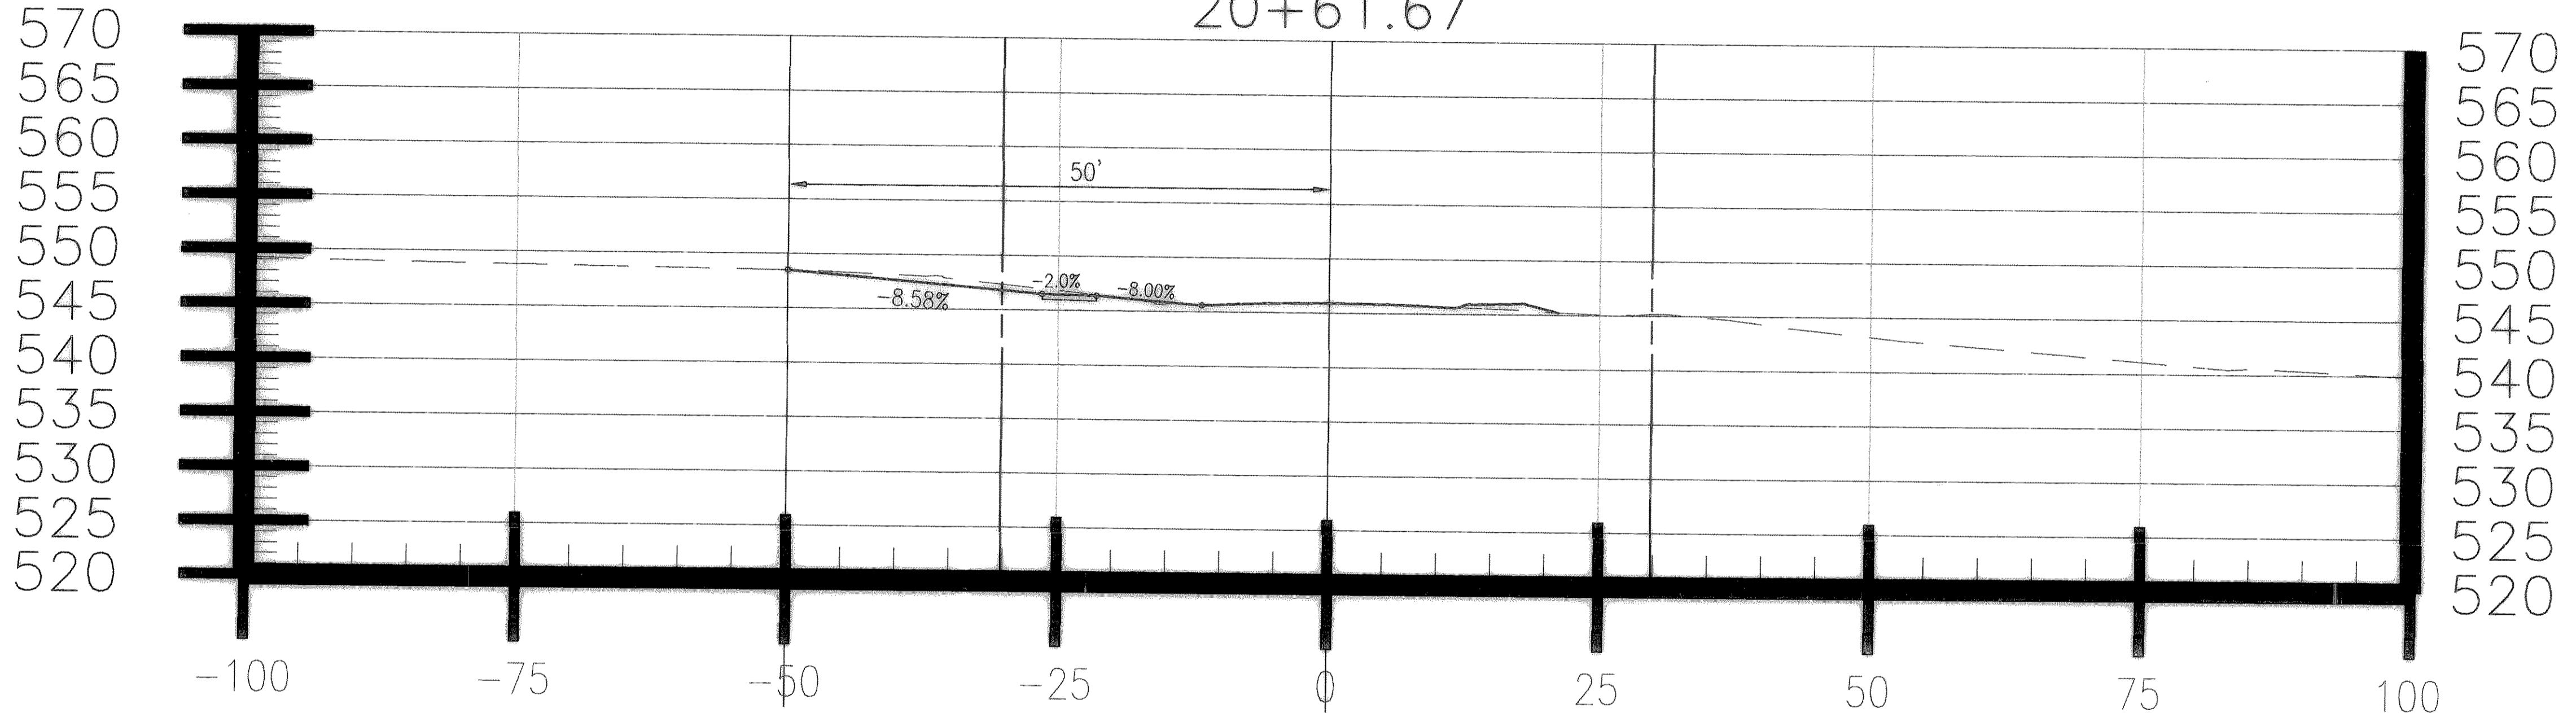

19+99.50

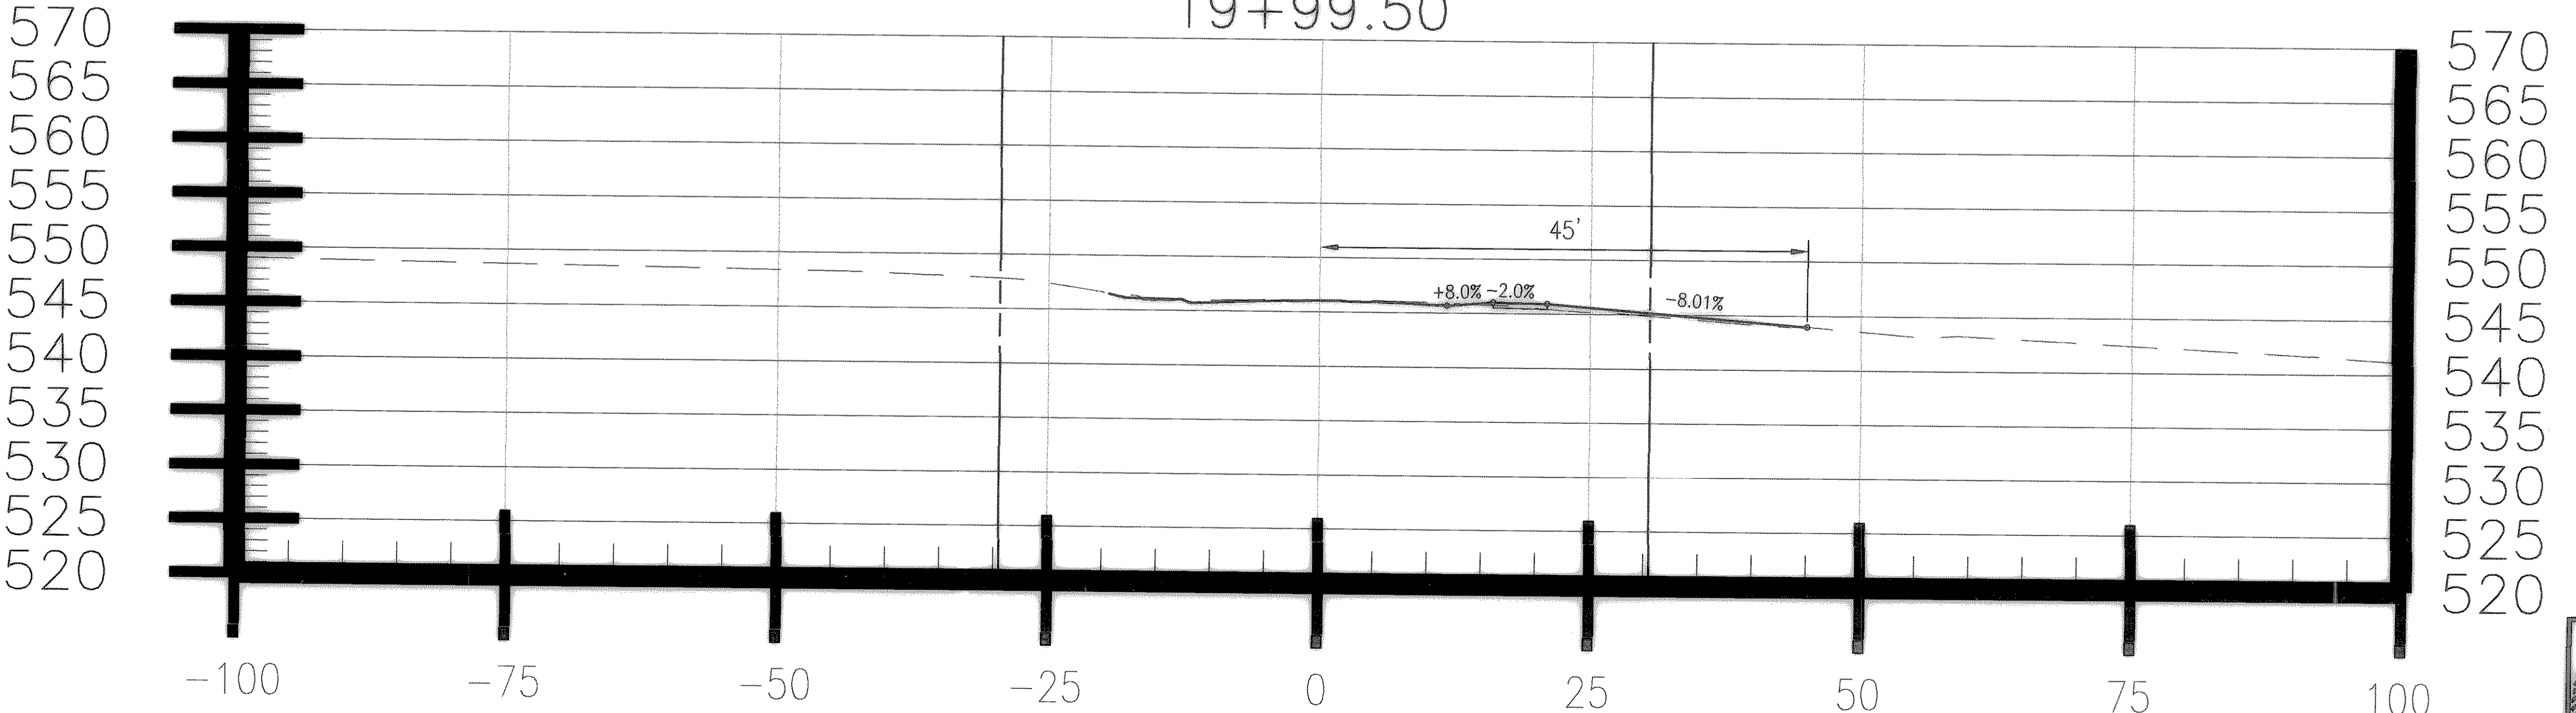


19+72.82

REVISED TO CONFORM TO CONSTRUCTION RECORDS
 BY M.H. DATE 12/04/2006

These plans and related specifications were prepared for construction of this specific project only. Reuse of these documents is not permitted without written authorization of Birkhoff, Hendricks & Conway, L.L.P.

THESE DOCUMENTS ARE FOR BIDDING, CONSTRUCTION, AND PERMIT PURPOSES.
Matthew Hickey
 DATE: 12/04/06

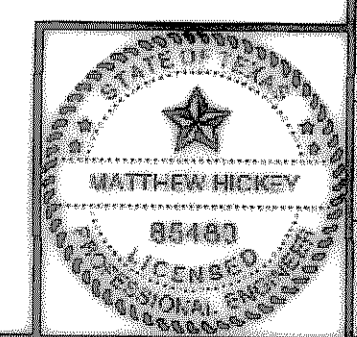

CITY OF ROCKWALL, TEXAS		
CLARK STREET DRIVEWAY CROSS SECTIONS		
BIRKHOFF, HENDRICKS & CONWAY, L.L.P. CONSULTING ENGINEERS Dallas, Texas		
DESIGNED BY: <u>M.H.</u>	PROJECT: <u>2003-120</u>	SHEET NO. <u>150</u>
DRAWN BY: <u>B.H.C.</u>	DATE: <u>AUGUST, 2004</u>	OF <u>150</u> SHEETS