




08/05/04 LBS H:\ROCKWALL\2003\20\INROADS\MAIN-DWAY-PROF.DWG SCALE: 1"=10' XREF: X

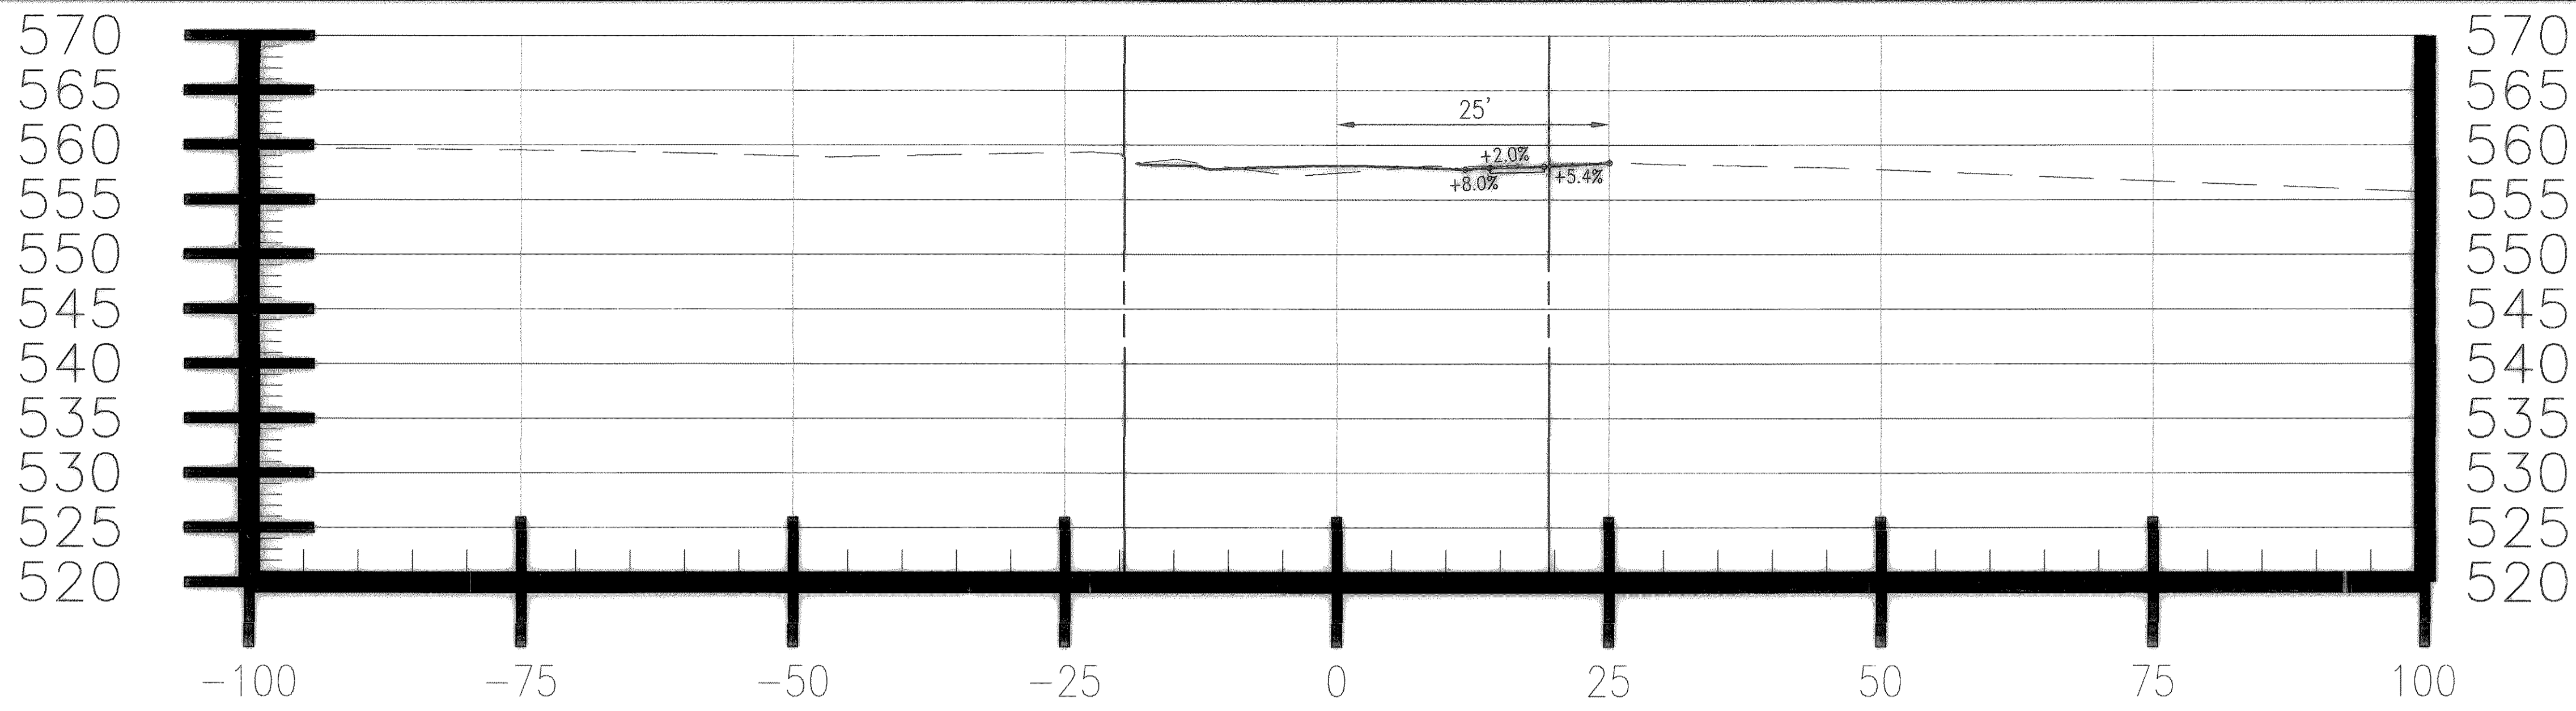

32+19.66

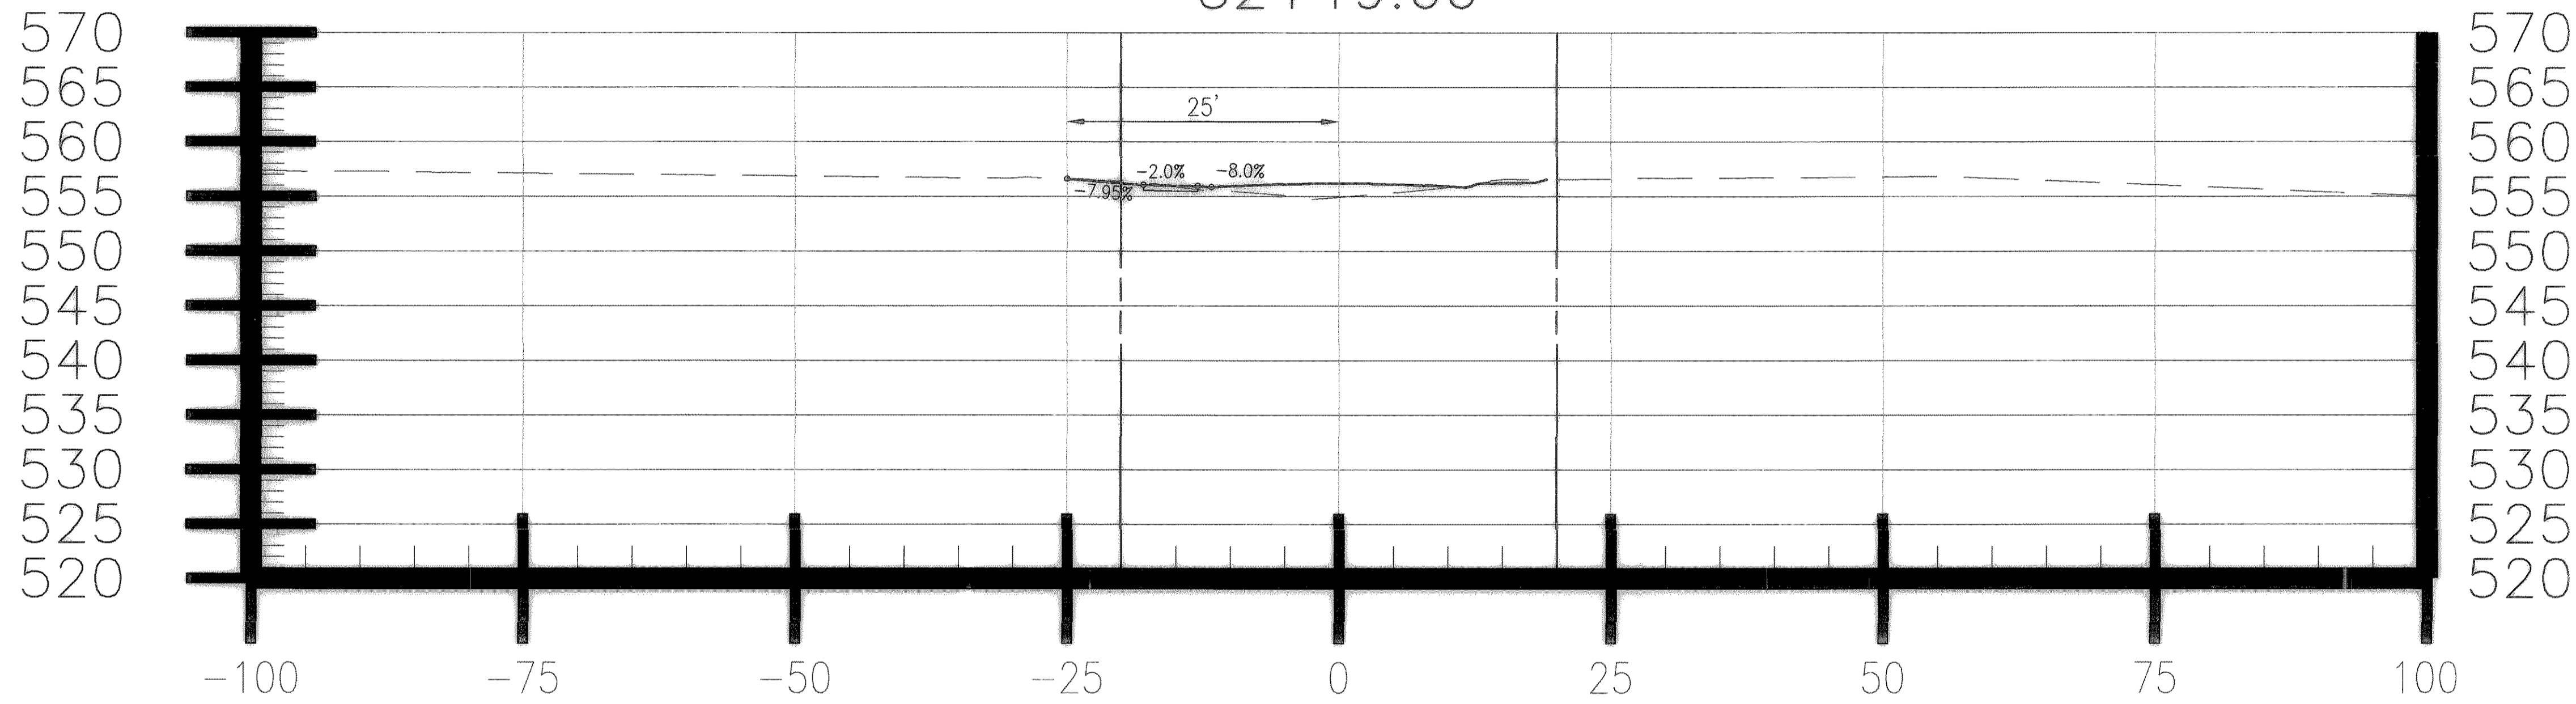

31+31.06

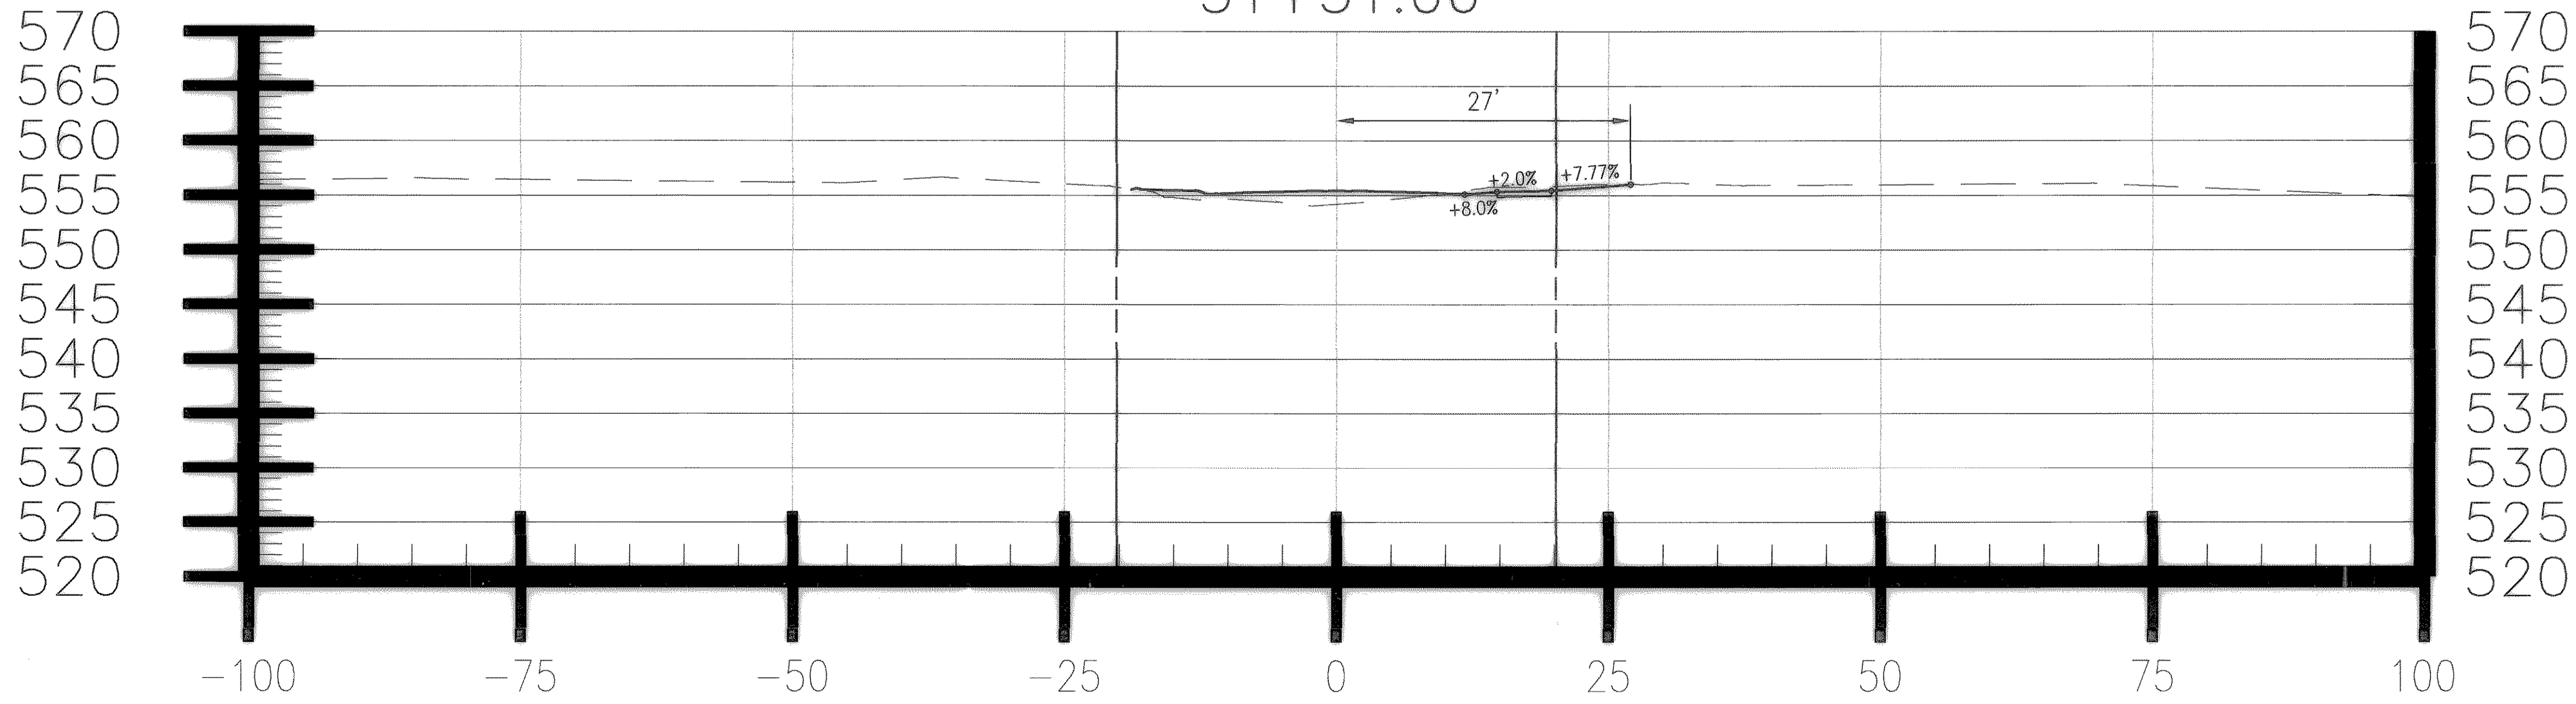


31+04.98

REVISED TO CONFORM  
TO CONSTRUCTION RECORDS  
BY M.H. DATE 12/04/2006

These plans and related specifications were prepared for construction of this specific project only. Reuse of these documents is not permitted without written authorization of Birkhoff, Hendricks & Conway, L.L.P.

THESE DOCUMENTS ARE FOR BIDDING, CONSTRUCTION, AND PERMIT PURPOSES.  
*Matthew Hickey*  
DATE: 12/04/06

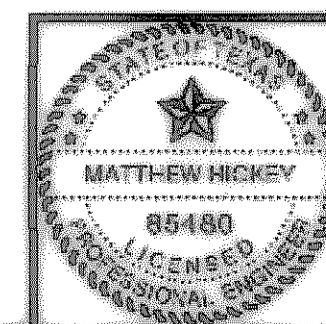

**CITY OF ROCKWALL, TEXAS**

**CLARK STREET DRIVEWAY CROSS SECTIONS**

**BIRKHOFF, HENDRICKS & CONWAY, L.L.P.**  
CONSULTING ENGINEERS  
Dallas, Texas

DESIGNED BY: M.H.	PROJECT: 2003-120	SHEET NO. 153
DRAWN BY: B.H.C.	DATE: AUGUST, 2004	OF SHEETS