

REVISED TO CONFORM  
TO CONSTRUCTION RECORDS  
BY M.H. DATE 12/04/2006

These plans and related specifications were prepared for construction of this specific project only. Reuse of these documents is not permitted without written authorization of Birkhoff, Hendricks & Conway, L.L.P.


THESE DOCUMENTS ARE FOR BIDDING, CONSTRUCTION, AND PERMIT PURPOSES.

Matthew Hickey  
DATE: 8/16/04

CITY OF ROCKWALL, TEXAS

CLARK STREET  
DRIVEWAY CROSS SECTIONS

BIRKHOFF, HENDRICKS & CONWAY, L.L.P.  
CONSULTING ENGINEERS  
Dallas, Texas

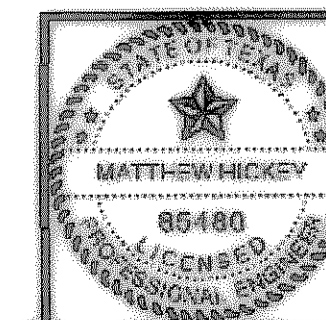

DESIGNED BY: M.H. PROJECT: 2003-120 SHEET NO. 154  
DRAWN BY: B.H.C. DATE: AUGUST, 2004 OF 154 SHEETS