
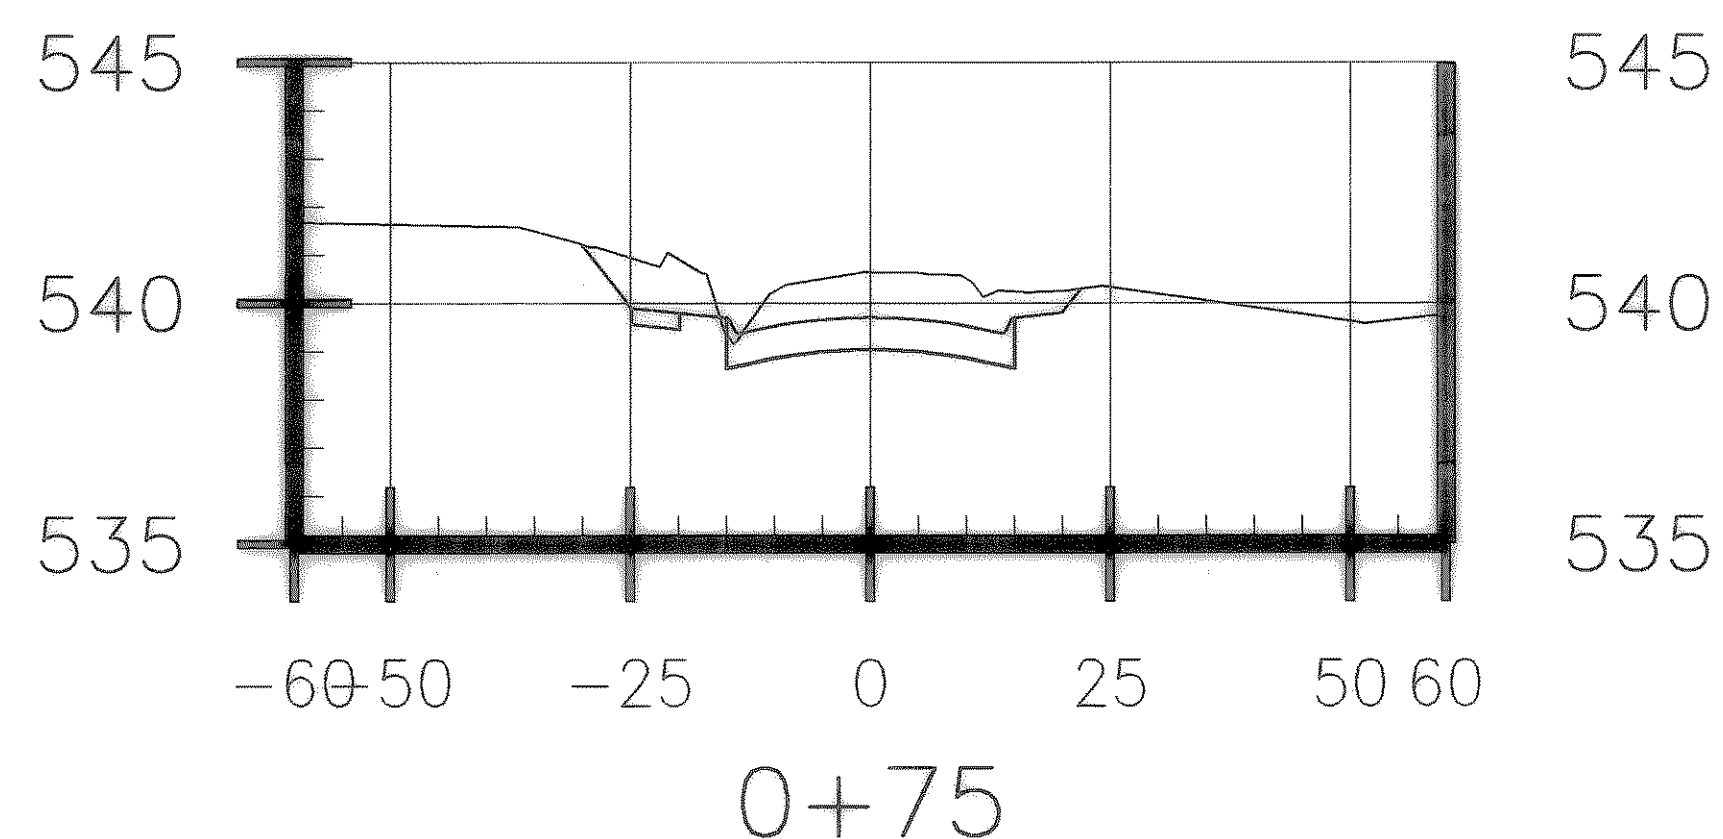
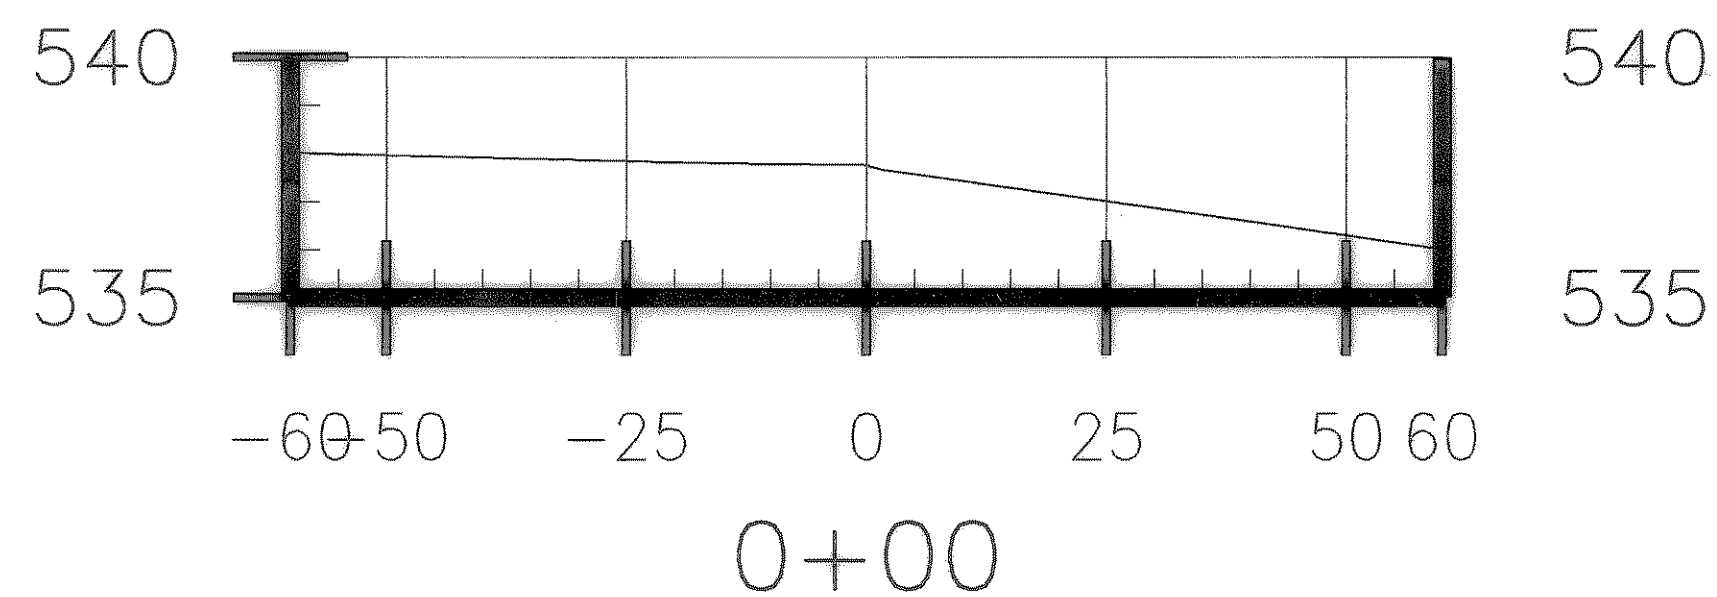
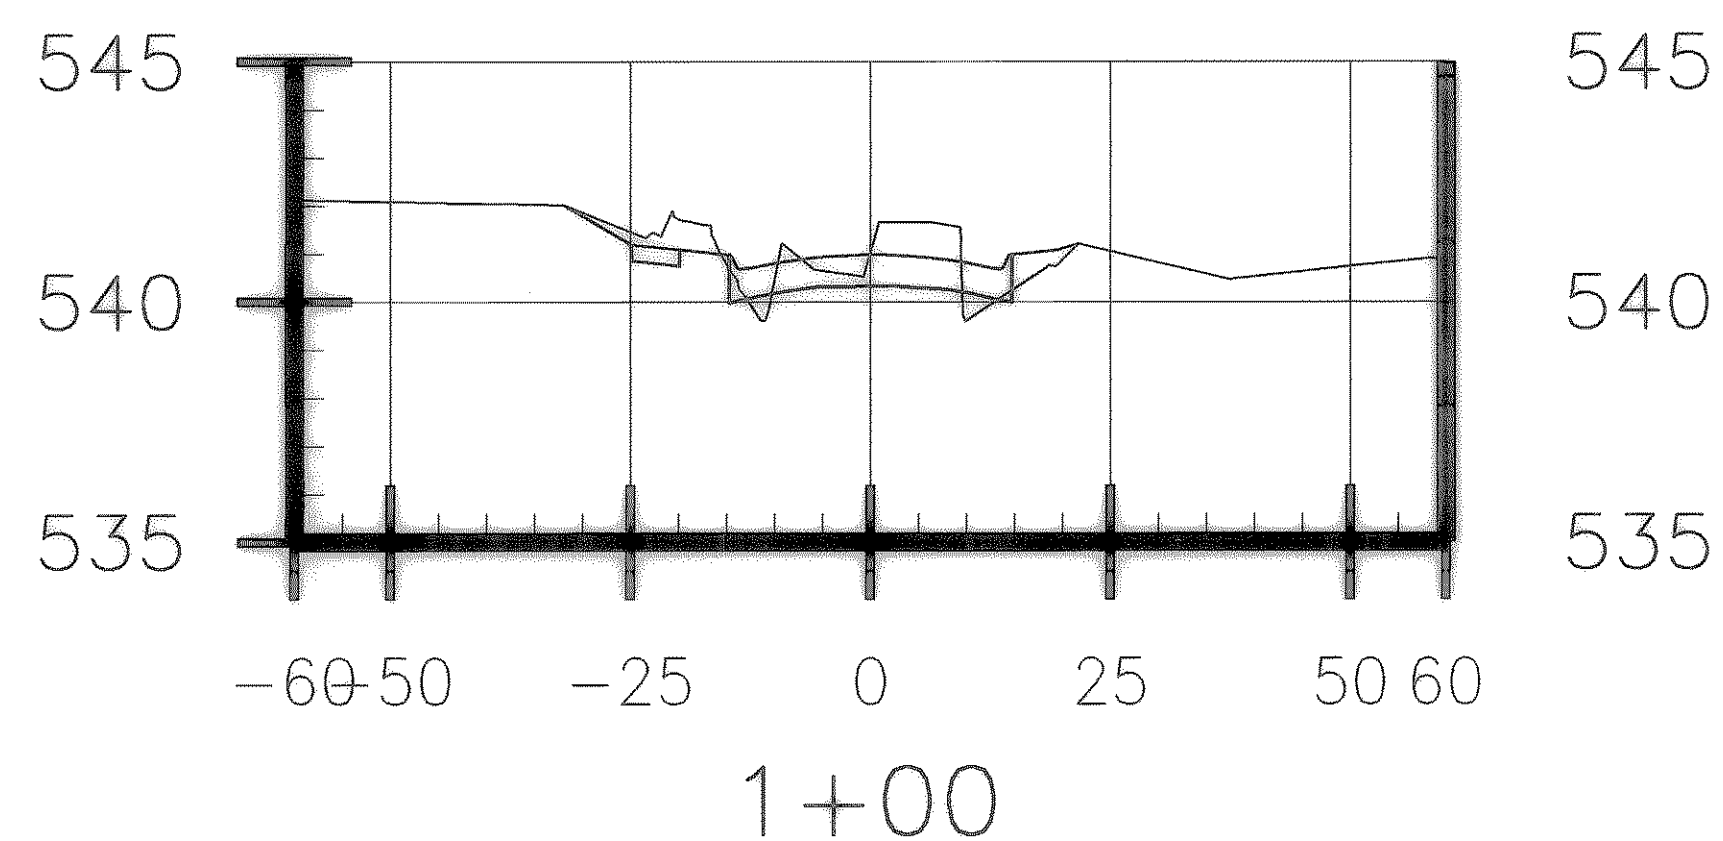
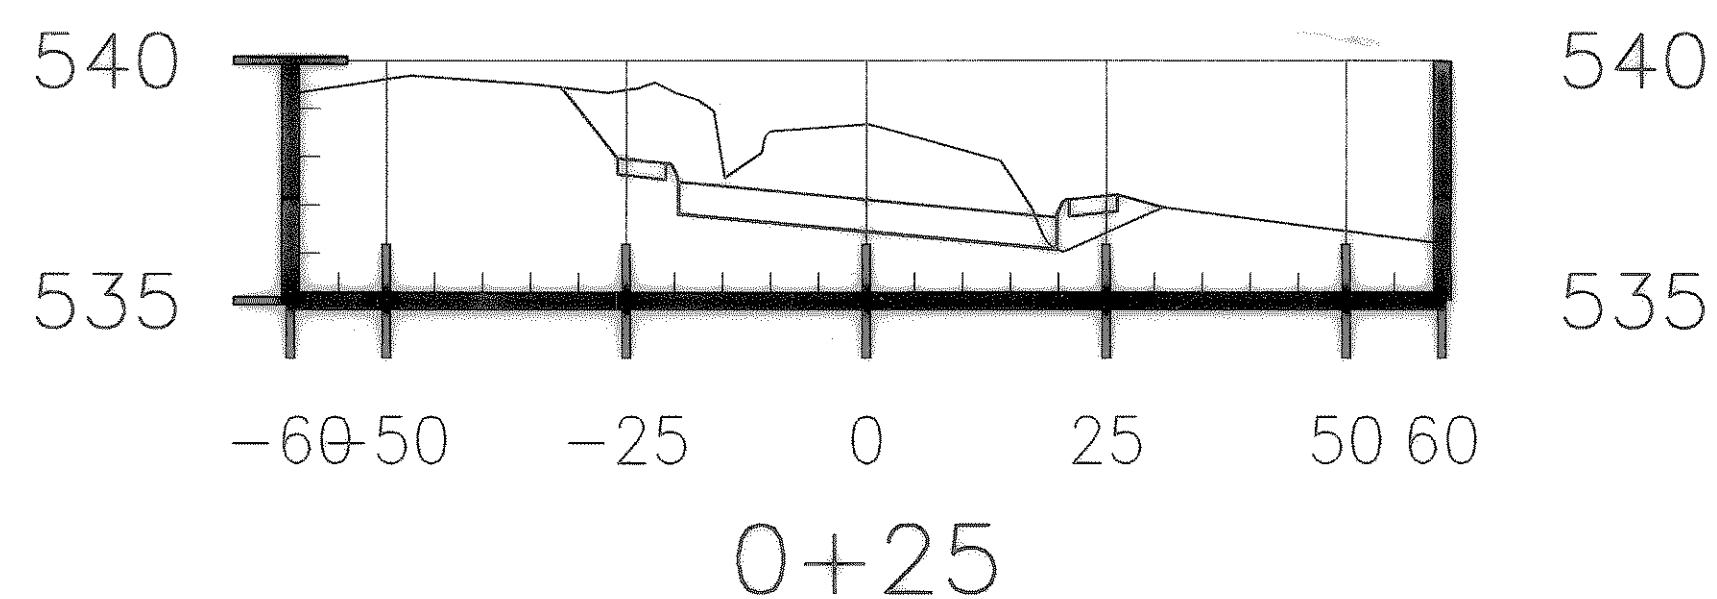
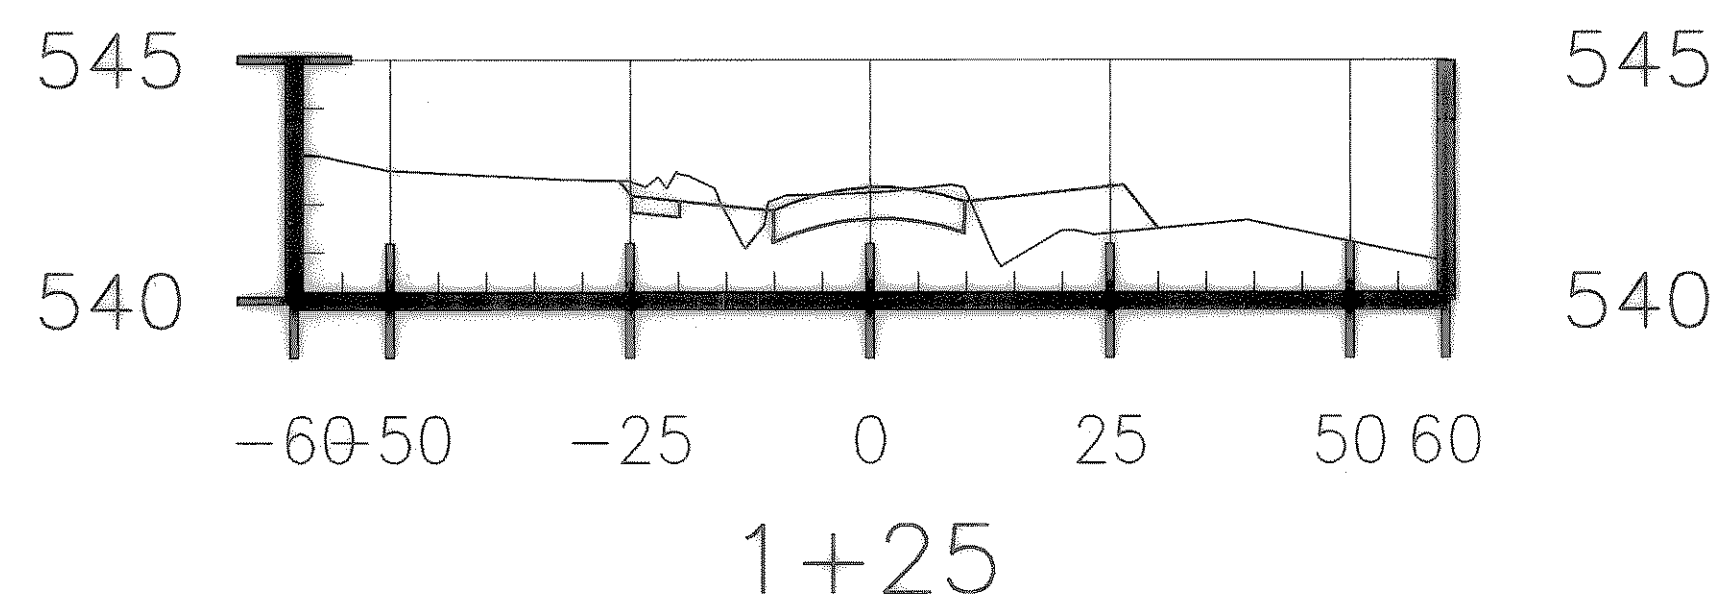


09/14/05 KAB H:\PROJECTS\ROCKWALL\200361220\PLAN-SHEETS\2003120-MUNSON-XSEC.dwg

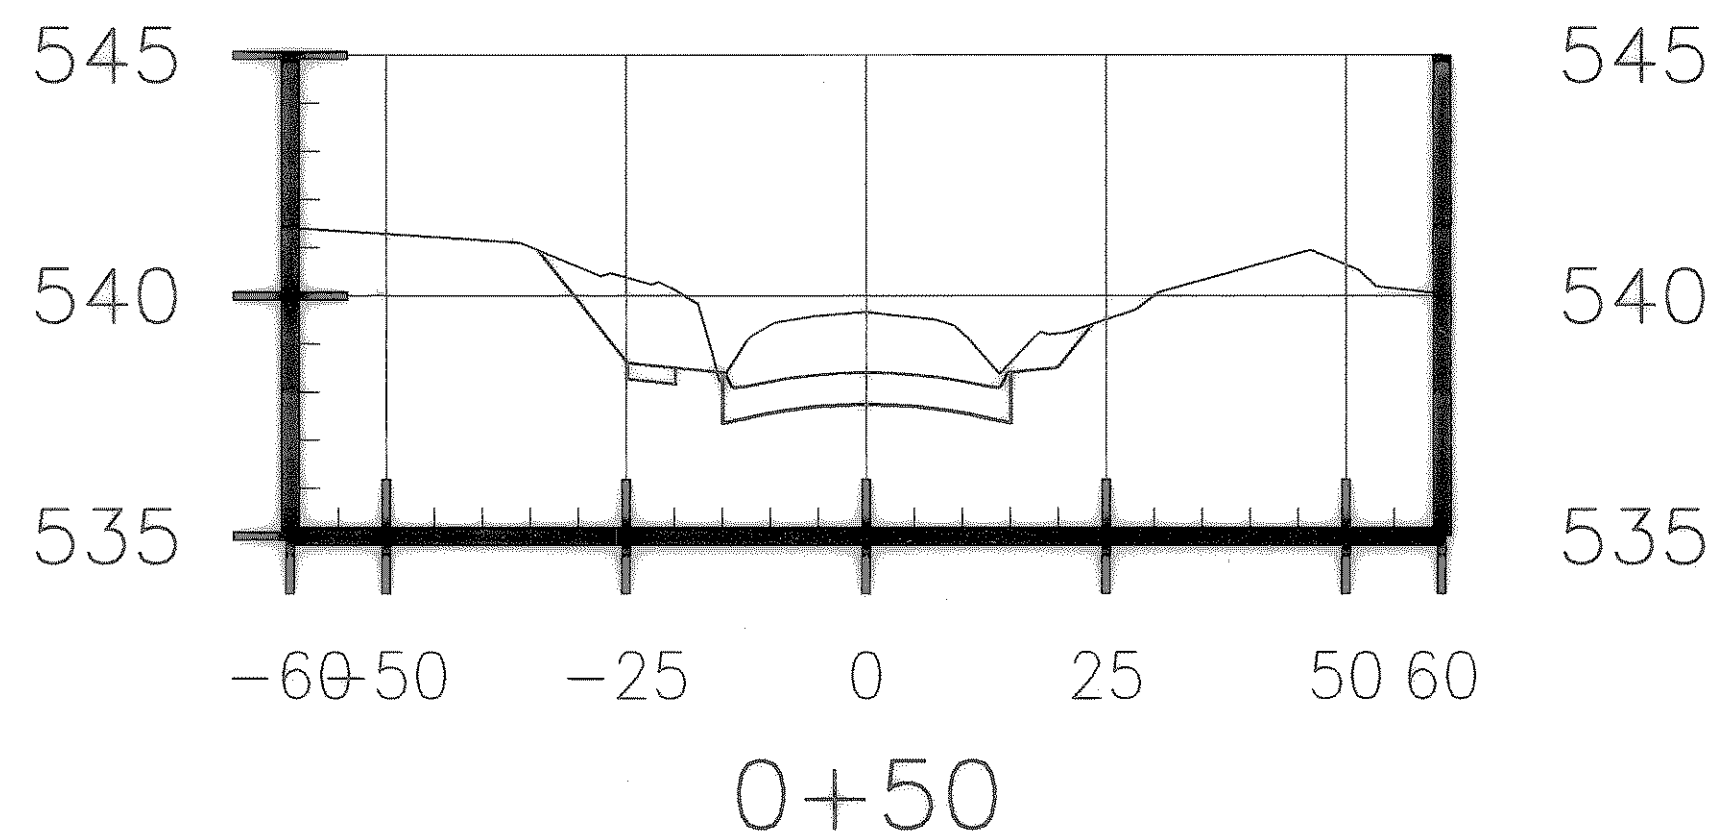

10 FIELD CHANGE NO. 10

REVISED TO CONFORM
TO CONSTRUCTION RECORDS

BY M.H. DATE 12/04/2006

THESE DOCUMENTS ARE FOR
BIDDING, CONSTRUCTION,
AND PERMIT PURPOSES.

Matthew Hickey
DATE: 5/6/04



CITY OF ROCKWALL, TEXAS

CLARK STREET
MUNSON STREET CROSS SECTIONS

BIRKHOFF, HENDRICKS & CONWAY, L.L.P.
CONSULTING ENGINEERS

SEPT., 2005