
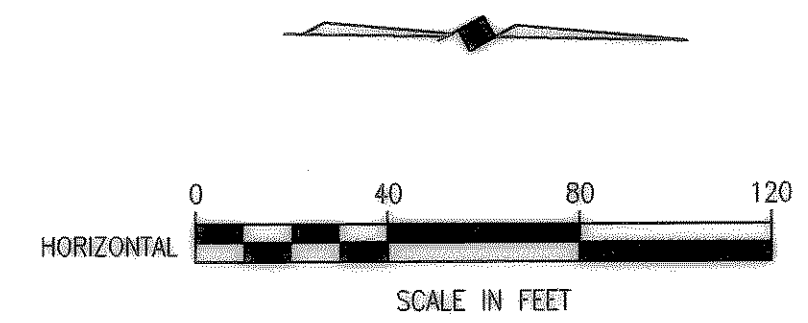
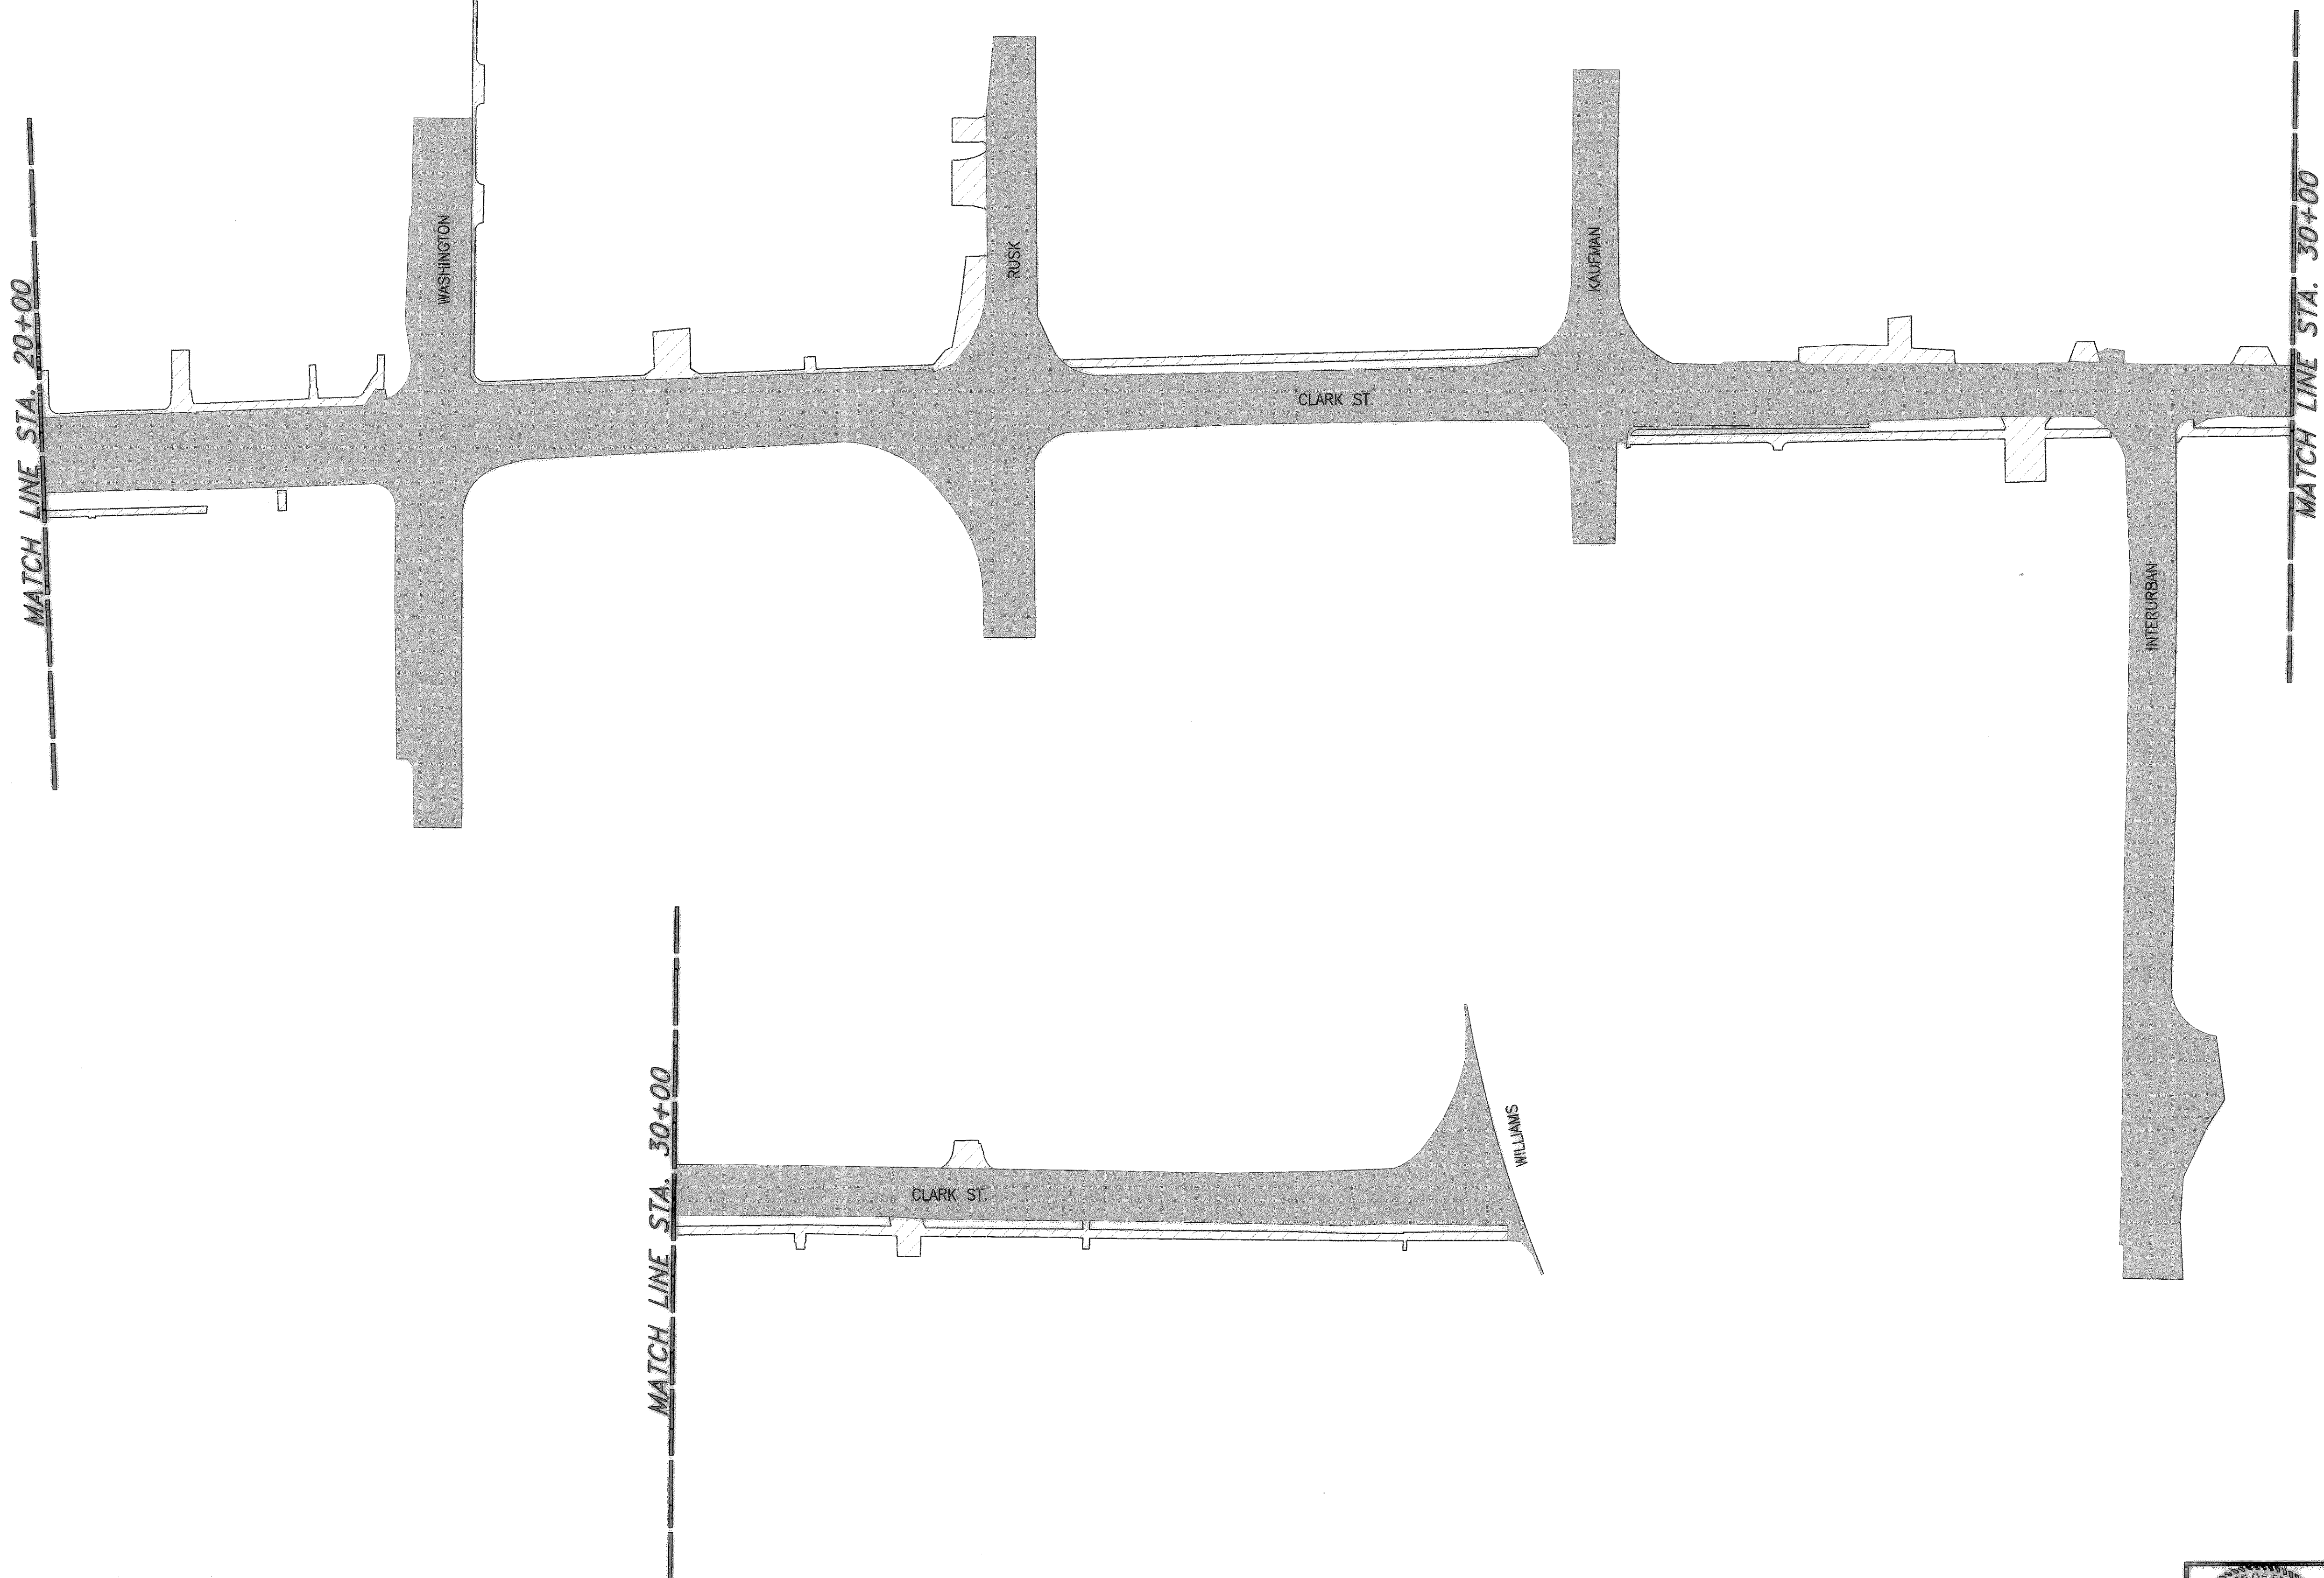
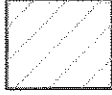


08/23/04 R.L. H:\ROCKWALL\2003\20\PLAN-SHEETS\2003\20-REMOVAL-2.DWG SCALE: 1"=40'

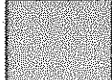

**LEGEND**

-  CONCRETE REMOVAL
-  ASPHALT REMOVAL

These plans and related specifications were prepared for construction of this specific project only. Reuse of these documents is not permitted without written authorization of Birkhoff, Hendricks, & Conway, L.L.P.

**CITY OF ROCKWALL, TEXAS**

**CLARK STREET  
PAVEMENT REMOVAL-2**

**BIRKHOFF, HENDRICKS & CONWAY L. L. P.**  
CONSULTING ENGINEERS  
Dallas, Texas



REVISED TO CONFORM  
TO CONSTRUCTION RECORDS  
BY M.H. DATE 12/04/2006

THESE DOCUMENTS ARE FOR  
BIDDING, CONSTRUCTION,  
AND PERMIT PURPOSES.  
*Matthew Hickey*  
DATE: 8/26/04

DESIGNED BY: <u>M.H.</u>	PROJECT: <u>2003-120</u>	SHEET NO. <u>89</u>
DRAWN BY: <u>B.H.C.</u>	DATE: <u>AUGUST, 2004</u>	OF <u>XX</u> SHEETS