
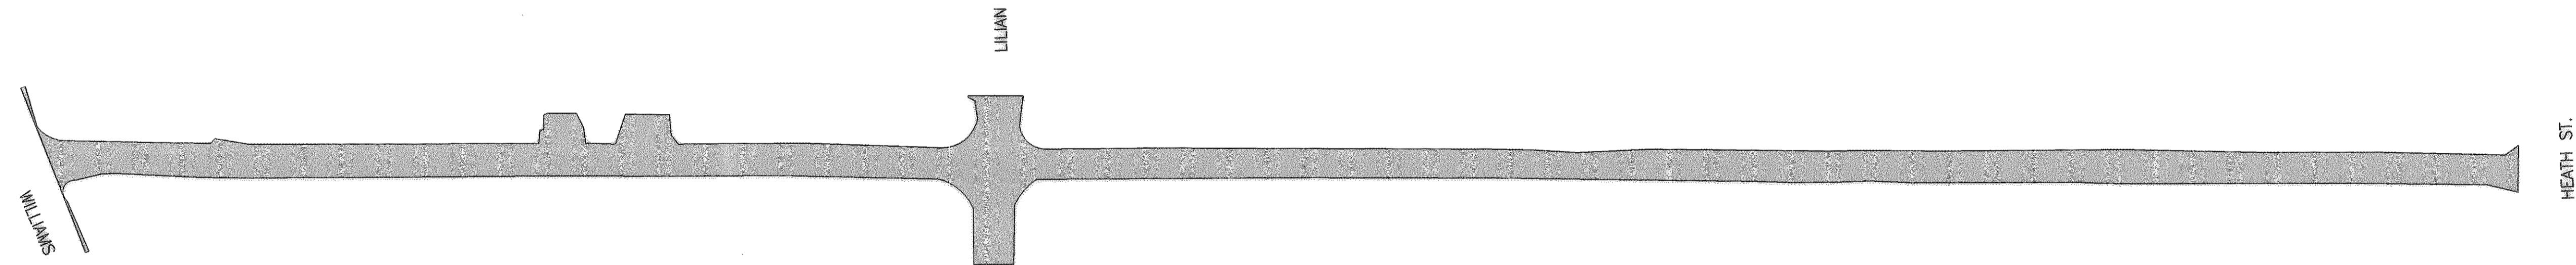
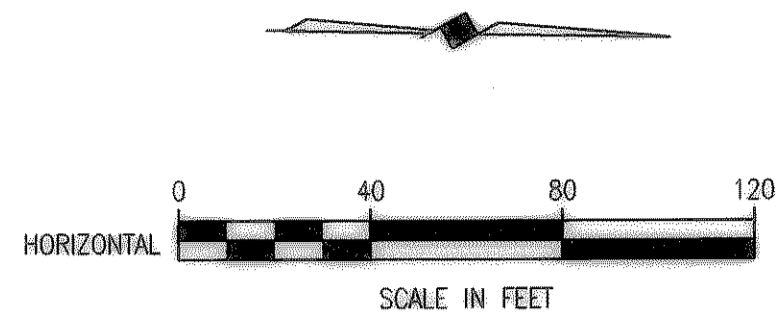
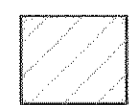


H:\ROCKWALL\2003120\PLAN-SHEETS\2003120-REMOVAL-3.DWG SCALE: 1=40

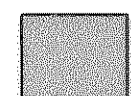

**LEGEND**

-  CONCRETE REMOVAL
-  ASPHALT REMOVAL


These plans and related specifications were prepared for construction of this specific project only. Reuse of these documents is not permitted without written authorization of Birkhoff, Hendricks, & Conway, L.L.P.

**CITY OF ROCKWALL, TEXAS**

**CLARK STREET  
PAVEMENT REMOVAL-3**

**BIRKHOFF, HENDRICKS & CONWAY L. L. P.**  
CONSULTING ENGINEERS  
Dallas, Texas

THESE DOCUMENTS ARE FOR  
BIDDING, CONSTRUCTION,  
AND PERMIT PURPOSES.  
*Matthew Hickey*  
DATE: *6/16/04*

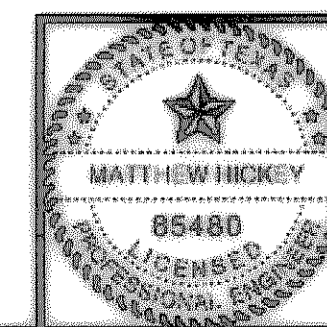

DESIGNED BY: <u>M.H.</u>	PROJECT: <u>2003-120</u>	SHEET NO. <u>90</u>
DRAWN BY: <u>B.H.C.</u>	DATE: <u>AUGUST, 2004</u>	OF <u>XX</u> SHEETS