


TIME: 9/15/17 FILE: D002-Dmmp1-08029.dwg




RECORD DRAWING
10/11/2013
 TO THE BEST OF OUR KNOWLEDGE WIER & ASSOCIATES, INC., HERBY STATES THAT THIS PLAN IS AS-BUILT. THIS INFORMATION PROVIDED IS BASED ON SURVEYING AT THE SITE AND INFORMATION PROVIDED BY THE CONTRACTOR.

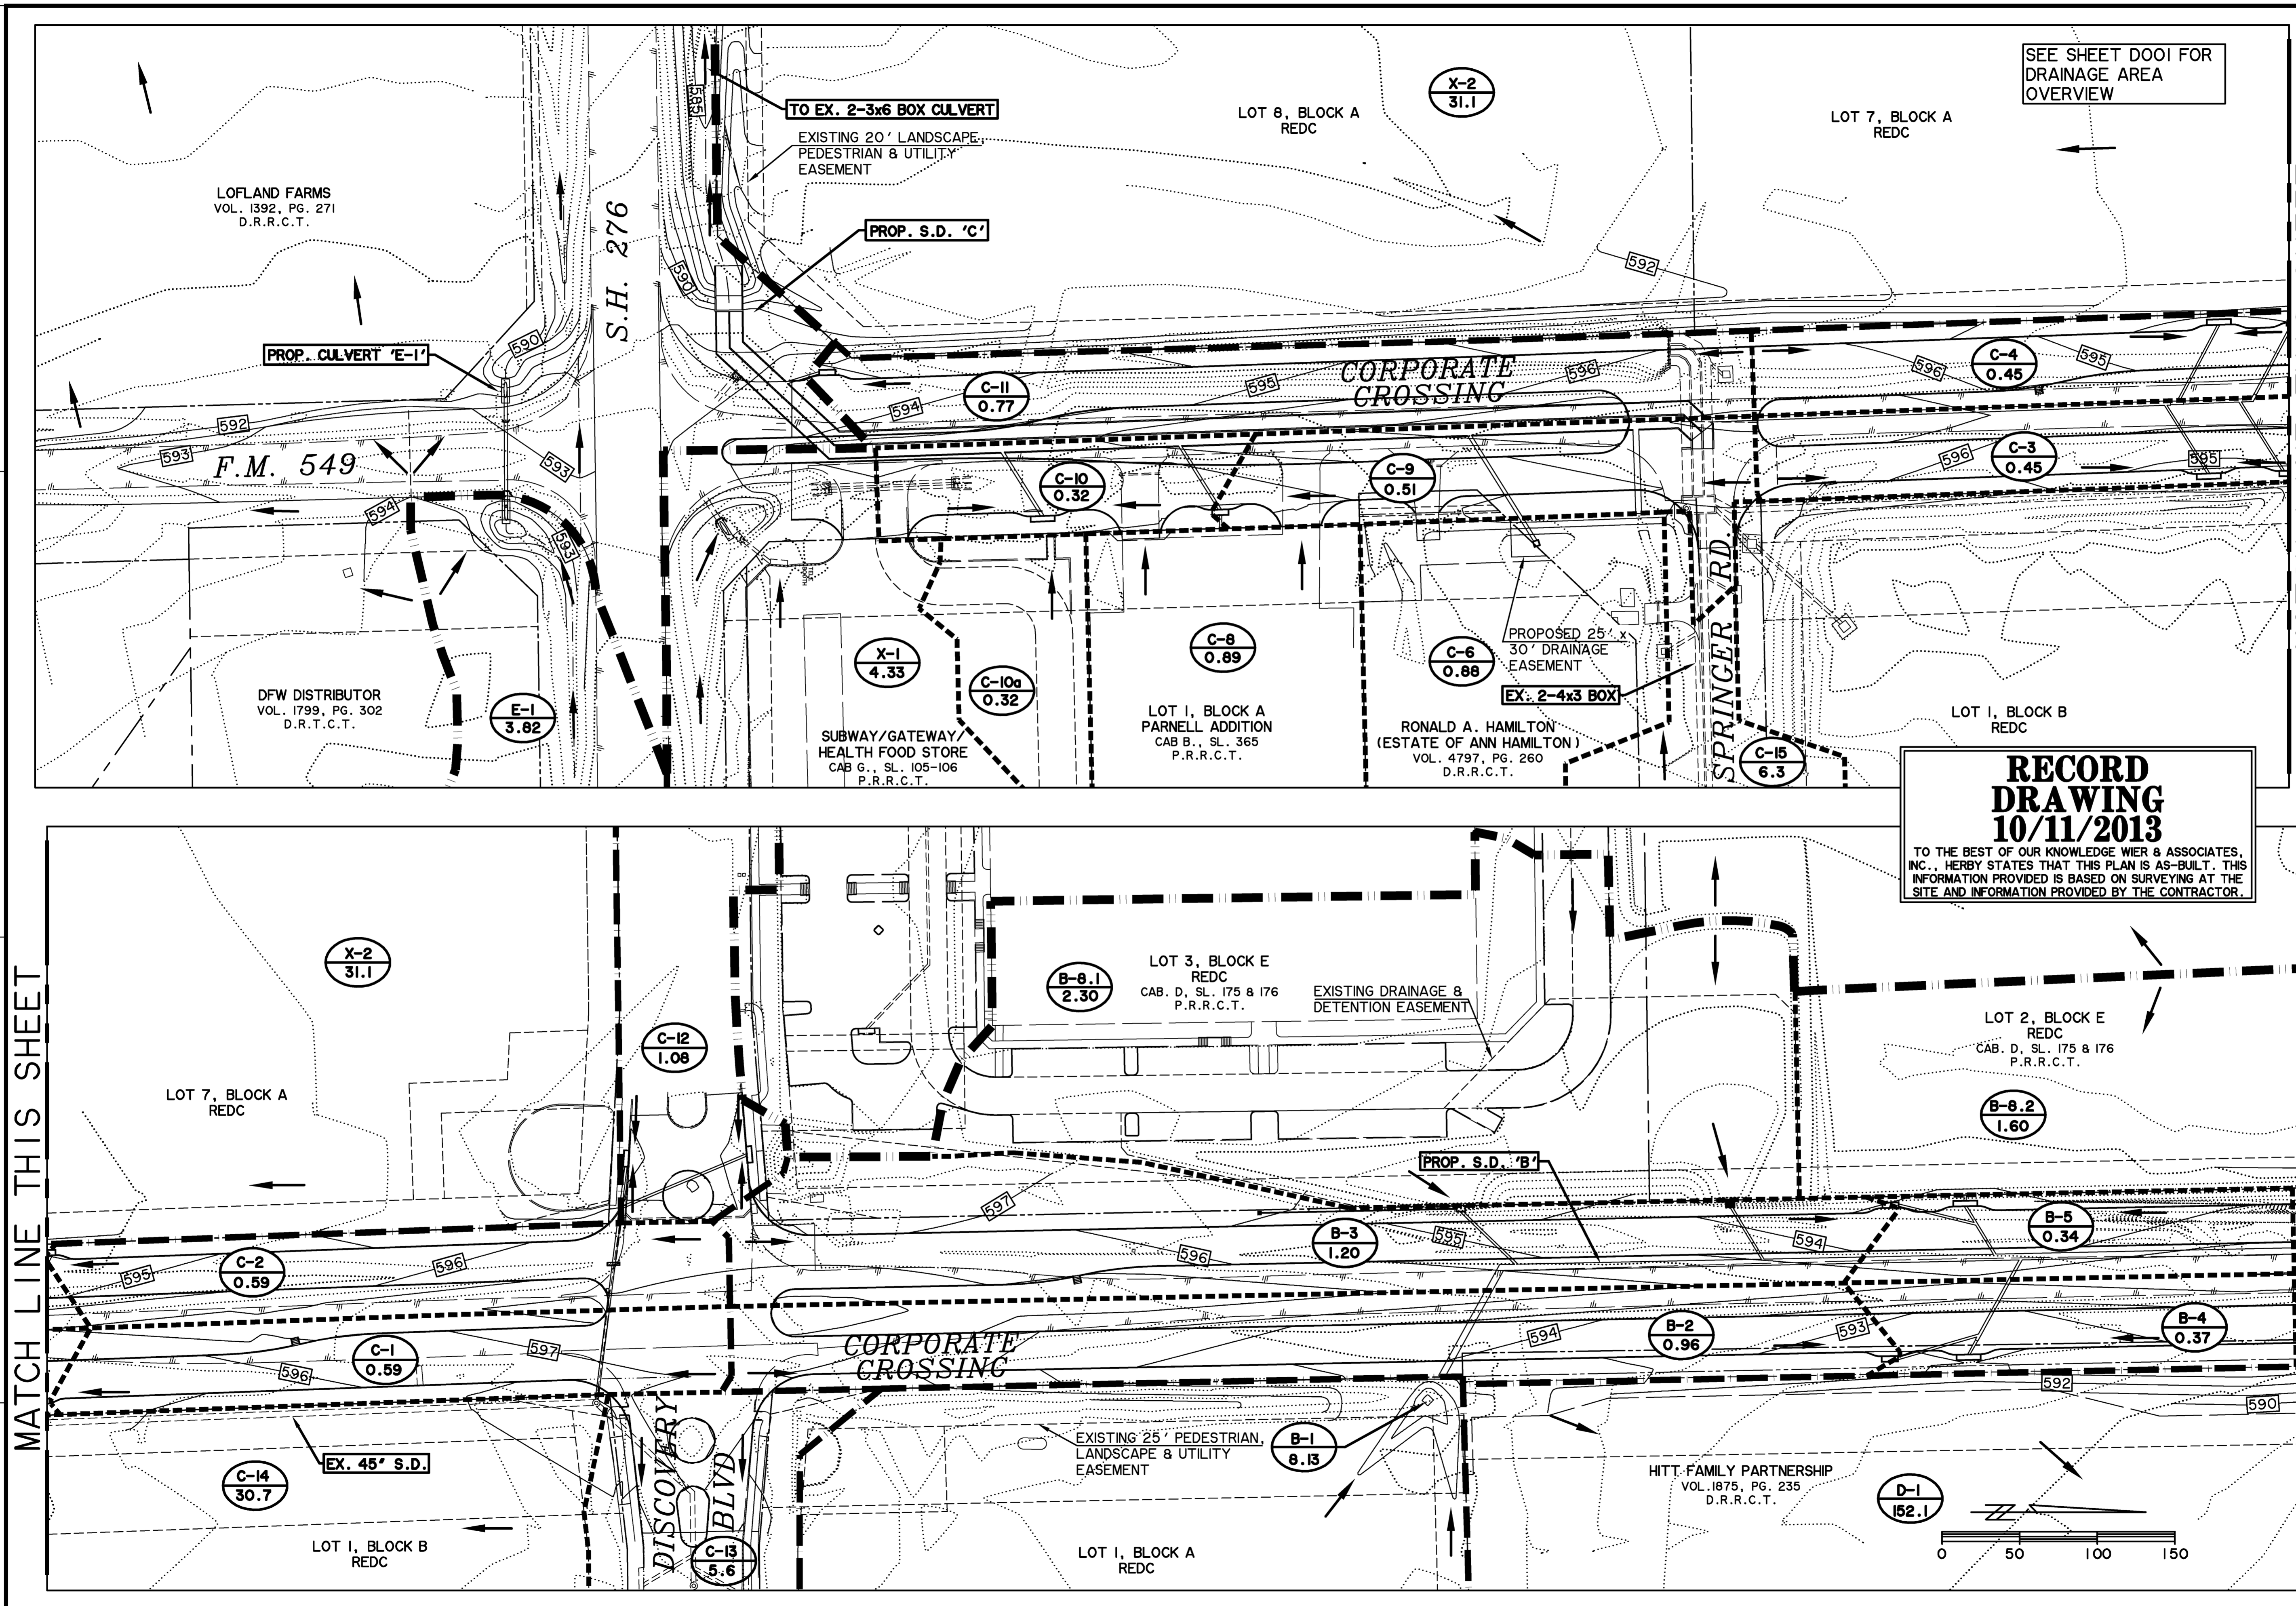

MATCH LINE THIS SHEET


MATCH LINE SHEET D003

PREPARED BY:
WIER & ASSOCIATES, INC.
 ENGINEERS SURVEYORS LAND PLANNERS
 701 HIGHLANDER BLVD., SUITE 300 ARLINGTON, TEXAS 76015 METRO (817)467-7700
 Texas Firm Registration No. F-2776 www.WierAssociates.com

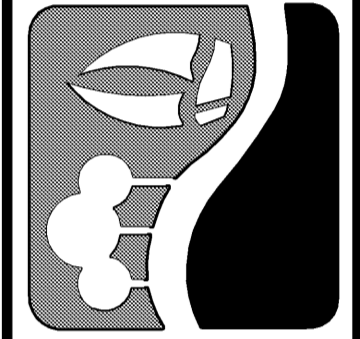

CITY OF ROCKWALL
 IMPROVEMENTS TO
 CORPORATE CROSSING
 (FROM S.H. 276 TO I.H. 30)

DRAINAGE AREA MAP

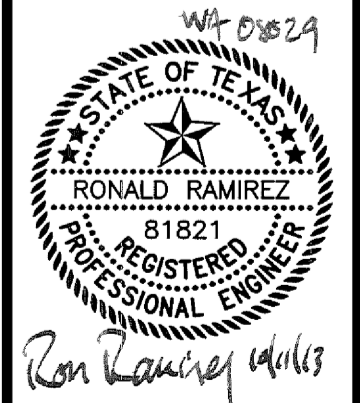

COPYRIGHT ©
 WIER & ASSOCIATES, INC.
 LAST SHEET EDIT
 DATE: 09-13-2013
 WA# 08029
SHEET NO. D002