


| Item No. | Description | Unit | PHASE | PP-1 | PP-2 | PP-3 | PP-4 | PP-5 | SDPP-1 | SDPP-2 | SDPP-3 | SDPP-4 | Quantities |
|---------------|--|------|-------|------|------|------|------|------|--------|--------|--------|--------|------------|
| PAVING | | | | | | | | | | | | | |
| 100 | Mobilization | LS | 1 | | | | | | | | | | 1 |
| 101 | Unclassified Street Excavation | CY | 6000 | | | | | | | | | | 6000 |
| 102 | ROW Preparation | STA | | 6 | 6 | 6 | 6 | 3 | | | | | 27 |
| 103 | Clearing and Grubbing, including all trees | LS | 1 | | | | | | | | | | 1 |
| 104 | Relocation of Trees at church | EA | | | | | 1 | 2 | | | | | 3 |
| 105 | Remove Asphalt Pavement | SY | | 1175 | 1350 | 1350 | 1350 | 720 | | | | | 6242 |
| 106 | Remove Existing Curb | LF | | 100 | 175 | 510 | 140 | 130 | | | | | 1055 |
| 107 | Remove Existing Concrete Roadway | SY | | 350 | 750 | 385 | 0 | 0 | | | | | 1485 |
| 108 | Remove Existing Concrete Sidewalk | SY | | 6 | 185 | 235 | 18 | 0 | | | | | 454 |
| 109 | Remove Existing Concrete Driveway | SY | | 210 | 210 | 700 | 675 | 30 | | | | | 1825 |
| 110 | Remove Existing Gravel Driveway | SY | | 0 | 0 | 73 | 0 | 0 | | | | | 73 |
| 111 | Hydrated Lime | TON | | 45 | 85 | 80 | 80 | 35 | | | | | 341 |
| 112 | 6" Lime Stabilized Subgrade | SY | | 1980 | 3725 | 3680 | 3500 | 1550 | | | | | 14435 |
| 113 | 6" HMC Pavement | SY | | 425 | 0 | 2 | 0 | 0 | | | | | 427 |
| 114 | 8" Concrete Roadway Pavement | SY | | 1850 | 3650 | 3610 | 3500 | 1550 | | | | | 14973 |
| 115 | 6" Monolithic Curb | LF | | 920 | 1510 | 1570 | 1450 | 675 | | | | | 6431 |
| 116 | 6" Reinforced Concrete Driveway | SY | | 30 | 75 | 70 | 0 | 0 | | | | | 175 |
| 117 | Gravel Driveway | SY | | 0 | 0 | 40 | 0 | 0 | | | | | 40 |
| 118 | 4" Reinforced Concrete Sidewalk | SY | | 160 | 275 | 185 | 0 | 0 | | | | | 600 |
| 119 | 4" Reinforced Conc. Hike and Bike Trail | SY | | 350 | 450 | 520 | 490 | 200 | | | | | 2010 |
| 120 | Barrier Free Ramp | SY | | 70 | 85 | 115 | 20 | 7 | | | | | 297 |
| 121 | Retaining Wall | CY | | 0 | 20 | 0 | 0 | 0 | | | | | 20 |
| 122 | Sawed Breakout Groove | LF | | 120 | 150 | 165 | 120 | 135 | | | | | 690 |
| 123 | Concrete Header | LF | | 37 | 0 | 0 | 0 | 56 | | | | | 93 |
| 124 | Adjust WV to grade | EA | | 3 | 3 | 3 | 2 | 1 | | | | | 12 |
| 125 | Remove Wire Fence | LF | | 400 | 485 | 380 | 0 | 0 | | | | | 1265 |
| 126 | Remove Pipe Rail Fence | LF | | 0 | 0 | 250 | 135 | 0 | | | | | 385 |
| 127 | Remove 12" CMP | LF | | 0 | 24 | 0 | 0 | 0 | | | | | 24 |
| 128 | Remove 18" RCP | LF | | 67 | 57 | 152 | 73 | 0 | | | | | 349 |
| 129 | Remove 21" RCP | LF | | 0 | 0 | 65 | 0 | 0 | | | | | 65 |
| 130 | Remove 30" RCP | LF | | 0 | 0 | 0 | 0 | 60 | | | | | 60 |
| 131 | Remove 15" CMP | LF | | 40 | 23 | 24 | 0 | 0 | | | | | 87 |
| 132 | Remove 18" CMP | LF | | 23 | 0 | 0 | 0 | 0 | | | | | 23 |
| 133 | Remove 36" CMP | LF | | 0 | 0 | 40 | 0 | 0 | | | | | 40 |
| 134 | Remove Concrete Headwall | EA | | 1 | 1 | 8 | 2 | 2 | | | | | 14 |
| 135 | Remove Concrete Slope Pavement | SY | | 20 | 56 | 0 | 0 | 0 | | | | | 76 |
| 136 | Bermuda Sod | SY | | 360 | 800 | 1080 | 1135 | 1600 | | | | | 4975 |
| 137 | Hydromulch | SY | | 1120 | 2750 | 1025 | 175 | 1100 | | | | | 6170 |
| 138 | Place Trees | EA | | 0 | 2 | 0 | 3 | 0 | | | | | 5 |
| 139 | Install Pipe Fence | LF | | 0 | 0 | 250 | 135 | 0 | | | | | 385 |
| 140 | Remove and Replace Mailbox | EA | | 0 | 0 | 1 | 0 | 0 | | | | | 1 |
| 141 | 4" White Reflector Buttons | EA | | 120 | | | | | | | | | 120 |
| 142 | 4" White Non-Reflector Buttons | EA | | 600 | | | | | | | | | 600 |
| 143 | 4" Yellow Reflector Buttons | EA | | 60 | | | | | | | | | 60 |
| 144 | 4" Yellow Non-Reflector Buttons | EA | | 300 | | | | | | | | | 300 |
| 145 | 4" Painted White Stripe | LF | | 300 | | | | | | | | | 300 |
| 146 | Stop Bar | EA | | 1 | 4 | 1 | 0 | 1 | | | | | 7 |
| 147 | Crosswalk | EA | | 1 | 4 | 3 | 2 | 0 | | | | | 10 |
| 148 | Turn Arrows | EA | | 0 | 3 | 0 | 0 | 3 | | | | | 6 |
| 149 | Remove and Relocate Signs | EA | | 1 | 1 | 6 | 0 | 2 | | | | | 10 |
| 150 | Temporary Traffic Control | LS | | 1 | 0 | 0 | 0 | 0 | | | | | 1 |
| 151 | Relocate GPS Monument | EA | | 0 | 0 | 0 | 0 | 1 | | | | | 1 |
| 152 | Erosion Control | LS | | 1 | 0 | 0 | 0 | 0 | | | | | 1 |
| 153 | 3" Temporary HMAC | SY | | 3900 | 0 | 0 | 0 | 0 | | | | | 3900 |
| 154 | 3" Temporary CMAC | SY | | 400 | 0 | 0 | 0 | 0 | | | | | 400 |
| 155 | Jersey Barriers | LF | | 1200 | 0 | 0 | 0 | 0 | | | | | 1200 |

| Item No. | Description | Unit | PHASE | PP-1 | PP-2 | PP-3 | PP-4 | PP-5 | SDPP-1 | SDPP-2 | SDPP-3 | SDPP-4 | Quantities |
|-----------------------|---------------------------|------|-------|------|------|------|------|------|--------|--------|--------|--------|------------|
| STORM DRAINAGE | | | | | | | | | | | | | |
| 200 | 5" Curb Inlet | EA | | | | | | | 1 | 0 | 0 | 0 | 1 |
| 201 | 10" Curb inlet | EA | | | | | | | 1 | 1 | 0 | 0 | 2 |
| 202 | 15" Curb inlet | EA | | | | | | | 2 | 2 | 0 | 0 | 4 |
| 203 | 20" Curb Inlet | EA | | | | | | | 0 | 0 | 1 | 0 | 1 |
| 204 | Extra Depth Curb Inlet | FT | | | | | | | 1 | 0 | 0 | 0 | 1 |
| 205 | 4' SDMH | EA | | | | | | | 0 | 2 | 0 | 0 | 2 |
| 206 | 5' SDMH | EA | | | | | | | 1 | 1 | 0 | 0 | 2 |
| 207 | Wye Connection | EA | | | | | | | 2 | 1 | 1 | 0 | 4 |
| 208 | Headwall | CY | | | | | | | 5 | 9 | 0 | 3 | 17 |
| 209 | Energy Dissipaters | CY | | | | | | | 1 | 2 | 0 | 0 | 3 |
| 210 | 18" Class III RCP | LF | | | | | | | 166 | 284 | 321 | 0 | 771 |
| 211 | 24" Class III RCP | LF | | | | | | | 178 | 0 | 0 | 0 | 178 |
| 212 | 27" Class III RCP | LF | | | | | | | 54 | 27 | 0 | 0 | 81 |
| 213 | 30" Class III RCP | LF | | | | | | | 0 | 29 | 0 | 0 | 29 |
| 214 | 36" Class III RCP | LF | | | | | | | 0 | 161 | 0 | 0 | 161 |
| 215 | 42" Class III RCP | LF | | | | | | | 0 | 33 | 0 | 0 | 33 |
| 216 | 18" Class IV RCP | LF | | | | | | | 0 | 0 | 0 | 111 | 111 |
| 217 | Concrete Storm Drain Plug | EA | | | | | | | 0 | 0 | 1 | 0 | 1 |
| 218 | Grouted Rip-Rap | SY | | | | | | | 34 | 60 | 0 | 261 | 355 |
| 219 | 5" Concrete Flume | LF | | | | | | | 0 | 0 | 0 | 27 | 27 |
| 220 | Handrail | LF | | | | | | | 0 | 100 | 0 | 0 | 100 |
| 221 | Trench Safety | LF | | | | | | | 398 | 534 | 321 | 111 | 1364 |

| Item No. | Description | Unit | PHASE | PP-1 | PP-2 | PP-3 | PP-4 | PP-5 | SDPP-1 | SDPP-2 | SDPP-3 | SDPP-4 | Quantities |
|--------------|-----------------------|------|-------|------|------|------|------|------|--------|--------|--------|--------|------------|
| Water | | | | | | | | | | | | | |
| 300 | 12" PVC Waterline | LF | | | 555 | 125 | | | | | | | 680 |
| 301 | Cast Iron Fittings | TON | | | | | | | | | | | 2 |
| 302 | FH Assembly | EA | | | 1 | | | | | | | | 1 |
| 303 | 12" x 12" TSV | EA | | | 2 | 1 | | | | | | | 3 |
| 304 | 6" x 6" TSV | EA | | | 1 | | | | | | | | 1 |
| 305 | 12" Gate Valve | EA | | | 3 | | | | | | | | 3 |
| 306 | 6" gate Valve | EA | | | 1 | 1 | 1 | | | | | | 3 |
| 307 | Cut and Plug WL | EA | | | 3 | 1 | | | | | | | 4 |
| 308 | Relocate FH | EA | | | | | | | | | | | 2 |
| 309 | Trench Safety | LF | | | 60 | 555 | 155 | | | | | | 770 |
| 310 | WL Adjustment | EA | | | 2 | 0 | 2 | | | | | | 5 |
| 311 | Chlorination Disposal | LS | | | | | | | | | | | 1 |



| Item No. | Description | Unit | PHASE | PP-1 | PP-2 | PP-3 | PP-4 | PP-5 | SDPP-1 | SDPP-2 | SDPP-3 | SDPP-4 | Quantities |
|---------------------------|-----------------------|------|-------|------|------|------|------|------|--------|--------|--------|--------|------------|
| Sewer (Force Main) | | | | | | | | | | | | | |
| 400 | 6" PVC Force Main | LF | | | | 510 | 600 | 280 | | | | | 1390 |
| 401 | Cast Iron Fittings | TON | | | | | | | | | | | 1 |
| 402 | 6" Dry Connection | EA | | | | 1 | | | | | | | 1 |
| 403 | Connect FM to Manhole | EA | | | | | | 1 | | | | | 1 |
| 404 | Cut & Plug 6" FM | EA | | | | 1 | | 1 | | | | | 2 |
| 405 | Trench Safety | LF | | | | 510 | 600 | 280 | | | | | 1390 |

LEGEND

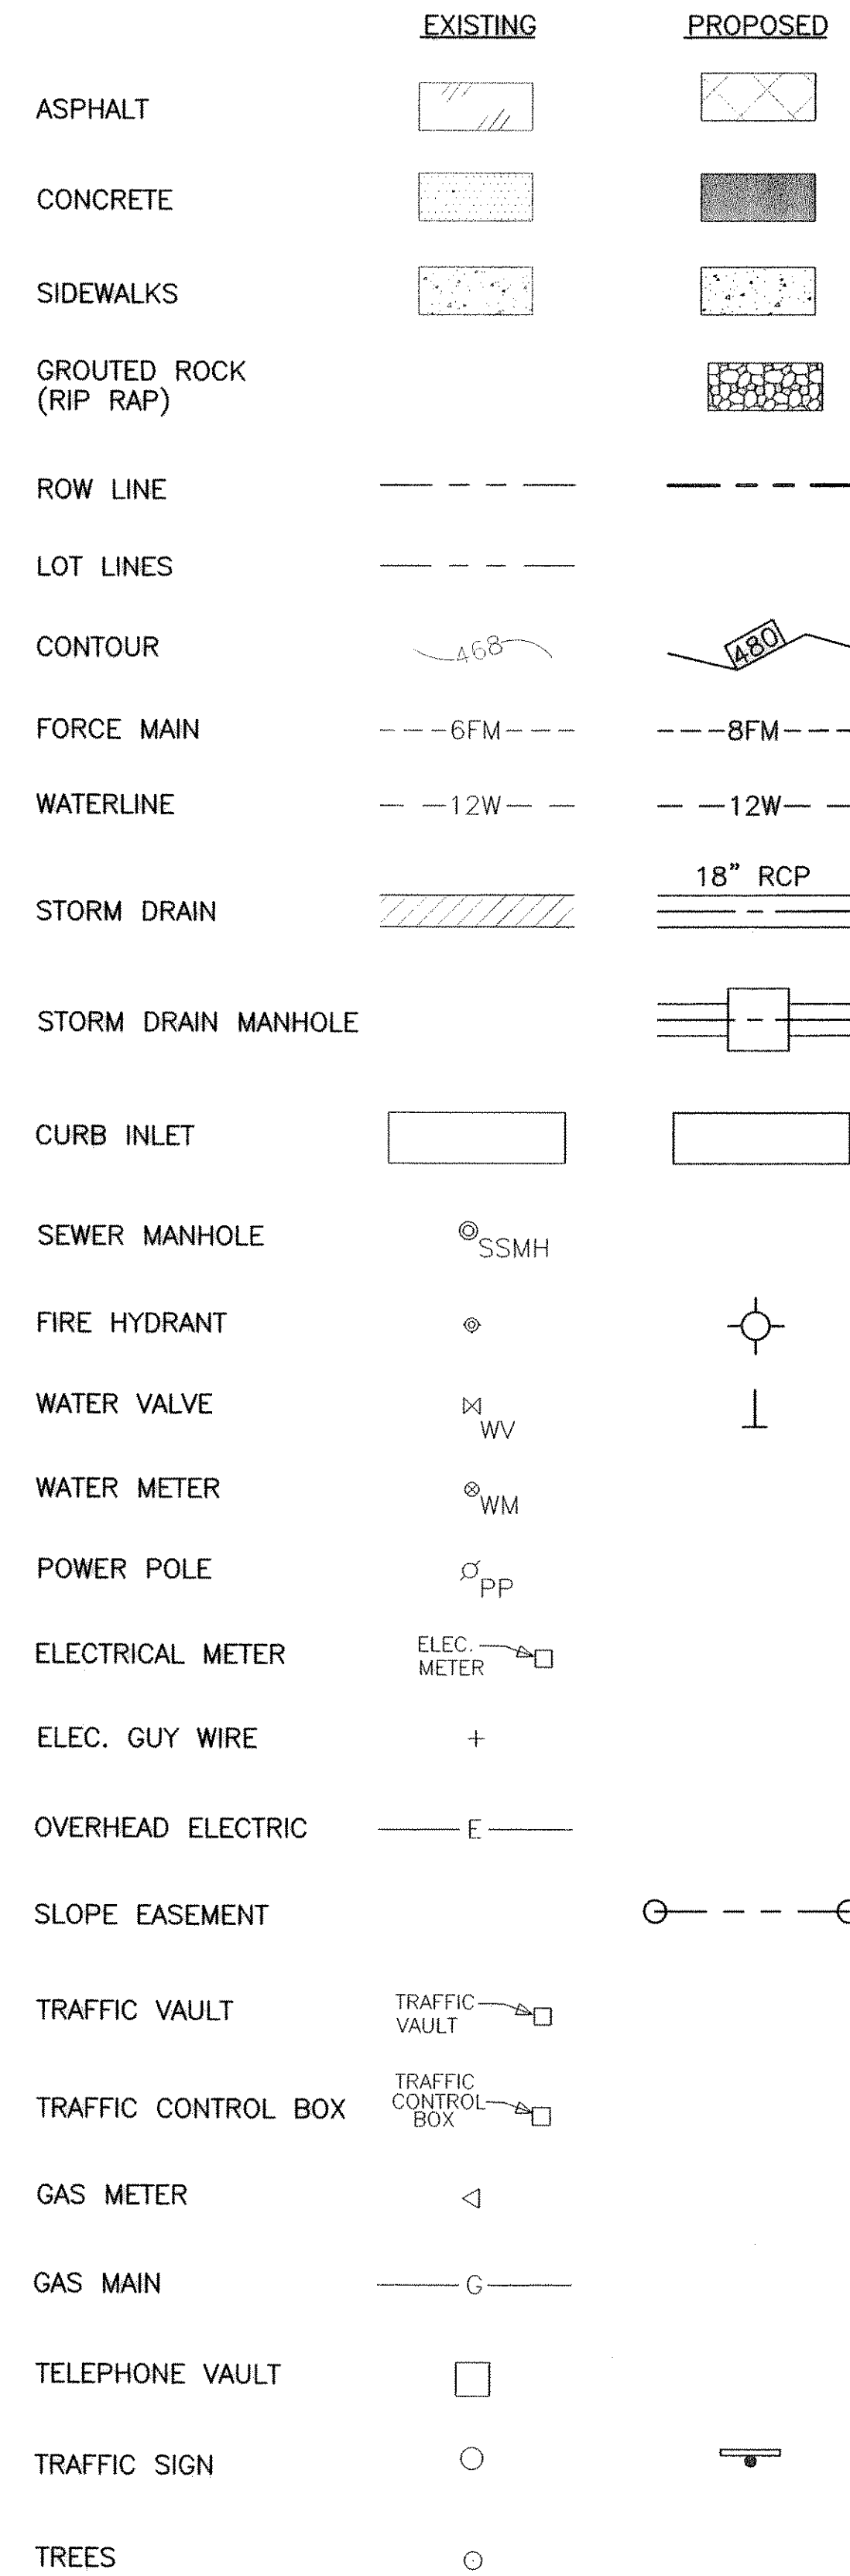


RECORD DRAWING
 BASED ON INFORMATION SUPPLIED
 BY THE CONTRACTOR
 TO: TRICIA H. HATLEY
 DATE: JANUARY 7, 2003

THIS DOCUMENT WAS ORIGINALLY
 SIGNED, SEALED AND DATED BY:
 ENGINEER: TRICIA H. HATLEY
 TEXAS REGISTRATION NO: 63282
 DATE: APRIL 17, 2002

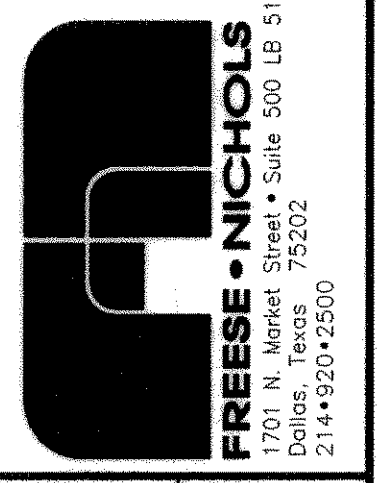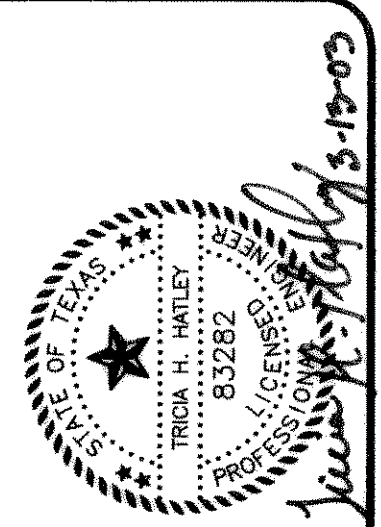

CITY OF ROCKWALL
DALTON ROAD RECONSTRUCTION
QUANTITIES AND LEGEND

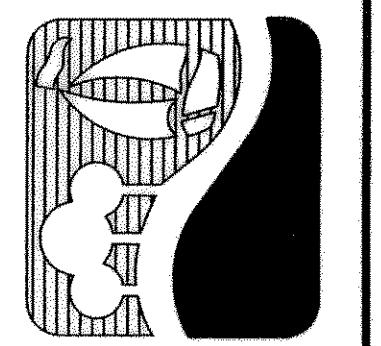

| | |
|----------|------------|
| FILE NO. | ROK01364 |
| DATE | 10-29-2002 |
| DESIGNED | KRJ/SDH |
| DRAWN | LMR |
| REVISION | |
| CHECKED | THH |

| | | |
|--------------|----|------|
| NO. REVISION | BY | DATE |
| | | |
| | | |
| | | |
| | | |

VERIFY SCALE: Bar is one inch on original drawing, if not one inch on this sheet, adjust scale.

SHEET **QTY**

SEQ. 3 OF 19