


DALTON ROAD IMPROVEMENTS


SH-205 TO HUNT LANE

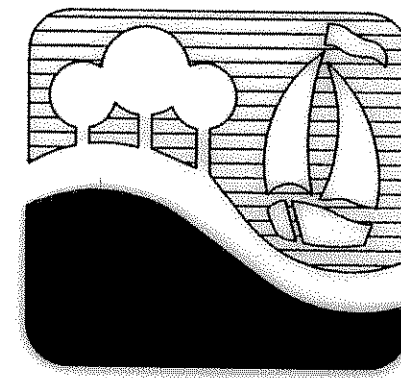

CITY OF ROCKWALL

"THE NEW HORIZON"

2002

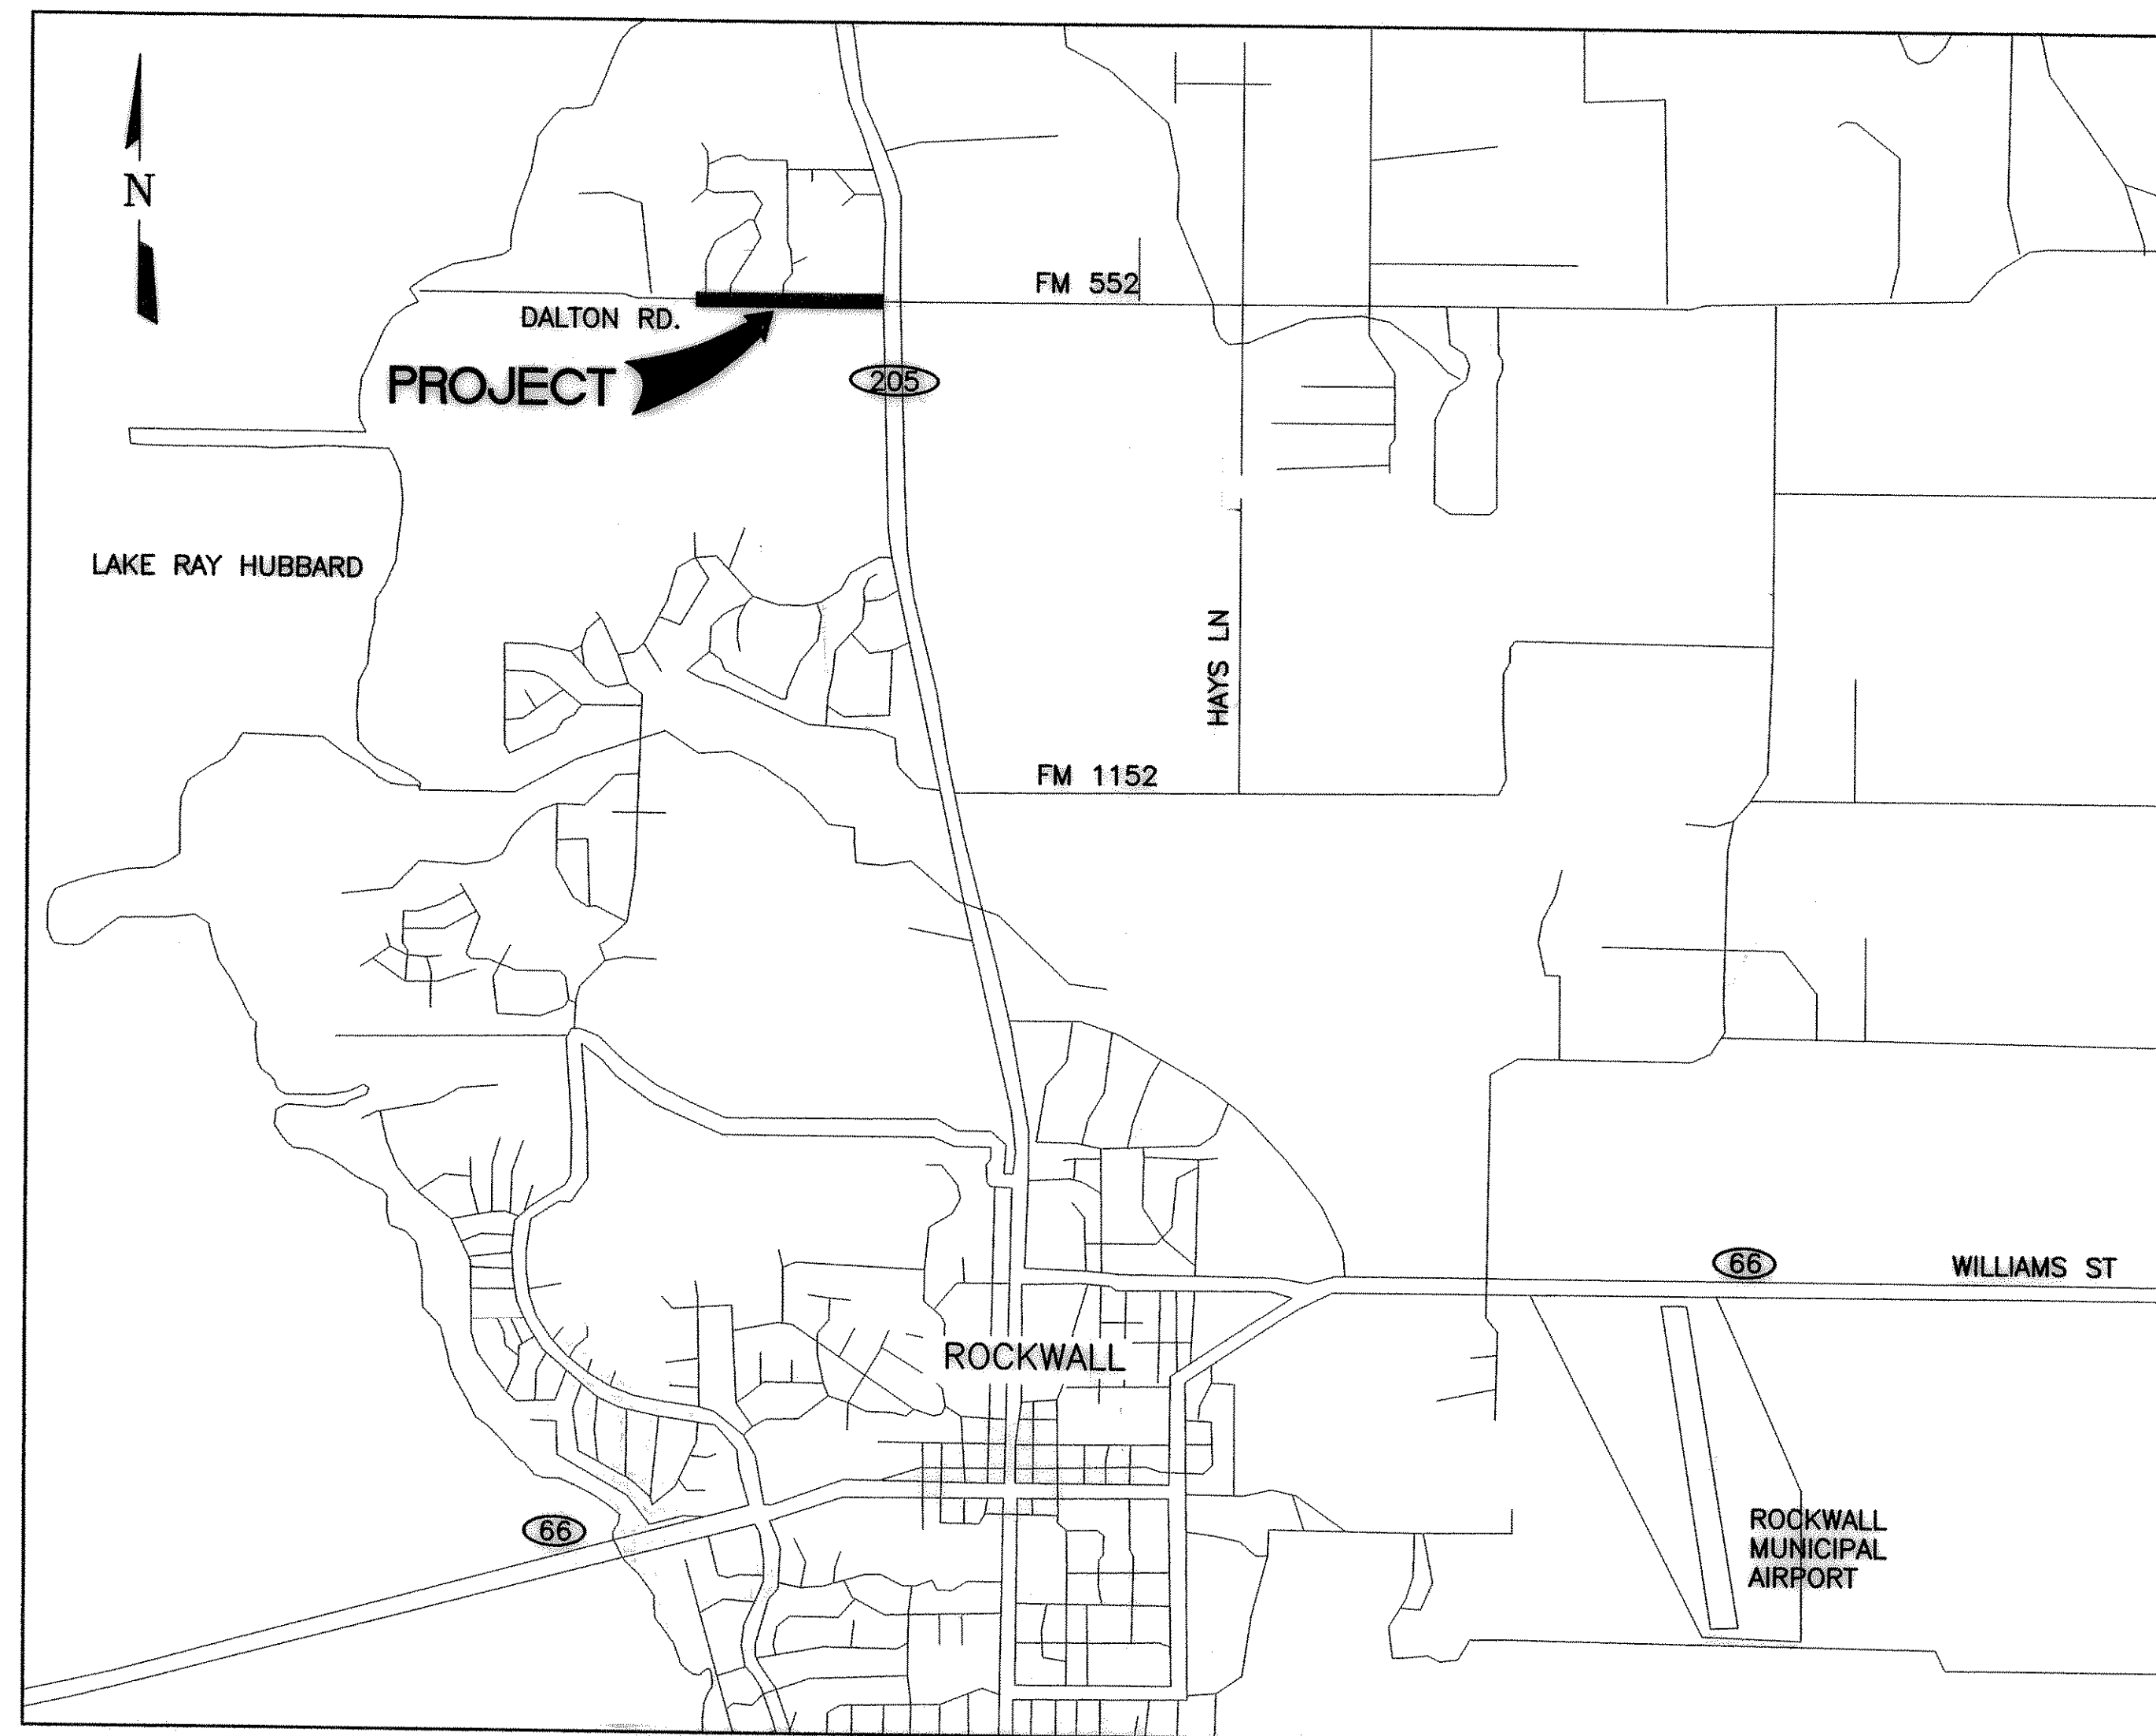

INDEX OF SHEETS

SEQ.	SHEET	SHEET DESCRIPTION
1		COVER SHEET
2	GNOTE	GENERAL NOTES AND TYPICAL SECTION
3	QTY	QUANTITIES & LEGEND
4	HORIZ-CTRL	HORIZONTAL CONTROL
5	PHASING	PHASING PLAN
6	PP-1	STA 1+00 TO 7+00 PLAN AND PROFILE
7	PP-2	STA 7+00 TO 13+00 PLAN AND PROFILE
8	PP-3	STA 13+00 TO 19+00 PLAN AND PROFILE
9	PP-4	STA 19+00 TO 25+00 PLAN AND PROFILE
10	PP-5	STA 25+00 TO END PLAN AND PROFILE
11	PDTL-1	PAVING DETAILS SHT-1
12	PDTL-2	PAVING DETAILS SHT-2
13	UTIL-DTLS1	UTILITY DETAILS SHT-1
14	DAMAP	DRAINAGE AREA MAP AND CALCULATIONS
15	SDPP-1	STORM DRAIN PLAN AND PROFILE 1
16	SDPP-2	STORM DRAIN PLAN AND PROFILE 2
17	SDPP-3	STORM DRAIN PLAN AND PROFILE 3
18	SDPP-4	STORM DRAIN PLAN AND PROFILE 4
19	SDDTL	STORM DRAIN DETAIL SHT-1

Ken Jones * Mayor

Ron Coleson

Billy Morris

Bill Cecil


John King

Bob Cotti

Terry Raulston * Mayor Pro-Tem
City Council

Julie Couch
City Manager

Chuck Todd, P.E.
Director of Public Works

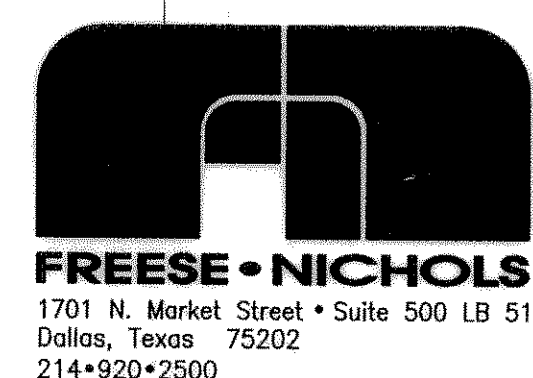


FREESE • NICHOLS
1701 N. Market Street • Suite 500 LB 51
Dallas, Texas 75202
214•920•2500

"RECORD DRAWINGS"

RECORD DRAWING
BASED ON INFORMATION SUPPLIED
BY THE CONTRACTOR
TO: TRICIA H. HATLEY
DATE: JANUARY 7, 2003

THIS DOCUMENT WAS ORIGINALLY
SIGNED, SEALED AND DATED BY:
ENGINEER: TRICIA H. HATLEY
TEXAS REGISTRATION NO: 83282
DATE: APRIL 5, 2002

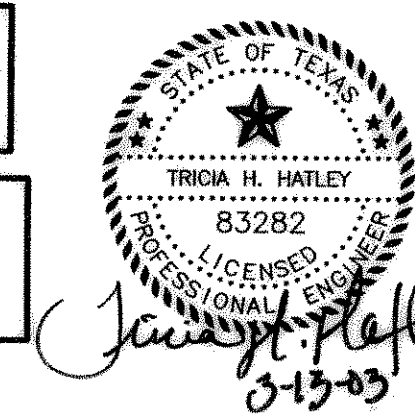

ROK01364