

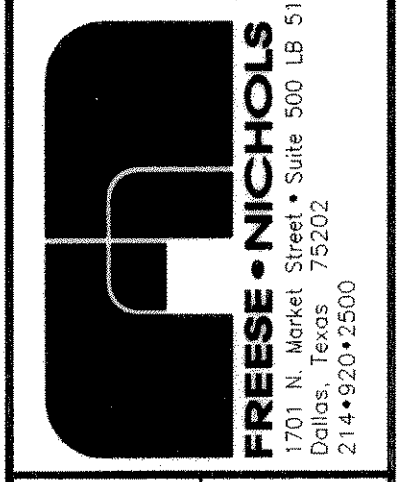
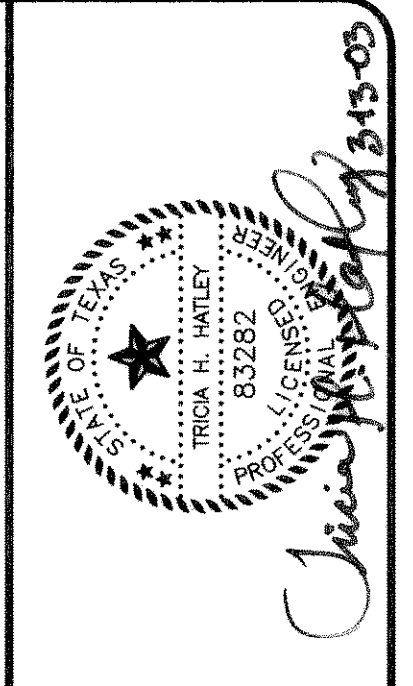


ACAD_Plan_15.06 (LWS_Text) User: RCV
 (R:\WORK\1364\N\CAD\AS-BUILTS\AS-BUILTS\PP2.DWG LAYOUT: Layout1
 MAR 11, 2003 9:29:44 A.M. LTS: 1 TWIST: 0
 6 REFERENCE FILES: N:\CAD\SHEETS\AS-BUILTS\364-BORDER, N:\CAD\SHEETS\AS-BUILTS\364-SITE, N:\CAD\SHEETS\AS-BUILTS\364-TOP, N:\CAD\SHEETS\AS-BUILTS\364-TOPO and N:\ORIGINALS\02-TOPO

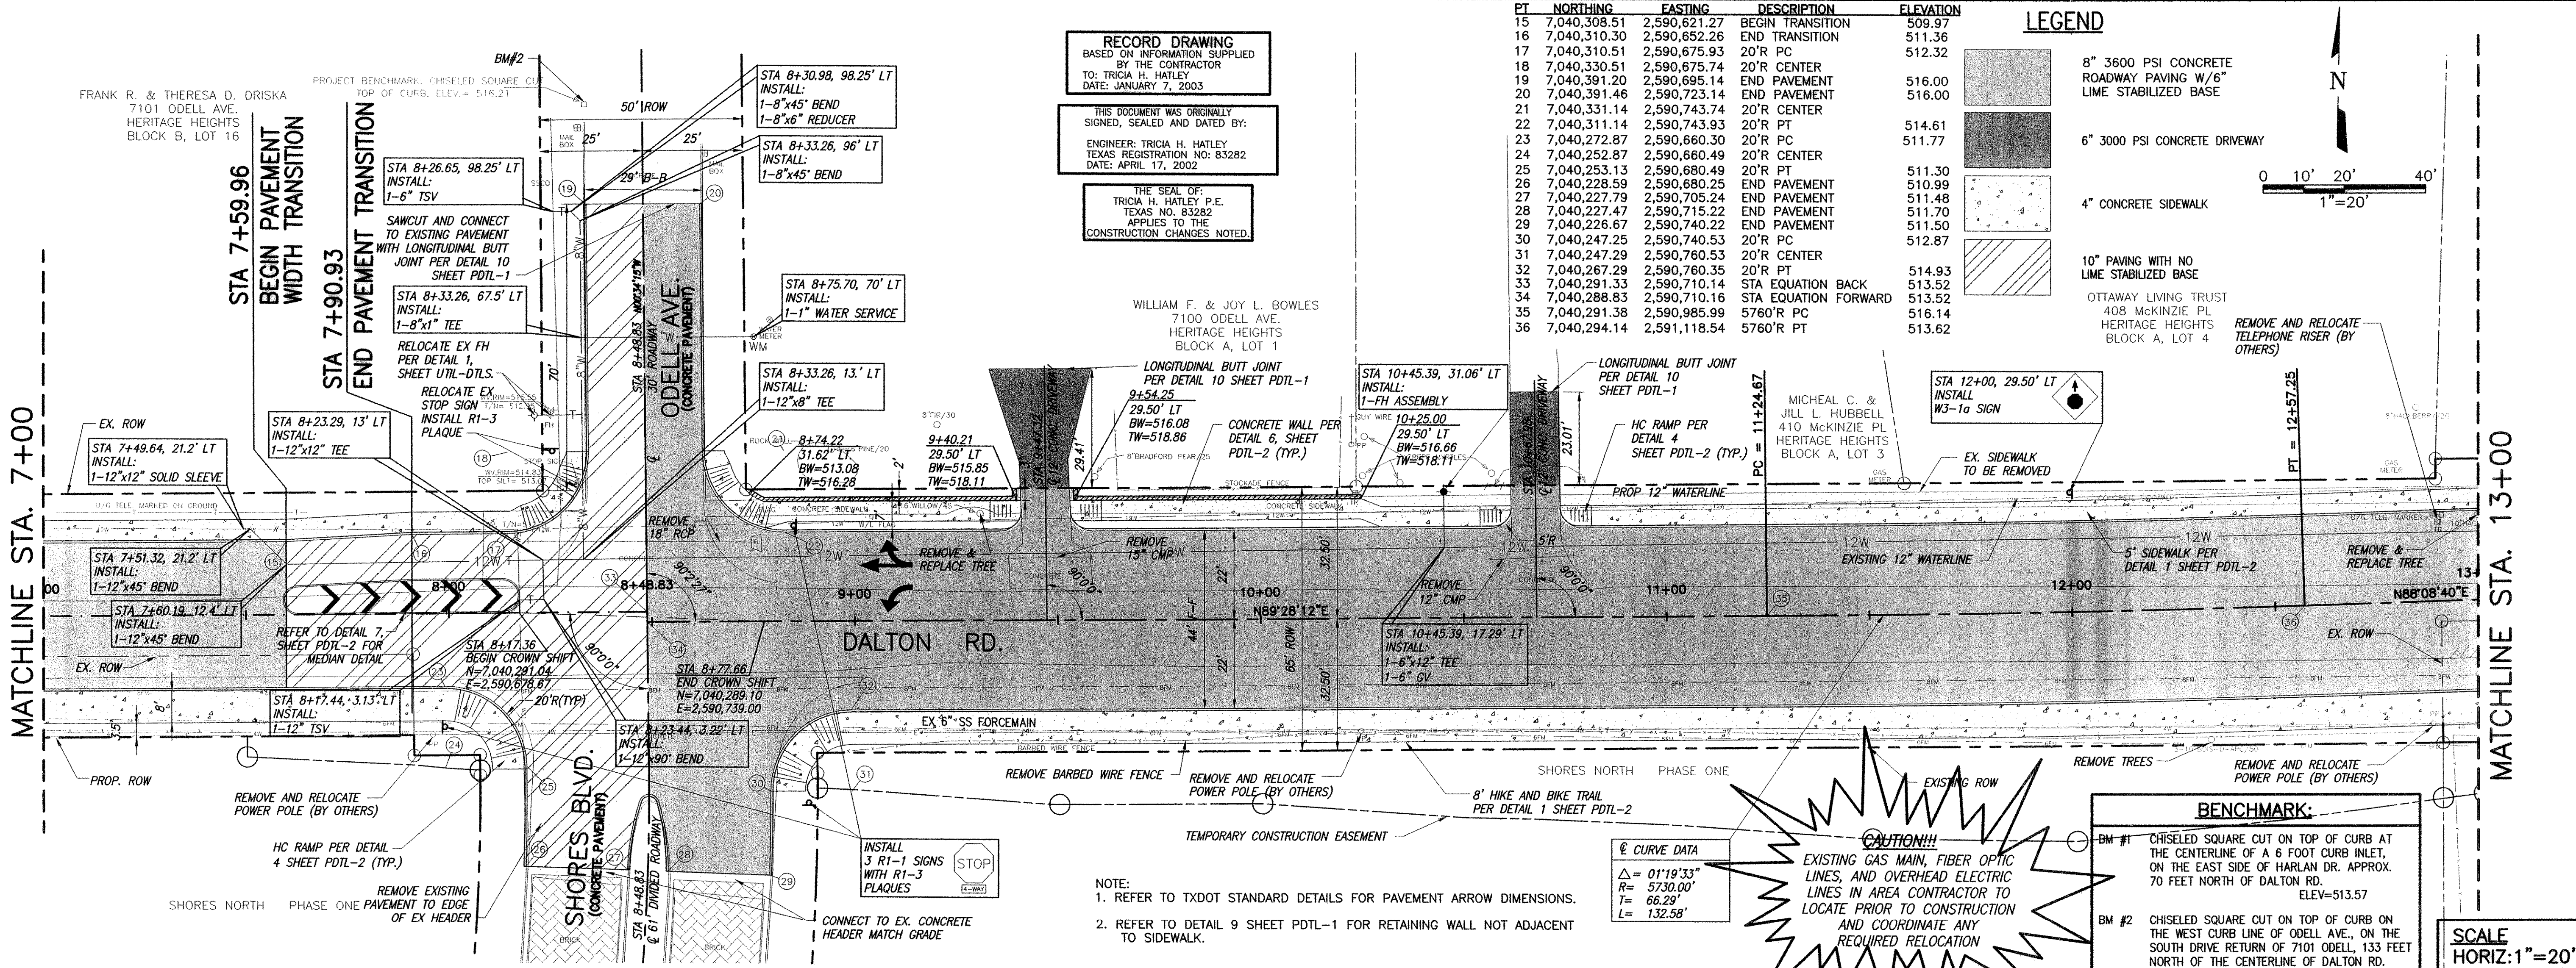

CITY OF ROCKWALL
DALTON ROAD RECONSTRUCTION
 PAVING PLAN AND PROFILE
 STA 7+00 TO STA 13+00

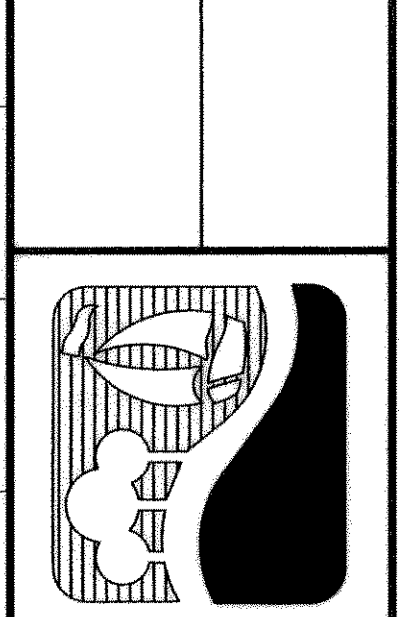

NO. REVISION	DATE	BY	DESCRIPTION
1	3/11/03	PP2.dwg	W/L & RD CHANGES PER CONTRACTOR
2	3/11/03	DESIGNED: KRJ,SDH	DESIGNED
3		DRAWN: JUS	DRAWN
4		REVIEWED: JUS	REVIEWED
5		CHECKED: THH	CHECKED

VERIFY SCALE: Bar is one inch on original drawing, if not one inch on this sheet, adjust scale.

SHEET: PP-2
 SEQ. 7 OF 19

RECORD DRAWINGS