


WARNING
S.W. BELL BURIED
TELEPHONE CABLE.
CALL ENTERPRISE 9800
72 HOURS PRIOR TO
EXCAVATION

WARNING
T.X.U. GAS LINE
NOTIFY T.X.U. GAS
72 HOURS PRIOR TO
EXCAVATION



C.W. JONES SURVEY
ABSTRACT NO. 127
MABLE DALTON
VOLUME 46, PAGE 85

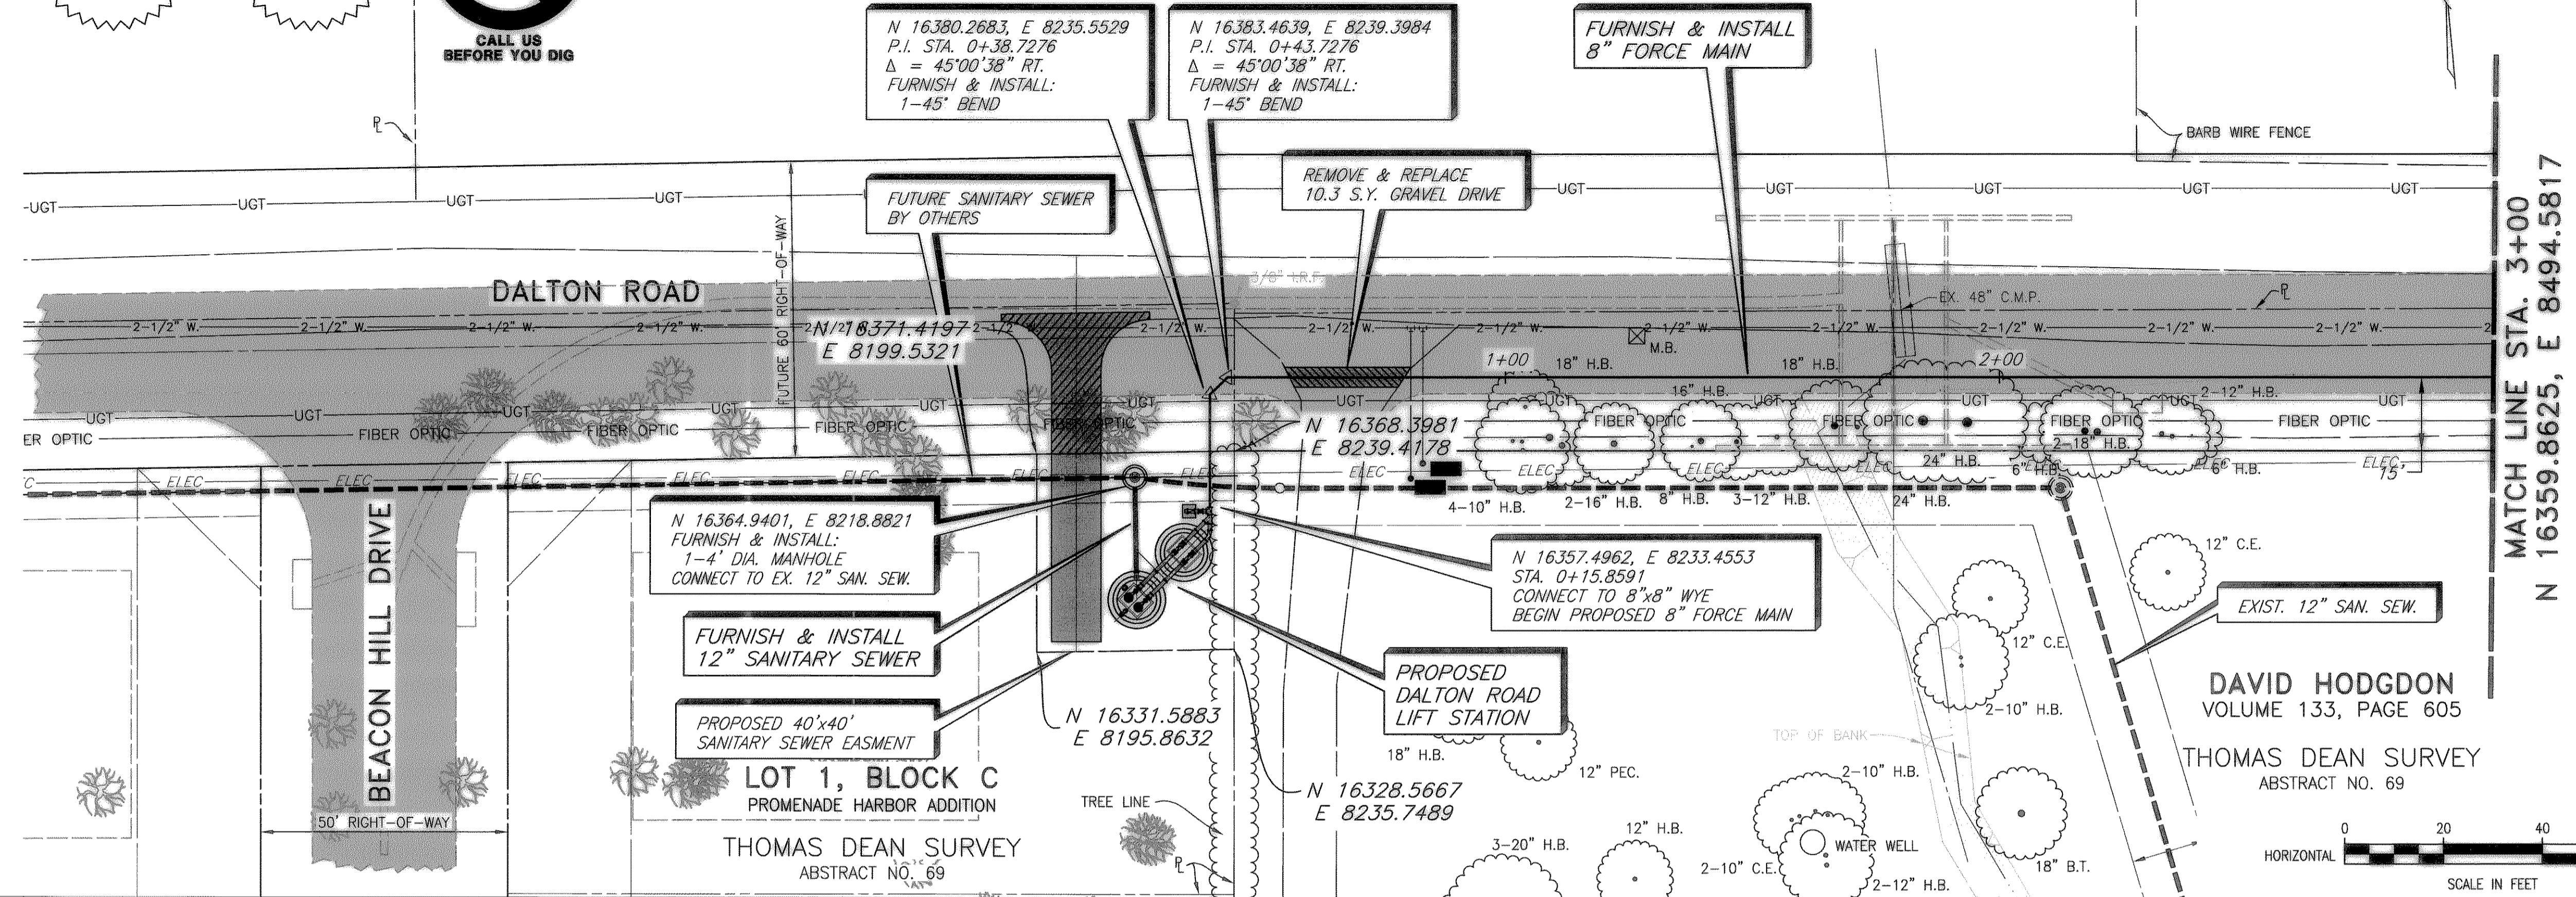

LEGEND


▬ FUTURE PAVEMENT BY OTHERS

▬ EXISTING ASPHALT PAVEMENT


T.B.M.
STA. 11+96.31, 38.97' LT.
N 16316.1170, E 9390.6695
"C" CUT ON TOP HEADWALL @
HUNT LANE.
ELEV. 495.03

B.M.
N. 16472.1670, E. 7124.5835
ALUMINUM DISC FOUND IN SOUTH
RIGHT-OF-WAY LINE OF DALTON RD.,
1,087.66 FEET WEST OF CENTERLINE
OF PROPOSED ACCESS ROAD.
ELEV. 443.29

DAVID HODGDON
VOLUME 133, PAGE 605
THOMAS DEAN SURVEY
ABSTRACT NO. 69

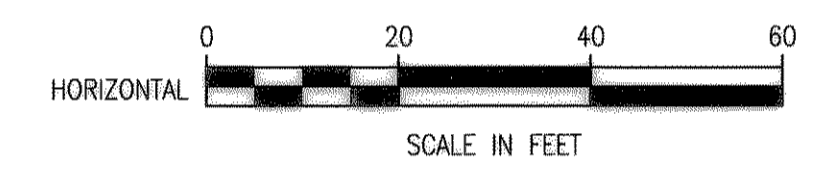

These plans and related specifications were prepared for construction of this specific project only. Reuse of these documents is not permitted without written authorization of Birkhoff, Hendricks, & Conway, L.L.P.

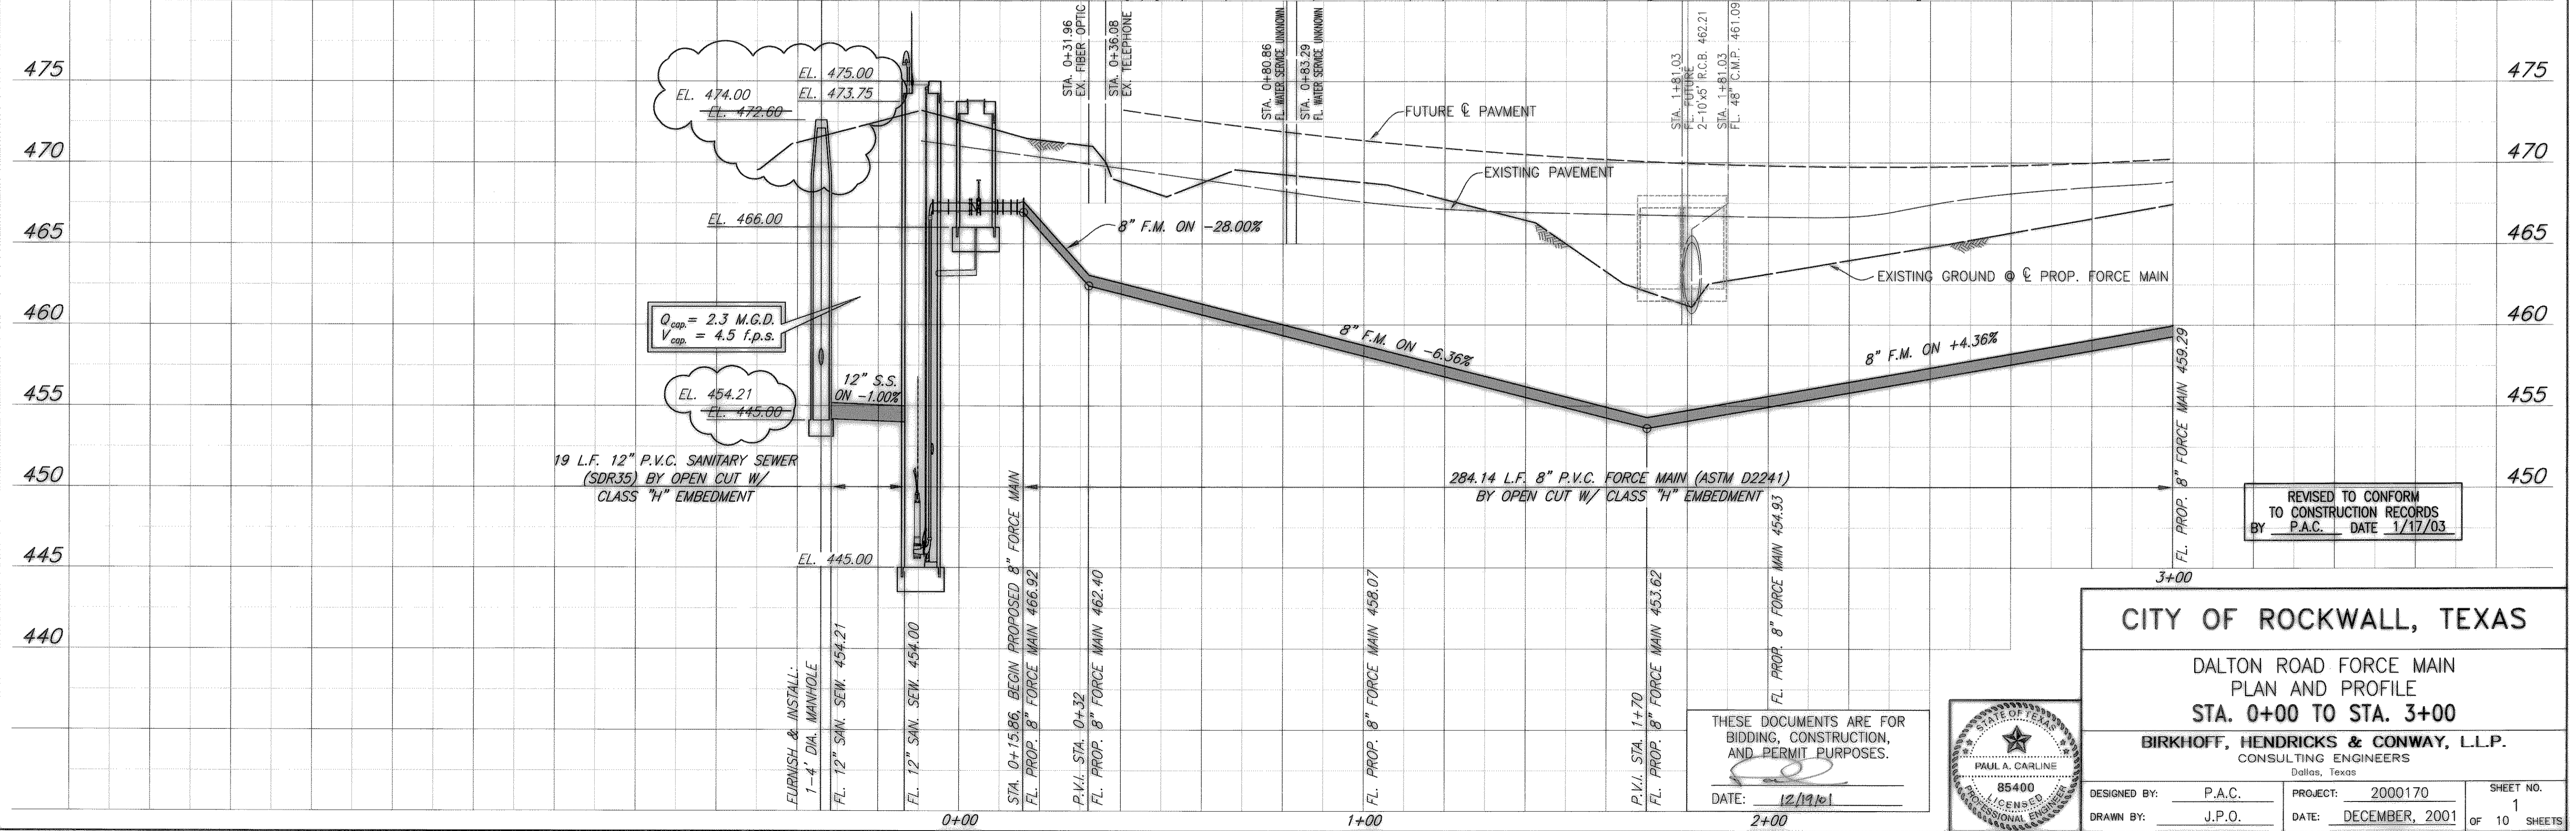


REVISED TO CONFORM
TO CONSTRUCTION RECORDS
BY P.A.C. DATE 1/17/03

CITY OF ROCKWALL, TEXAS

DALTON ROAD FORCE MAIN
PLAN AND PROFILE
STA. 0+00 TO STA. 3+00

BIRKHOFF, HENDRICKS & CONWAY, L.L.P.
CONSULTING ENGINEERS
Dallas, Texas

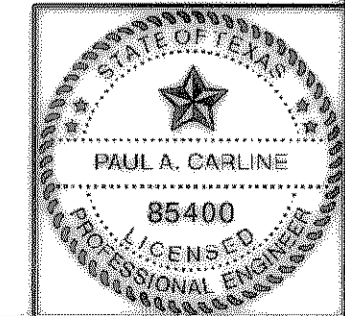

DESIGNED BY: P.A.C. PROJECT: 2000170 SHEET NO. 1
DRAWN BY: J.P.O. DATE: DECEMBER, 2001 OF 10 SHEETS

THESE DOCUMENTS ARE FOR
BIDDING, CONSTRUCTION,
AND PERMIT PURPOSES.
DATE: 12/19/01

Revised: 12/19/2001 JPO H:\Projects\Rockwall\2000170\Plans\Sheets\2000170-501.dwg Xref: Master: 170