

CHARLES W. JONES SURVEY
ABSTRACT NO. 127
OTTAWAY LIVING TRUST
(GAIL OTTAWAY, TRUSTEE)
VOLUME 1654, PAGE 273
(HERITAGE HEIGHTS ADDITION, LOT 4, BLOCK A)

CHARLES W. JONES SURVEY
ABSTRACT NO. 127
THOMAS J. & TONYA A. BOMKAMP
VOLUME 1018, PAGE 125
(HARLAN PARK, PHASE I ADDITION, LOT 13, BLOCK A)

CHARLES W. JONES SURVEY
ABSTRACT NO. 127
DAVID J. & CYNTHIA K. SCHULZE
VOLUME 772, PAGE 274
(HARLAN PARK, PHASE I ADDITION, LOT 1, BLOCK B)

MATCH LINE STA. 18+00
N 16224.4418, E 9988.4999

MATCH LINE STA. 23+00
N 16180.6969, E 10486.5814

SHORES NORTH, PHASE V ADDITION
THOMAS DEAN SURVEY
ABSTRACT NO. 69

**RICHARD H. PETERSEN, JR.
AND WIFE SANDRA PETERSEN**
VOLUME 240, PAGE 595

W.G. DEWESSE
ABSTRACT NO. 71

WARNING
S.W. BELL BURIED
TELEPHONE CABLE
CALL ENTERPRISE 9800
72 HOURS PRIOR TO
EXCAVATION

WARNING
T.X.U. GAS LINE
NOTIFY T.X.U. GAS
72 HOURS PRIOR TO
EXCAVATION



CALL US
BEFORE YOU DIG

FURNISH & INSTALL
8" FORCE MAIN

N 16211.2435, E 10144.7910
P.I. STA. 19+56.8993
Δ = 00°16'48" RT.
PULL PIPE FOR DEFLECTION


REMOVE & REPLACE
5 L.F. 36" C.M.P. CULVERT

LEGEND


- FUTURE PAVEMENT BY OTHERS
- EXISTING ASPHALT PAVEMENT

T.B.M.
STA. 11+96.31, 38.97' LT.
N 16316.1170, E 9390.6695
"X" CUT ON TOP HEADWALL @
HUNT LANE.
ELEV. 495.03

B.M.
N. 16472.1670, E. 7124.5835
ALUMINUM DISC FOUND IN SOUTH
RIGHT-OF-WAY LINE OF DALTON RD.,
1,087.66 FEET WEST OF CENTERLINE
OF PROPOSED ACCESS ROAD.
ELEV. 443.29

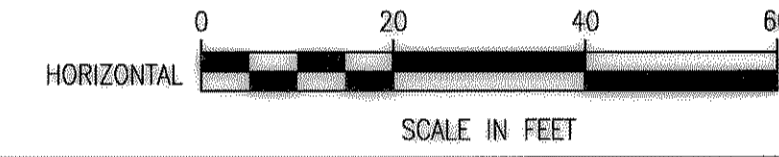

These plans and related specifications were prepared for construction of this specific project only. Reuse of these documents is not permitted without written authorization of Birkhoff, Hendricks, & Conway, L.L.P.

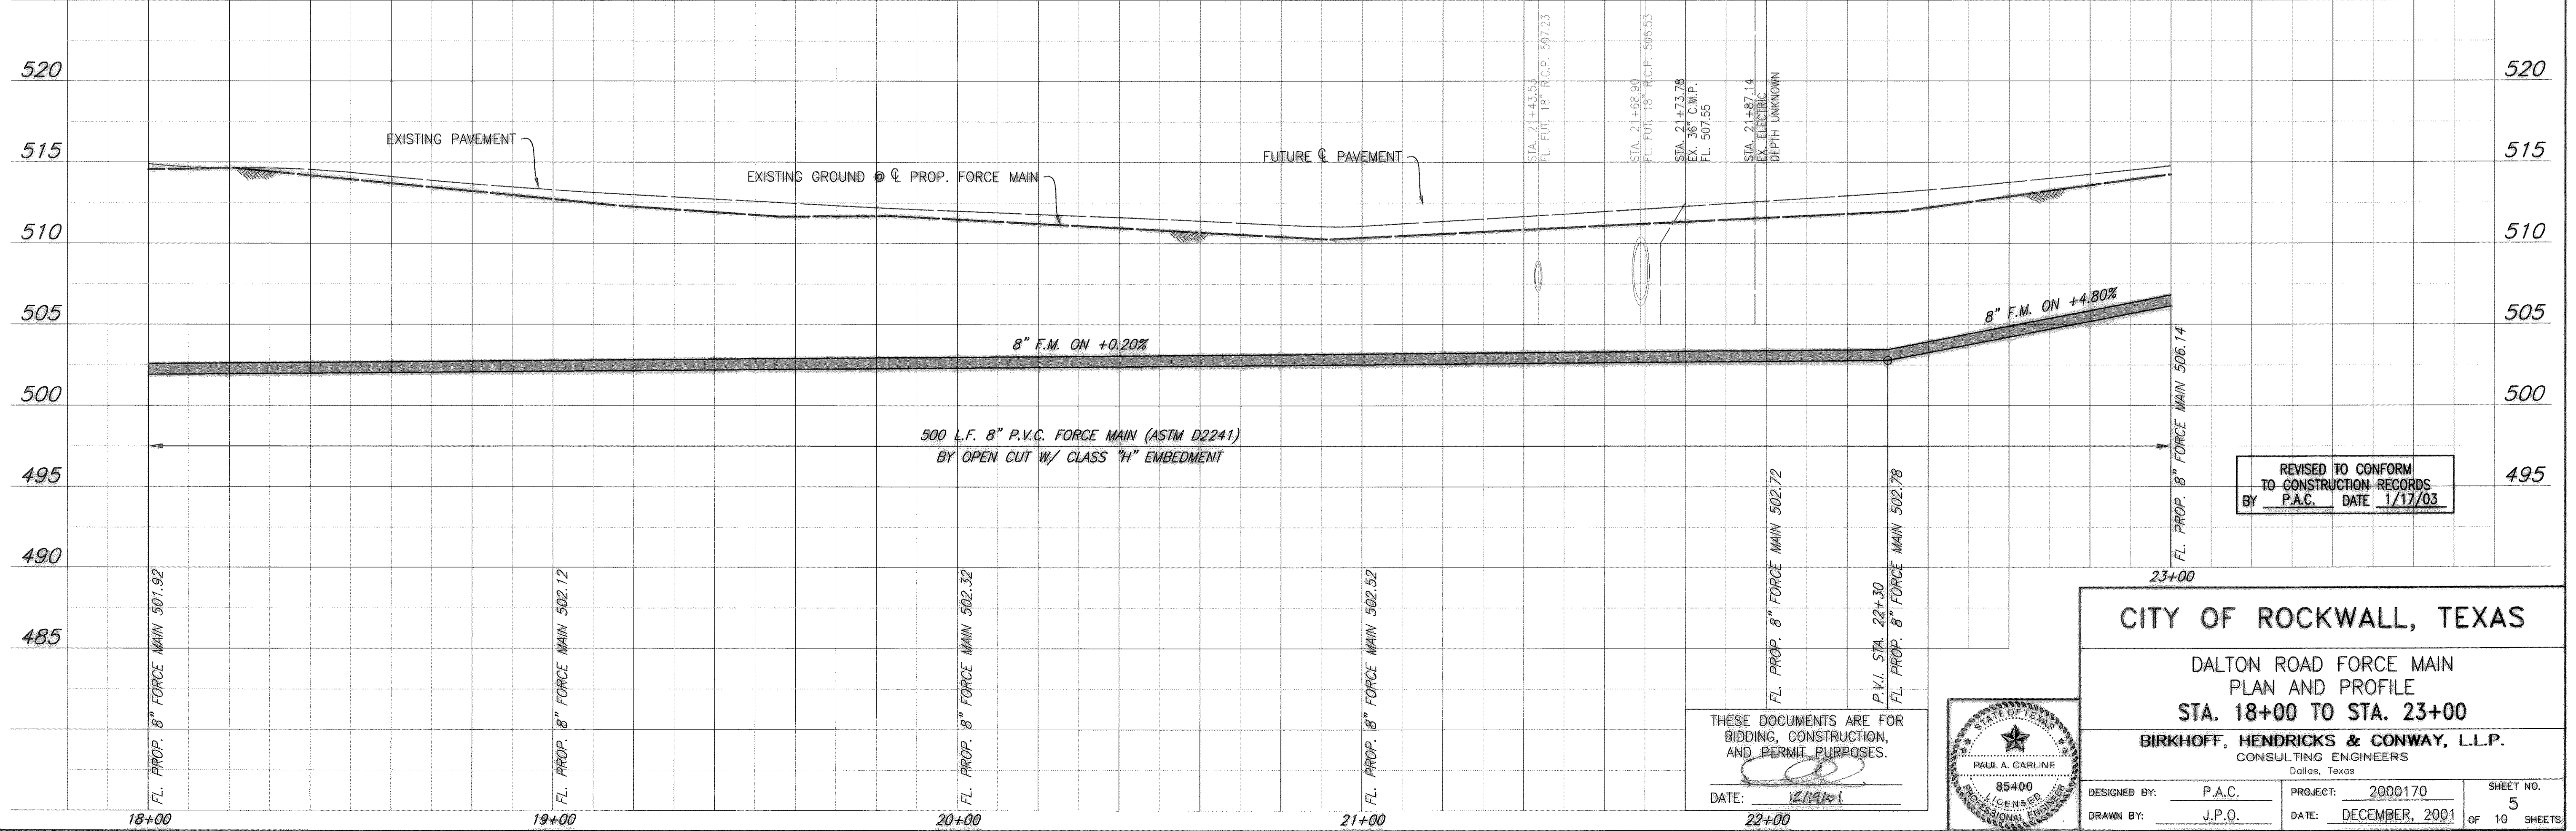

REVISED TO CONFORM
TO CONSTRUCTION RECORDS
BY P.A.C. DATE 1/17/03

THESE DOCUMENTS ARE FOR
BIDDING, CONSTRUCTION,
AND PERMIT PURPOSES.
DATE: 12/19/01



CITY OF ROCKWALL, TEXAS

DALTON ROAD FORCE MAIN
PLAN AND PROFILE
STA. 18+00 TO STA. 23+00

BIRKHOFF, HENDRICKS & CONWAY, L.L.P.
CONSULTING ENGINEERS
Dallas, Texas

DESIGNED BY: P.A.C. PROJECT: 2000170 SHEET NO. 5
DRAWN BY: J.P.O. DATE: DECEMBER, 2001 OF 10 SHEETS

Revised: 12/19/2001 JPO H:\Projects\Rockwall\2000170\Plans\Sheets\2000170-505.dwg Xrefs: Master 170, Master Profile