


MATCH LINE STA. 28+00
N 16136.1881, E 10984.5964

MATCH LINE STA. 33+00
N 16091.6793, E 11482.6114

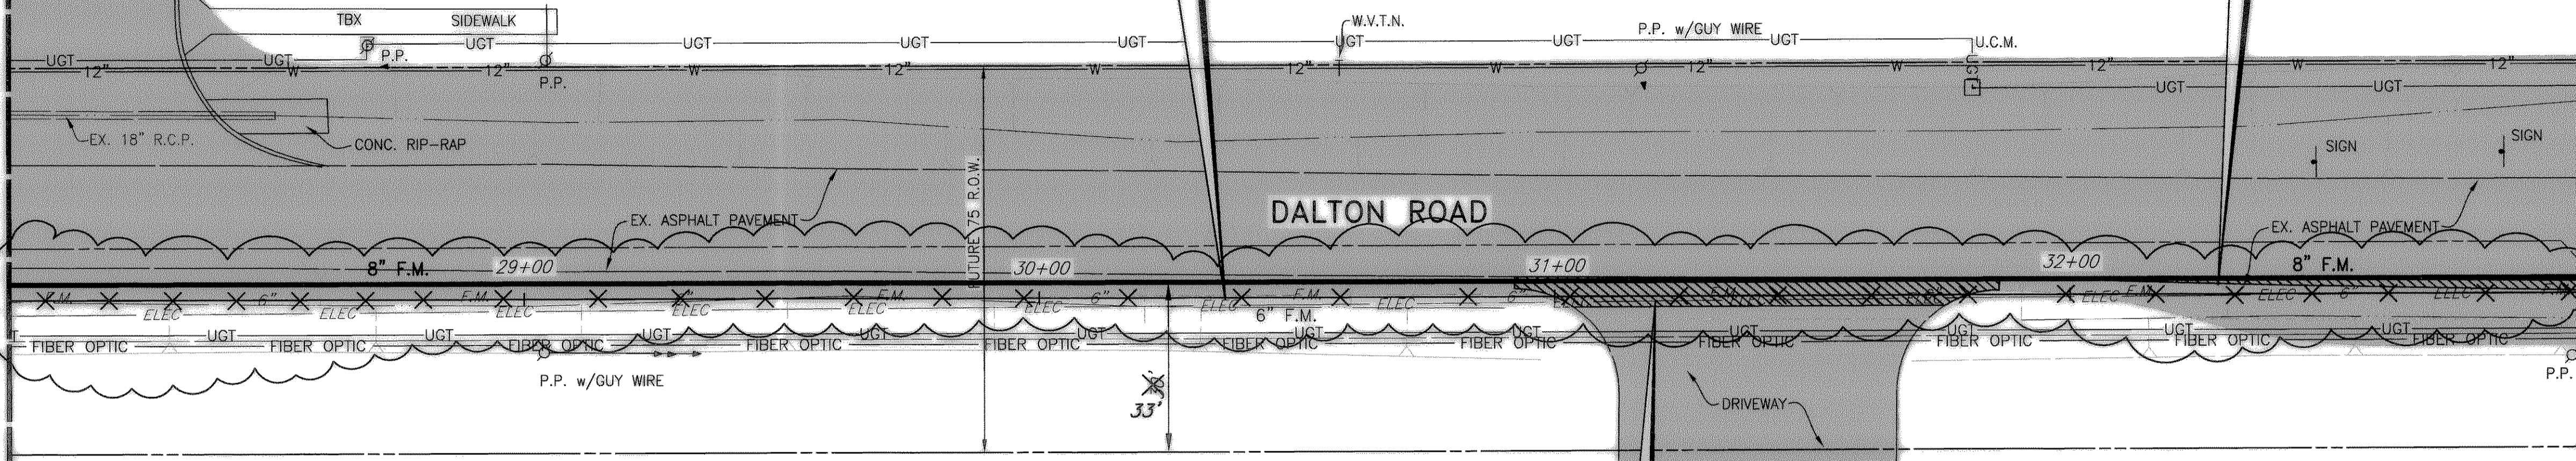

LEGEND

■ FUTURE PAVEMENT BY OTHERS

▨ EXISTING ASPHALT PAVEMENT

T.B.M.
STA. 11+96.31, 38.97' LT.
N 16316.1170, E 9390.6695
"C" CUT ON TOP HEADWALL @
HUNT LANE.
ELEV. 495.03

B.M.
N. 16042.9053, E. 11715.2592
CONCRETE RIGHT-OF-WAY MONUMENT
@ THE INTERSECTION OF THE EAST
RIGHT-OF-WAY LINE OF DALTON ROAD
AND SOUTH RIGHT-OF-WAY LINE OF
STATE HIGHWAY NO. 205
ELEV. 543.16


WARNING
S.W. BELL BURIED
TELEPHONE CABLE
CALL ENTERPRISE 9800
72 HOURS PRIOR TO
EXCAVATION

WARNING
T.X.U. GAS LINE
NOTIFY T.X.U. GAS
72 HOURS PRIOR TO
EXCAVATION


**CALL US
BEFORE YOU DIG**

**THE FREE METHODIST CHURCH
OF NORTH AMERICA ADDITION**
CABINET D, SLIDE 247 AND 248

W.G. DEWESSE
ABSTRACT NO. 71

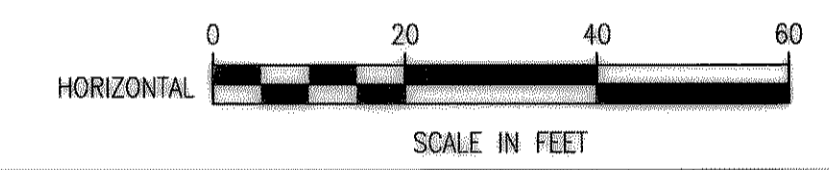


These plans and related specifications were prepared for construction of this specific project only. Reuse of these documents is not permitted without written authorization of Birkhoff, Hendricks, & Conway, L.L.P.

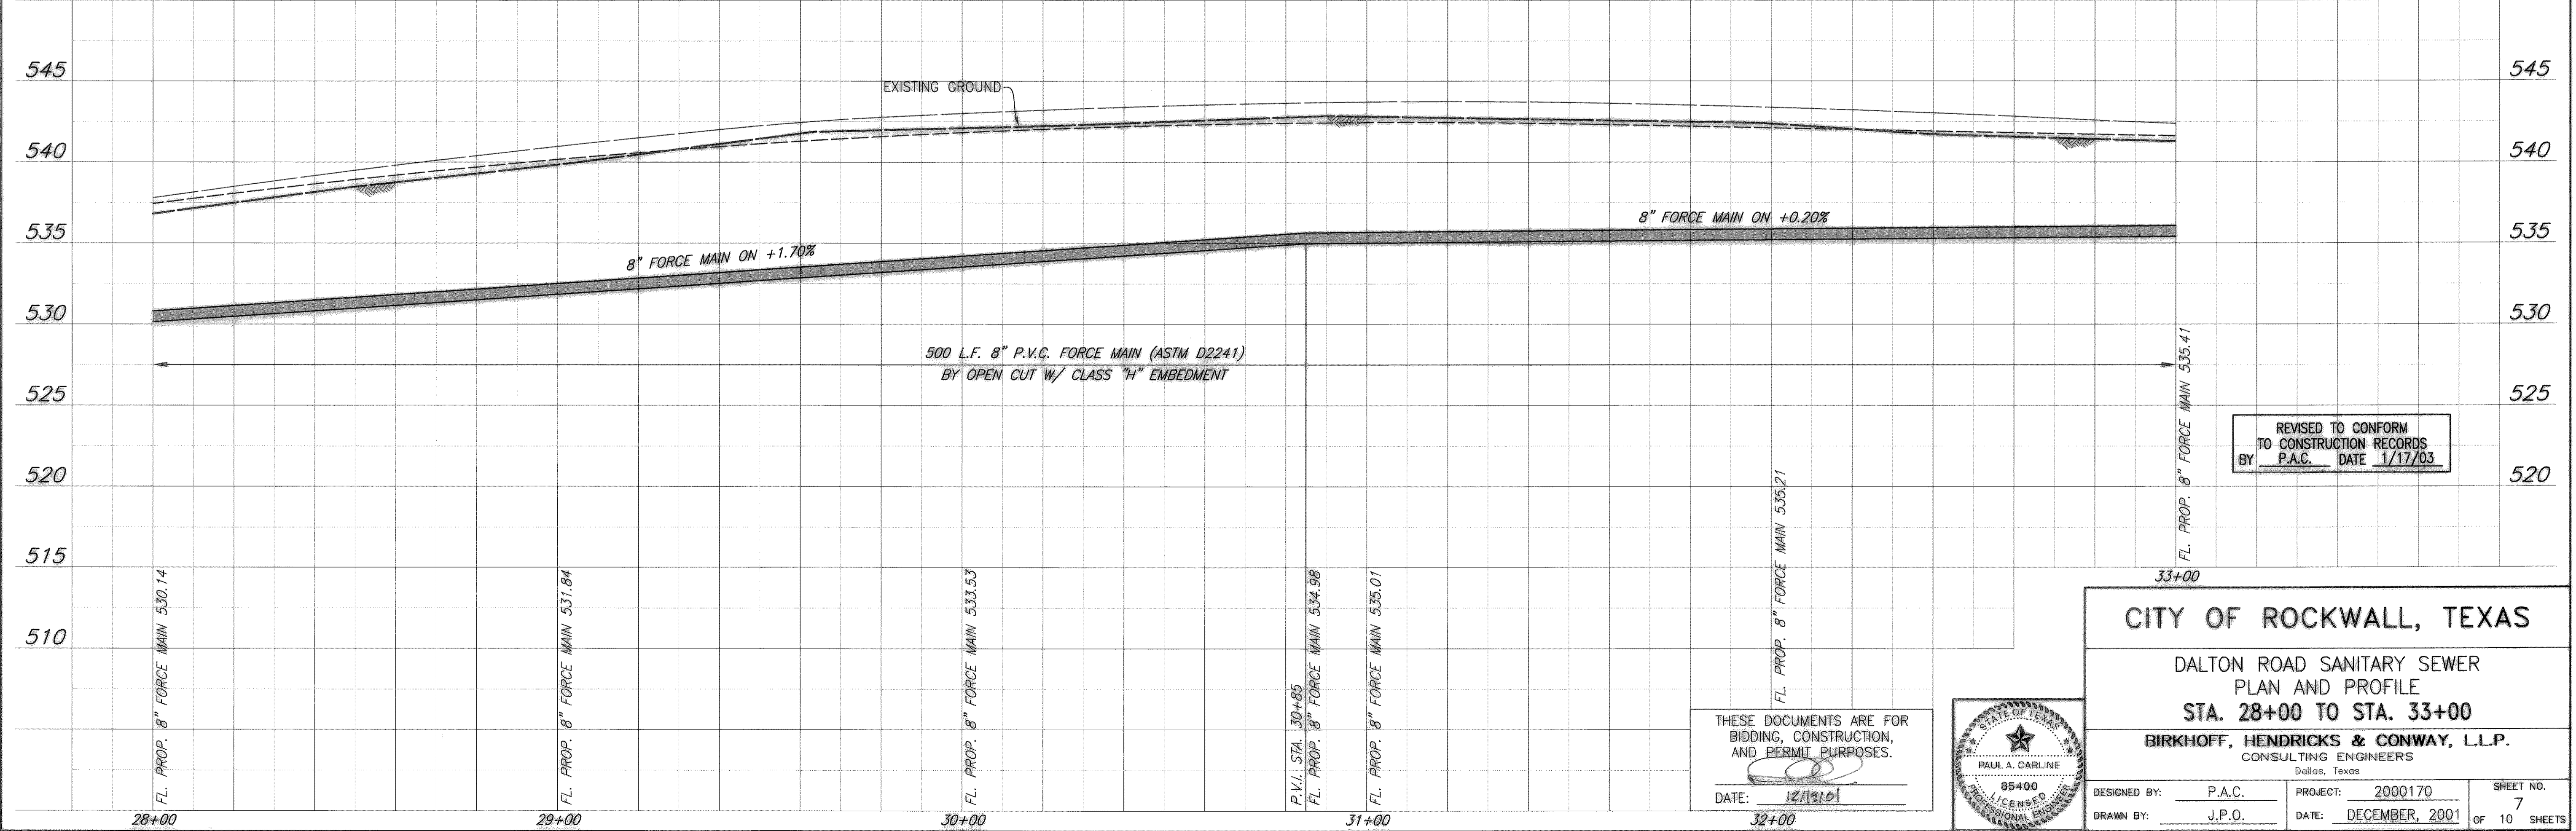

REVISED TO CONFORM
TO CONSTRUCTION RECORDS
BY P.A.C. DATE 1/17/03

THESE DOCUMENTS ARE FOR
BIDDING, CONSTRUCTION,
AND PERMIT PURPOSES.

DATE: 12/17/01

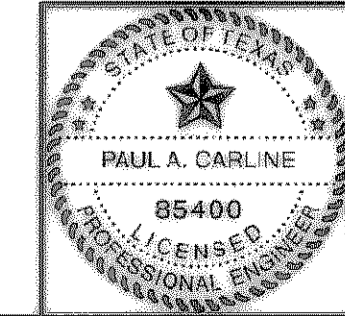

CITY OF ROCKWALL, TEXAS

DALTON ROAD SANITARY SEWER
PLAN AND PROFILE
STA. 28+00 TO STA. 33+00

BIRKHOFF, HENDRICKS & CONWAY, L.L.P.
CONSULTING ENGINEERS
Dallas, Texas

DESIGNED BY: P.A.C. PROJECT: 2000170 SHEET NO. 7
DRAWN BY: J.P.O. DATE: DECEMBER, 2001 OF 10 SHEETS

Revised: 12/17/2001 JPO H:\Projects\Rockwall\2000170\Plans\Sheets\2000170-307.dwg Xrefs: Master 170, Master Profile