


- ① - STA. 4+71.40  
INSTALL: 1-8" 45° BEND
- ② - STA. 8+25.83  
INSTALL: 1-8" 45° BEND
- ③ - STA. 8+25.83  
INSTALL: 1-8" 45° BEND
- ④ - STA. 8+90.39  
INSTALL: 1-8" 45° BEND
- ⑤ - STA. 8+90.39  
INSTALL: 1-8" 45° BEND
- ⑥ - STA. 9+54.77  
INSTALL: 1-8" 45° BEND
- ⑦ - STA. 10+04.28  
INSTALL: 1-8" 45° BEND
- ⑧ - STA. 10+14.19  
INSTALL: 1-8" 45° BEND
- ⑨ - STA. 10+56.54  
INSTALL: 1-8" 45° BEND
- ⑩ - STA. 10+94.66  
INSTALL: 1-8" 45° BEND

NOTE:  
CONNECT ALL EXISTING METERS TO PROPOSED  
WATER LINE

8" WATER LINE STA. 0+00 TO 1+00  
DOBBS WATER LINE  
ROCKWALL, TEXAS

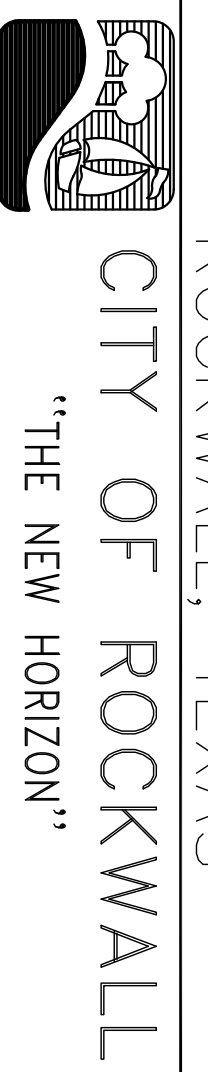

REVISION NO.	REMARKS	DATE

DESIGNED:	B.W.H.	THE SEAL APPEARING ON THIS DOCUMENT WAS AUTHORIZED BY CHARLES A. TODD TEXAS P.E. NO. 35647 ON
DRAWN:	ACAD	
JOB NO.		DATE:
		SHEET NO.

