


UTILITY EXCAVATION &
EMBEDMENT DETAIL

N.T.S.

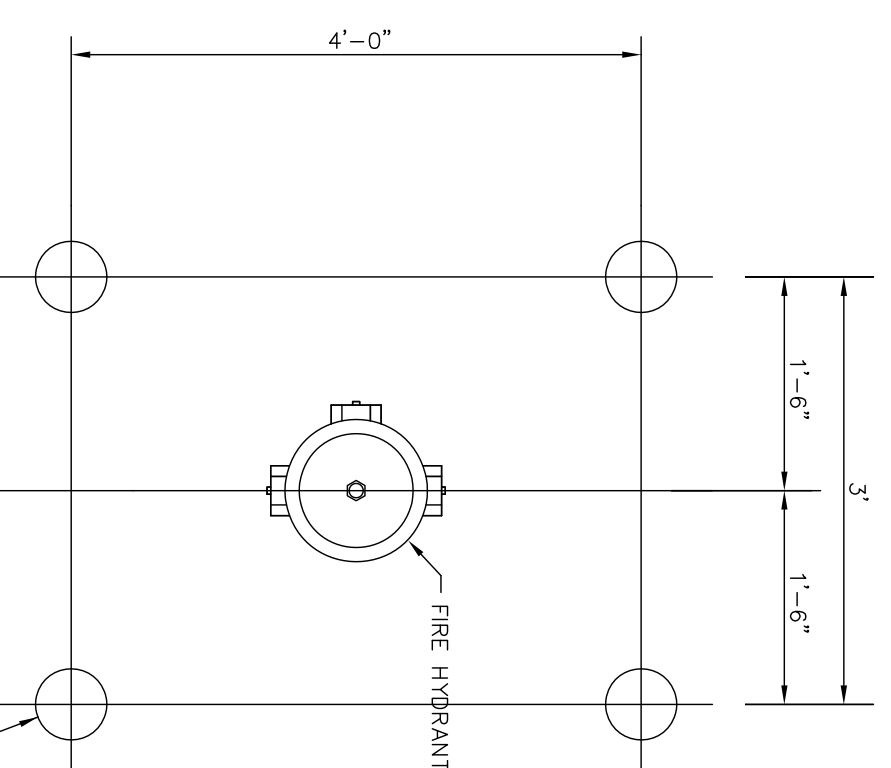


FIRE HYDRANT
GUARD POST DETAIL

N.T.S.

- NOTES:
1. PAYMENT TO THE CONTRACTOR FOR REPLACEMENT OF PAVEMENT AND/OR DRIVEWAYS WILL BE BASED ON ACTUAL MEASUREMENTS UP TO A MAXIMUM WIDTH EQUAL TO THE CONTRACTOR.
 2. WHEN REMOVING CONCRETE PAVEMENT, THE CONTRACTOR SHALL ENSURE TO LIMIT DAMAGE TO EXISTING REINFORCEMENT SO IT MAY BE REUSED IN THE REPLACEMENT OPERATIONS. IF ORIGINAL REINFORCEMENT IS NOT IN BOND, NEW REINFORCEMENT SHALL BE INSTALLED BY DRILLING AND SPLICING AS DIRECTED BY THE OWNER.

NOTE:
CONNECT ALL EXISTING METERS TO PROPOSED
WATER LINE

REVISION NO.	REMARKS	DATE

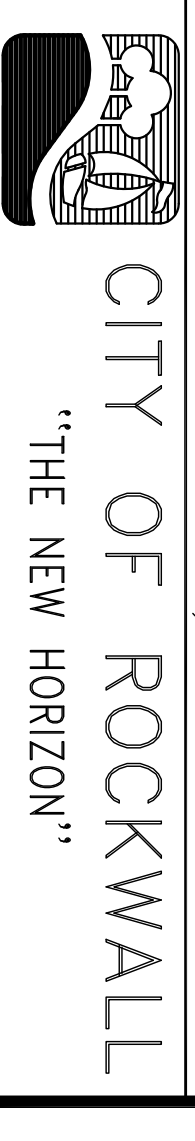

8" WATER LINE STA 11+00 - 17+66.
DOBBS WATER LINE
ROCKWALL, TEXAS
"THE NEW HORIZON"

DESIGNED: B.W.H.
DRAWN: A.C.A.D.
DATE: _____
SHEET NO. _____

