
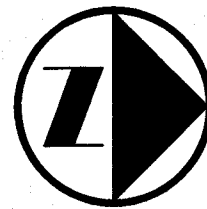


MATCH LINE - SHEET C6-5

MATCH LINE - SHEET C6-8

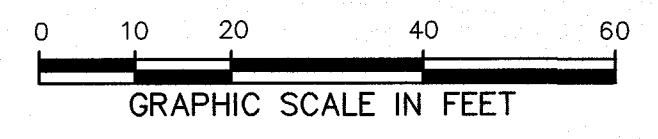


**LEGEND**

B	BOLLARD	FL	FLOOD LIGHT
EM	ELECTRIC METER	FP	FLAG POLE
PP	POWER POLE	SIGL	TRAFFIC SIGN
LS	LIGHT STANDARD	IRS	1/2-INCH IRON ROD
WM	WATER METER	(C.M.)	W/PACHECO KOCH® CAP SET
WV	WATER VALVE		CONTROLLING MONUMENT
ICV	IRRIGATION CONTROL VALVE	---	PROPERTY LINE
PH	FIRE HYDRANT	X	FENCE
CN	CLEANOUT	OH	OVERHEAD UTILITY LINE
MH	MANHOLE	E	UNDERGROUND ELECTRIC LINE
TSC	TRAFFIC SIGNAL CONTROL	T	UNDERGROUND TELEPHONE LINE
TSP	TRAFFIC SIGNAL POLE	C	UNDERGROUND CABLE LINE
TELE	TELEPHONE BOX	6"W	UNDERGROUND WATER LINE
		6"SS	UNDERGROUND SANITARY SEWER LINE


**BENCH MARK LIST**

BM # 1	"+" SET IN BOX ON CURB INLET ON NORTHWEST CORNER OF ALAMO ST. AND GOLIAD ST.	ELEV=574.54
BM # 2	"+" SET IN BOX ON BACK OF CURB ON SOUTH SIDE OF A CURB RETURN TO A PARKING LOT ON EAST SIDE OF FANNIN ST. ±7 FEET SOUTH OF OLIVE ST.	ELEV=573.63
BM # 3	"+" SET IN BOX ON SOUTH WEST CORNER OF GOLIAD ST. AND KAUFMAN ST. ±40 FEET WEST OF CL OF GOLIAD ST. AND ±25 FEET SOUTH OF CL OF KAUFMAN	ELEV=587.41
BM # 4	"+" SET IN BOX ON NORTH EAST CORNER OF N. FANNIN ST. AND KAUFMAN ST. ±15 FEET NORTH OF CL OF KAUFMAN ST. AND ±30 FEET EAST FROM CL OF KAUFMAN ST.	ELEV=578.80
BM # 5	"+" SET IN BOX ON NORTH WEST CORNER OF WASHINGTON ST. ON GOLIAD ST. ±40 FEET WEST OF CL OF GOLIAD ST. AND ±25 FEET NORTH OF CL OF WASHINGTON ST.	ELEV=595.39
BM # 6	"+" SET IN BOX SOUTH EAST CORNER OF WASHINGTON ST. AND FANNIN ST. ±22 FEET OF CL OF FANNIN ST. AND ±45 FEET SOUTH OF CL OF WASHINGTON ST.	ELEV=580.69

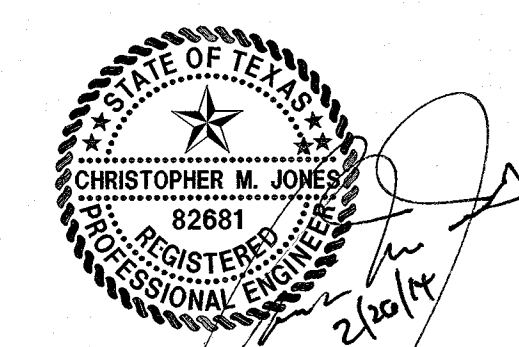

THE SEAL APPEARING ON THIS DOCUMENT WAS AUTHORIZED BY CHRISTOPHER M. JONES, P.E. 82681 ON 02/26/2014. ALTERATION OF A SEALED DOCUMENT WITHOUT PROPER NOTIFICATION TO THE RESPONSIBLE ENGINEER IS AN OFFENSE UNDER THE TEXAS ENGINEERING PRACTICE ACT.

sheet location  
KEY MAP

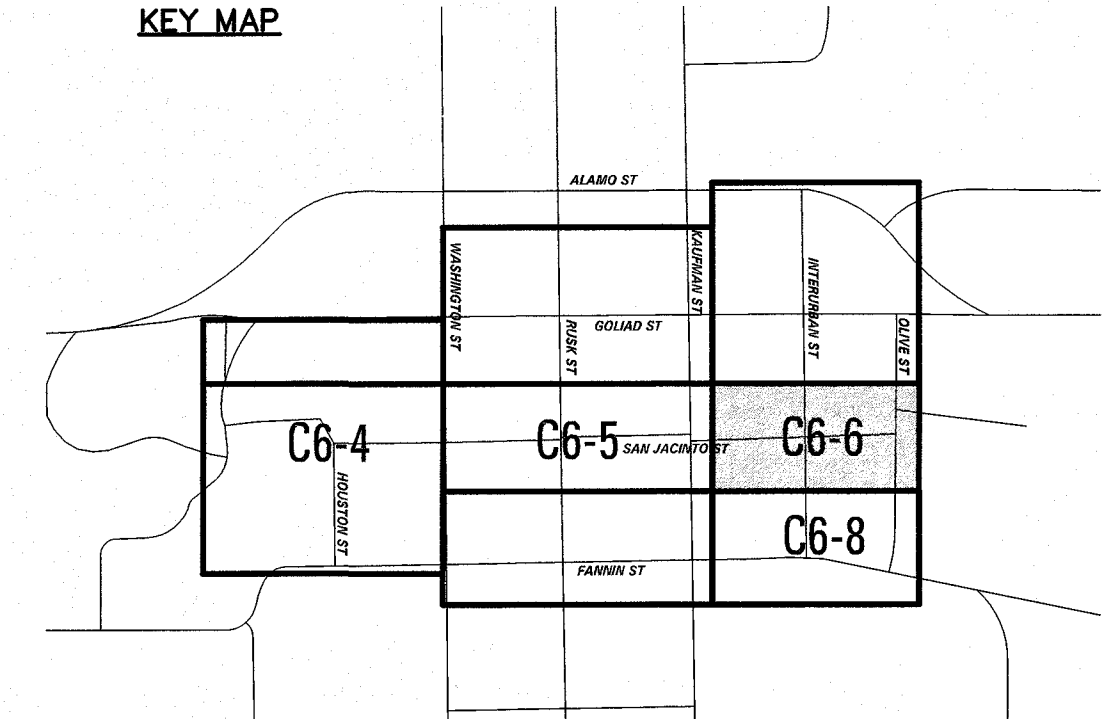

# Downtown Rockwall

streetscape improvements  
PHASE 2  
rockwall, texas

submittals / revisions

no.	date	detail
△	12/11/13	ADDENDUM #2
△	12/11/13	ADDENDUM #3
△	7/11/14	LASI #7
△	1/28/15	LASI #13
△	6/3/15	RFI's 165 & 180

la terra studio, inc.  
12024  
its project number  
02.26.2014  
date  
JHB  
drawn by  
CMJ  
checked by