

Pacheco Koch

DALLAS - FORT WORTH - HOUSTON

*improvements* rockwall, texas RO

O

0

no. date detail


4/2/2014 Electrical Revisions

la terra studio, inc.

12024 Its project number

<u>02.26.2</u>014 C.A.D. drawn by

checked by

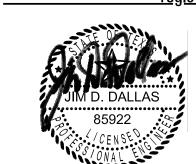

ENTIRE NEW DRAWING

AT&T Telephone

Mr. Brian Duncan (903) 457-2303

TX REG #F-4925 Ph: 940 . 427 . 8487 Fax: 940 . 427 . 8499 P.O. Box 167 Alvord, TX 76225

UTILITY CONTACTS

Oncor Electric Delivery

Mr. Phil Dickerson (972) 551-6712

NOTES BY SYMBOL 'O'

Utility Relocation Plan - Electrical