



© 2013 la terra studio, inc. All Rights Reserved FILE:R:\12024-Downtown Rockwall PS&E - Rockwall\CAD\Sheet\12024_Enlargement_Plan_key.dwg

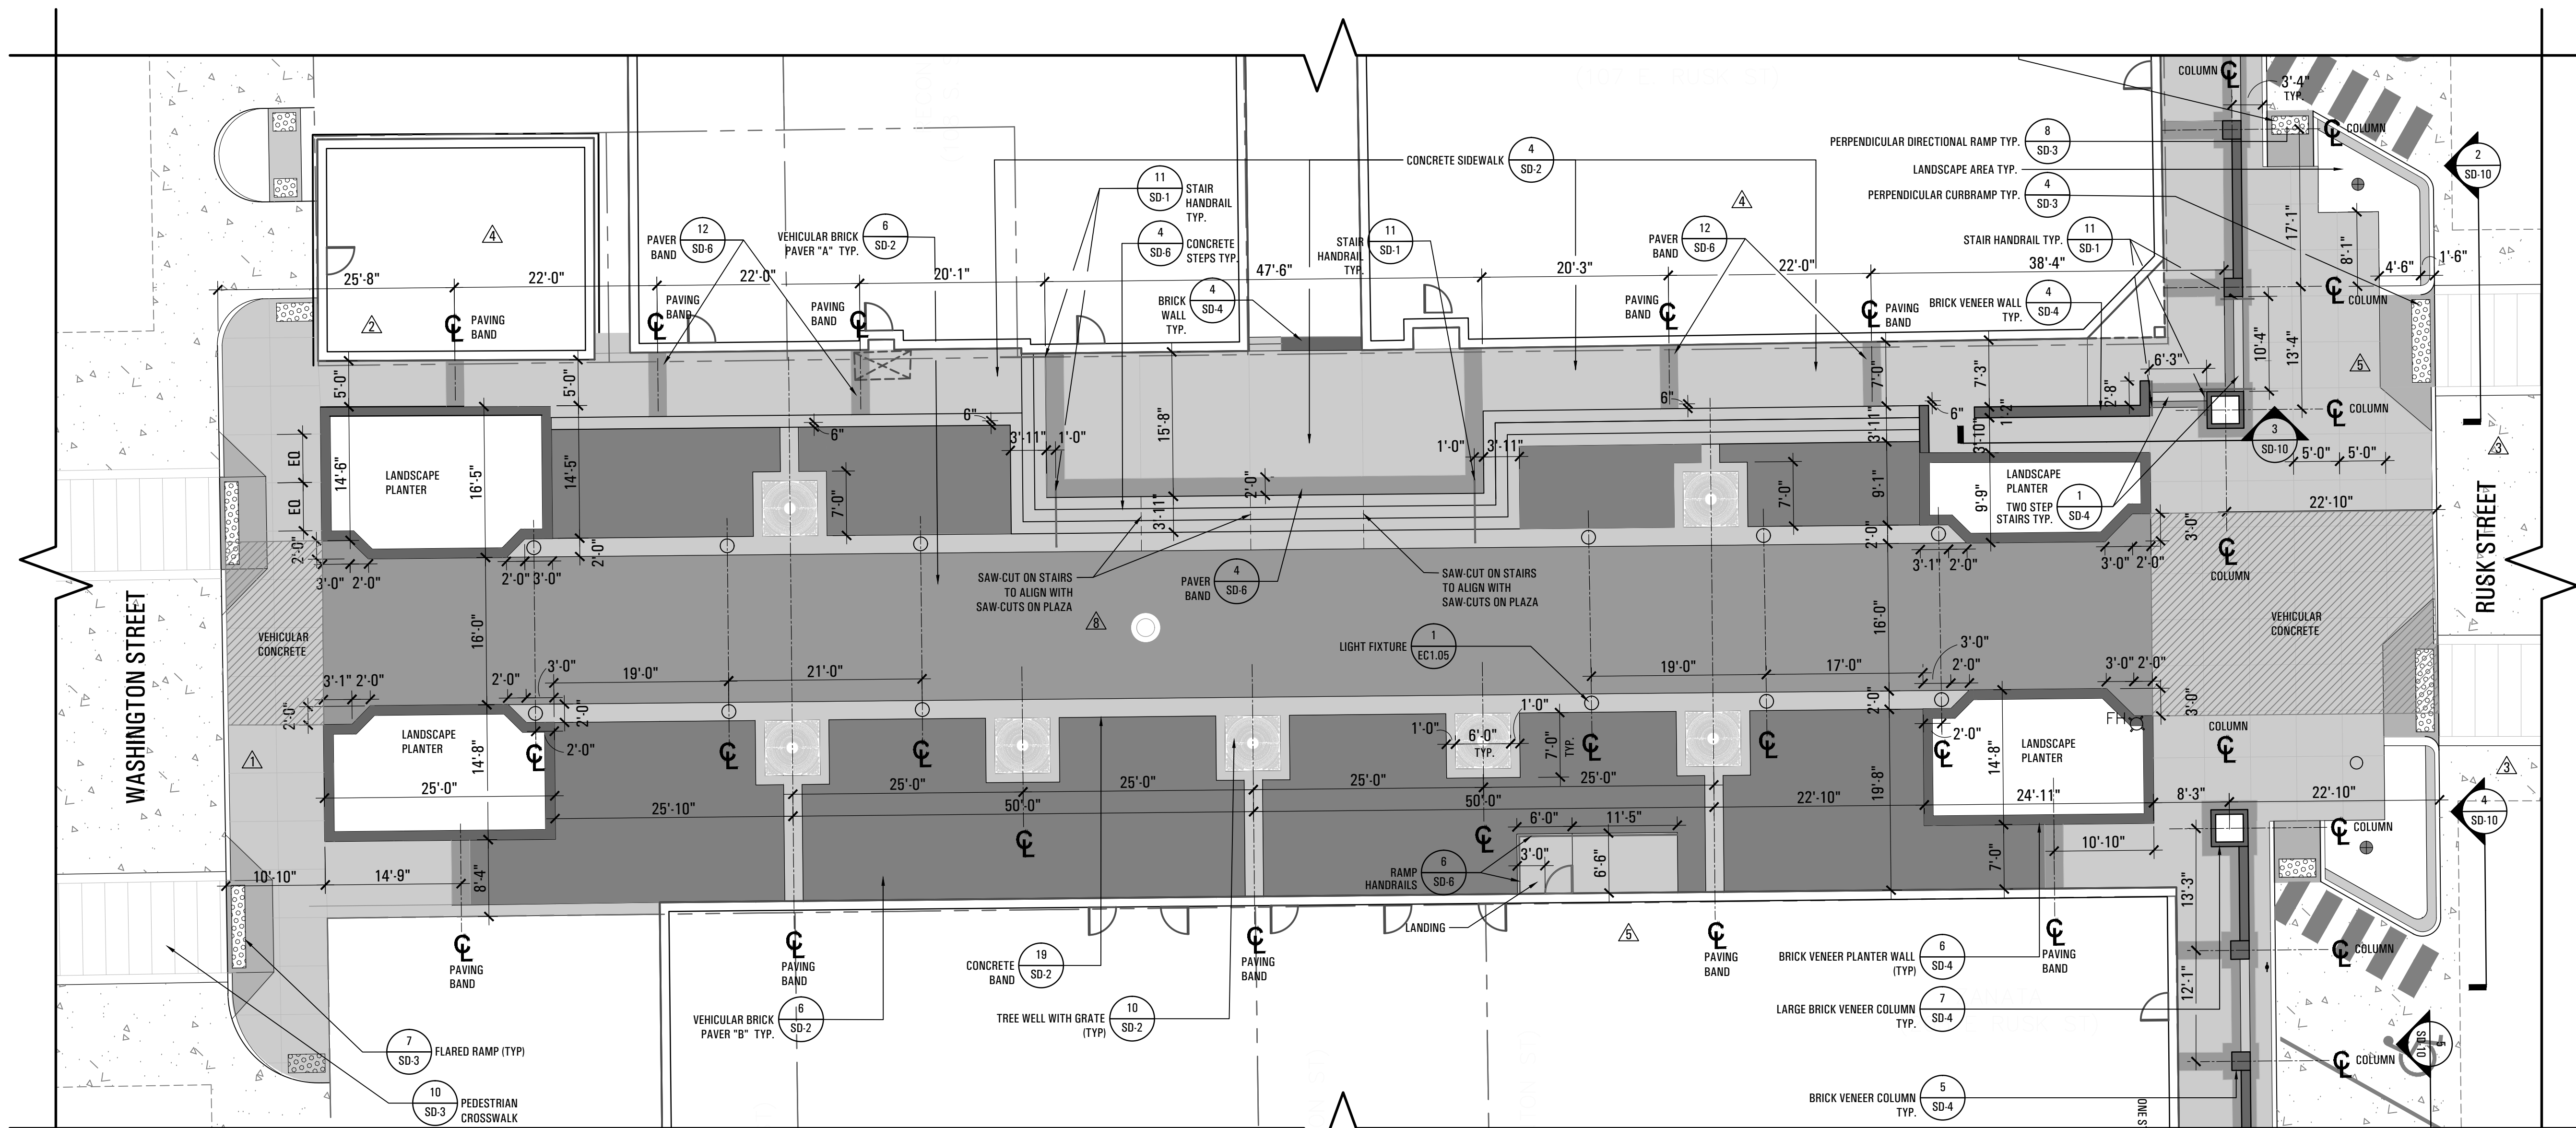

1 ENLARGEMENT PLAN
SCALE: 1" = 10'-0"

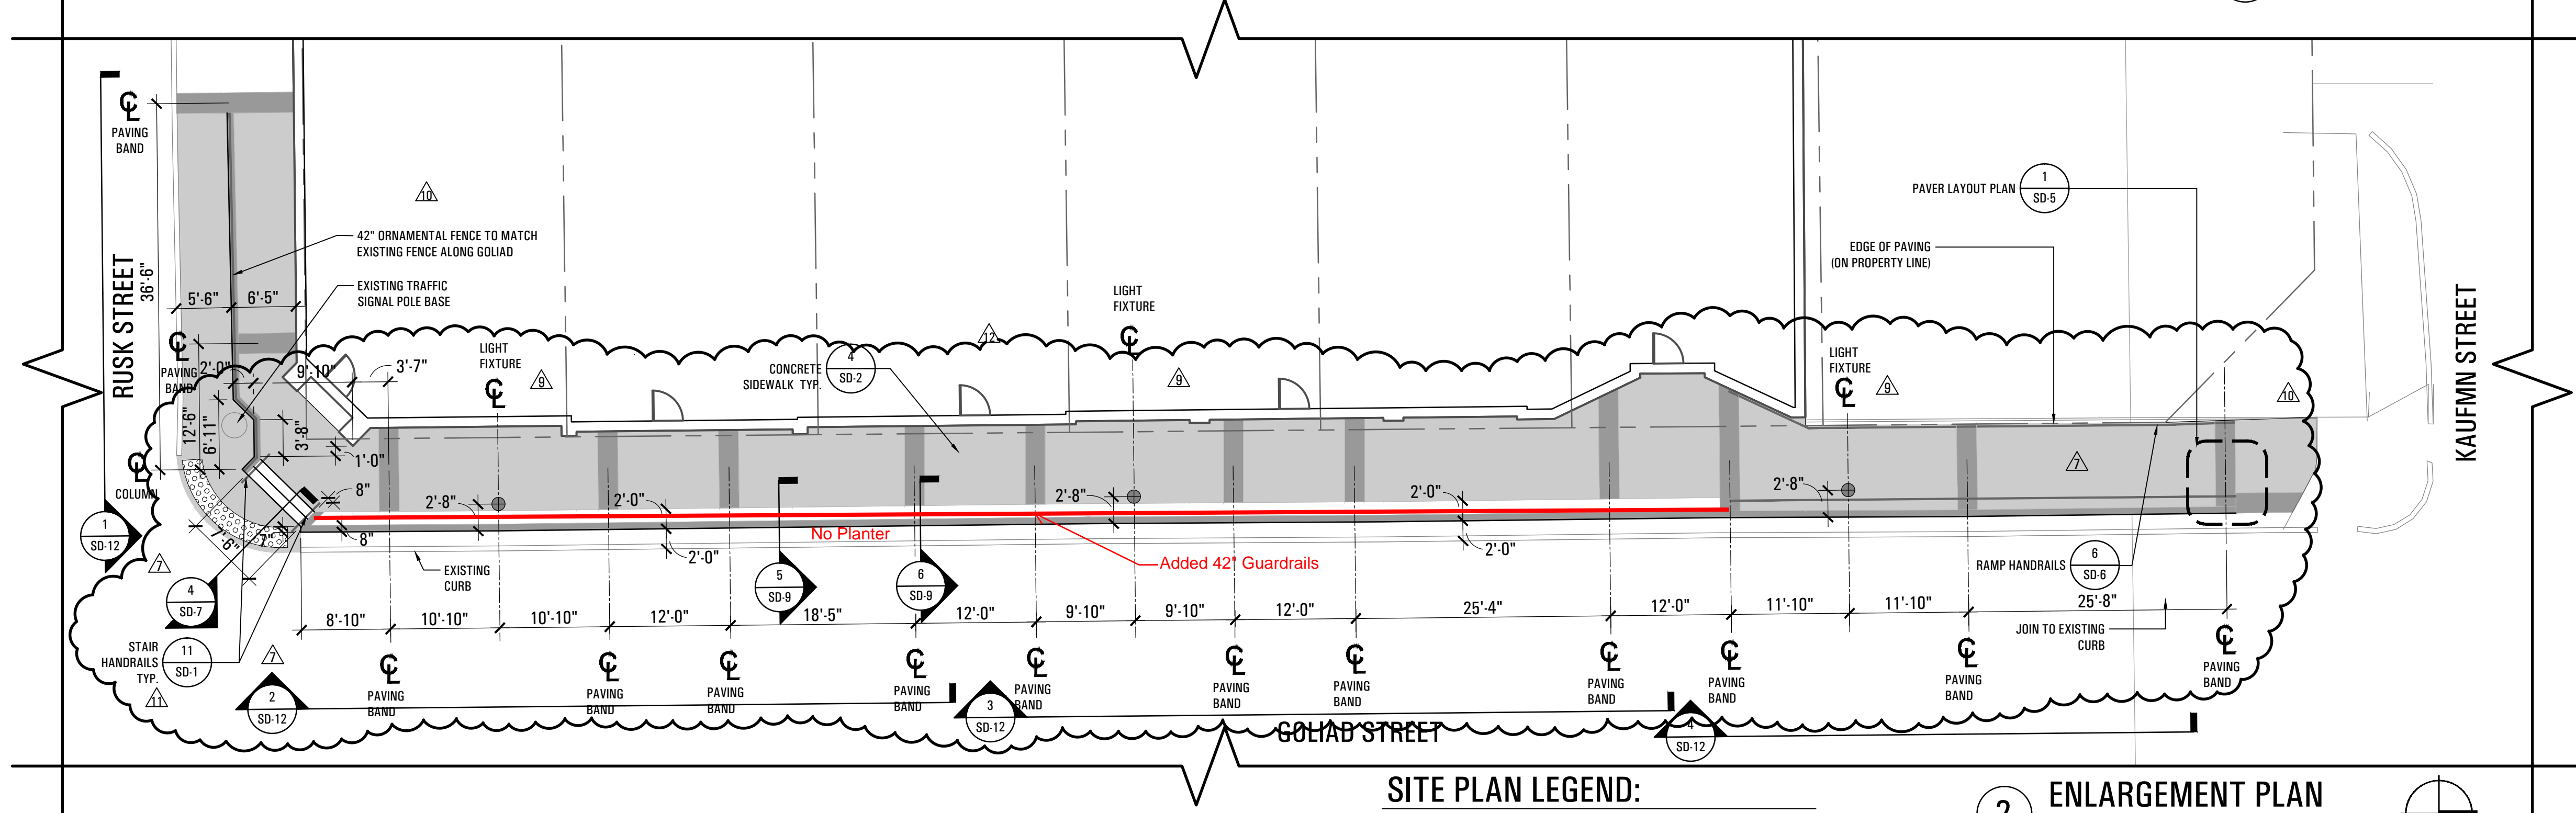

2 ENLARGEMENT PLAN
SCALE: 1" = 10'-0"

SITE PLAN LEGEND:

- EDGE OF PAVEMENT
- ▬ CONCRETE SIDEWALK PAVEMENT
- ▬ CONCRETE VEHICULAR PAVEMENT
- TYPICAL LIGHT FIXTURE

- ▲ 10/09/15 RFI #200, #202
- ▲ 10/30/15 RFI #212
- ▲ 11/28/15 LASI #23

Downtown Rockwall
 la terra studio Project #12024
streetscape improvements
 PHASE 2
 rockwall, texas



submittals / revisions

no.	date	detail
▲	05/13/14	RFI #71
▲	08/14/14	LASI #9
▲	07/31/14	LASI #10
▲	09/26/14	RFI #131
▲	10/16/14	RFI #137
▲	12/30/14	RFI #139
▲	06/04/15	LASI #18
▲	06/08/15	LASI #19
▲	09/28/15	RFI #196

la terra studio, inc.

12024
 its project number
 02.26.2014
 date
 rac; bhm
 drawn by
 mtb
 checked by



Enlargement Plan
 sheet number

EP-1
AS BUILT
 03/07/2016