



submittals / revisions

no.	date	detail
1	4-15-14	RFI #39
2	7-03-14	RFI #39
3	7-22-14	RFI #109
4	12-30-14	RFI #139
5	3-30-15	RFI #167

la terra studio, inc.

12024  
Its project number  
4.15.2014  
date  
bgp  
drawn by  
bgp  
checked by


registration



3-30-15  
sheet title  
**FOUNDATION PLAN**  
sheet number

**FP-2**  
**AS BUILT**  
03/07/2016


# RUSK STREET

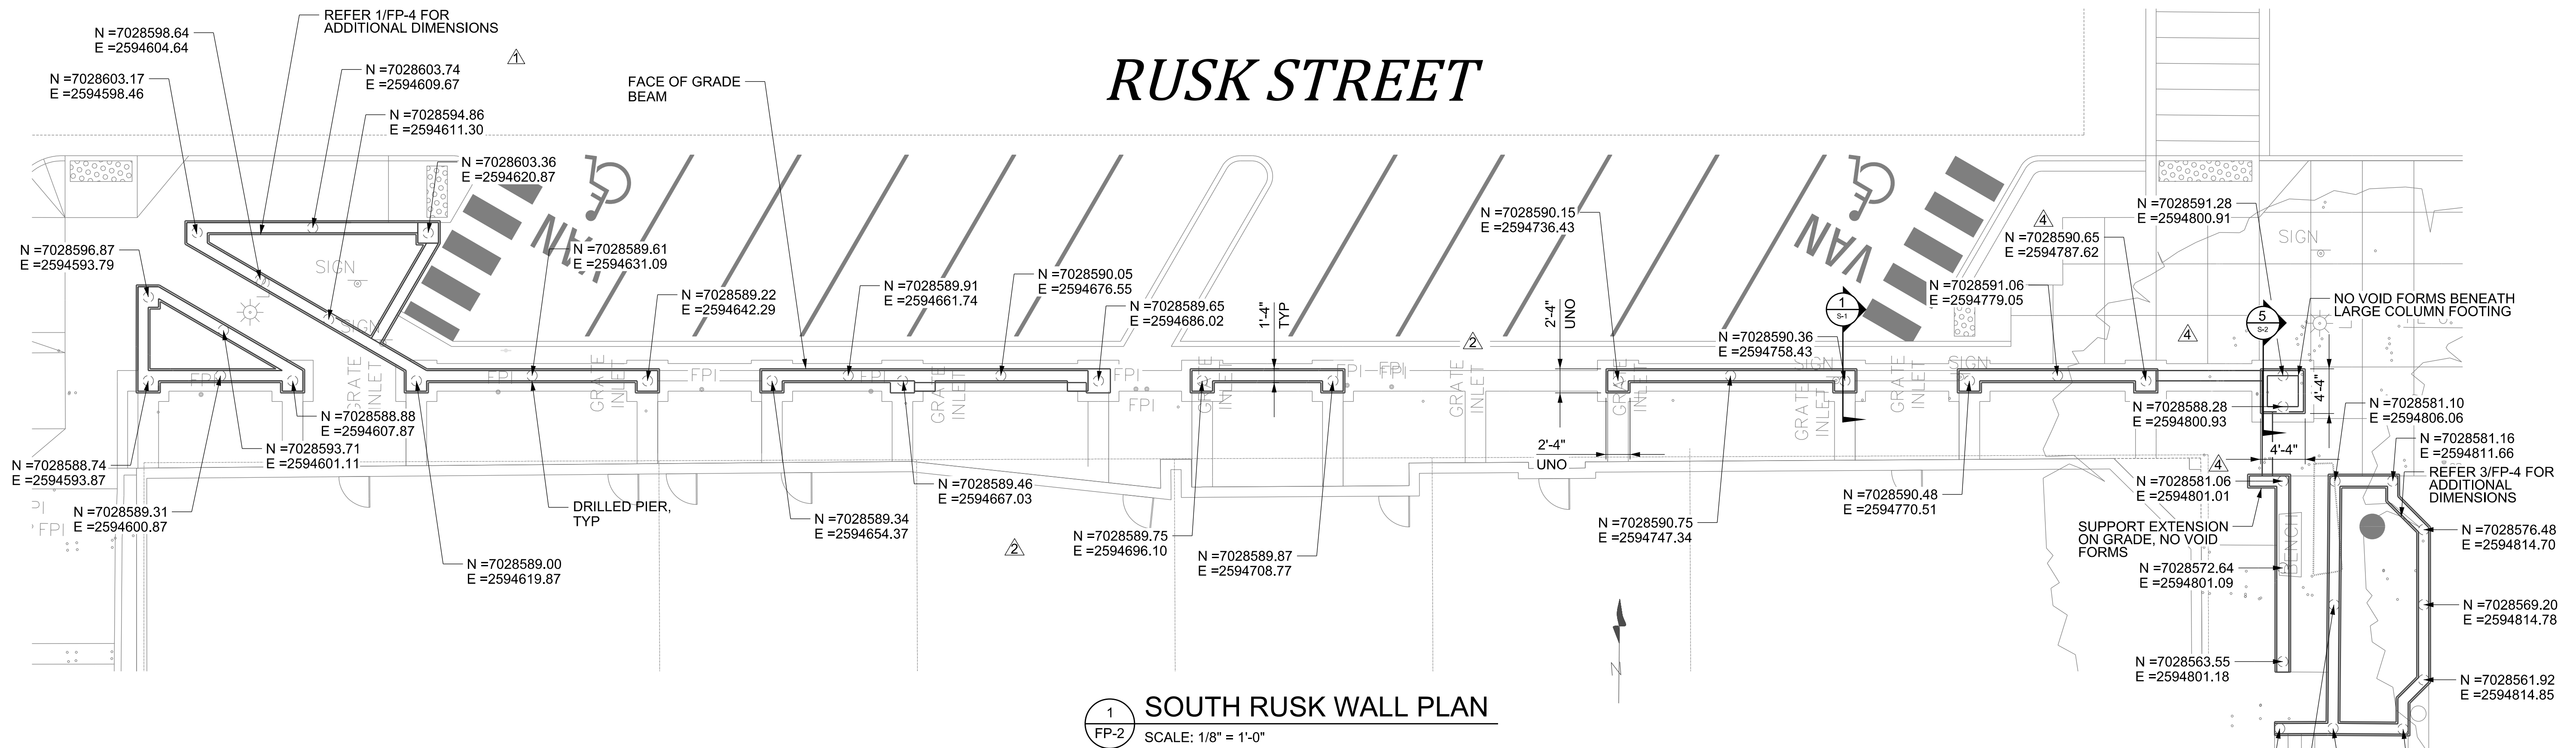


1 SOUTH RUSK WALL PLAN  
SCALE: 1/8" = 1'-0"

- REMOVED SECTIONS OF WALL, ADDED STEPS, ADJUSTED PIER LOCATIONS. 12-30-14
- MODIFIED WALL AND PIER LOCATIONS. 4-15-14
- ADJUSTED WALLS AND PIER LOCATIONS 7-03-14
- REMOVED NOTE 7-22-14

# RUSK STREET

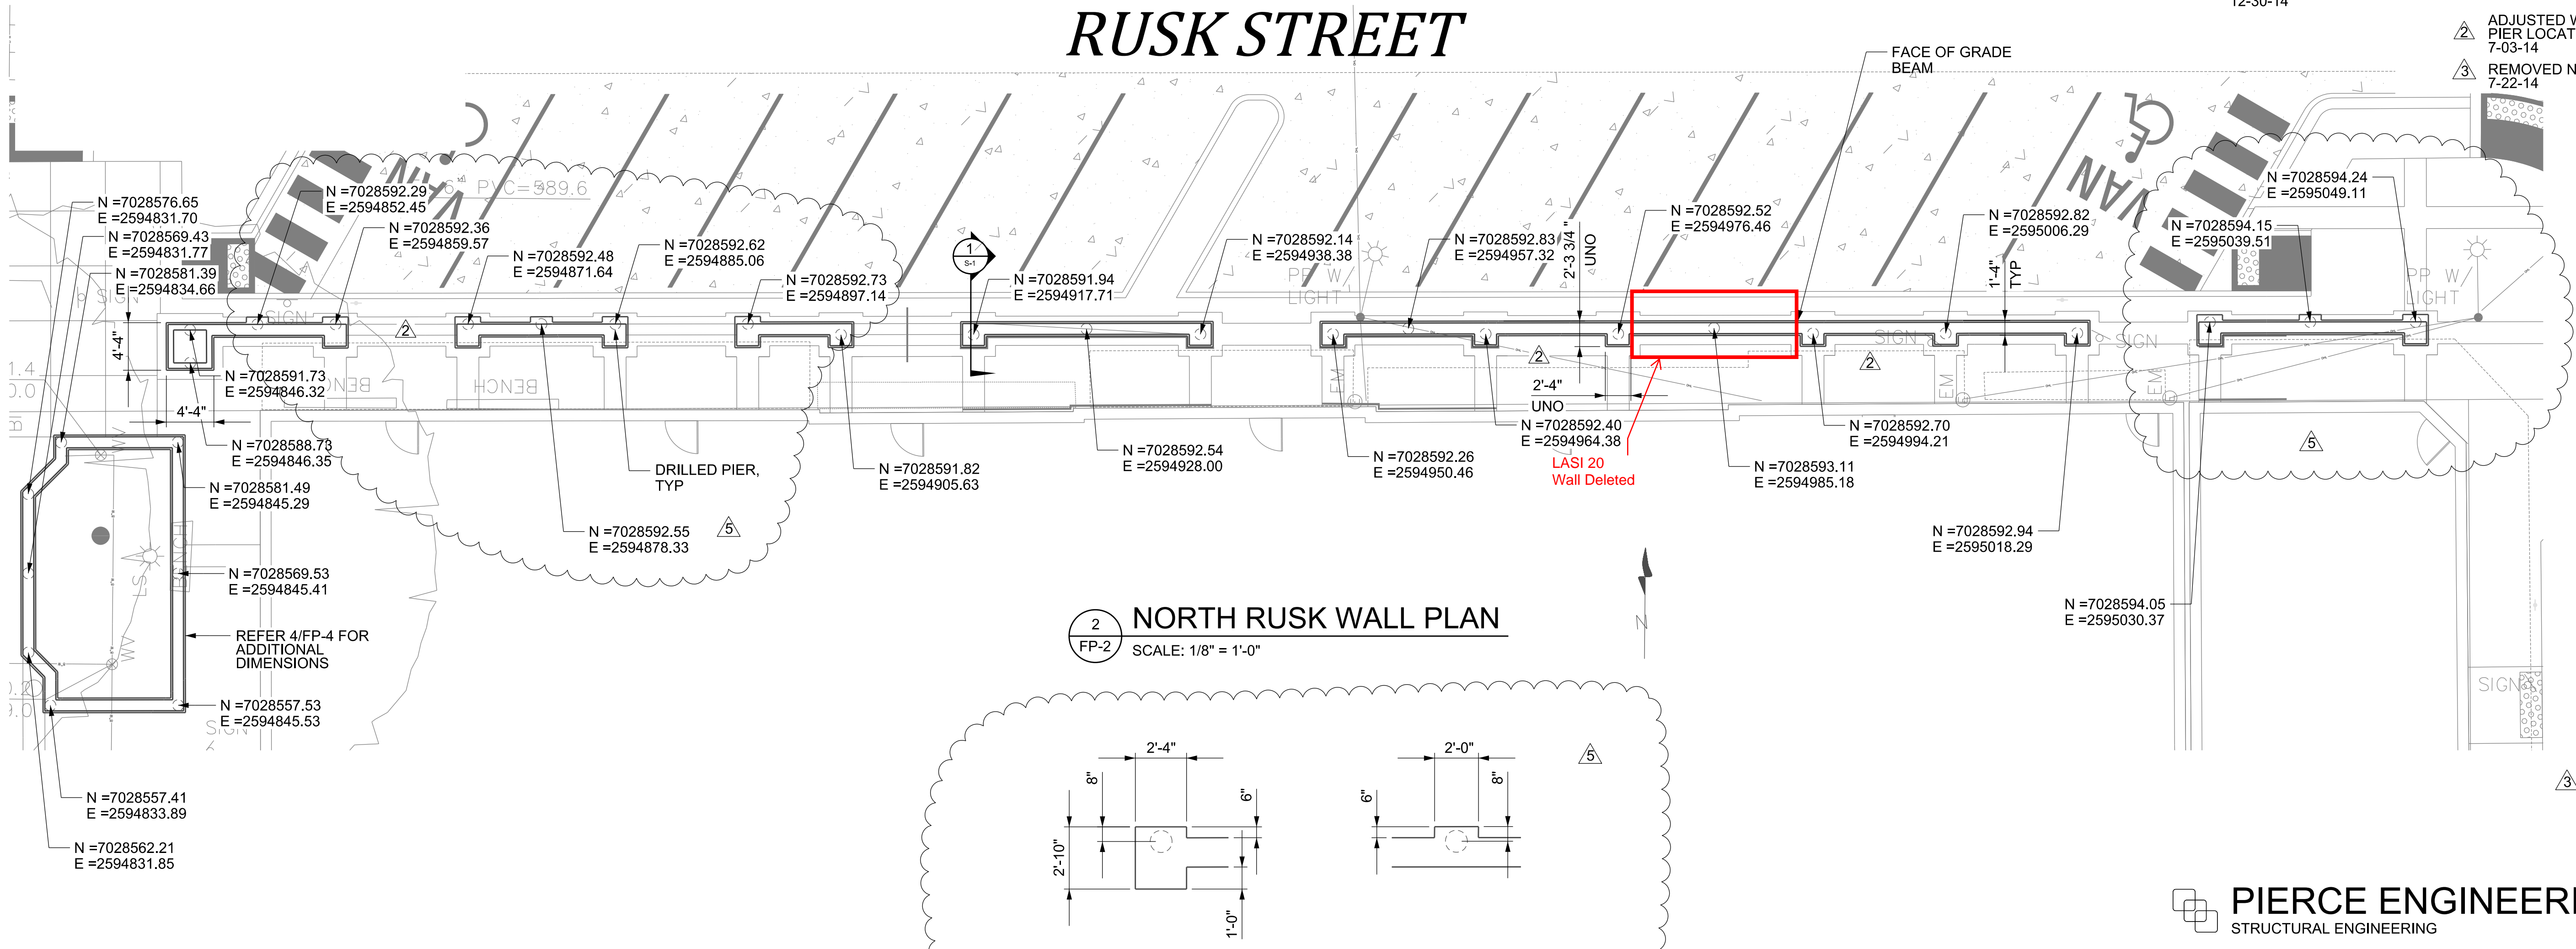

2 NORTH RUSK WALL PLAN  
SCALE: 1/8" = 1'-0"

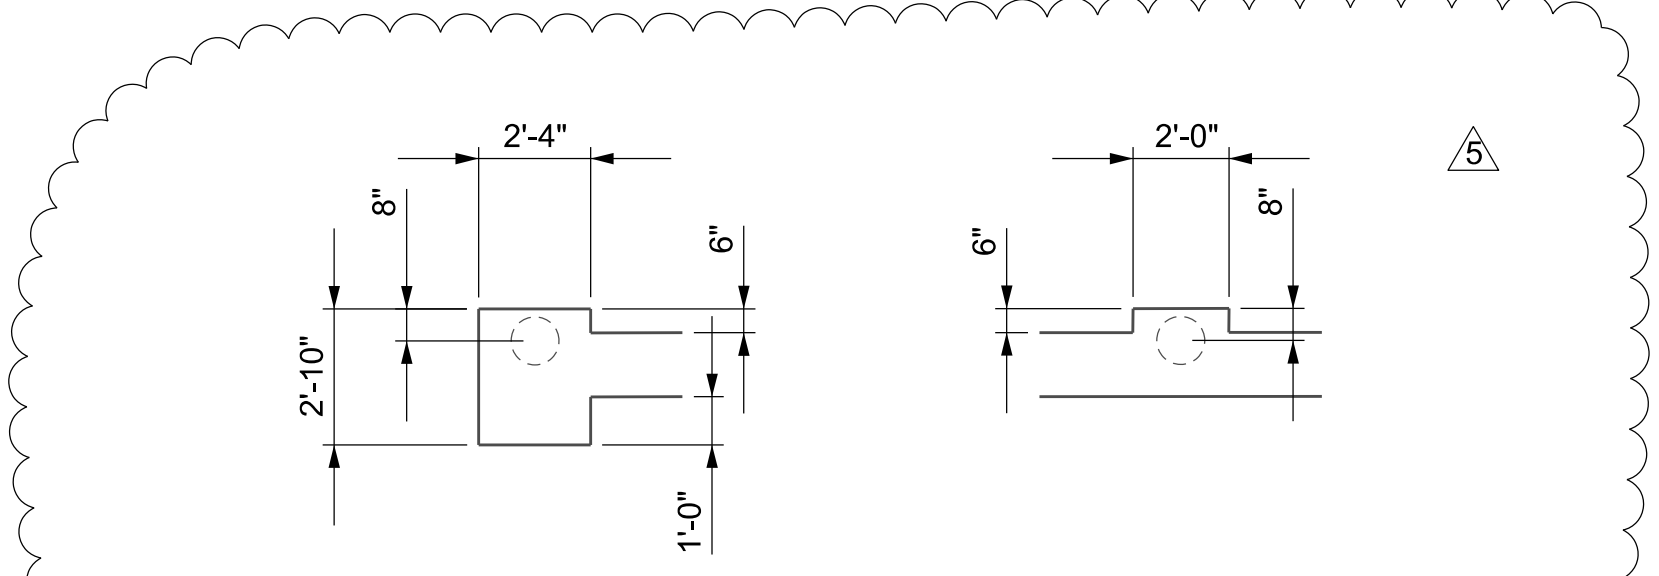

3 TYPICAL WALL BUMPOUT  
SCALE: 1/4" = 1'-0"

**PIERCE ENGINEERING**  
STRUCTURAL ENGINEERING  
BUS.: (940) 937-8600 132 N. MAIN STREET  
FIRM REG #: F-9186 CHILDRESS, TX 79201