


GRADING PLAN LEGEND:

- 580 — EXISTING GRADE CONTOUR
- 581 — FINISH GRADE CONTOUR
- 587.25 — FINISH SPOT GRADE
- 580.00 — SEE CIVIL FOR CROSS REFERENCE OF PROPOSED ELEVATION
- TS TOP STEP
- BS BOTTOM STEP
- TW TOP OF WALL
- BW BOTTOM OF WALL
- TC TOP OF CURB
- G GUTTER
- FF FINISH FLOOR
- TCOL TOP OF COLUMN

sheet location

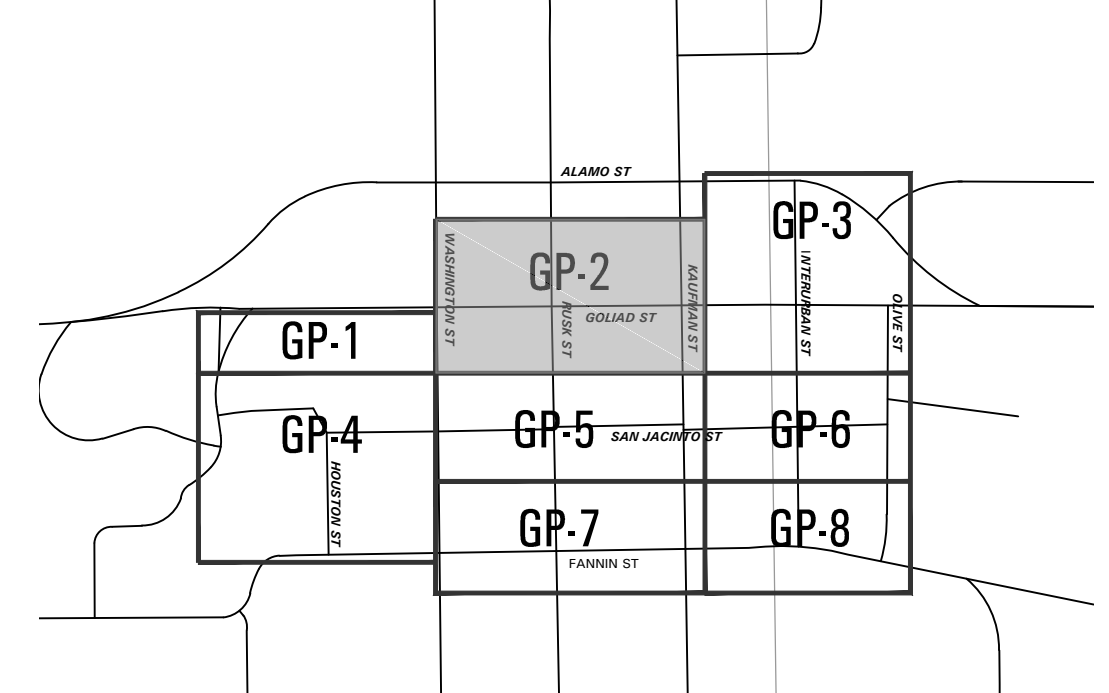

Downtown Rockwall
 la terra studio Project #12024
streetscape improvements
 PHASE 2
 rockwall, texas



submittals / revisions

no.	date	detail
△	04/11/14	RFI #39,56
△	05/02/14	RFI #77 WEST RUSK GRADING
△	06/17/14	RFI #93
△	07/11/14	LASI #7
△	07/25/14	RFI #104
△	09/10/14	RFI #124
△	10/27/14	RFI #140
△	01/13/15	LASI #14
△	02/09/15	RFI #160

la terra studio, inc.

12024
 its project number
 02.26.2014
 date
 rac; bhm
 drawn by
 mtb
 checked by



Grading Plan
 sheet number

GP-2
AS BUILT
 03/07/2016