



sheet location

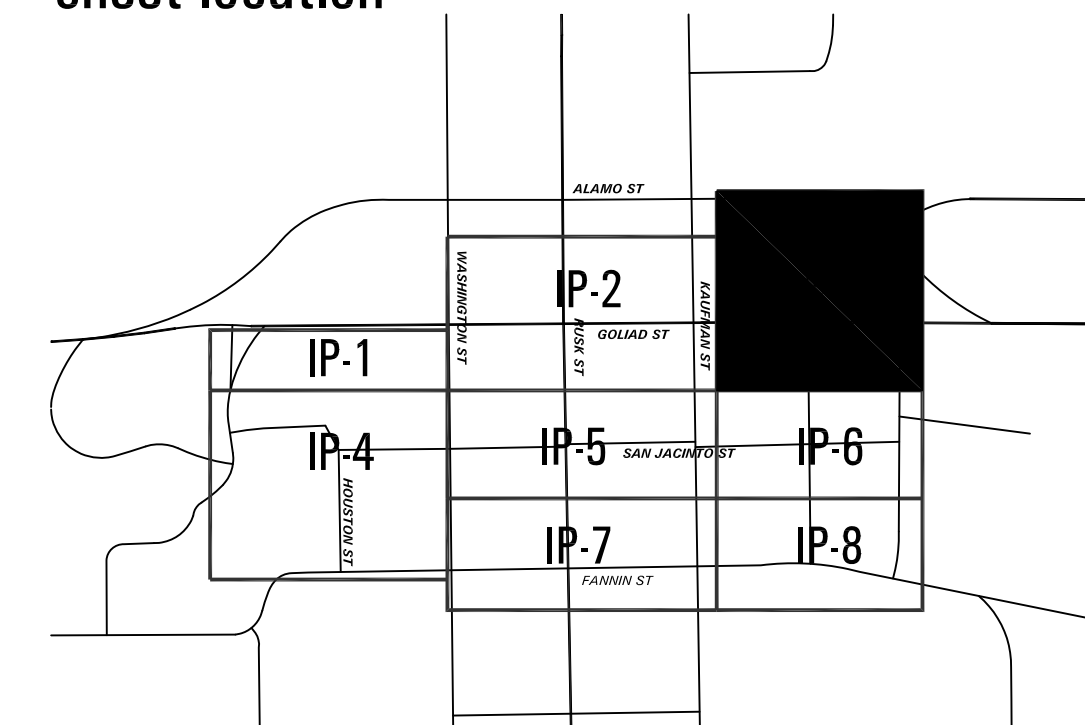

Downtown Rockwall
 Project # 12024 ~ renovation ~
streetscape improvements
 rockwall, texas

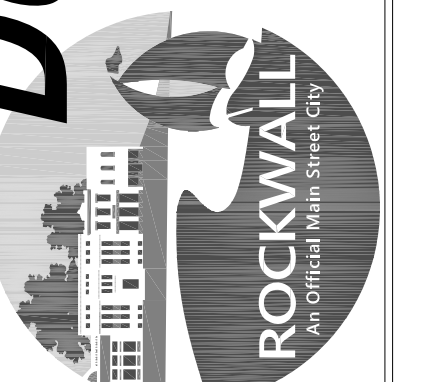

submittals / revisions

no.	date	detail
1	3-19-14	RFI #11
2	6-26-15	RFI #161

la terra studio, inc.

12024
 Its project number
 02.26.2014
 date
 SAH
 drawn by
 SAH
 checked by

registration



6-26-2015

sheet title

Irrigation Plan
 sheet number

2 **IP-3**

AS BUILT

03/07/2016