

Pacheco Koch

DALLAS - FORT WORTH - HOUSTON



streetscape

owntown

submittals	revision

		submittals	revis
)_	date	detail	


la terra studio, inc.

Its project number 02.26.2014 date

SAH drawn by

SAH checked by

<u>registration</u>

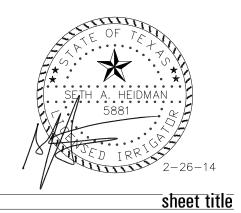

**Irrigation Plan**