




Pacheco Koch

DALLAS - FORT WORTH - HOUSTON



improvements rockwall, texas

streetscape

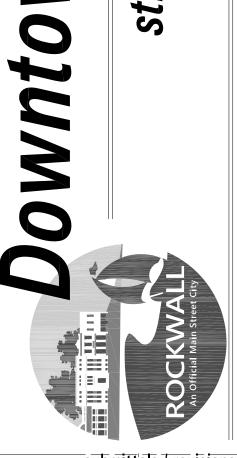

|--|

		Submittais	16
no.	date	detail	

la terra studio, inc.


Its project number 02.26.2014 date

12024

SAH drawn by

SAH checked by

<u>registration</u>

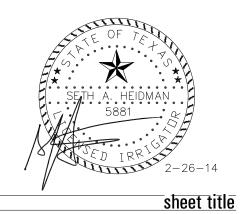

Irrigation Plan