


**1 ENLARGEMENT PLAN**  
SCALE: 1" = 10'-0"

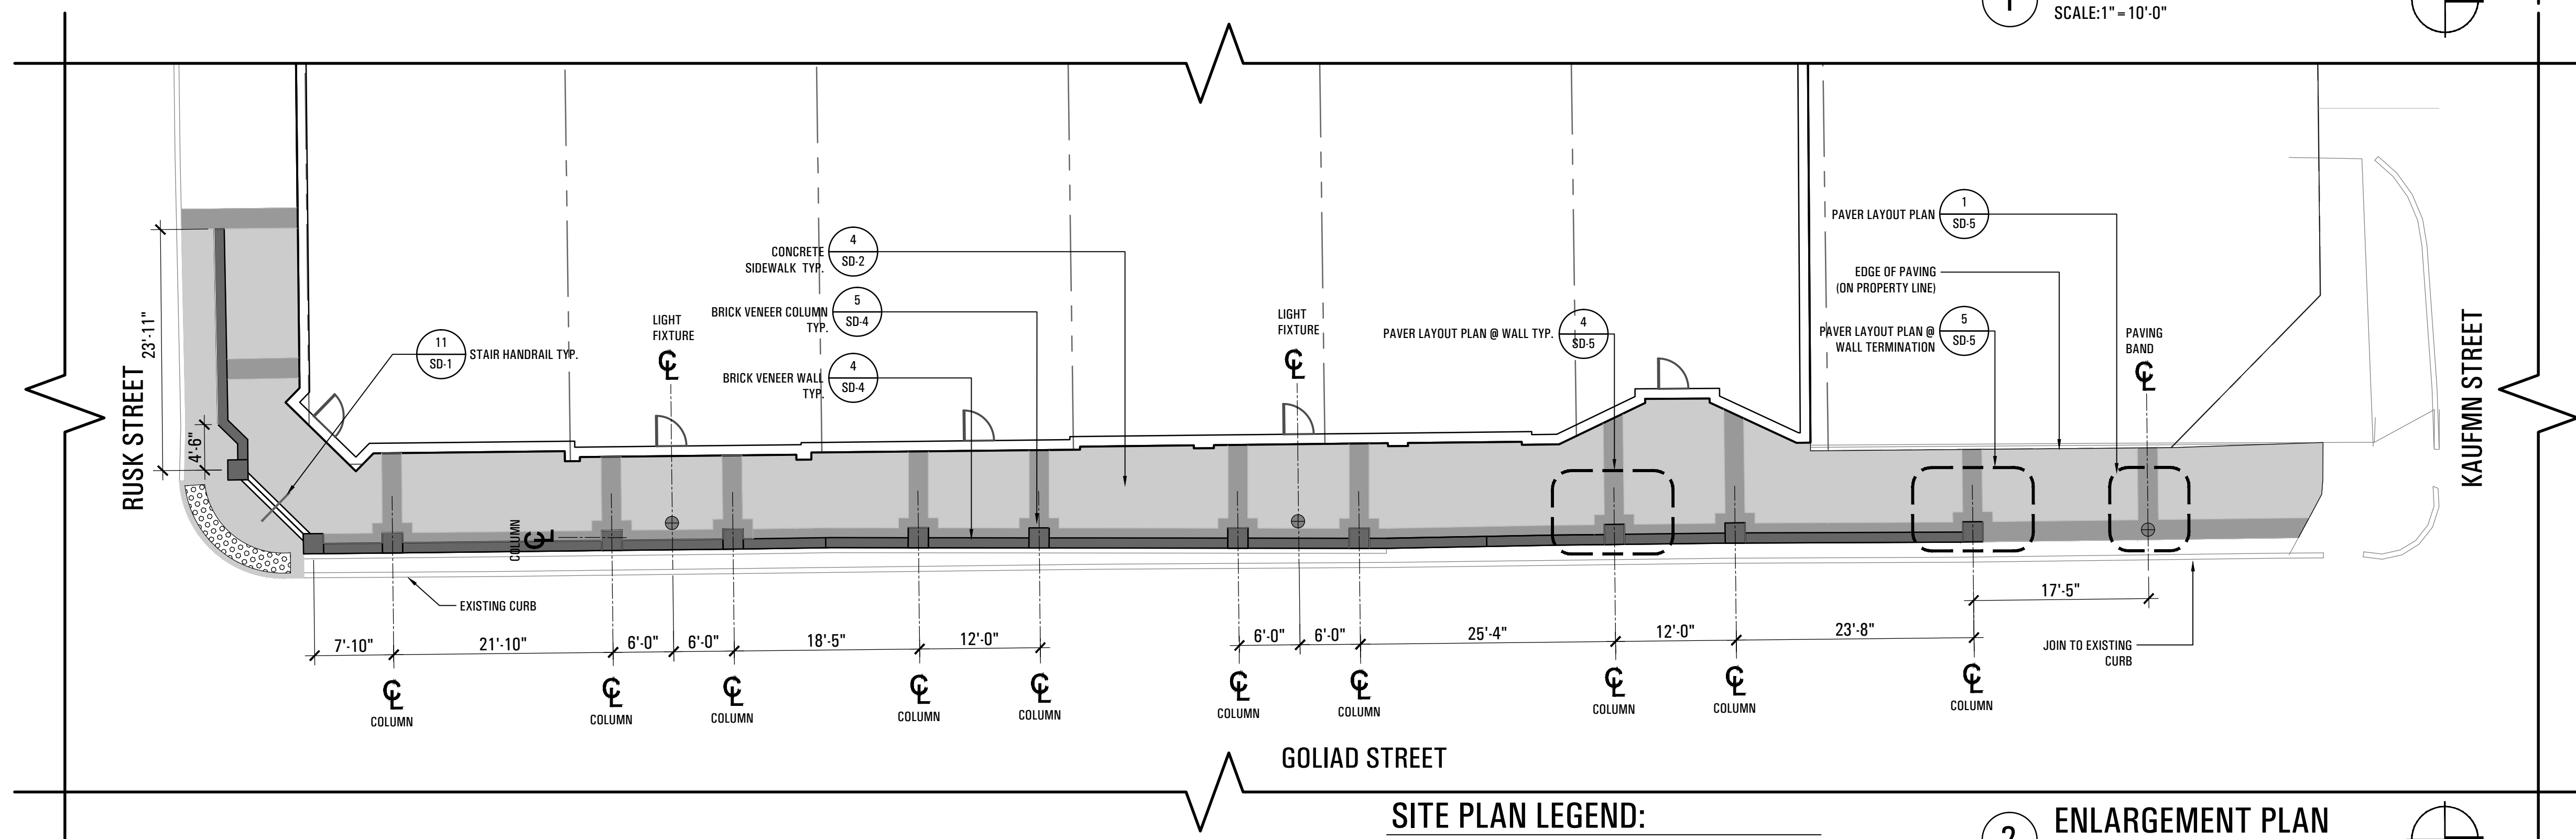

**SITE PLAN LEGEND:**

- EDGE OF PAVEMENT
- CONCRETE SIDEWALK PAVEMENT
- CONCRETE VEHICULAR PAVEMENT
- TYPICAL LIGHT FIXTURE

**2 ENLARGEMENT PLAN**  
SCALE: 1" = 10'-0"

**Downtown Rockwall**  
*la terra studio Project #12024*  
**streetscape improvements**  
PHASE 2  
rockwall, texas



submittals / revisions

no.	date	detail
▲	06/13/14	RFI #71
▲	07/28/14	LASI #9
▲	07/31/14	LASI #10

la terra studio, inc.  
12024  
its project number  
02.26.2014  
date  
rac; bhm  
drawn by  
mtb  
checked by

