


1 ENLARGEMENT PLAN
SCALE: 1" = 10'-0"

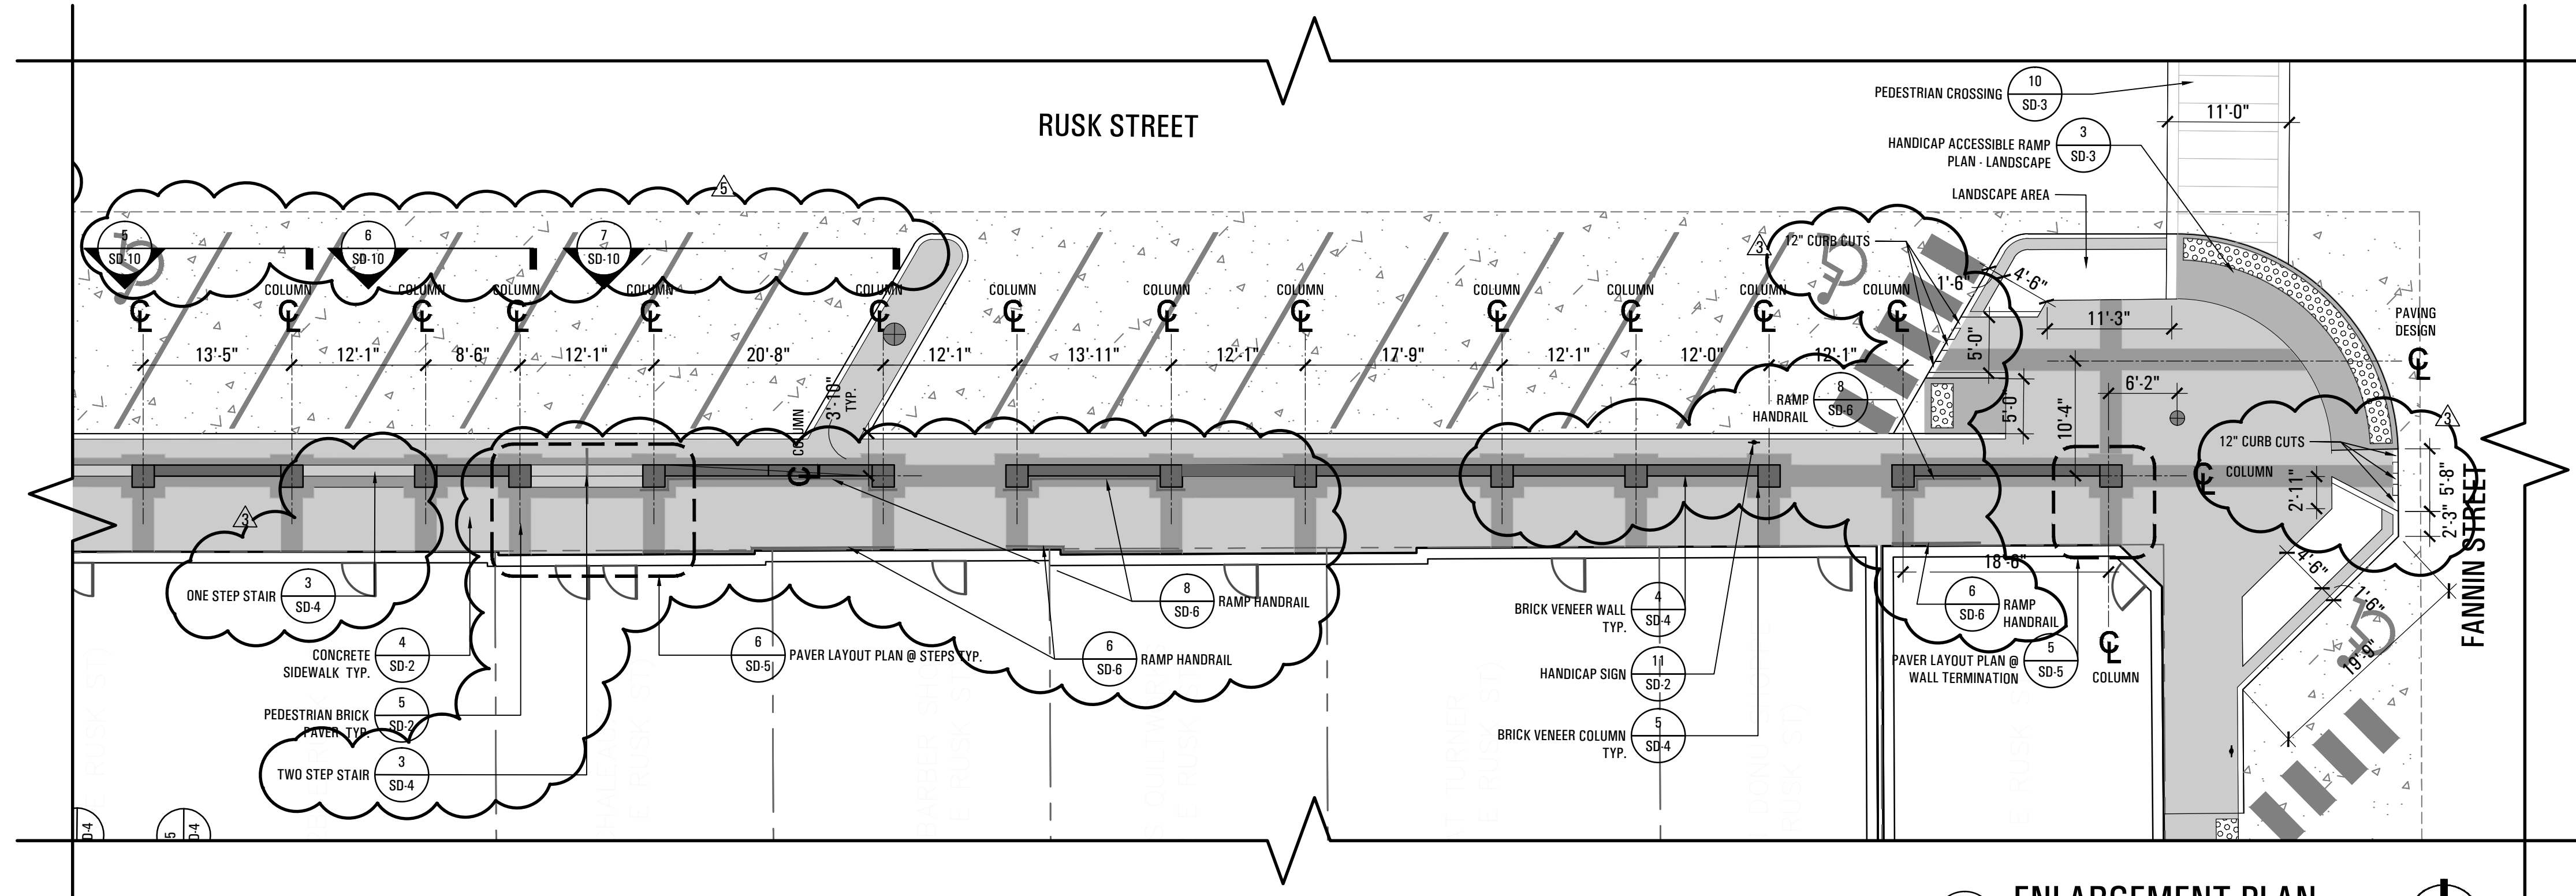


2 ENLARGEMENT PLAN
SCALE: 1" = 10'-0"

SITE PLAN LEGEND:

- EDGE OF PAVEMENT
- CONCRETE SIDEWALK PAVEMENT
- CONCRETE VEHICULAR PAVEMENT
- TYPICAL LIGHT FIXTURE

Downtown Rockwall
la terra studio Project #12024
streetscape improvements
PHASE 2
rockwall, texas

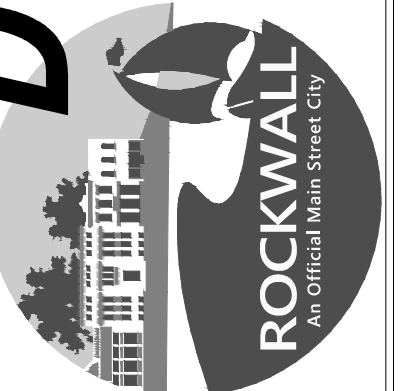


submittals / revisions

no.	date	detail
▲	04/14/14	RFI #39
▲	05/02/14	RFI #77 WEST RUSK GRADING
▲	05/08/14	RFI #20, #38, #42, #43, #54
▲	06/17/14	RFI #93
▲	07/31/14	LASI #10

la terra studio, inc.

12024
Its project number
02.26.2014
date
rac; bhm
drawn by
mtb
checked by

registration

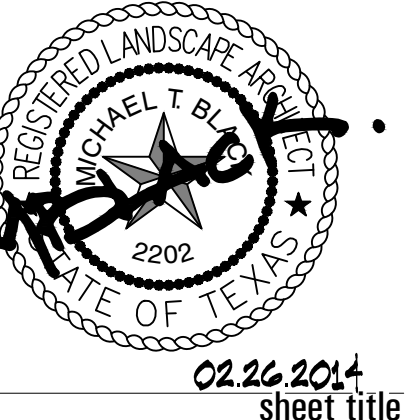

02.26.2014
sheet title

Enlargement Plan
sheet number

EP-3